


V I C I N I T Y M A P

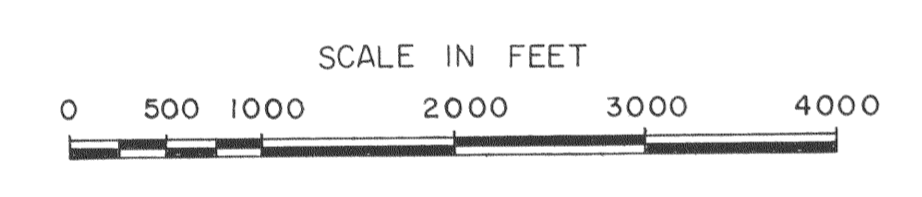

CITY OF OROVILLE
 OROVILLE, CALIFORNIA

MUNICIPAL SEWER DISTRICT NO. 1

PLANS FOR CONSTRUCTION OF
 SANITARY SEWER PROJECT

Mayor- CONRAD W. WEISKER

Council Members

- ALBERT J. WALSH
- C. MYRON BUCK, JR.
- JACK J. McKILLOP
- DAIR A. TANDY
- JAMES SAVERCOOL
- WALTER C. SHANER

City Administrator- RALPH M. CARPENTER
 Director of Engineering-HAROLD KROEGER

I N D E X T O S H E E T S

SHEET	TITLE	SHEET	TITLE
1	INDEX AND VICINITY MAP	18	PLAN AND PROFILE - "H" LINE
2	GENERAL MAP	19	PLAN AND PROFILE - "I" LINE
3	PLAN AND PROFILE - OUTFALL LINE & "A" LINE	20	PLAN AND PROFILE - "J" & "E" LINE
4-8	PLAN AND PROFILE - "A" LINE	21	PLAN AND PROFILE - "K" LINE
9-11	PLAN AND PROFILE - "B" LINE	22	PLAN AND PROFILE - "K" & "C" LINE
12	PLAN AND PROFILE - "C" LINE	23	ELECTRICAL AND FORCE MAIN PLANS
13-15	PLAN AND PROFILE - "D" LINE	24	MISCELLANEOUS DETAILS
16	PLAN AND PROFILE - "D" & "G" LINE	25	SEWAGE PUMPING STATION & MISCELLANEOUS DETAILS
17	PLAN AND PROFILE - "F" LINE		

L E G E N D

- Manhole & line to be constructed.
- Force main
- Existing water line
- Existing sewer
- Existing gas line
- R/W line and/or property line
- Power line
- Culvert
- Tree line
- Edge of pavement
- Mail box line
- Major ditch
- V.C.P. Vitrified clay pipe
- M.H. Manhole
- C.I. Cast iron

"AS - BUILT"

CITY OF OROVILLE
 OROVILLE, CALIFORNIA

MUNICIPAL SEWER DISTRICT NO. 1
 SANITARY SEWER PROJECT

INDEX AND VICINITY MAP

DEWANTE AND STOWELL
 SANITARY AND CIVIL ENGINEERS - SACRAMENTO, CALIFORNIA

DRAWN: R.A.B.	SUBMITTED: <i>[Signature]</i>	SHEET NO. 1
CHECKED: E.R.S.	APPROVED: <i>[Signature]</i>	OF 25
DATE: Mar., 1962		