


NOTE: Wyes are marked in field at property lines by a 2" x 2" redwood stake.

Scales:
Horizontal: 1"=40'-0"
Vertical: 1"=4'-0"

"A5 - BUILT"

Ground profile shown for ϕ of pavement. Ground profile at sewer may differ. Verify in field.

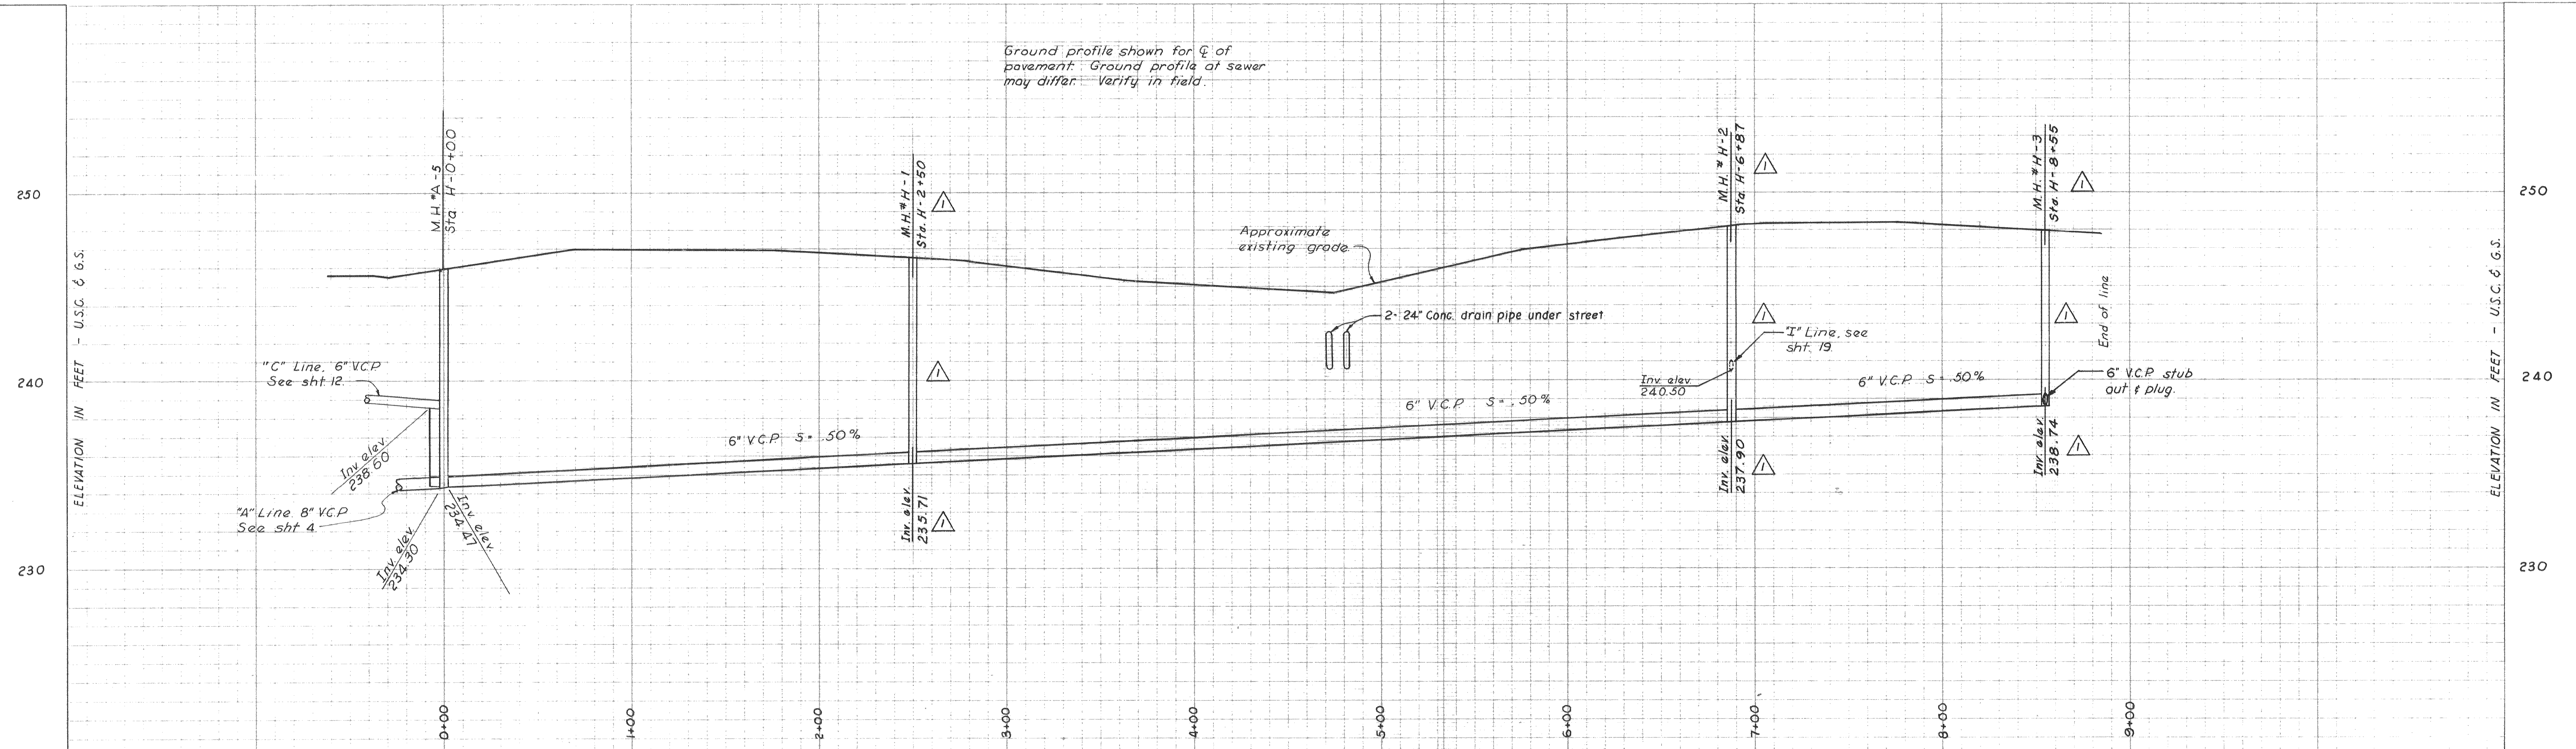

DEWANTE AND STOWELL
SANITARY AND CIVIL ENGINEERS - SACRAMENTO, CALIFORNIA

REVISION	DATE	DESCRIPTION	BY	APPD
△ AB	8/26/63	Revised manhole stationing, location, and invert elevations.	HNH RNE	ERS

SUBMITTED:
Edwin R. Stowell

APPROVED:
R. M. Longherty

CITY OF OROVILLE
OROVILLE, CALIFORNIA

MUNICIPAL SEWER DISTRICT NO. 1 SANITARY SEWER PROJECT
PLAN AND PROFILE - "H" LINE

DATE: March 1962	SHEET NO: 18
CHKD: E.R.S.	DRWN: R.A.B.
OF 25	

SS215