


Note:  
Water & gas service not shown. Locate in field prior to trenching.

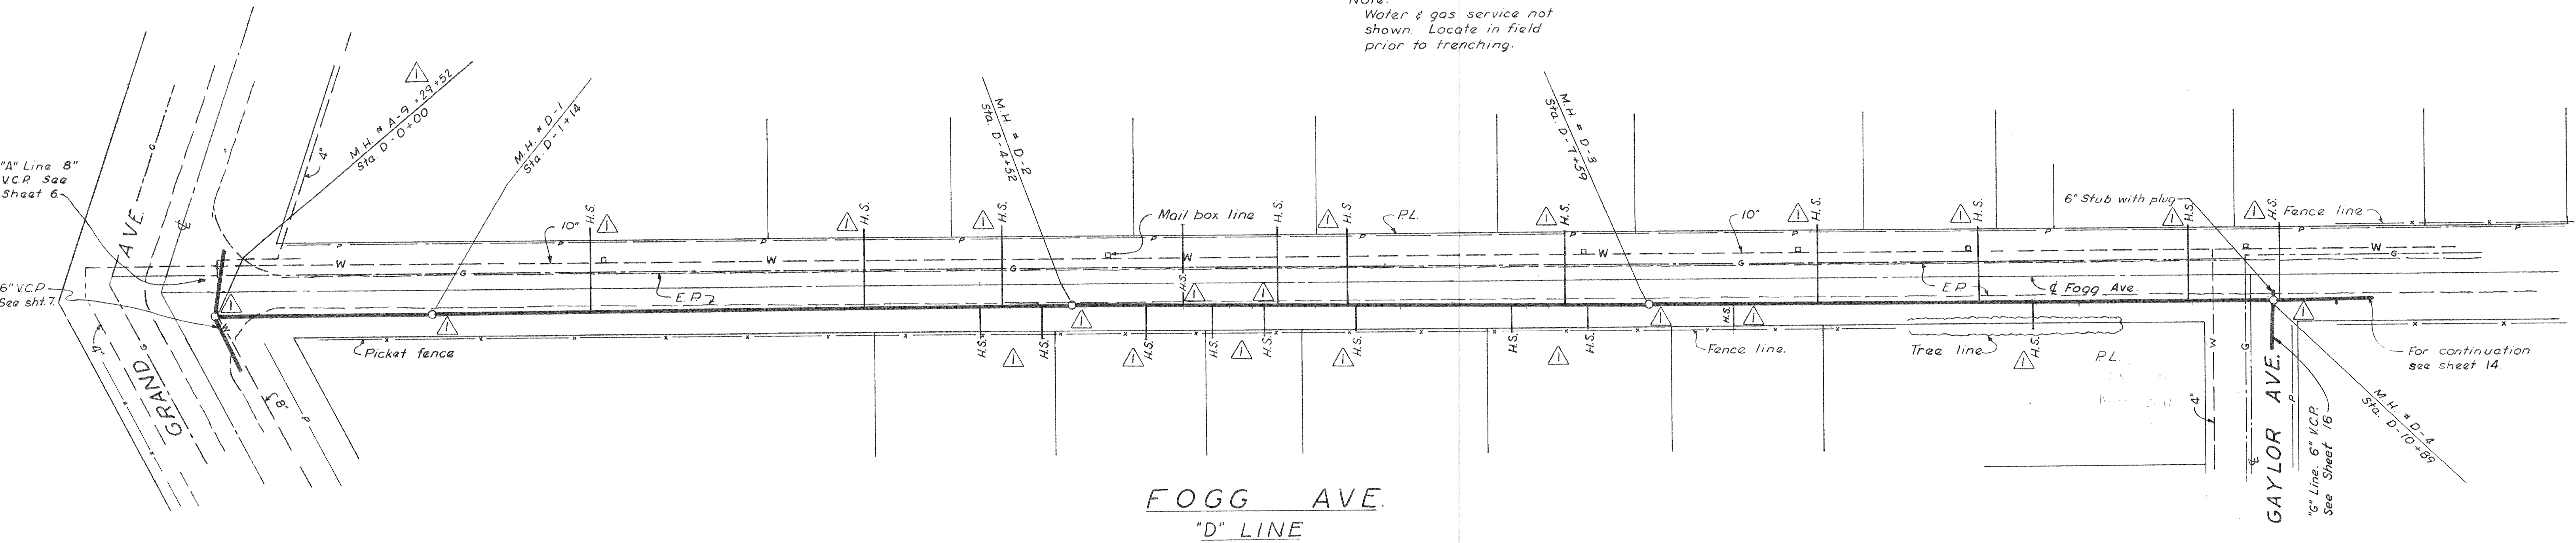


NOTE: Wyes are marked in field at property lines by a 2" x 2" redwood stake.

Scales:  
Horizontal: 1" = 40' 0"  
Vertical: 1" = 4' 0"

NOTE:  
As-built invert elevations are not field surveyed. Where manholes were moved from original locations or where manholes were added, inverts were calculated using slopes from original plans and distances as furnished for As-Built.

"AS - BUILT"

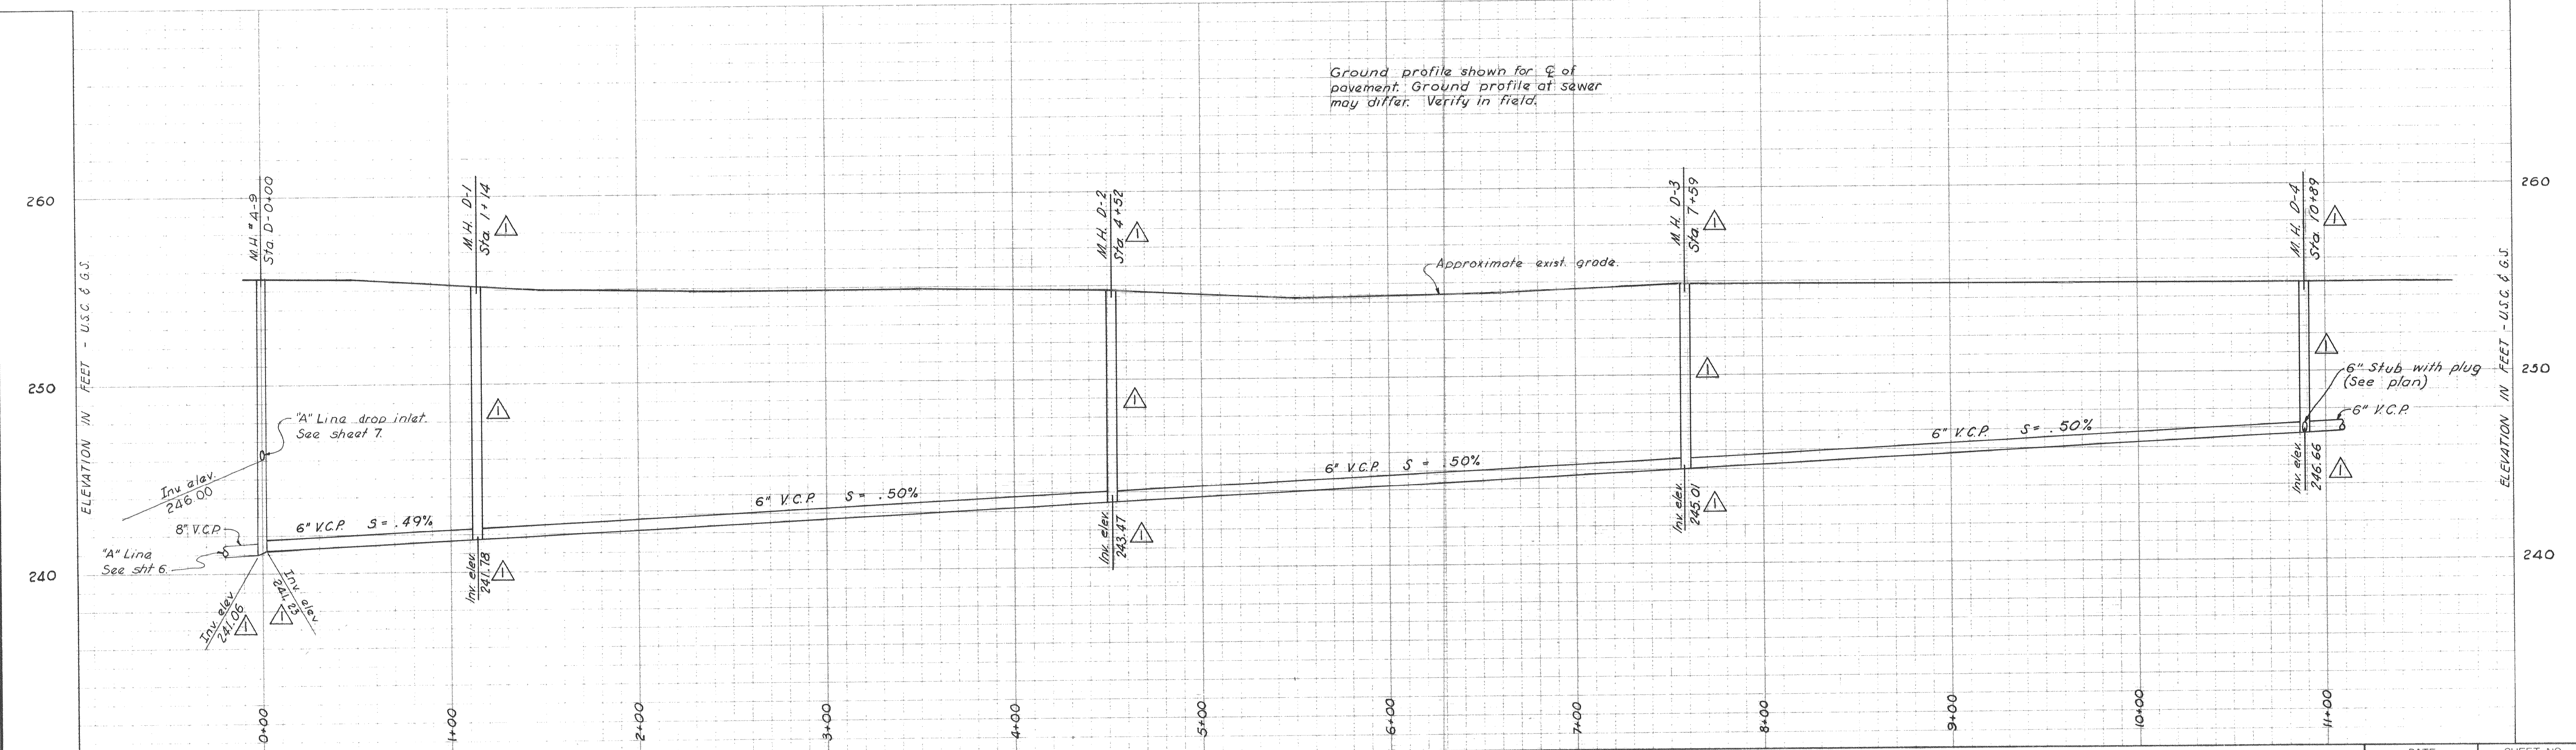

DEWANTE AND STOWELL  
SANITARY AND CIVIL ENGINEERS - SACRAMENTO, CALIFORNIA

REVISION	DATE	DESCRIPTION	BY	APPD.
△ AB	8/26/63	Revised manhole stationing, location, and invert elevations	HNR RNE ERS	
SUBMITTED		Edwin R. Stowell		
APPROVED		R. [Signature]		

CITY OF OROVILLE  
OROVILLE, CALIFORNIA  
MUNICIPAL SEWER DISTRICT NO. 1 SANITARY SEWER PROJECT  
PLAN AND PROFILE - "D" LINE

DATE	SHEET NO.
March 1962	13
CHKD	DRWN
E.R.S.	R.A.B.
OF 25	

SS 210