


NOTE:
As-Built invert elevations are not field surveyed. Where manholes were moved from original locations or where manholes were added, inverts were calculated using slopes from original plans and distances as furnished for As-Built.

"AS - BUILT"

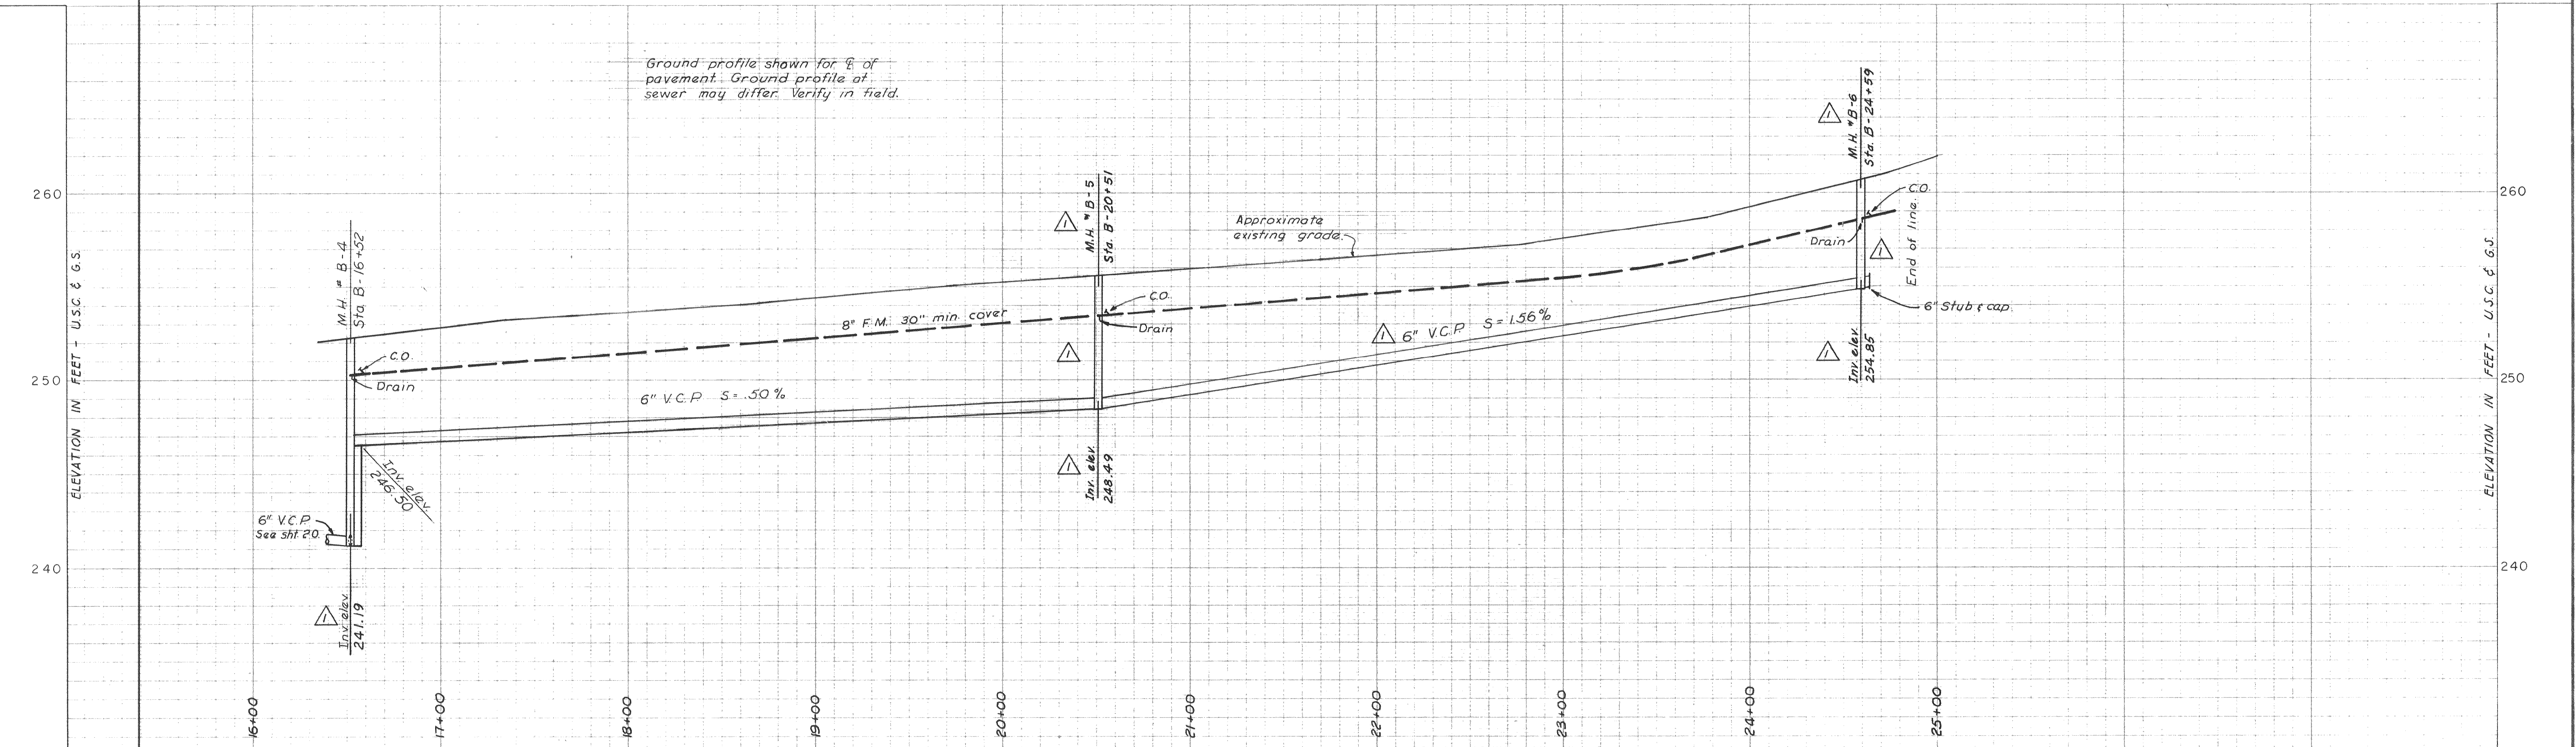

DEWANTE AND STOWELL
SANITARY AND CIVIL ENGINEERS - SACRAMENTO, CALIFORNIA.

REVISION	DATE	DESCRIPTION	BY	APPD.
△ AB	8/26/63	Revised manhole stationing, location, and invert elevations.	HNH RNE	ERS

SUBMITTED:
Edwin R. Stowell

APPROVED:
[Signature]

CITY OF OROVILLE
OROVILLE, CALIFORNIA

MUNICIPAL SEWER DISTRICT NO. 1 SANITARY SEWER PROJECT

PLAN AND PROFILE - "B" LINE

DATE: March 1962	SHEET NO. 11
CHKD: E.R.S.	DRWN: R.A.B.
OF 25	