


Note:
Water & gas services
not shown. Locate in
field prior to trenching.

NOTE: Wyes are marked in field at
property lines by a 2" x 2"
redwood stake.

4 T H . S T .
"B" LINE

Scales:
Horizontal: 1" = 40'-0"
Vertical: 1" = 4'-0"

AS-BUILT
As-built invert elevations are not field surveyed
where manholes were moved from original locations
or where manholes were added, inverts were calculated
using slopes from original plans and distances as
furnished for As-builts.

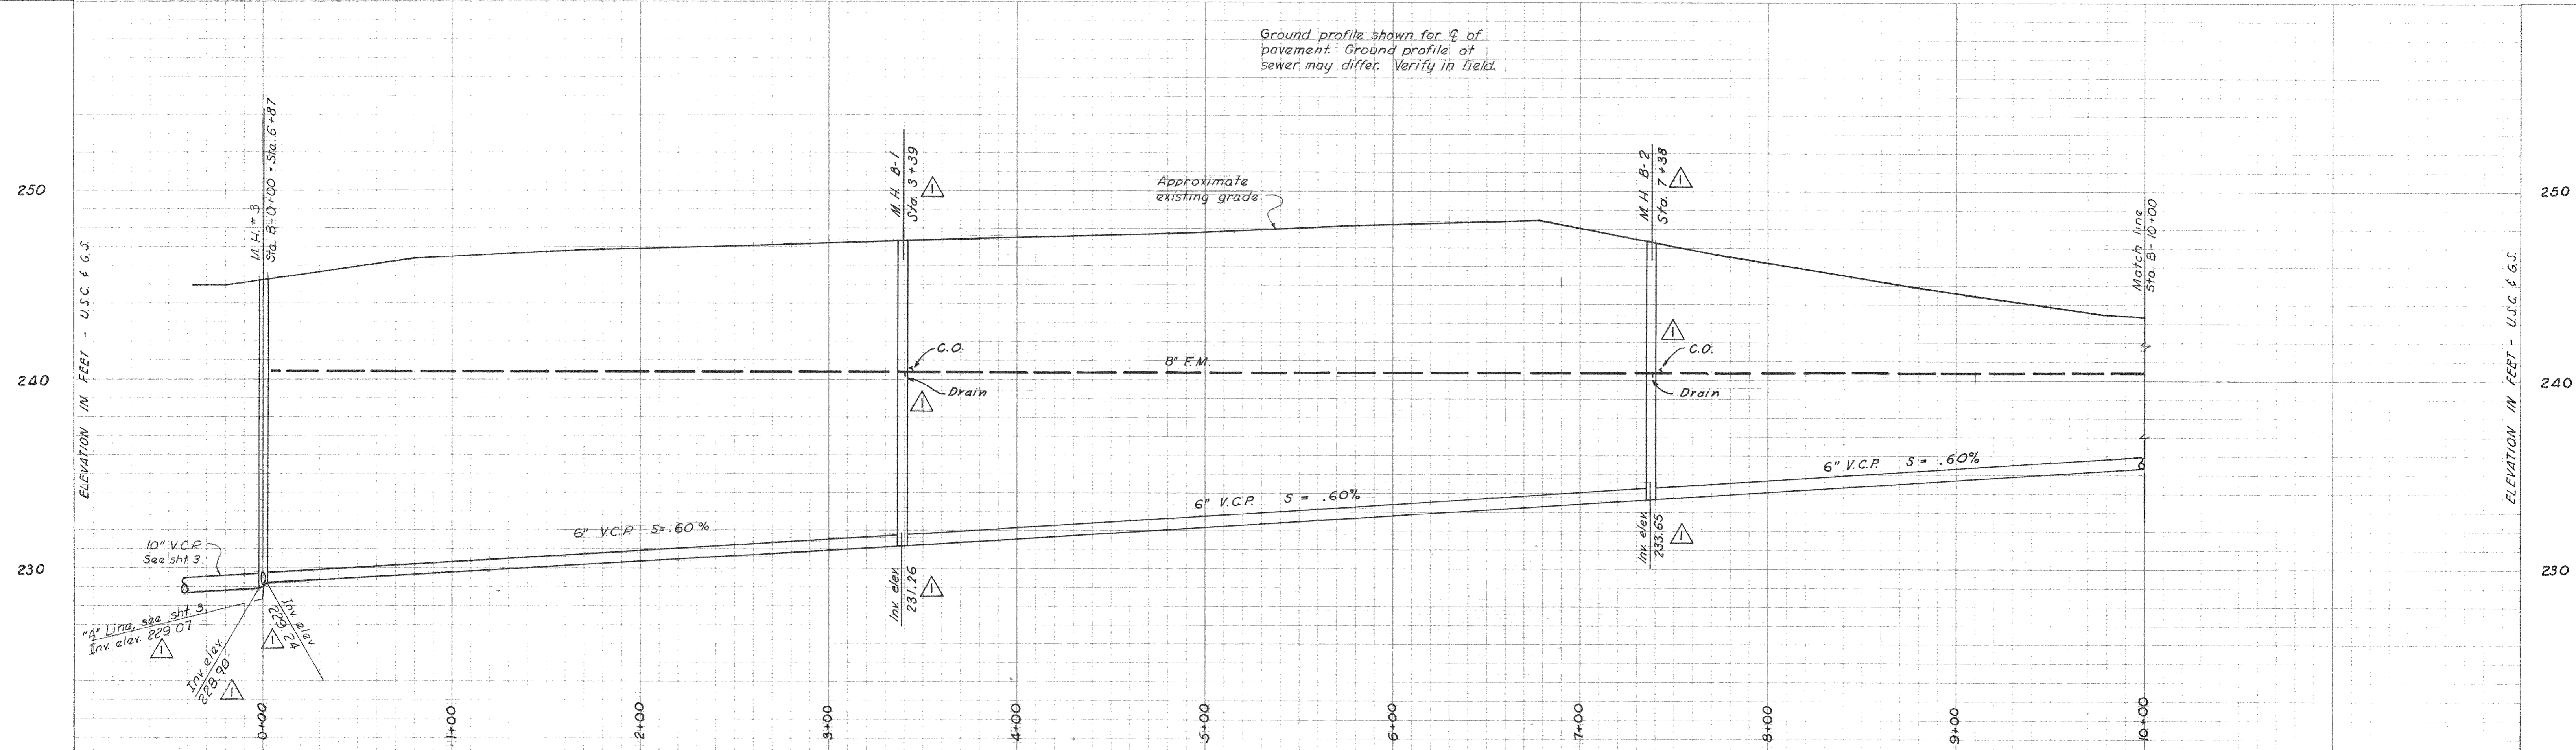

DEWANTE AND STOWELL
SANITARY AND CIVIL ENGINEERS - SACRAMENTO, CALIFORNIA

REVISION	DATE	DESCRIPTION	BY	APPD.
△ AB	8/26/63	Revised manhole stationing, location, and invert elevations.	HNH RNE	ERS

SUBMITTED
Edwin R. Stowell
APPROVED:
R. M. Carpenter

CITY OF OROVILLE
OROVILLE, CALIFORNIA
MUNICIPAL SEWER DISTRICT NO. 1
SANITARY SEWER PROJECT
PLAN AND PROFILE - "B" LINE

DATE	MARCH 1962	SHEET NO	9
CHKD	DRWN	OF 25	
E.R.S.	R.A.B.		

SS206