



DATE: _____
 BY: _____
 SURVEYED: _____
 PLAN: _____
 CHECKED: _____

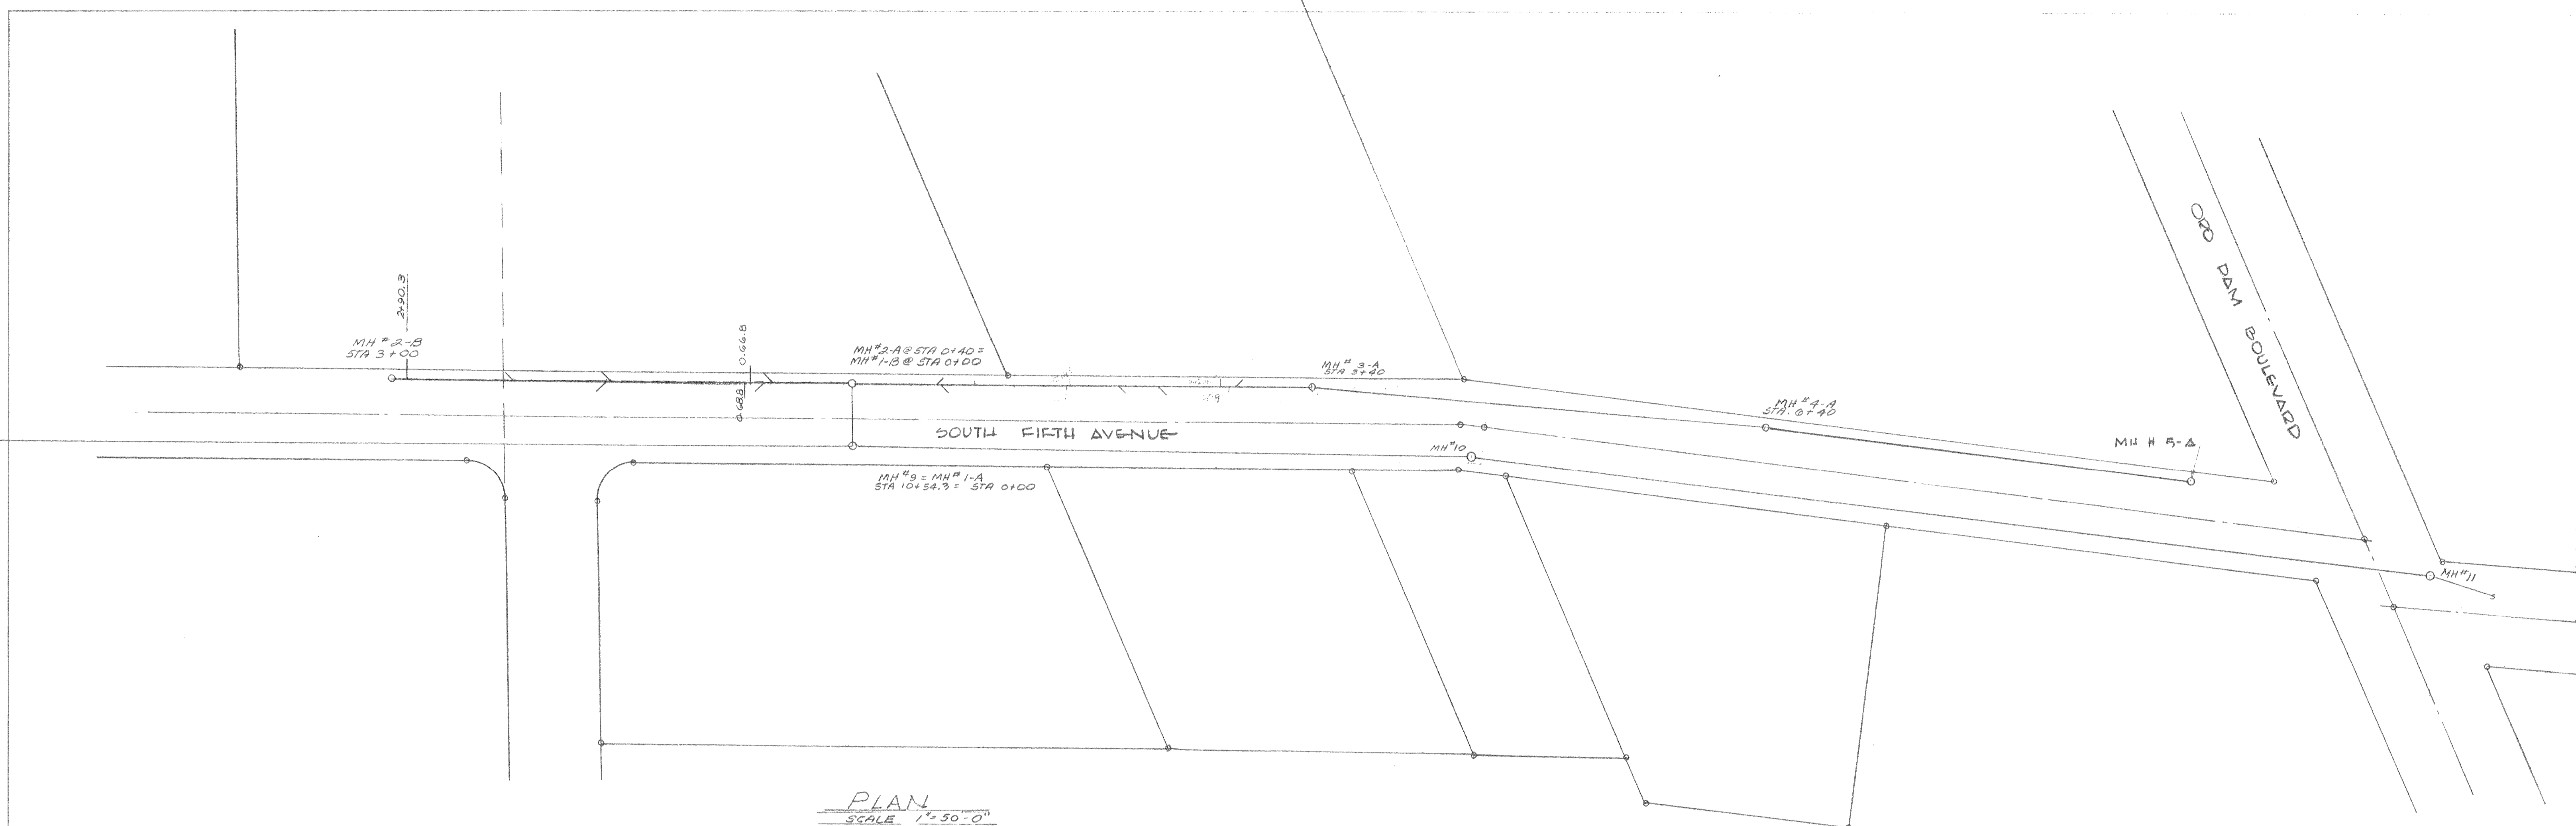

PLAN
 SCALE: 1" = 50'-0"

DATE: _____
 BY: _____
 SURVEYED: _____
 PROFILE: _____
 CHECKED: _____

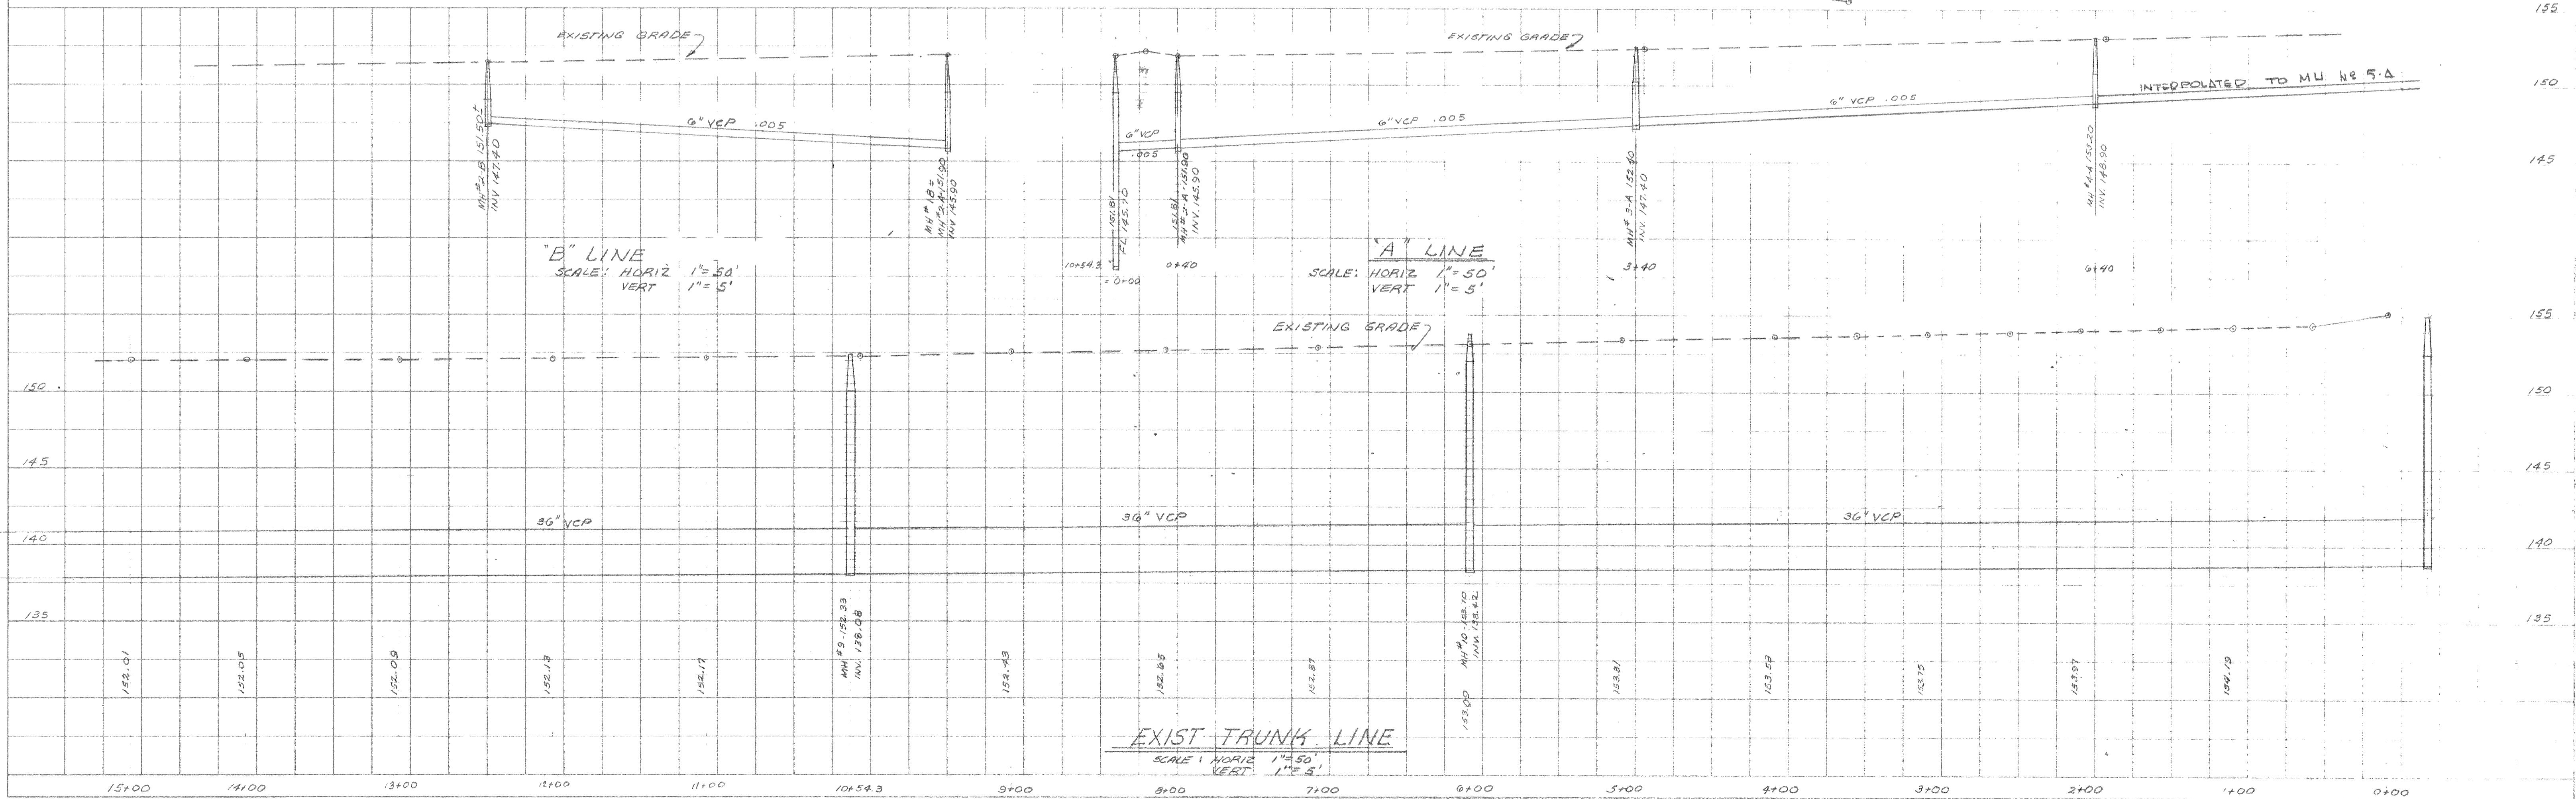

"B" LINE
 SCALE: HORIZ 1" = 50'
 VERT 1" = 5'

"A" LINE
 SCALE: HORIZ 1" = 50'
 VERT 1" = 5'

EXIST TRUNK LINE
 SCALE: HORIZ 1" = 50'
 VERT 1" = 5'

MH# 2-B - 152.11
 INV. 137.69

PLATE 1 PLAN PROFILE

AS BUILTS - LAYERS INDICATED FROM FIELD NOTES ON 8-24-77
 SOUTH FIFTH AVENUE 1962-1963