



CITY OF OROVILLE
BUTTE COUNTY, CALIFORNIA

PLANS FOR CONSTRUCTION OF
SANITARY SEWER TRUNK LINES
(SCHEDULE A)

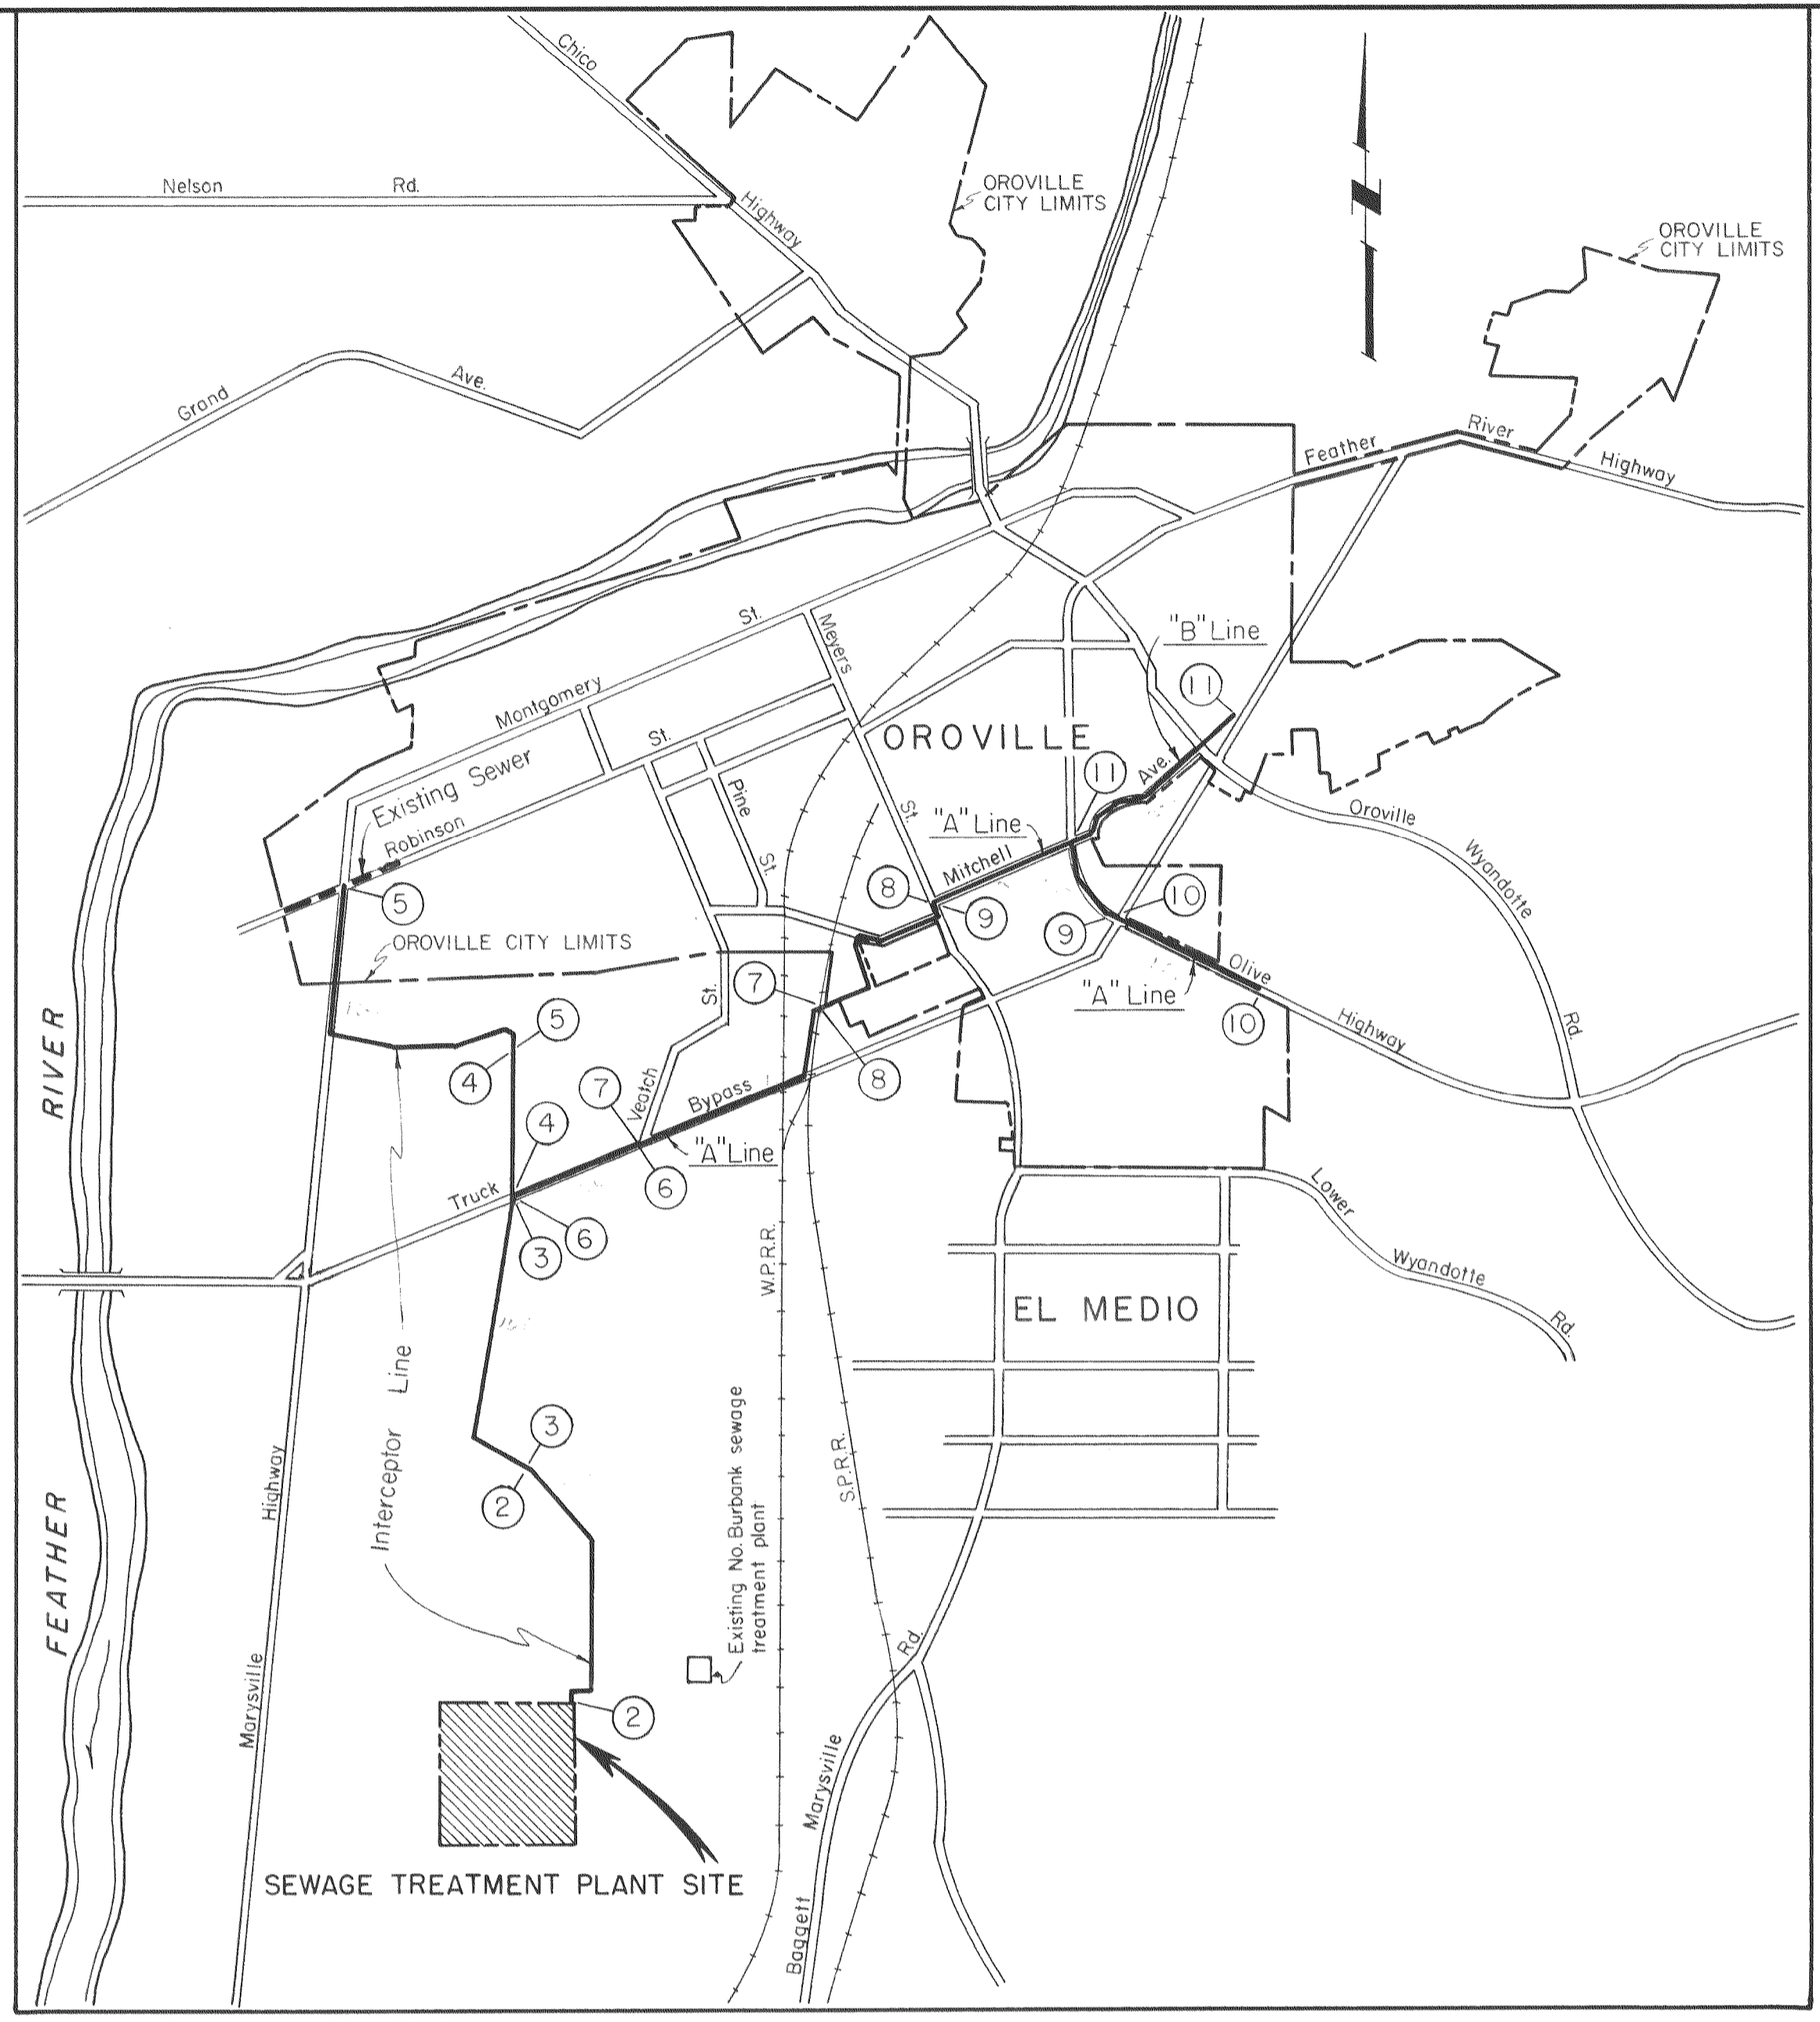

Adopted by City Council of City of Oroville,
April 27, 1959
R.M. Carpenter
R.M. CARPENTER, City Clerk

VICINITY MAP

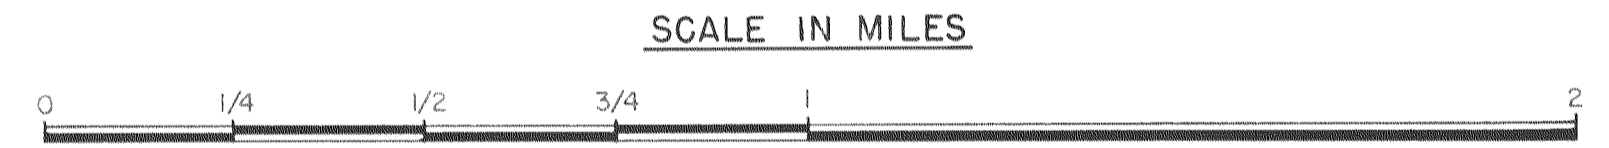

INDEX TO SHEETS

SHEET	TITLE
1	INDEX AND VICINITY MAP
2-5	PLAN & PROFILE INTERCEPTOR LINE
6-10	PLAN & PROFILE "A" LINE
11	PLAN & PROFILE "B" LINE
12	MANHOLE DETAILS

LEGEND

	R/W line
	Water line
	Gas line
	Manhole
	Edge of pavement
	Culvert
	Stream
	Power pole
	Tree
	Large ditch
	Centerline
	Underground Cable
	Fence
	Bench mark
	Existing sewer
	Water valve

- NOTES:
- ③ Denotes sheets on which plan & profile are shown.
 - All elevations shown on profiles are U.S.G.S. Datum.
 - Depth of underground utilities shown in profile are approx. only unless elev. indicated.
 - All manholes to be set flush with finish grade unless otherwise indicated.
 - All stubs to be V.C., size as noted, one section long. Provide stopper with lime mortar.

AS BUILT

CITY OF OROVILLE
BUTTE COUNTY, CALIFORNIA

SANITARY SEWER TRUNK LINES
INDEX AND VICINITY MAP

DEWANTE AND STOWELL
SANITARY AND CIVIL ENGINEERS—SACRAMENTO, CALIFORNIA

DRAWN: L.R.K.	SUBMITTED: <i>R.D. Stowell</i>	SHEET NO. 1
CHECKED: R.H.D.	APPROVED: <i>R.D. Stowell</i>	1
DATE: Mar. 1959	<i>R.M. Carpenter</i>	of 12