




SECTION A-A 26  
Scale: 1/2" = 1'-0"

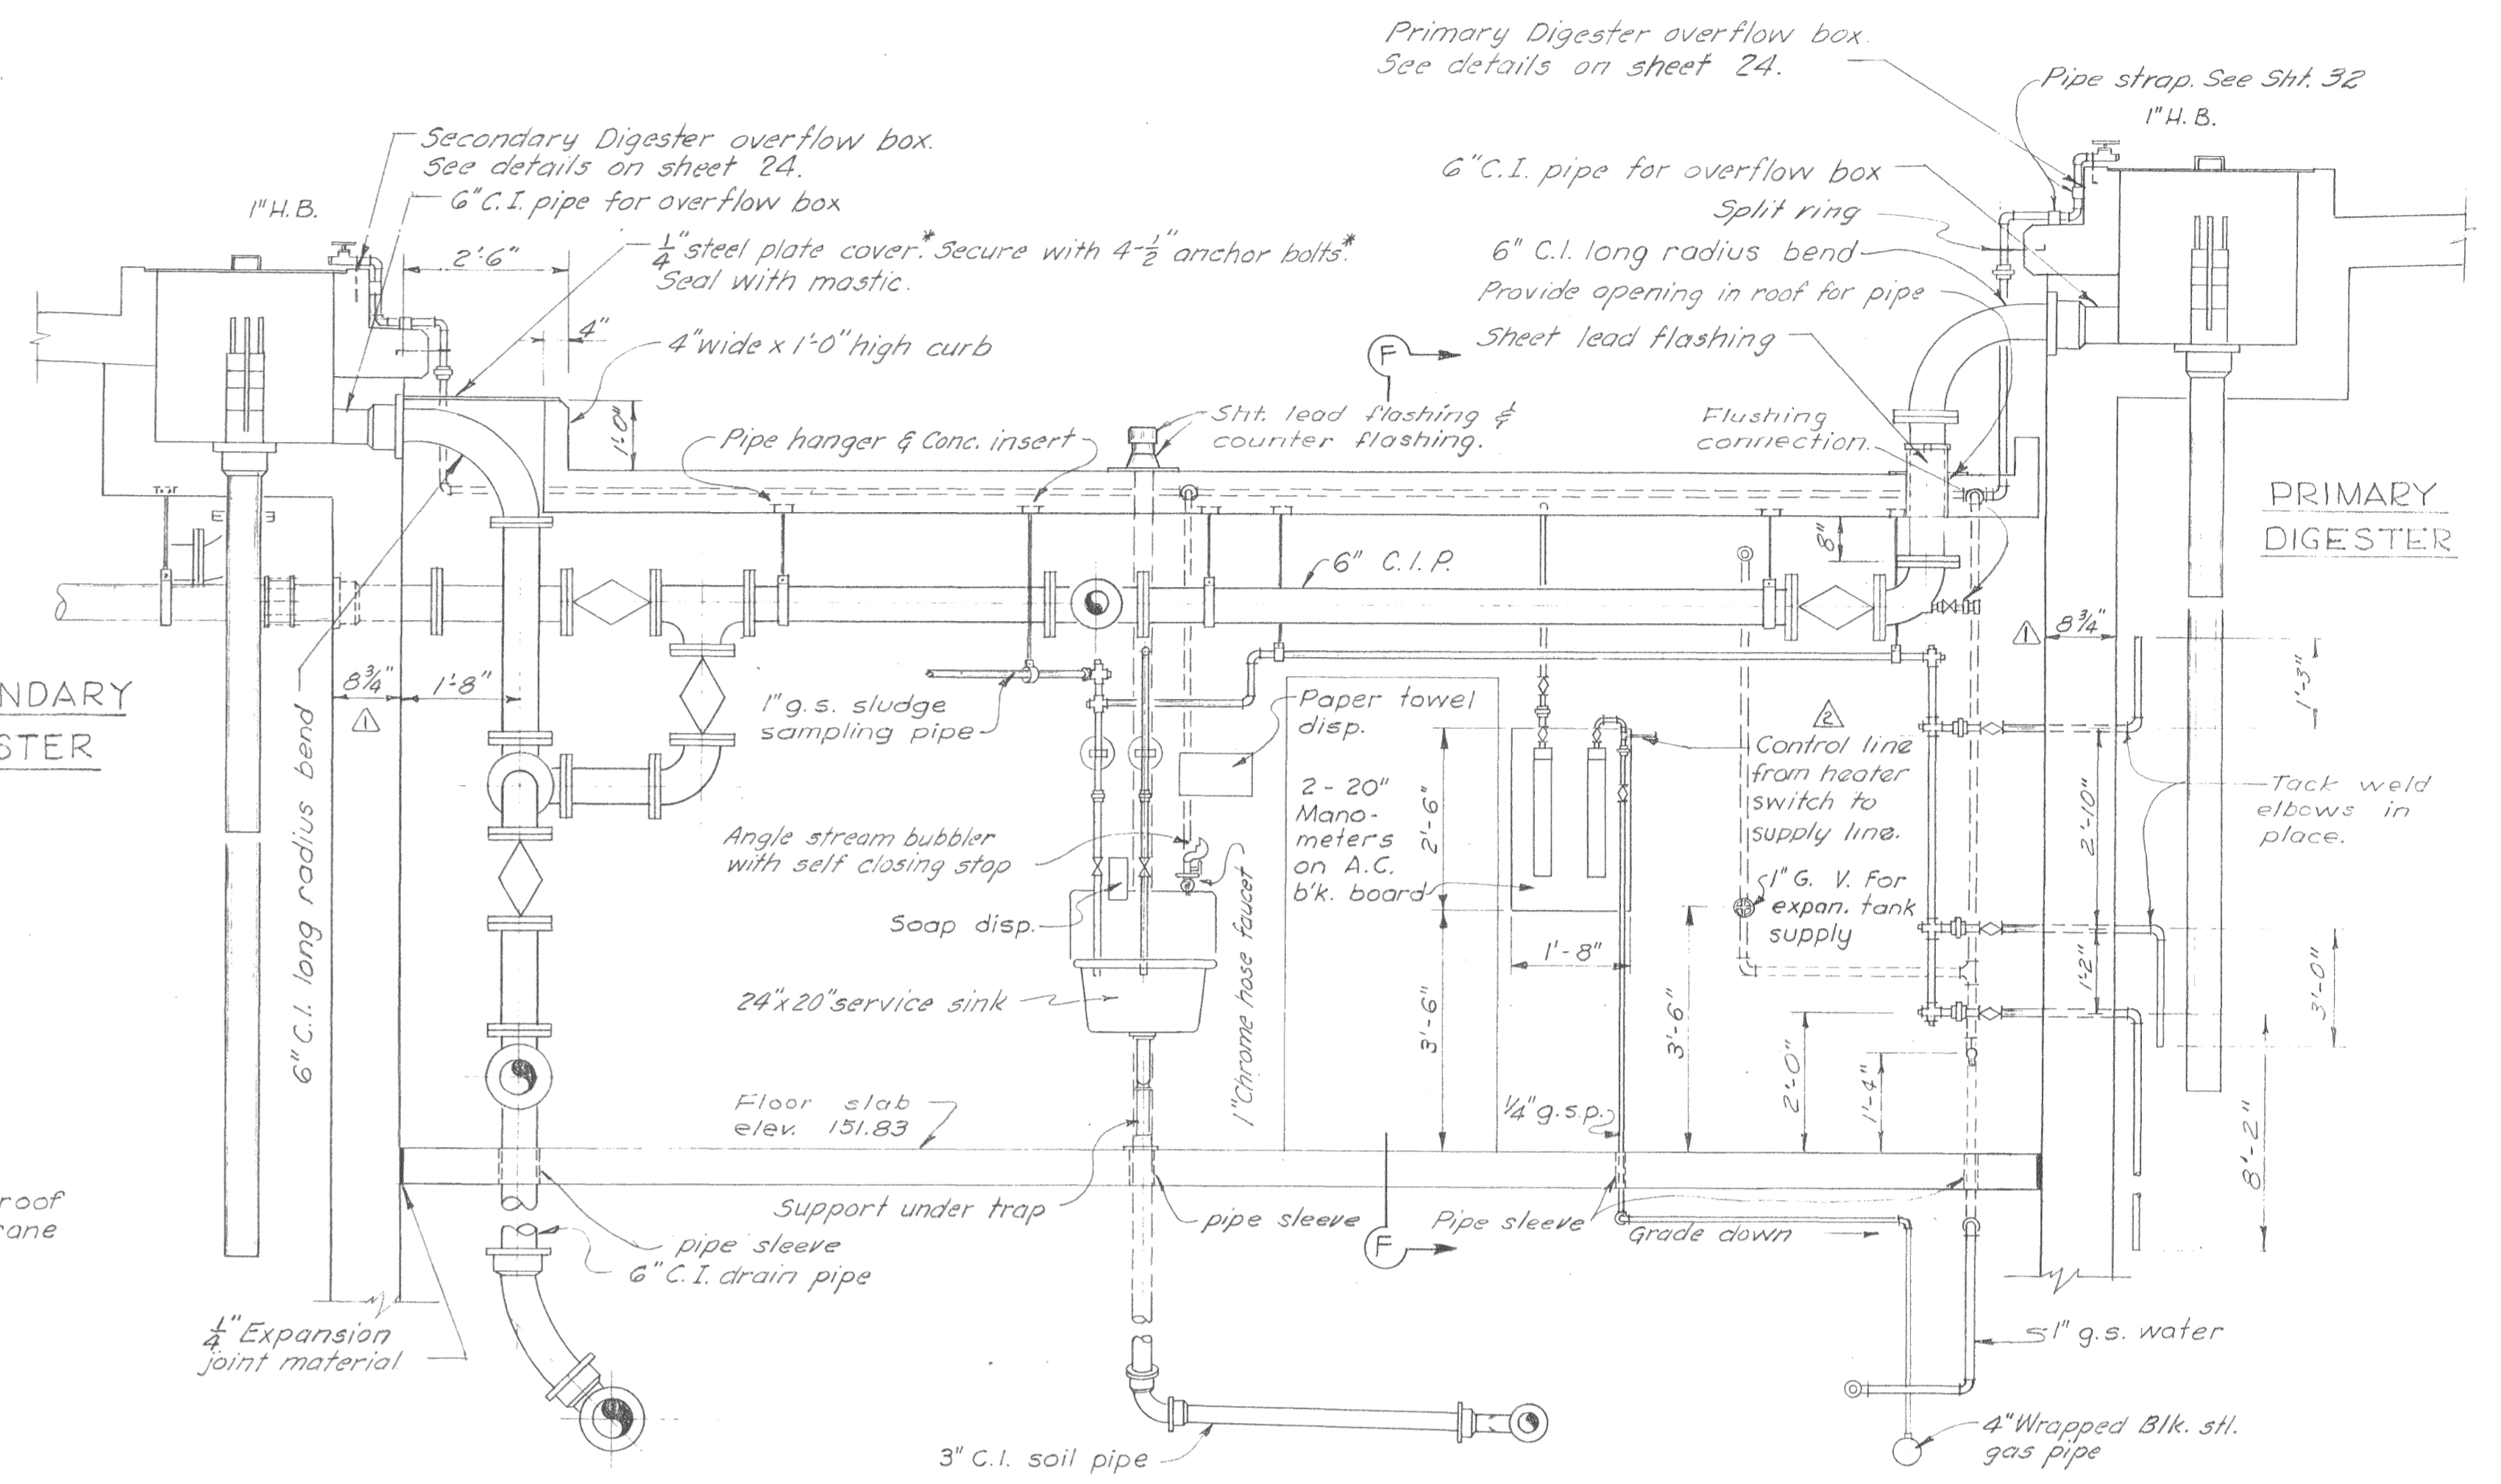

SECTION C-C 26  
Scale: 1/2" = 1'-0"

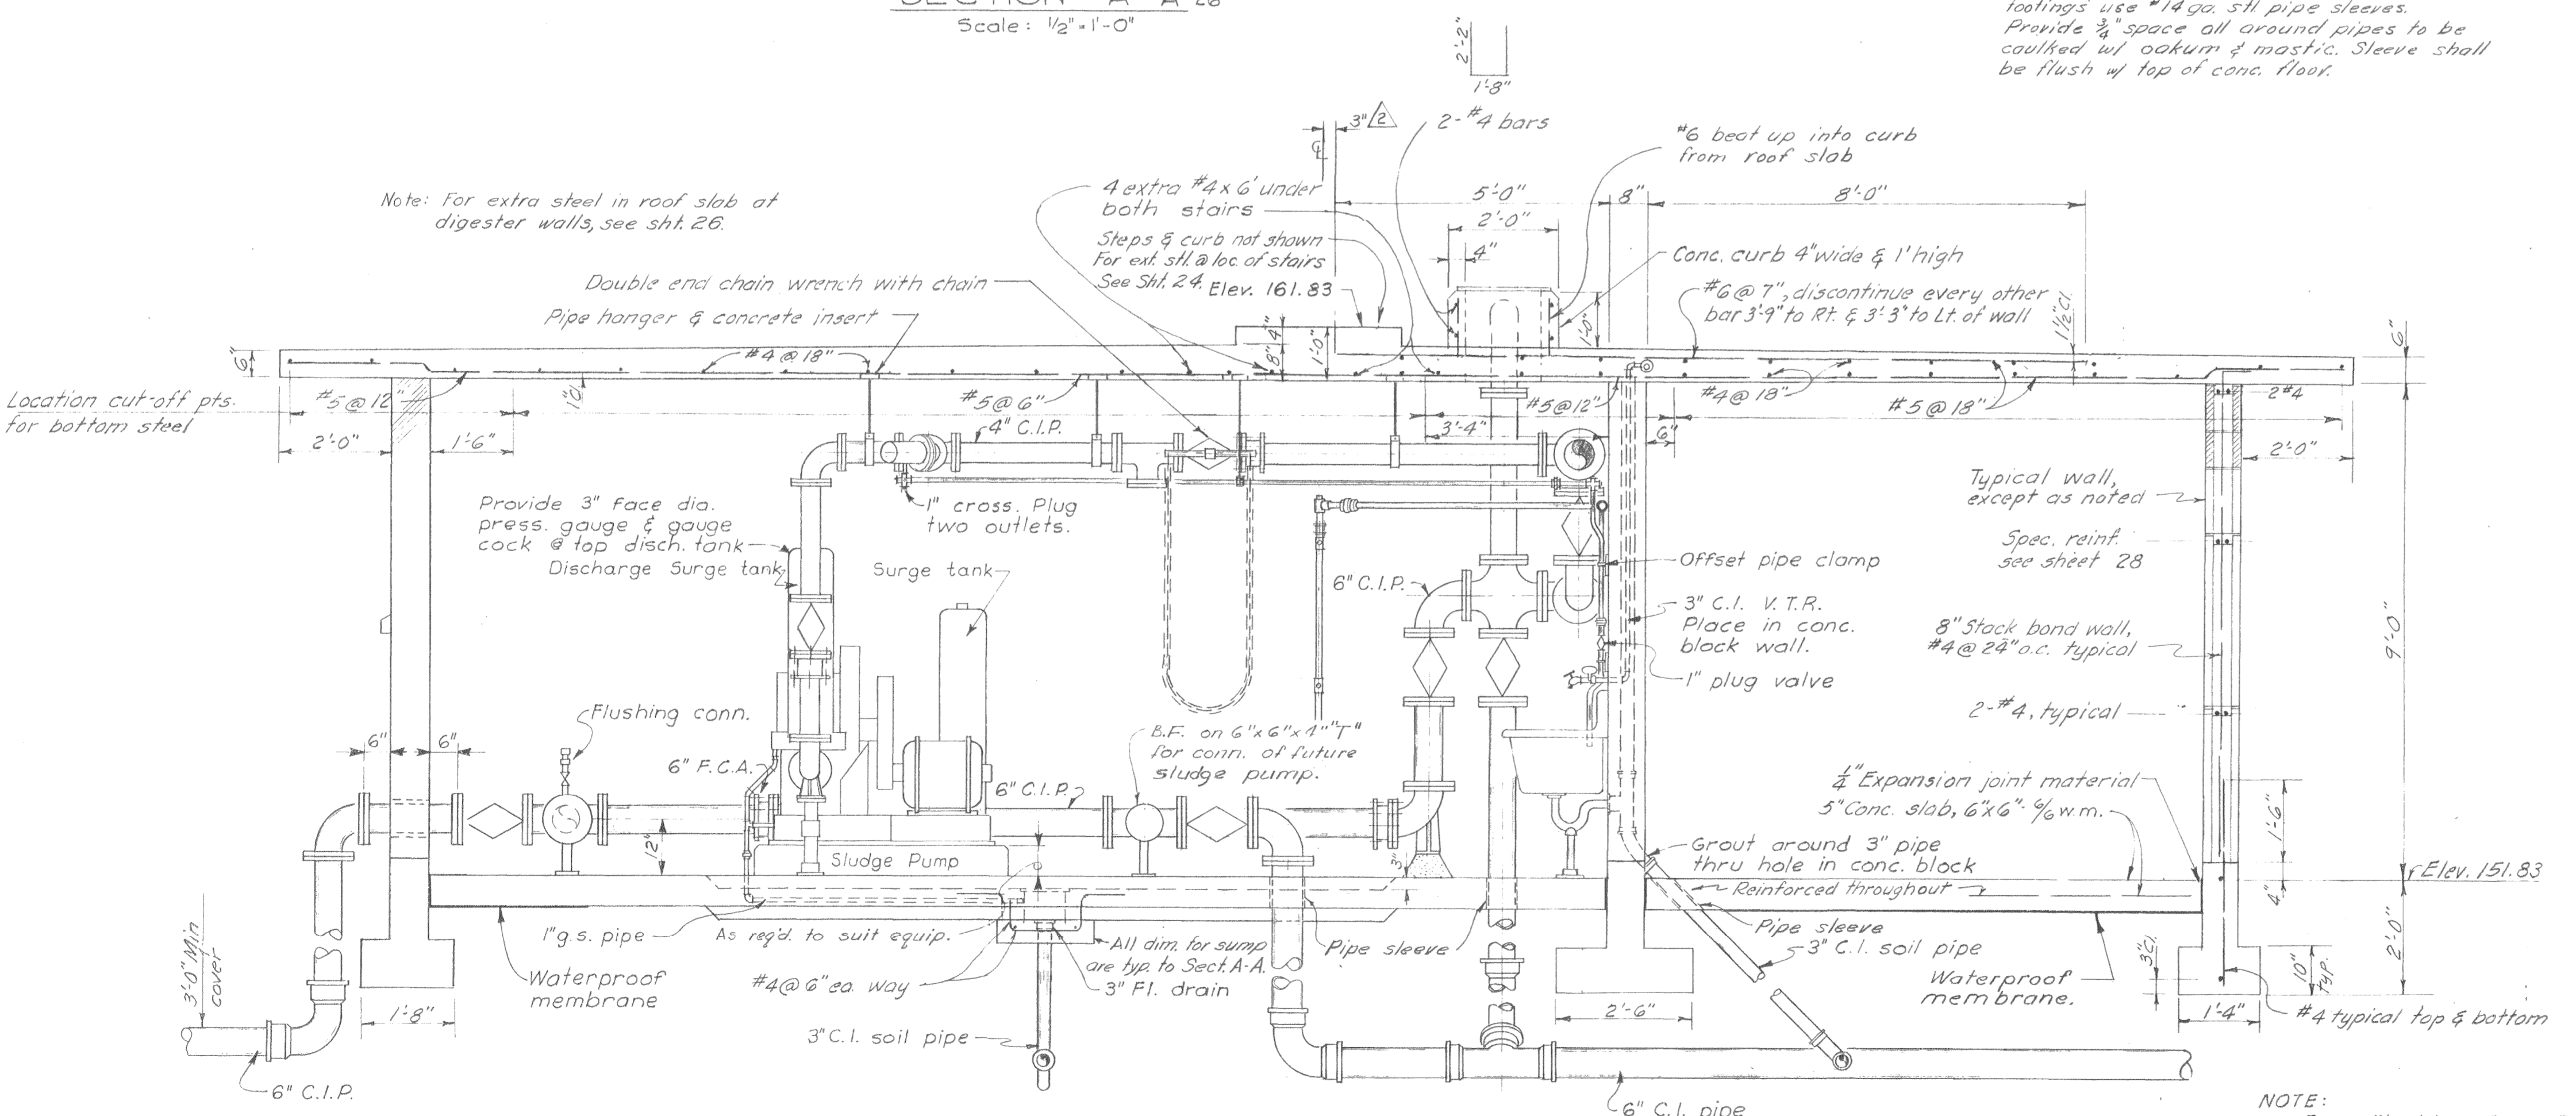

SECTION B-B 26  
Scale: 1/2" = 1'-0"

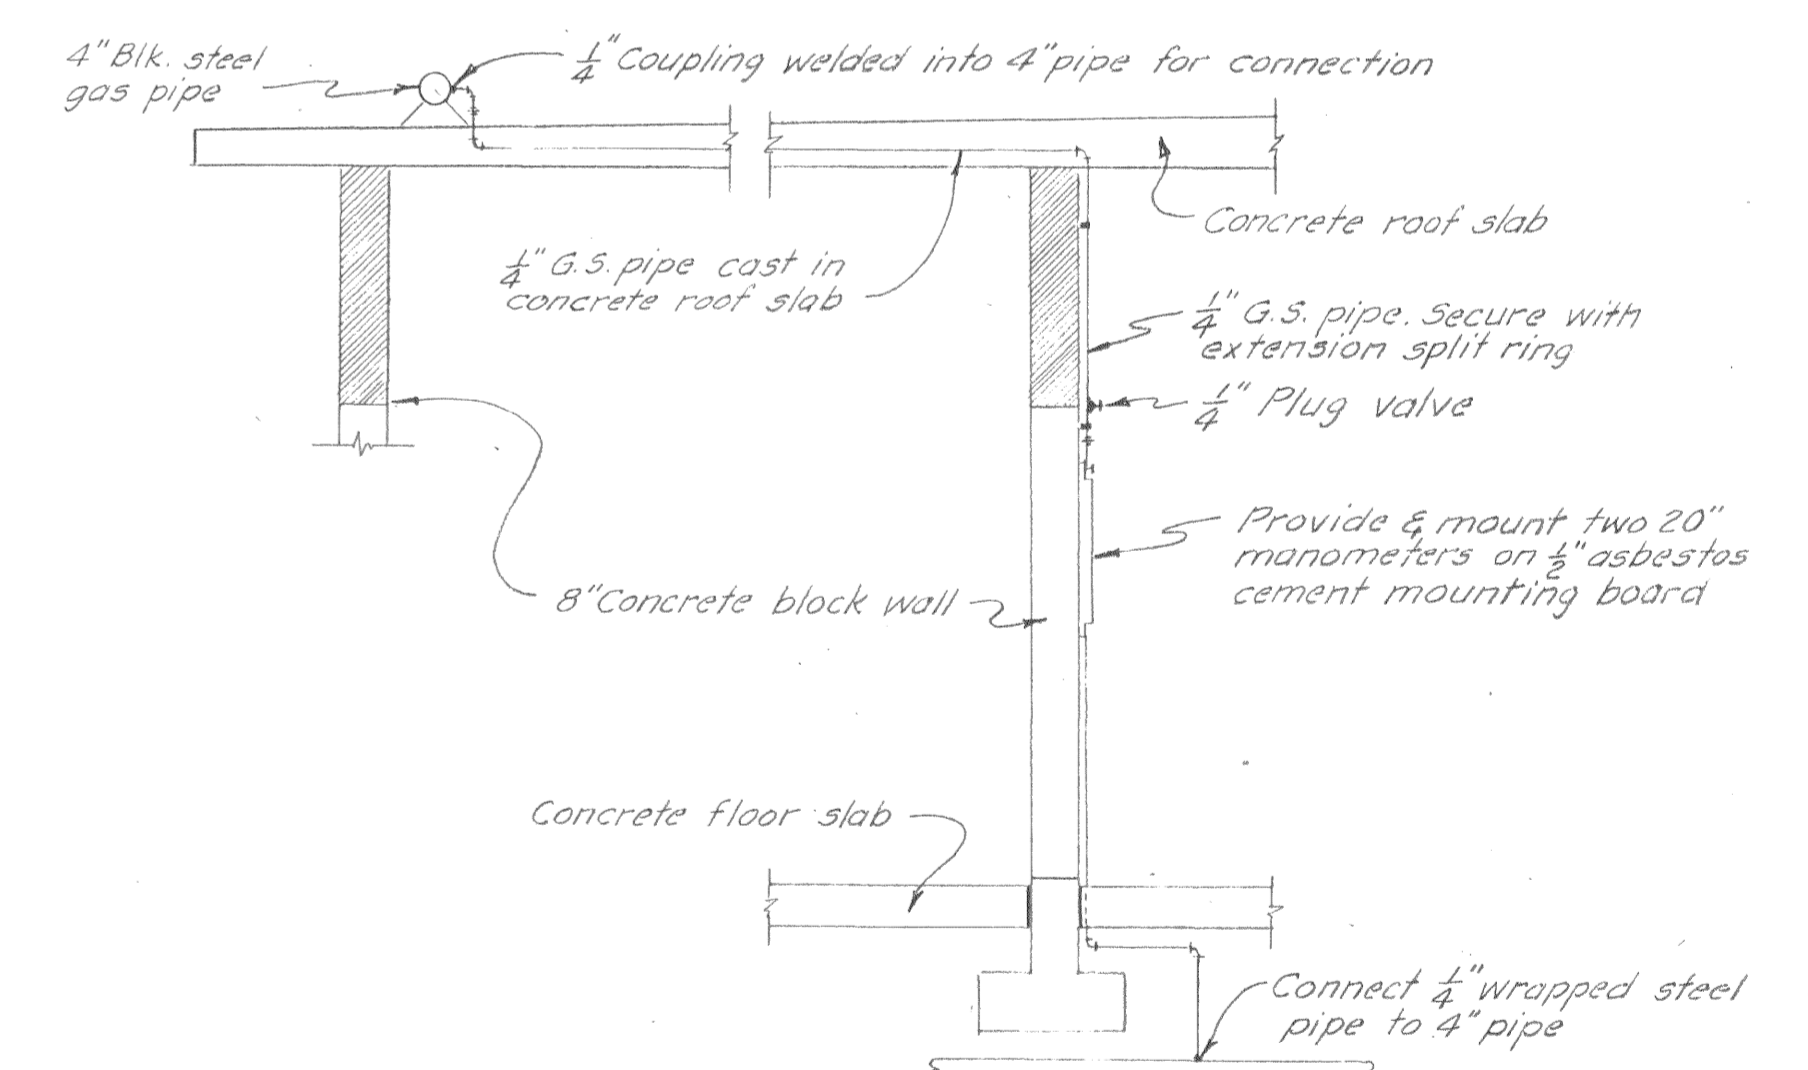

SECTION F-F  
Scale: 3/8" = 1'-0"

NOTE: For Flushing Conn. Detail, see sh. 32.

AS BUILT

REV	DATE	DESCRIPTION	BY	APP
ADD		NOTES & COUNTER FLASHING	RAB	PHD
REV	8-13-51	REVISED DUE TO PRESTRESSED DESIGN	G.L.	PHD

CITY OF OROVILLE  
BUTTE COUNTY, CALIFORNIA  
SEWAGE TREATMENT PLANT  
SLUDGE CONTROL BUILDING  
MECHANICAL & STRUCTURAL

DEWANTE AND STOWELL  
SANITARY AND CIVIL ENGINEERS - SACRAMENTO, CALIFORNIA

DRAWN: J. D. J.  
CHECKED: R.H.D.  
DATE: Mar. 1959

SUBMITTED: [Signature]  
APPROVED: [Signature]

SHEET NO. 27  
OF 36