




PLAN
Scale: $\frac{3}{4}$ " = 1'-0"

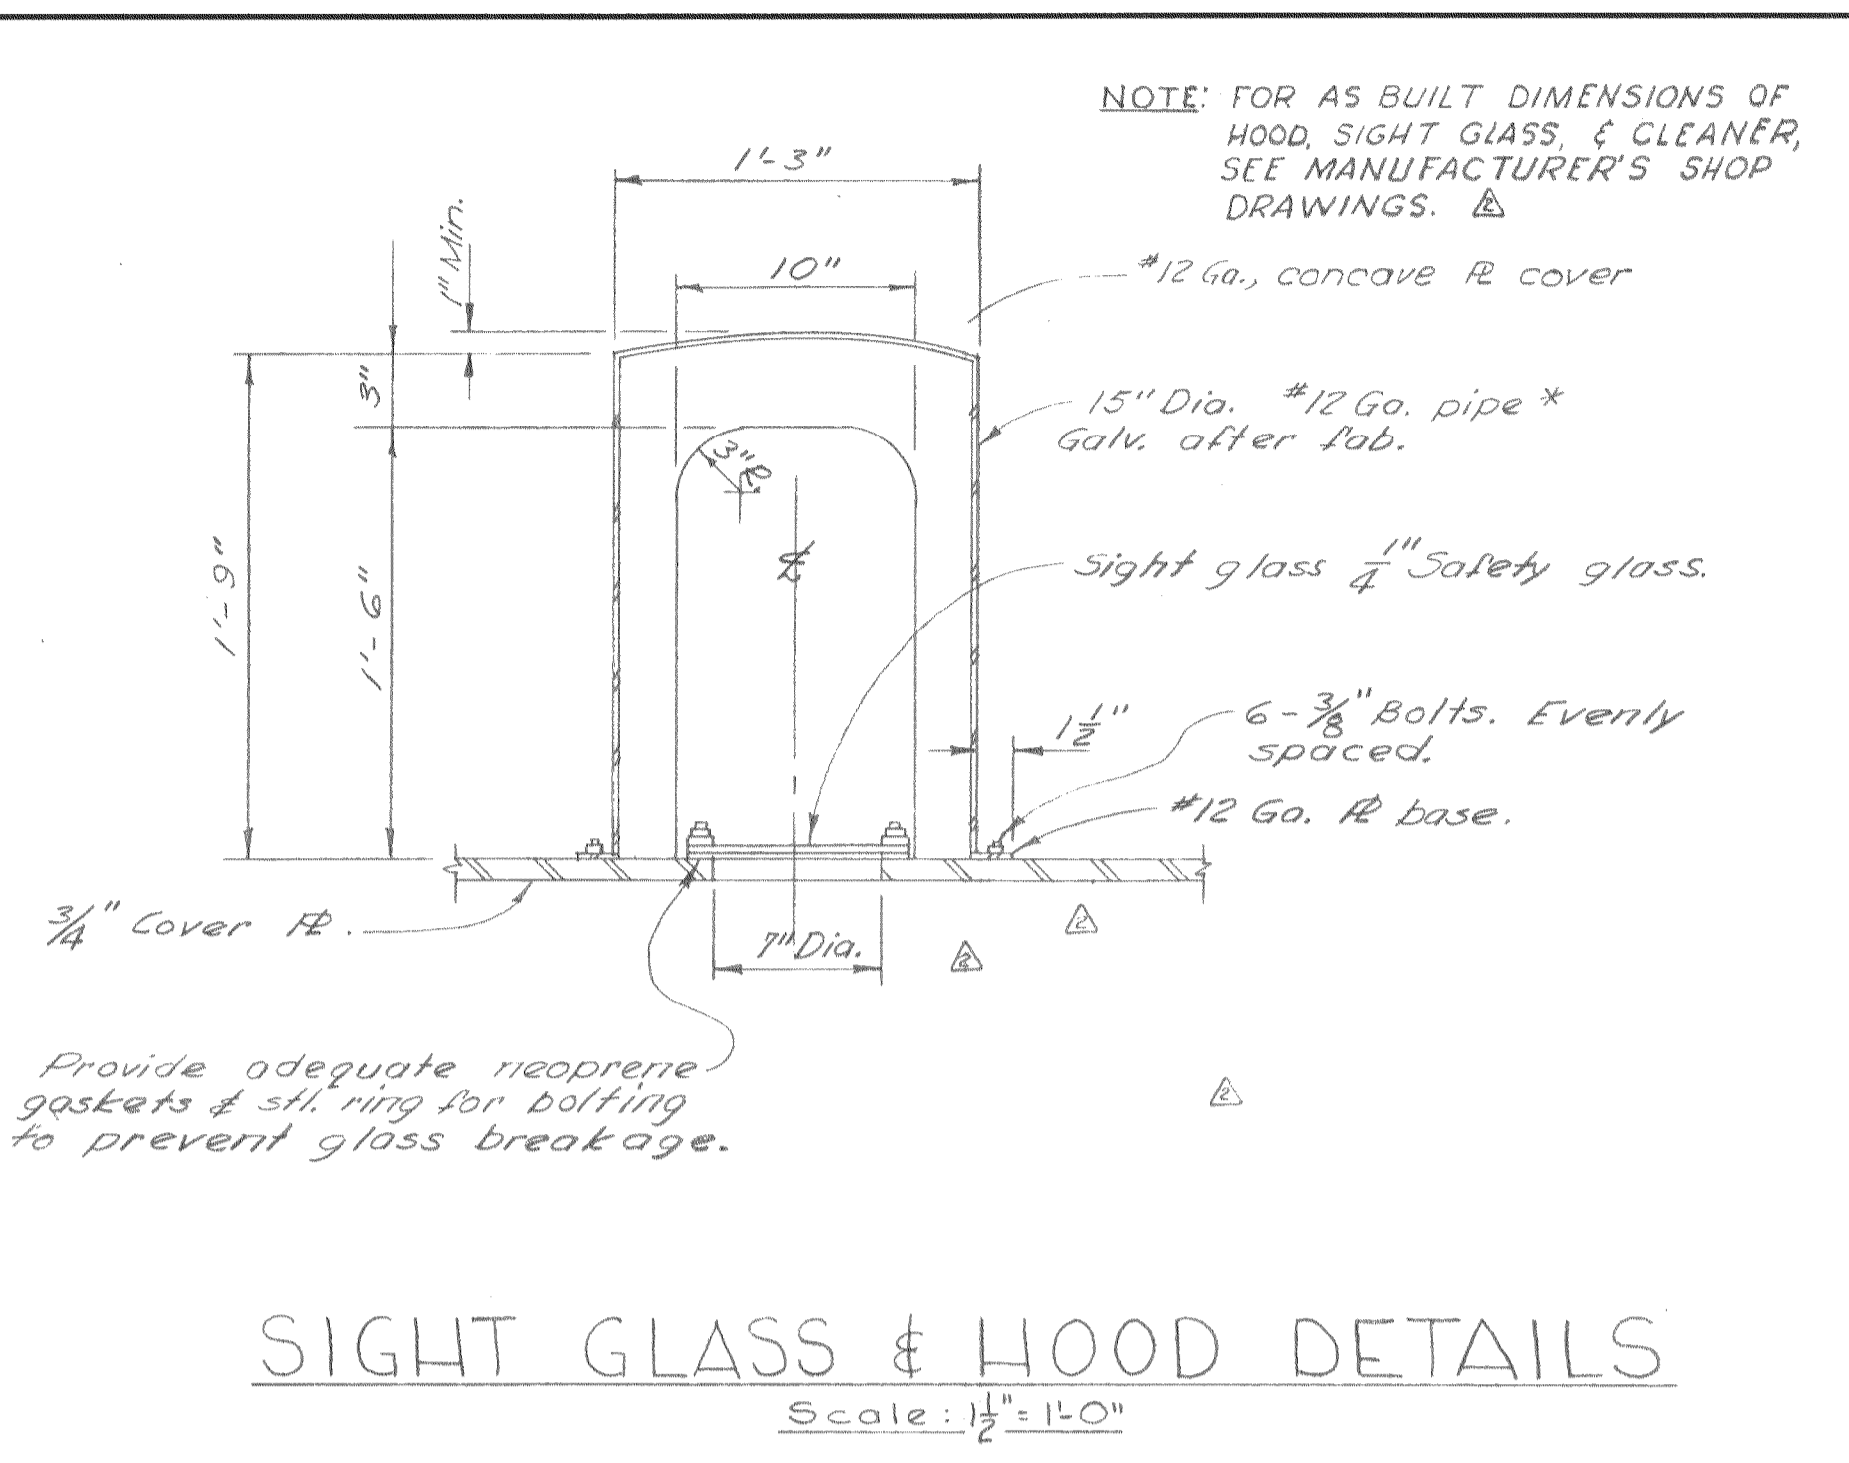


SIGHT GLASS & HOOD DETAILS
Scale: $\frac{1}{2}$ " = 1'-0"

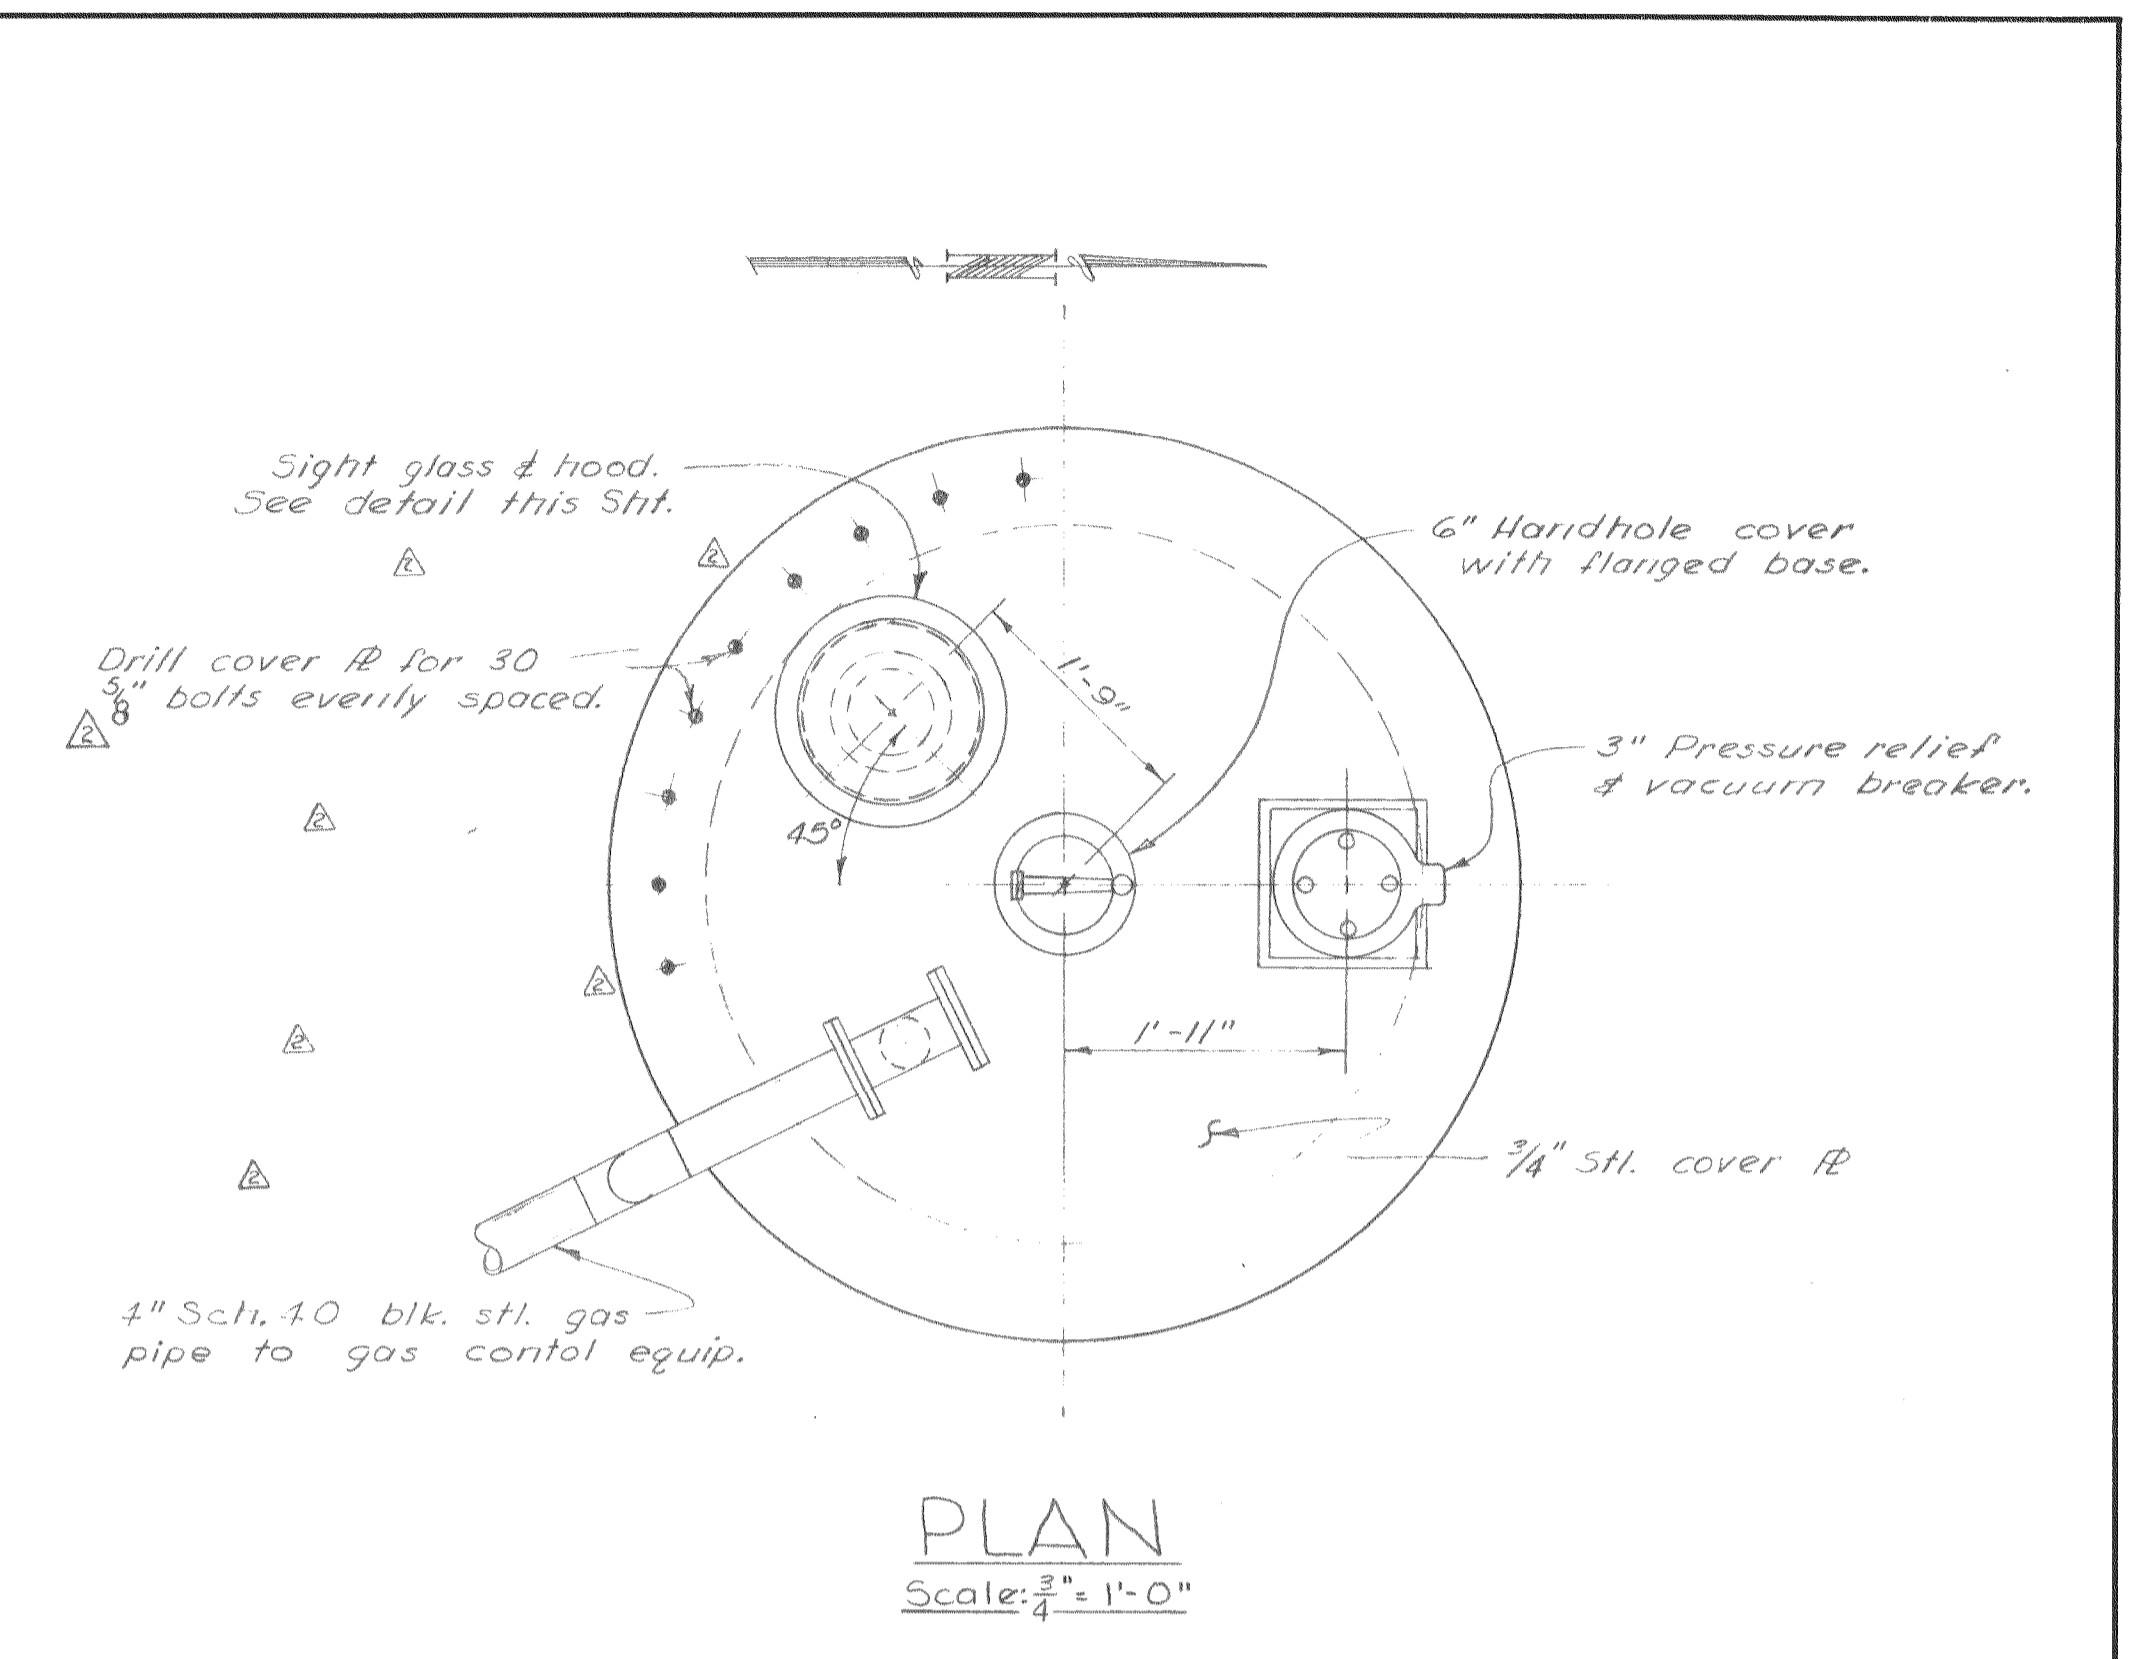


PLAN
Scale: $\frac{3}{4}$ " = 1'-0"

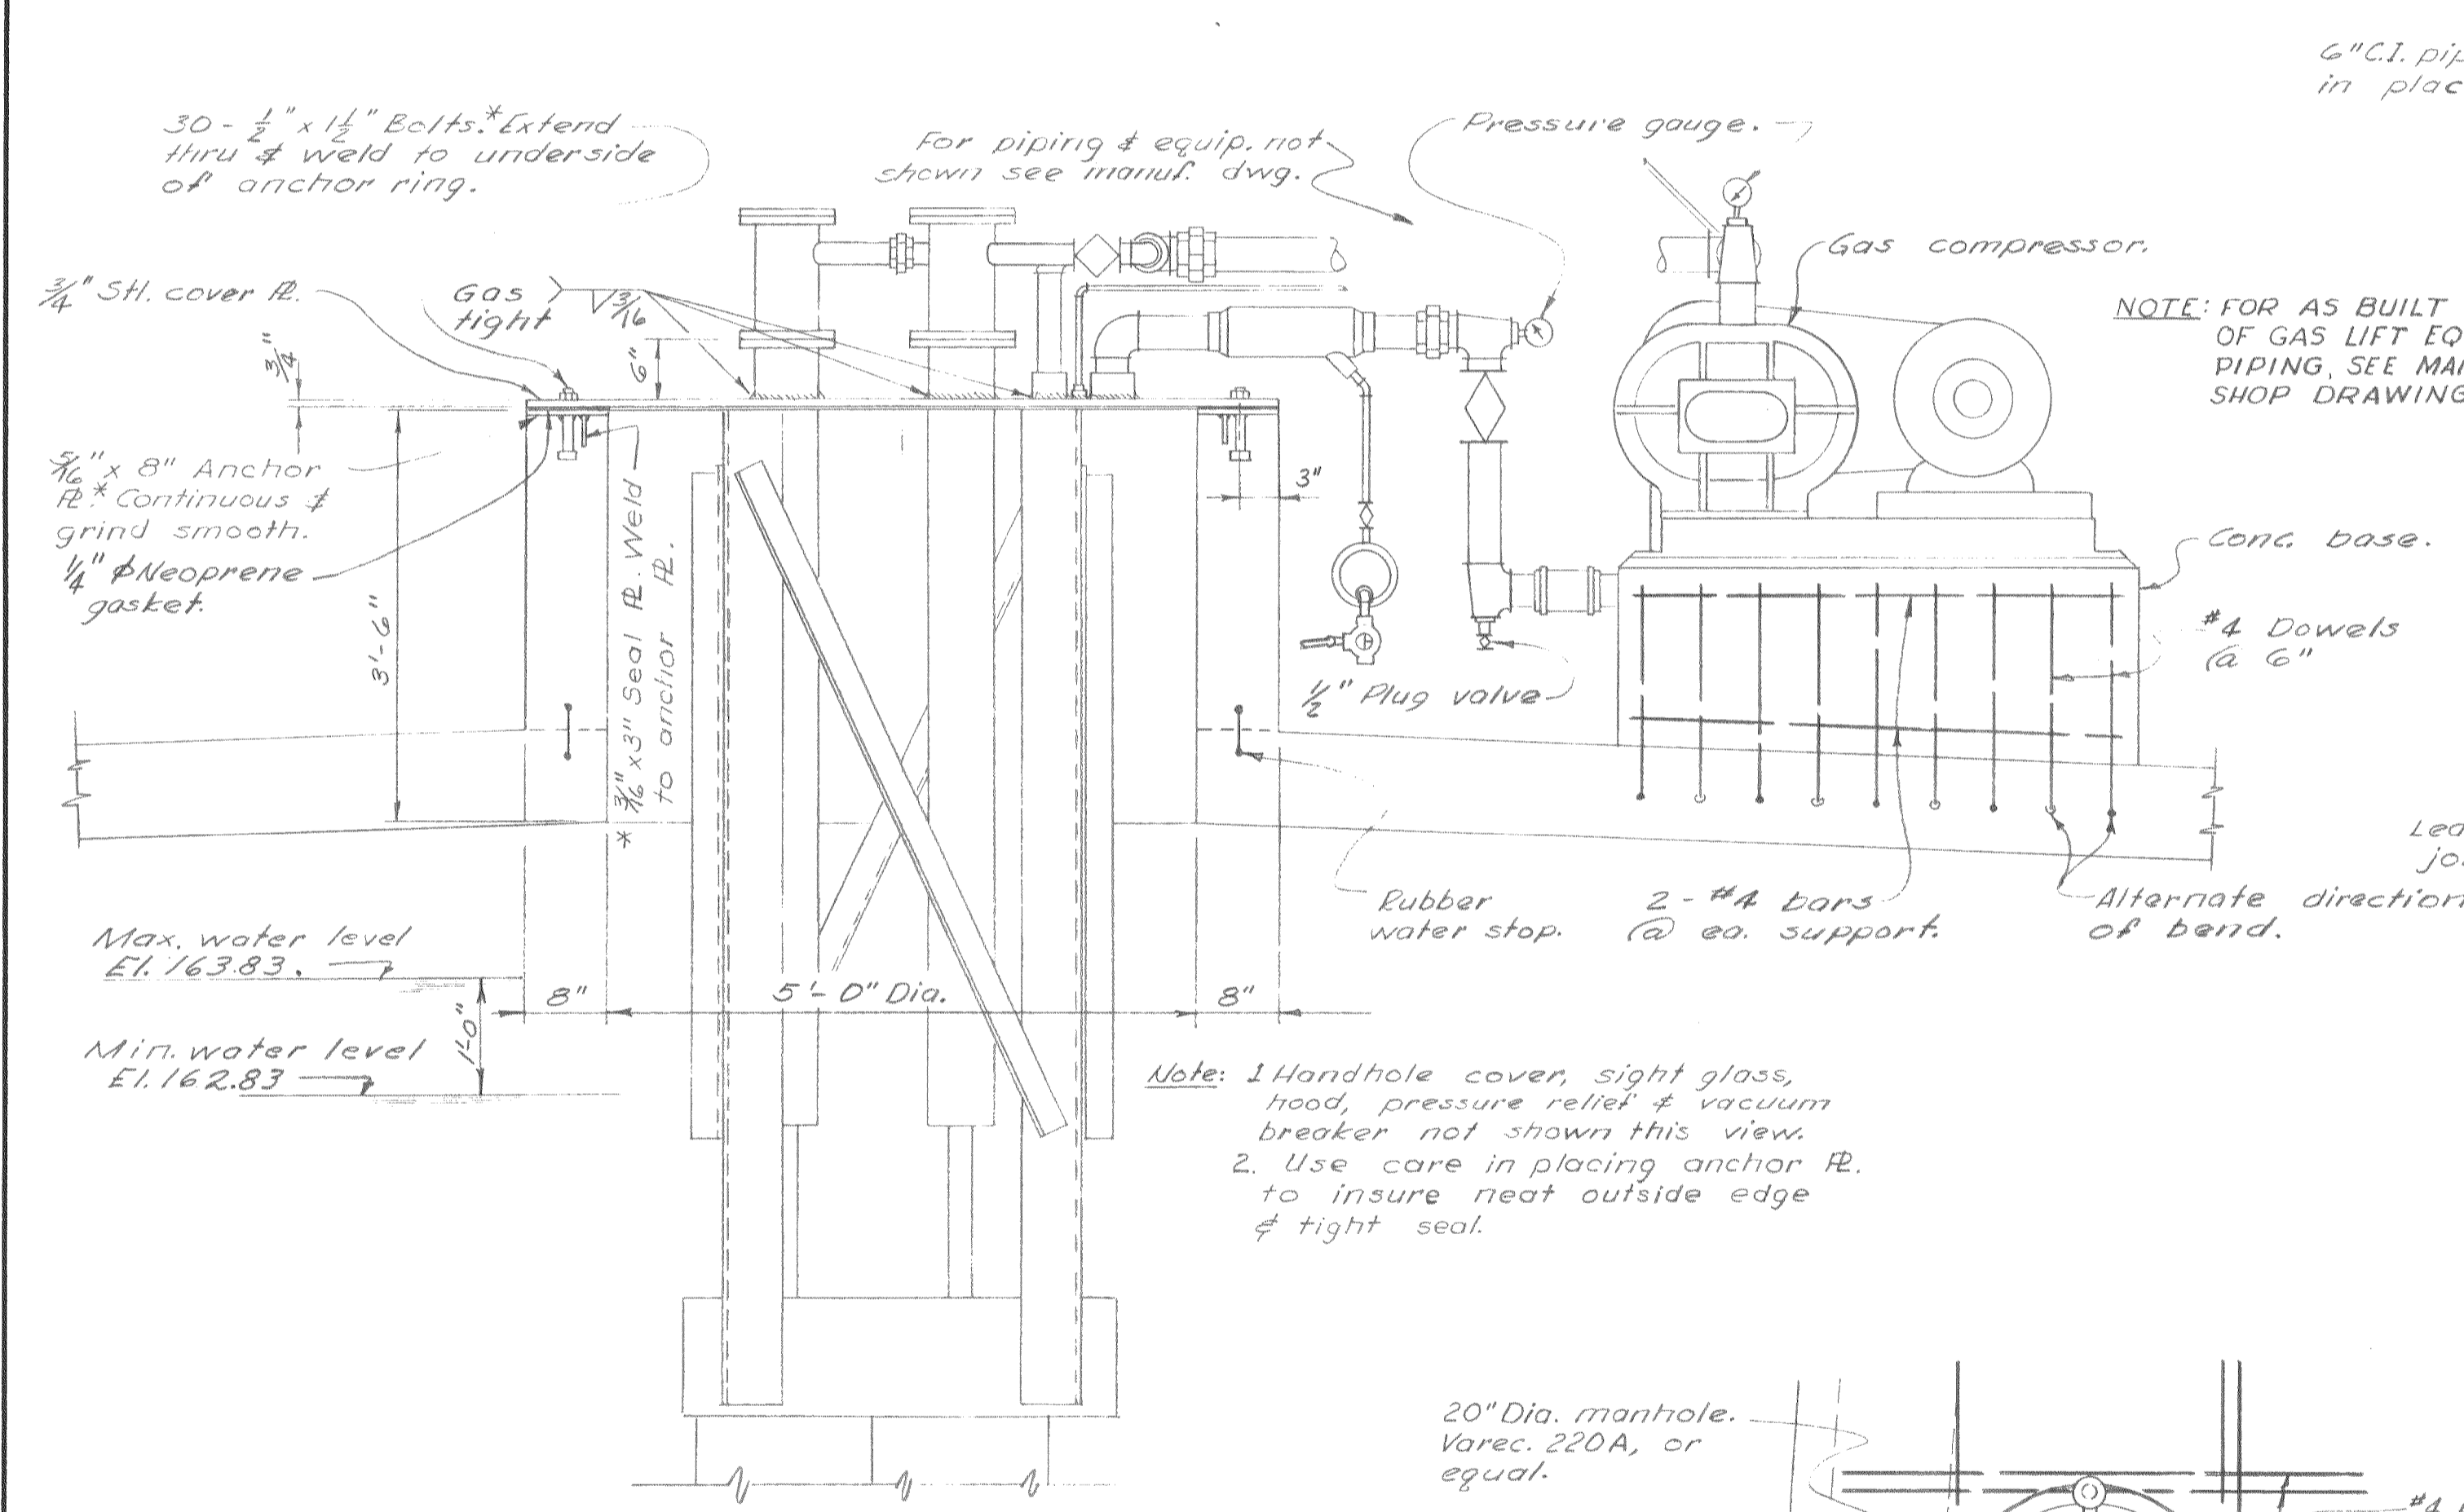


ELEVATION
Scale: $\frac{3}{4}$ " = 1'-0"
PRIMARY GAS DOME

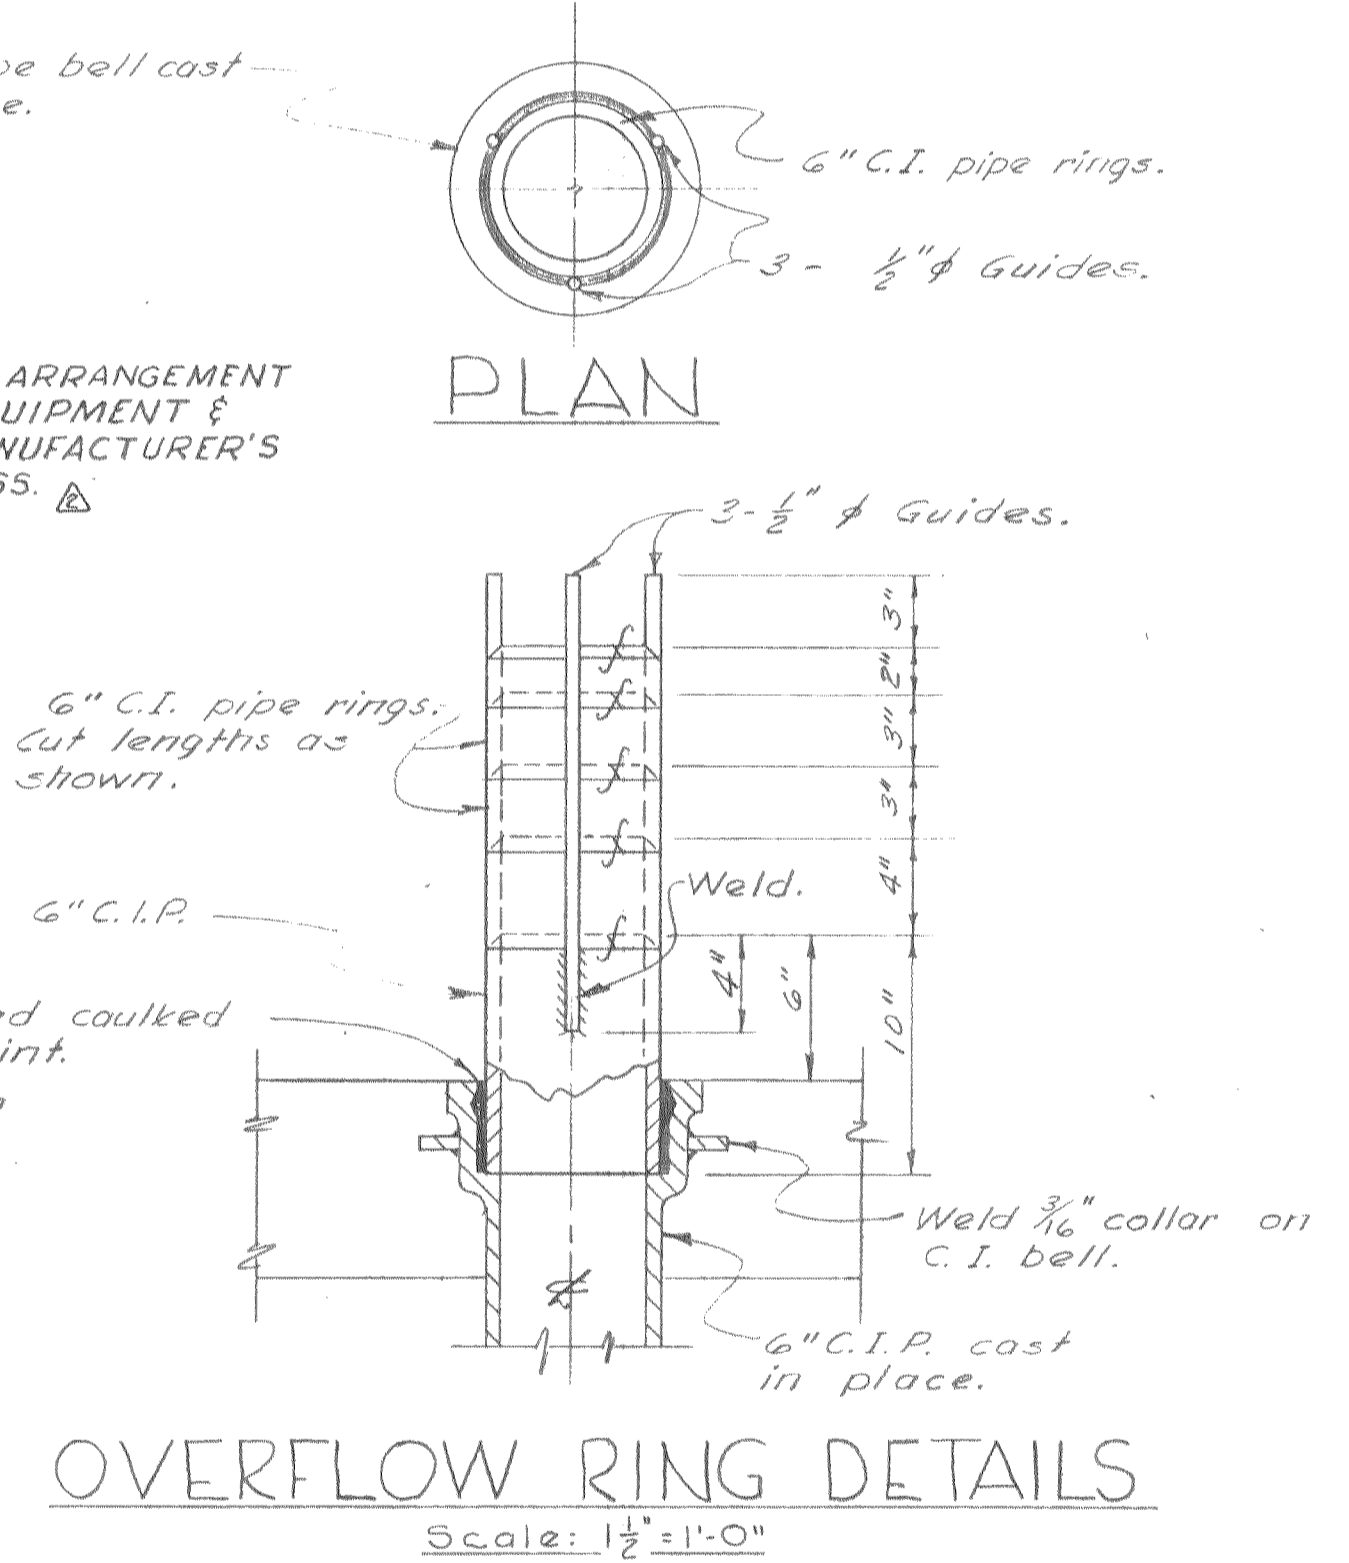


OVERFLOW RING DETAILS
Scale: $\frac{1}{2}$ " = 1'-0"

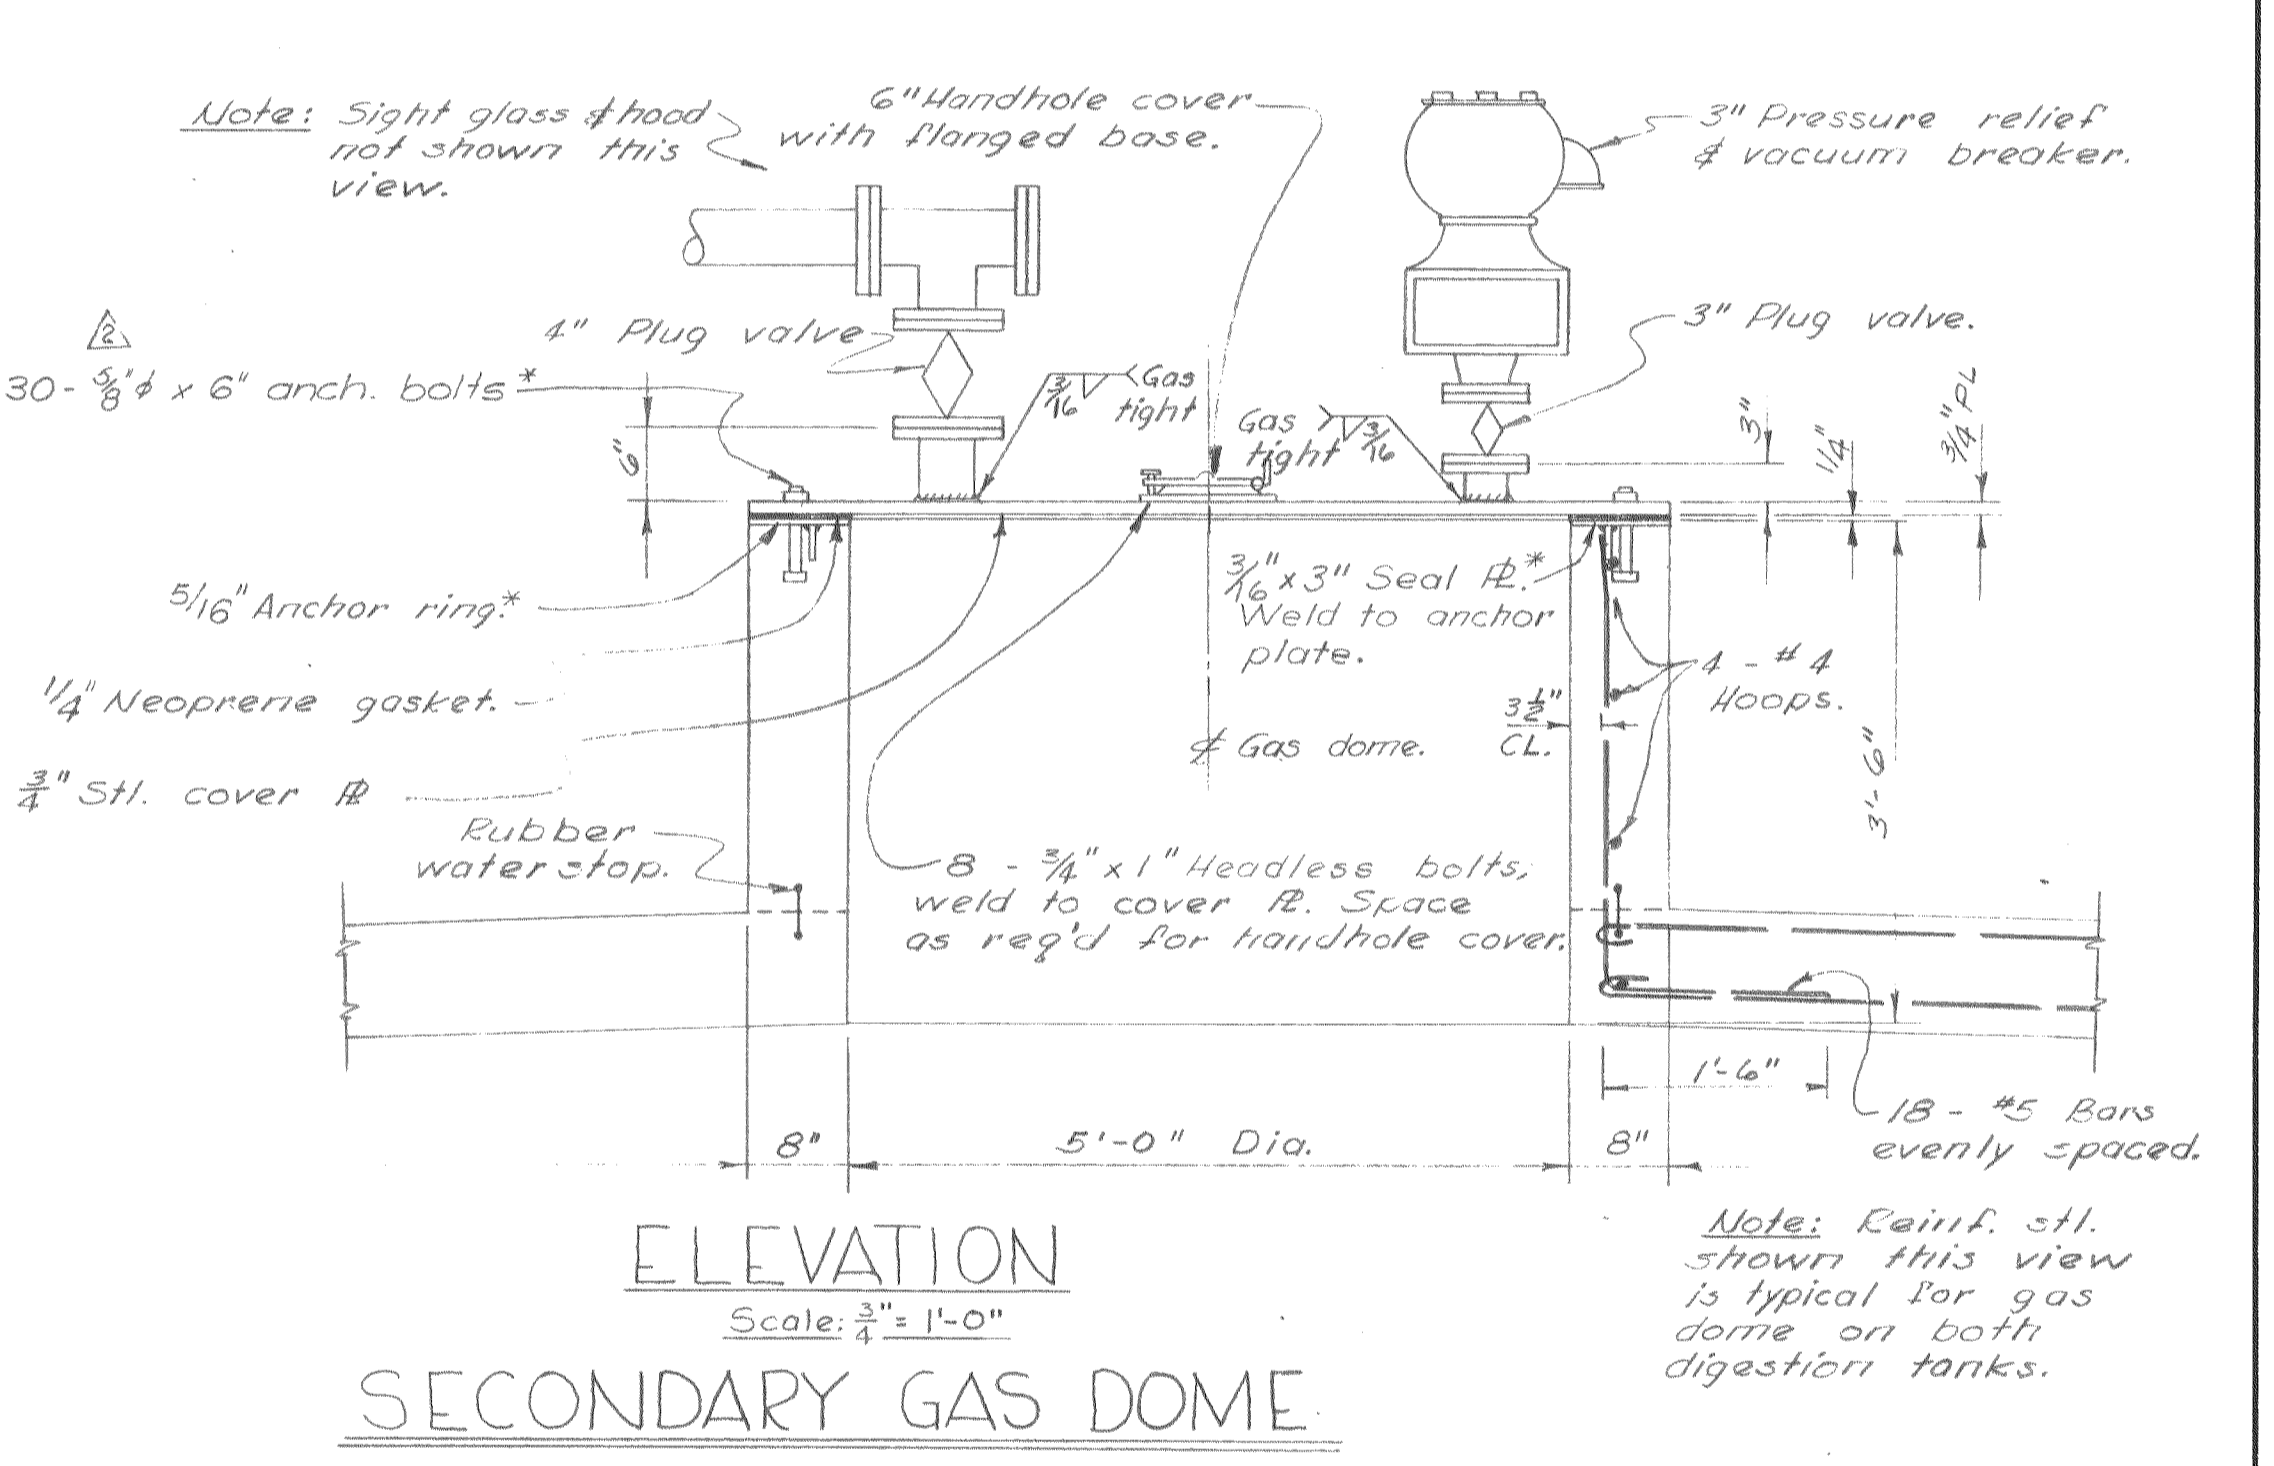

ELEVATION
Scale: $\frac{3}{4}$ " = 1'-0"
SECONDARY GAS DOME

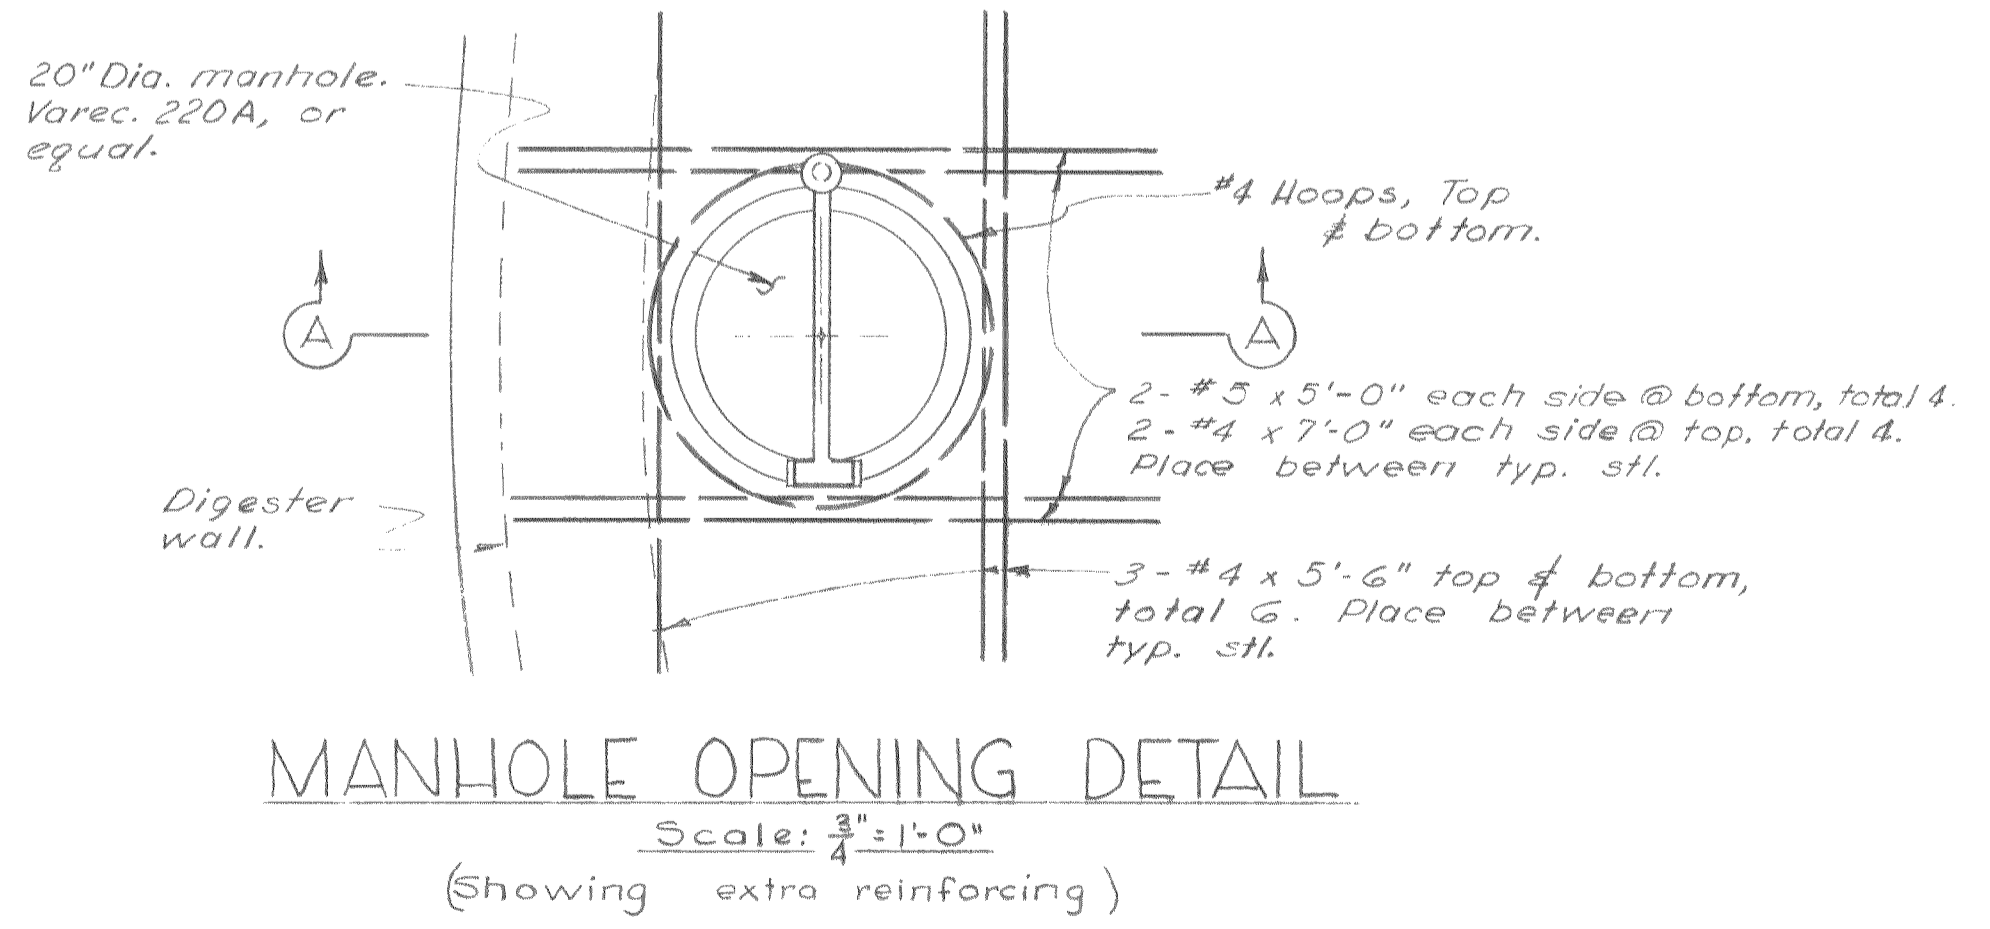

MANHOLE OPENING DETAIL
Scale: $\frac{3}{4}$ " = 1'-0"
(Showing extra reinforcing)

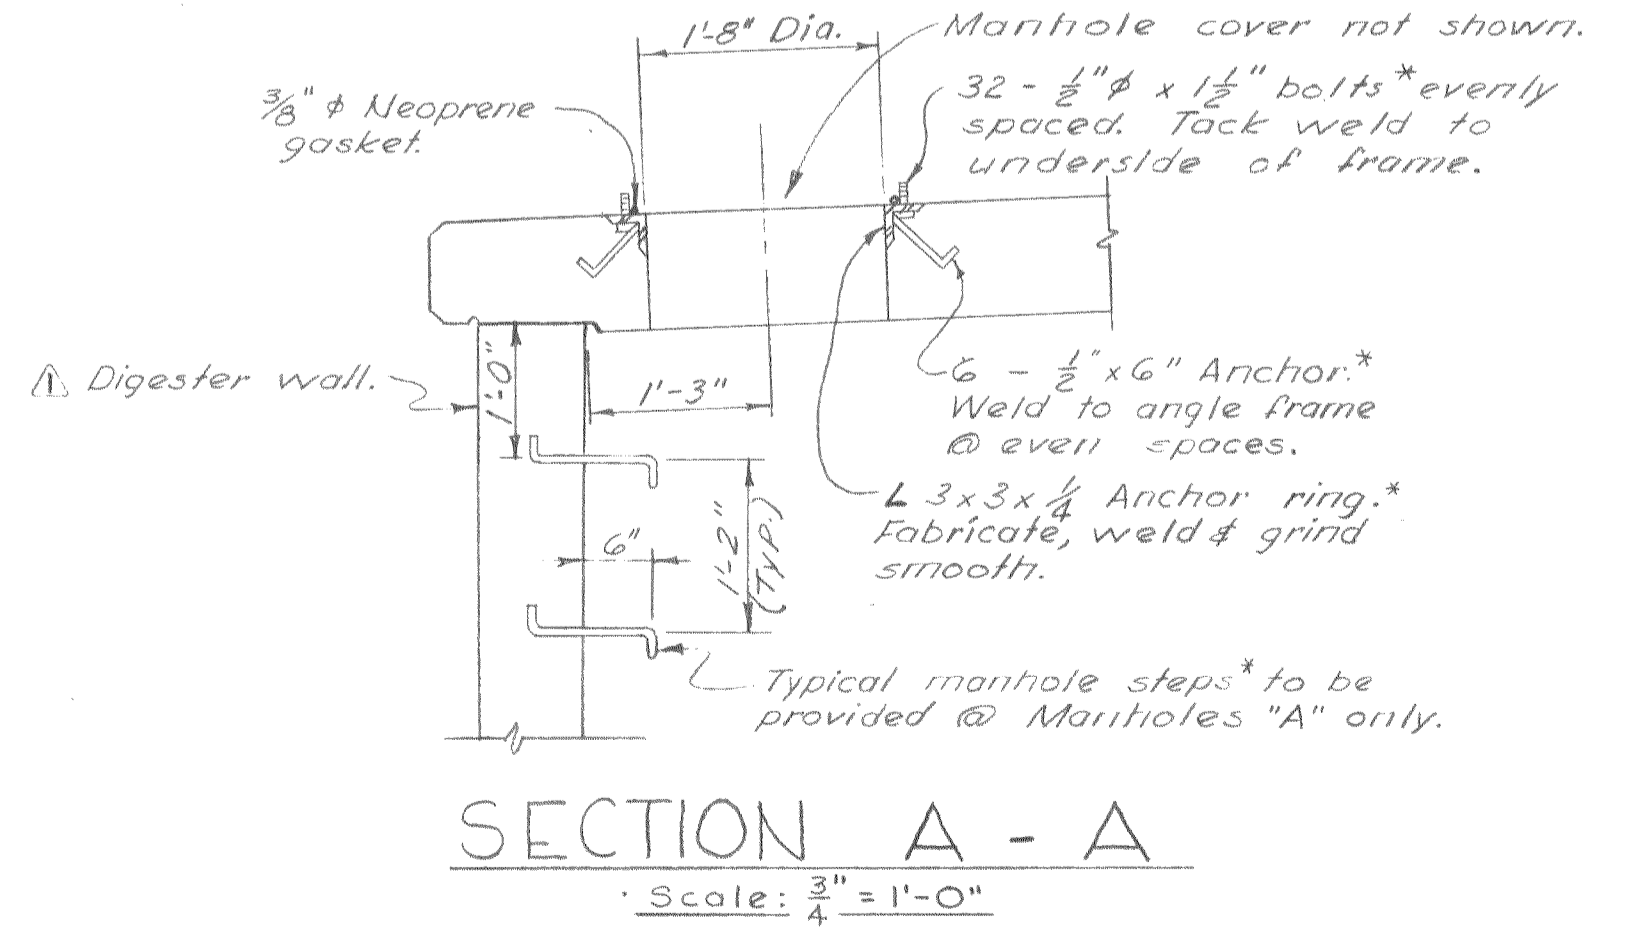

SECTION A - A
Scale: $\frac{3}{4}$ " = 1'-0"

AS BUILT			
REV	DATE	DESCRIPTION	BY
AB	5-16	ADDED NOTES RE: MFR DRWS. REMOVED WATER LINES. CHANGED BOLT SIZE.	RAB
B	11-5	REVISED DUE TO PRESTRESSED DESIGN	G.L.
		CITY OF OROVILLE BUTTE COUNTY, CALIFORNIA SEWAGE TREATMENT PLANT DIGESTION TANKS MECHANICAL	
		DEWANTE AND STOWELL SANITARY AND CIVIL ENGINEERS - SACRAMENTO, CALIFORNIA	
DRAWN: J.D.J.	SUBMITTED:		SHEET NO.
CHECKED: R.H.D.	APPROVED:		23
DATE: Mar. 1959			OF 36