
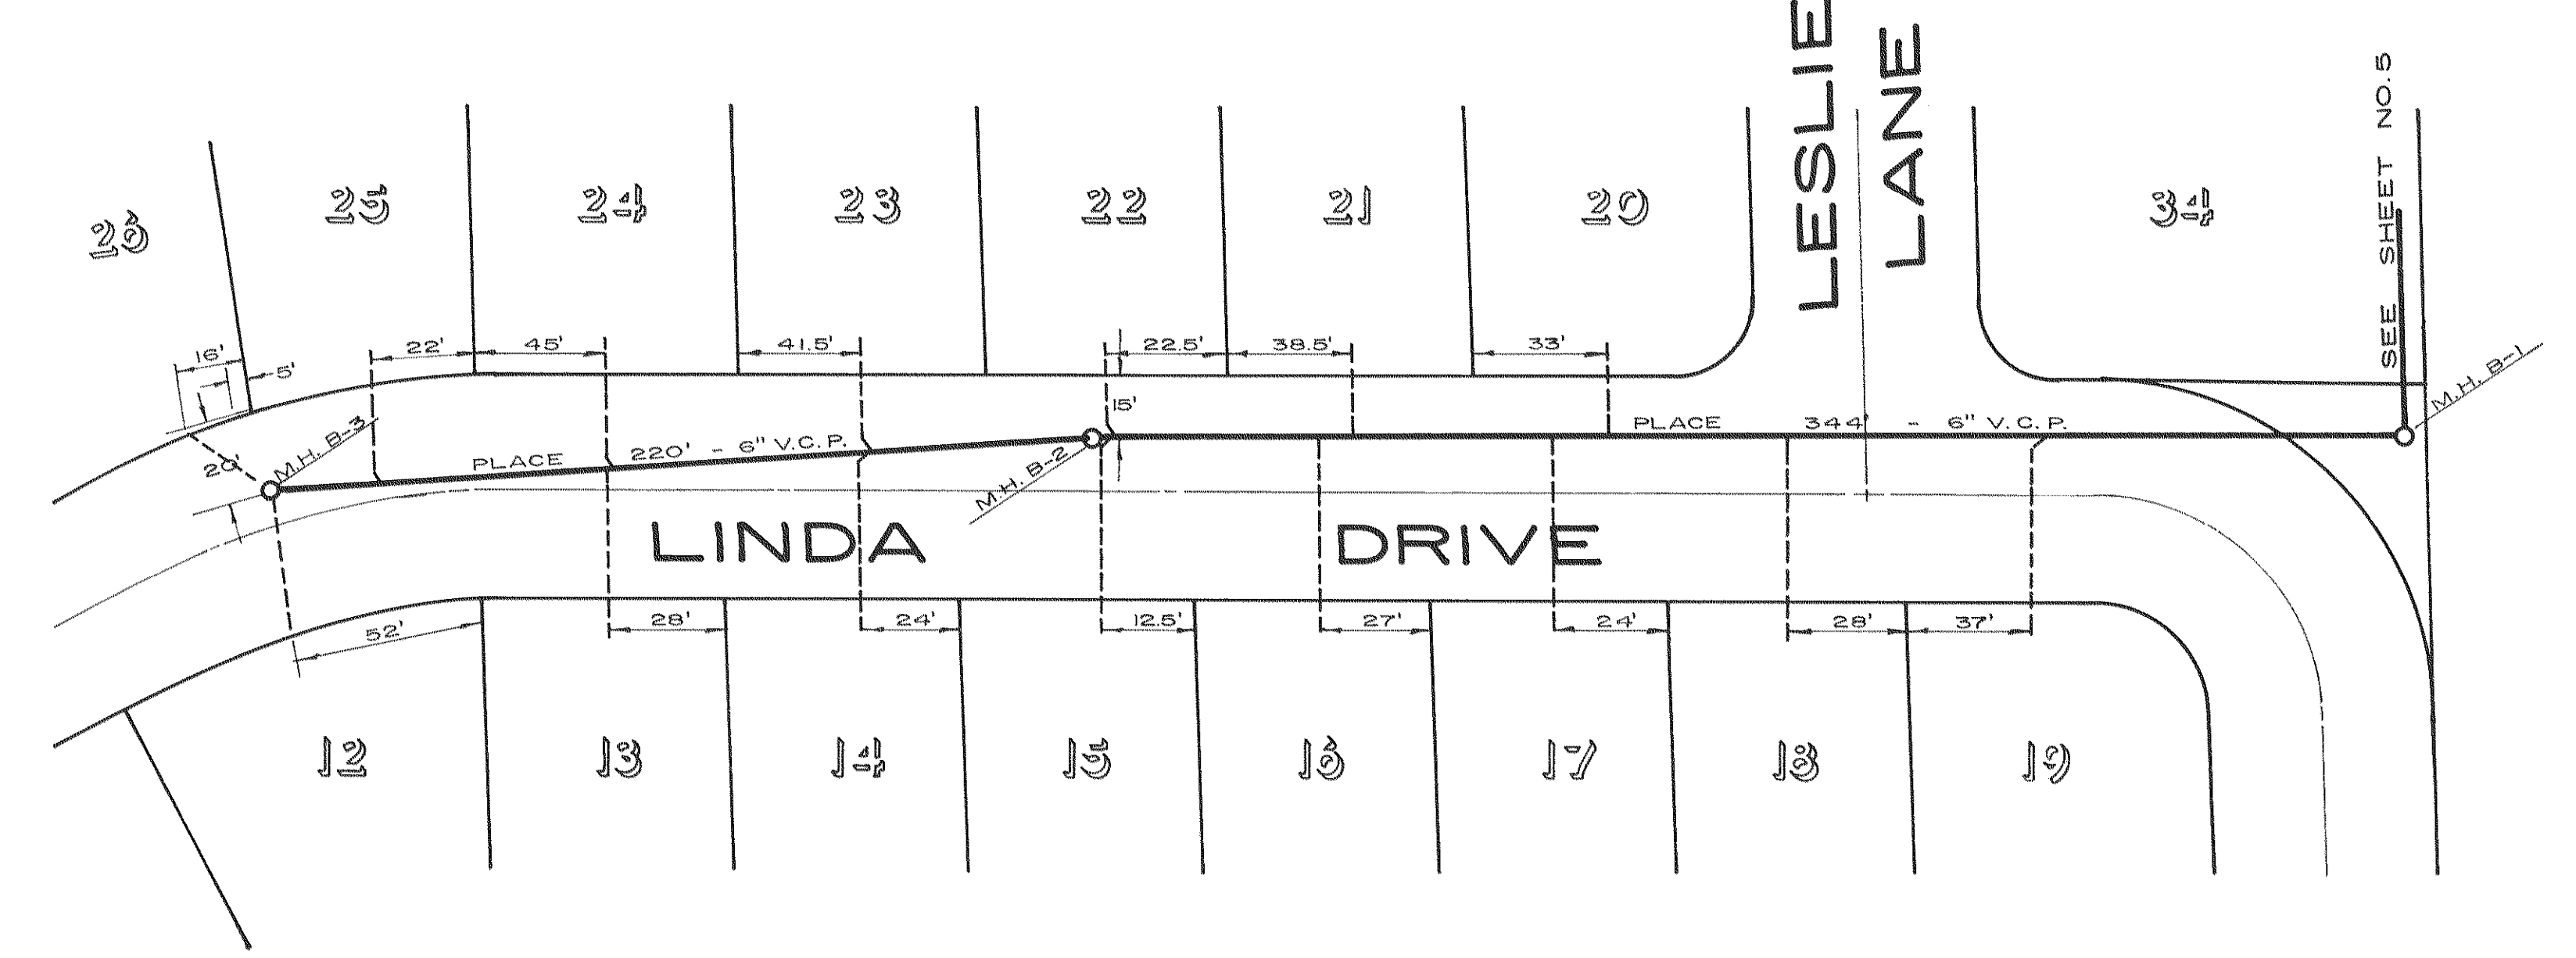


NOTE:
 ENDS OF ALL LATERALS TO BE MARKED BY R.W.D.
 2" x 4" x 8', PAINTED WHITE, AND EXTENDING 2'
 ABOVE FINISH GRADE.

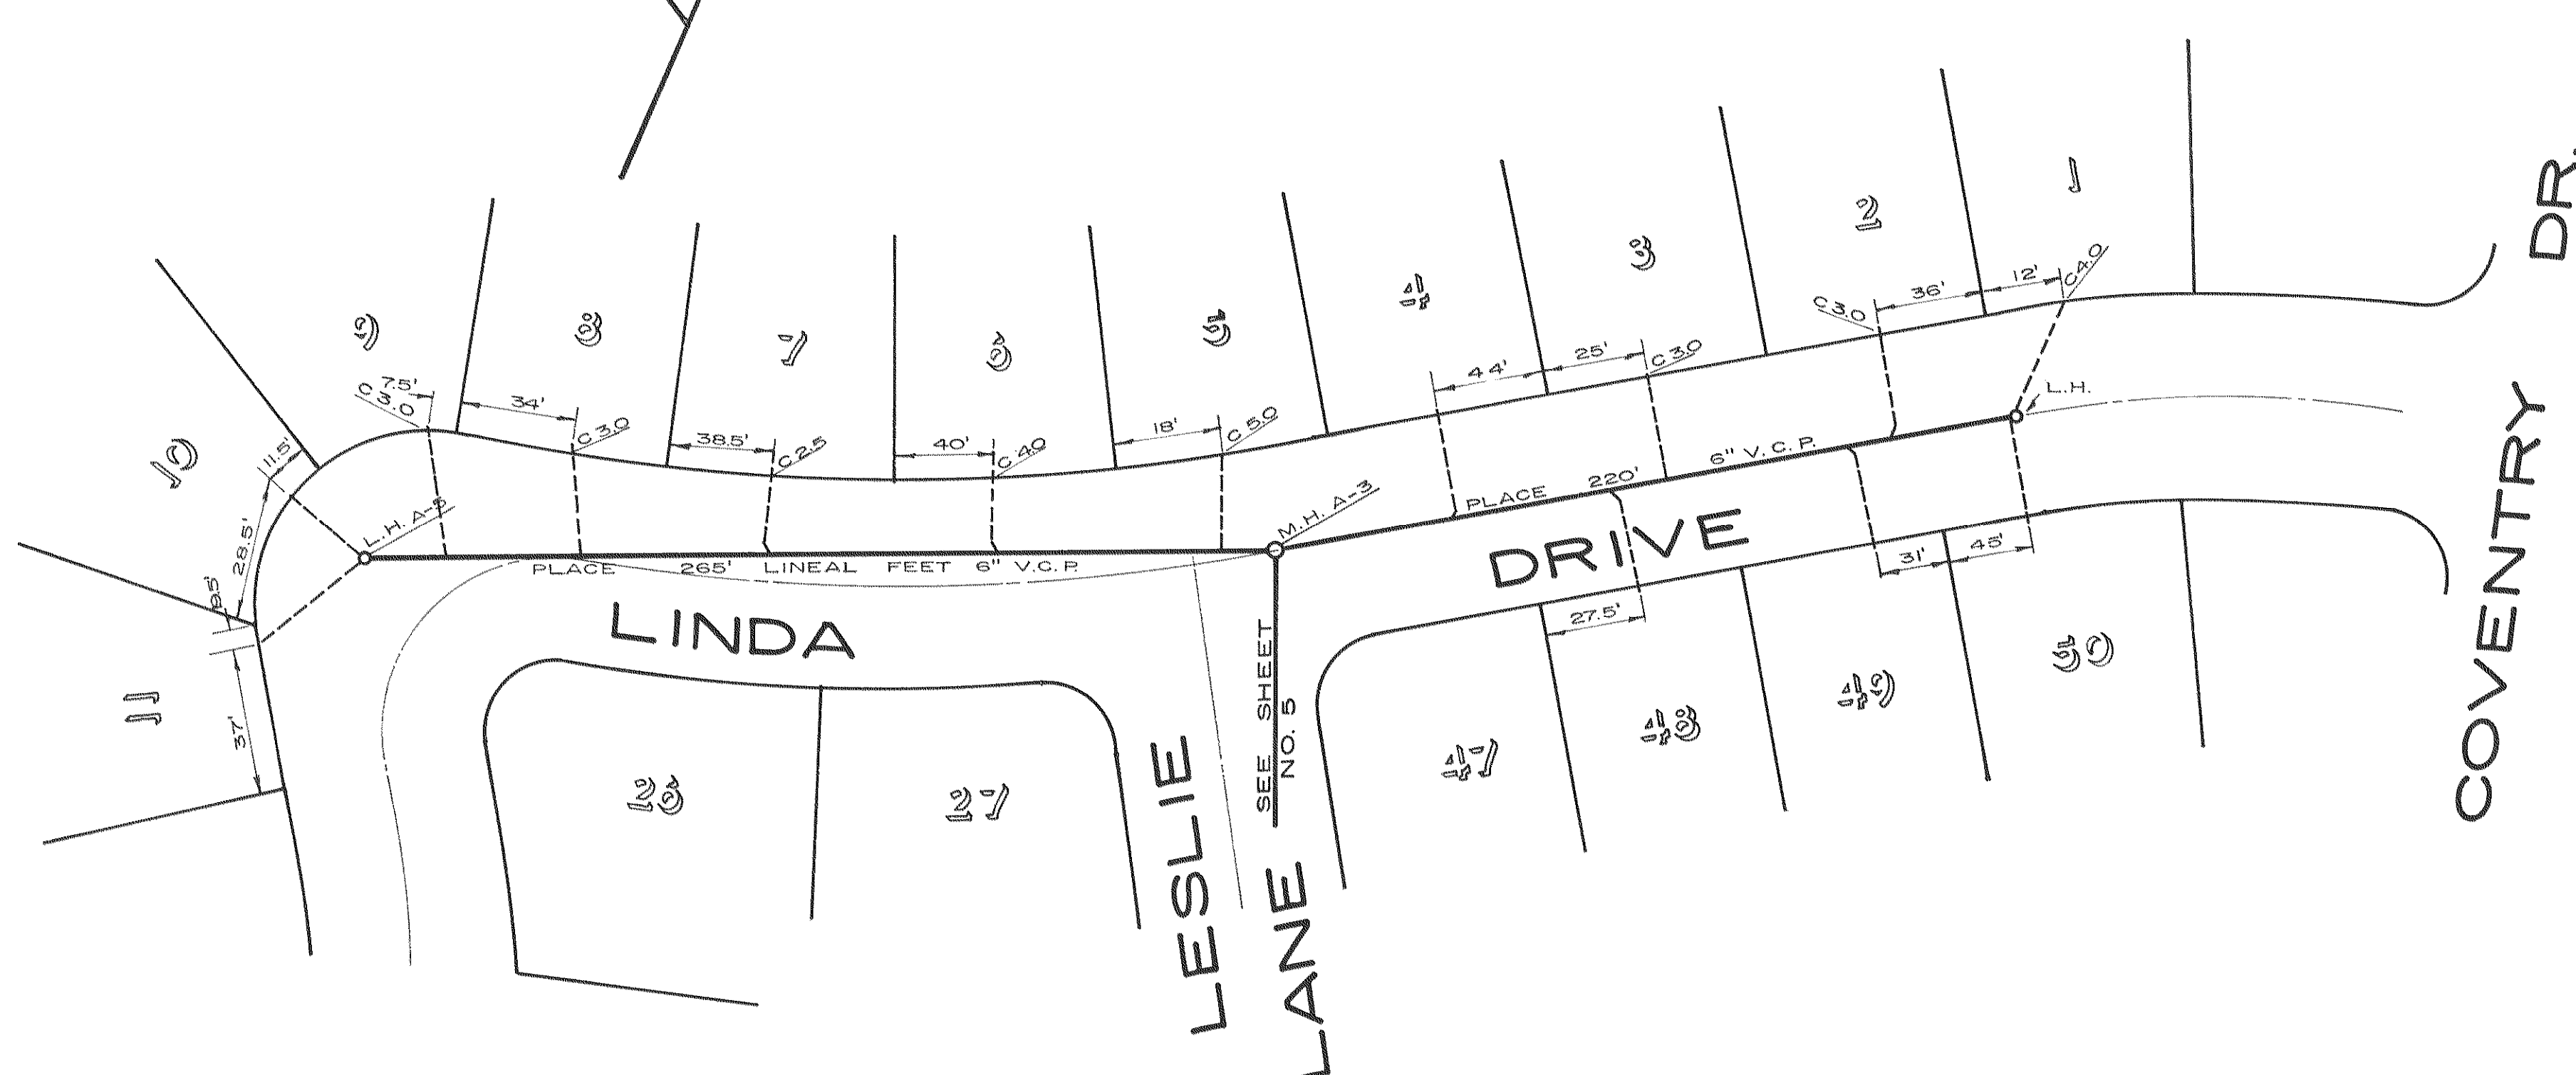

REDRAWN ON LINEN—12/10/69—N.A.W.

AS BUILT

ACACIA MANOR SUBDIVISION SANITARY SEWER PLANS		
DRAWN BY: W.J.C.	CHECKED BY:	DATE: MARCH 1961
SCALE: 1" = 40'	SHEET 4 OF 6	FILE NO.
WALTER B. GRIMES RE. NO. 7294 1338 MANGROVE, CHICO		