


"A" LINE

"C2" LINE

Scales:
 Horizontal: 1" = 100'
 Vertical: 1" = 8'

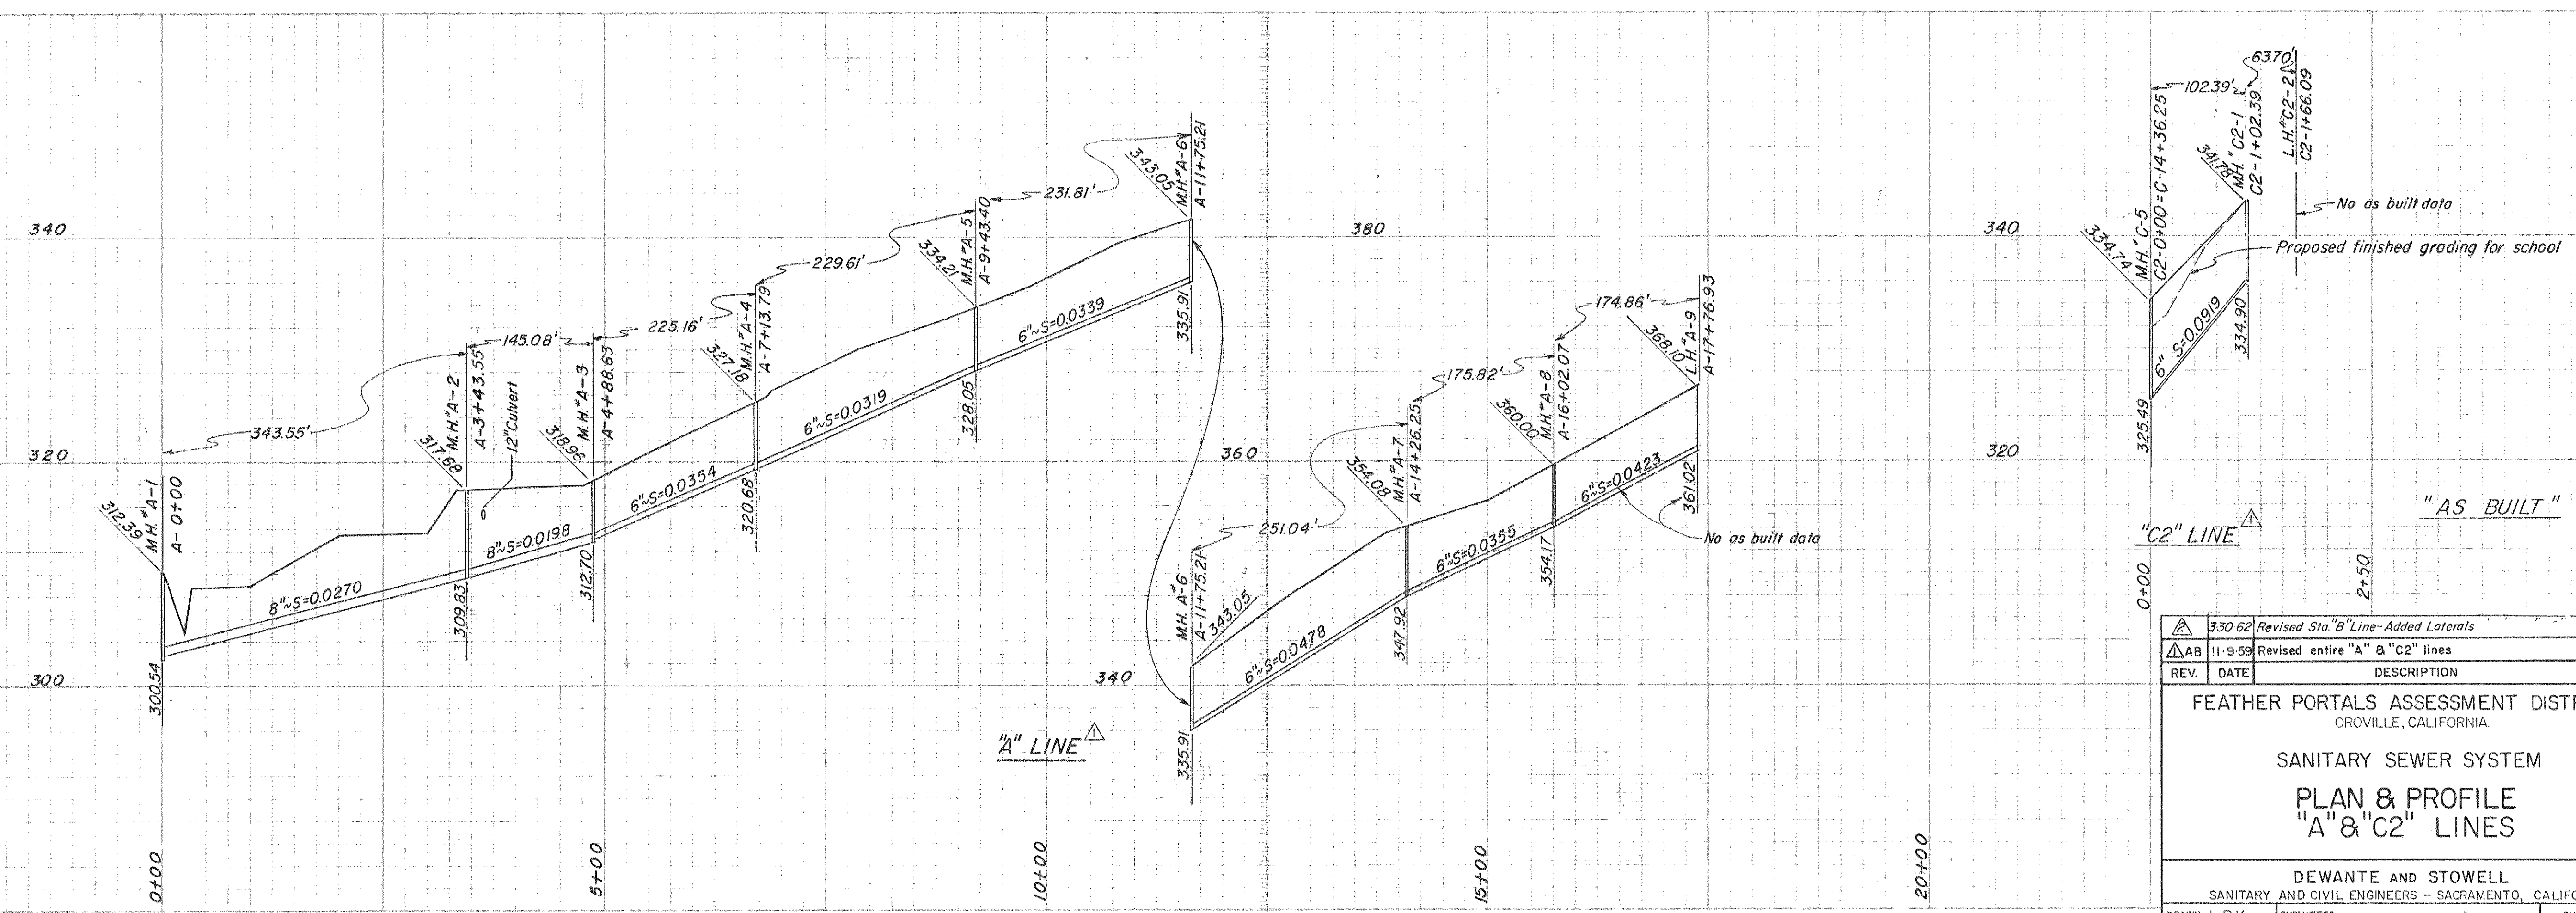

"A" LINE

"C2" LINE

"AS BUILT"

330-62	Revised Sta. "B" Line-Added Laterals	BAB
AB 11-9-59	Revised entire "A" & "C2" lines	LRK
REV.	DATE	DESCRIPTION
		BY APP.
FEATHER PORTALS ASSESSMENT DISTRICT OROVILLE, CALIFORNIA		
SANITARY SEWER SYSTEM PLAN & PROFILE "A" & "C2" LINES		
DEWANTE AND STOWELL SANITARY AND CIVIL ENGINEERS - SACRAMENTO, CALIFORNIA		
DRAWN L.R.K.	SUBMITTED	SHEET NO.
CHECKED N.E.W.	APPROVED: <i>Edwin R. Stowell</i>	2
DATE: March '59	APPROVED: <i>R. J. Carpenter</i>	OF 11