


Scales:
 Horizontal 1" = 100'
 Vertical 1" = 8'

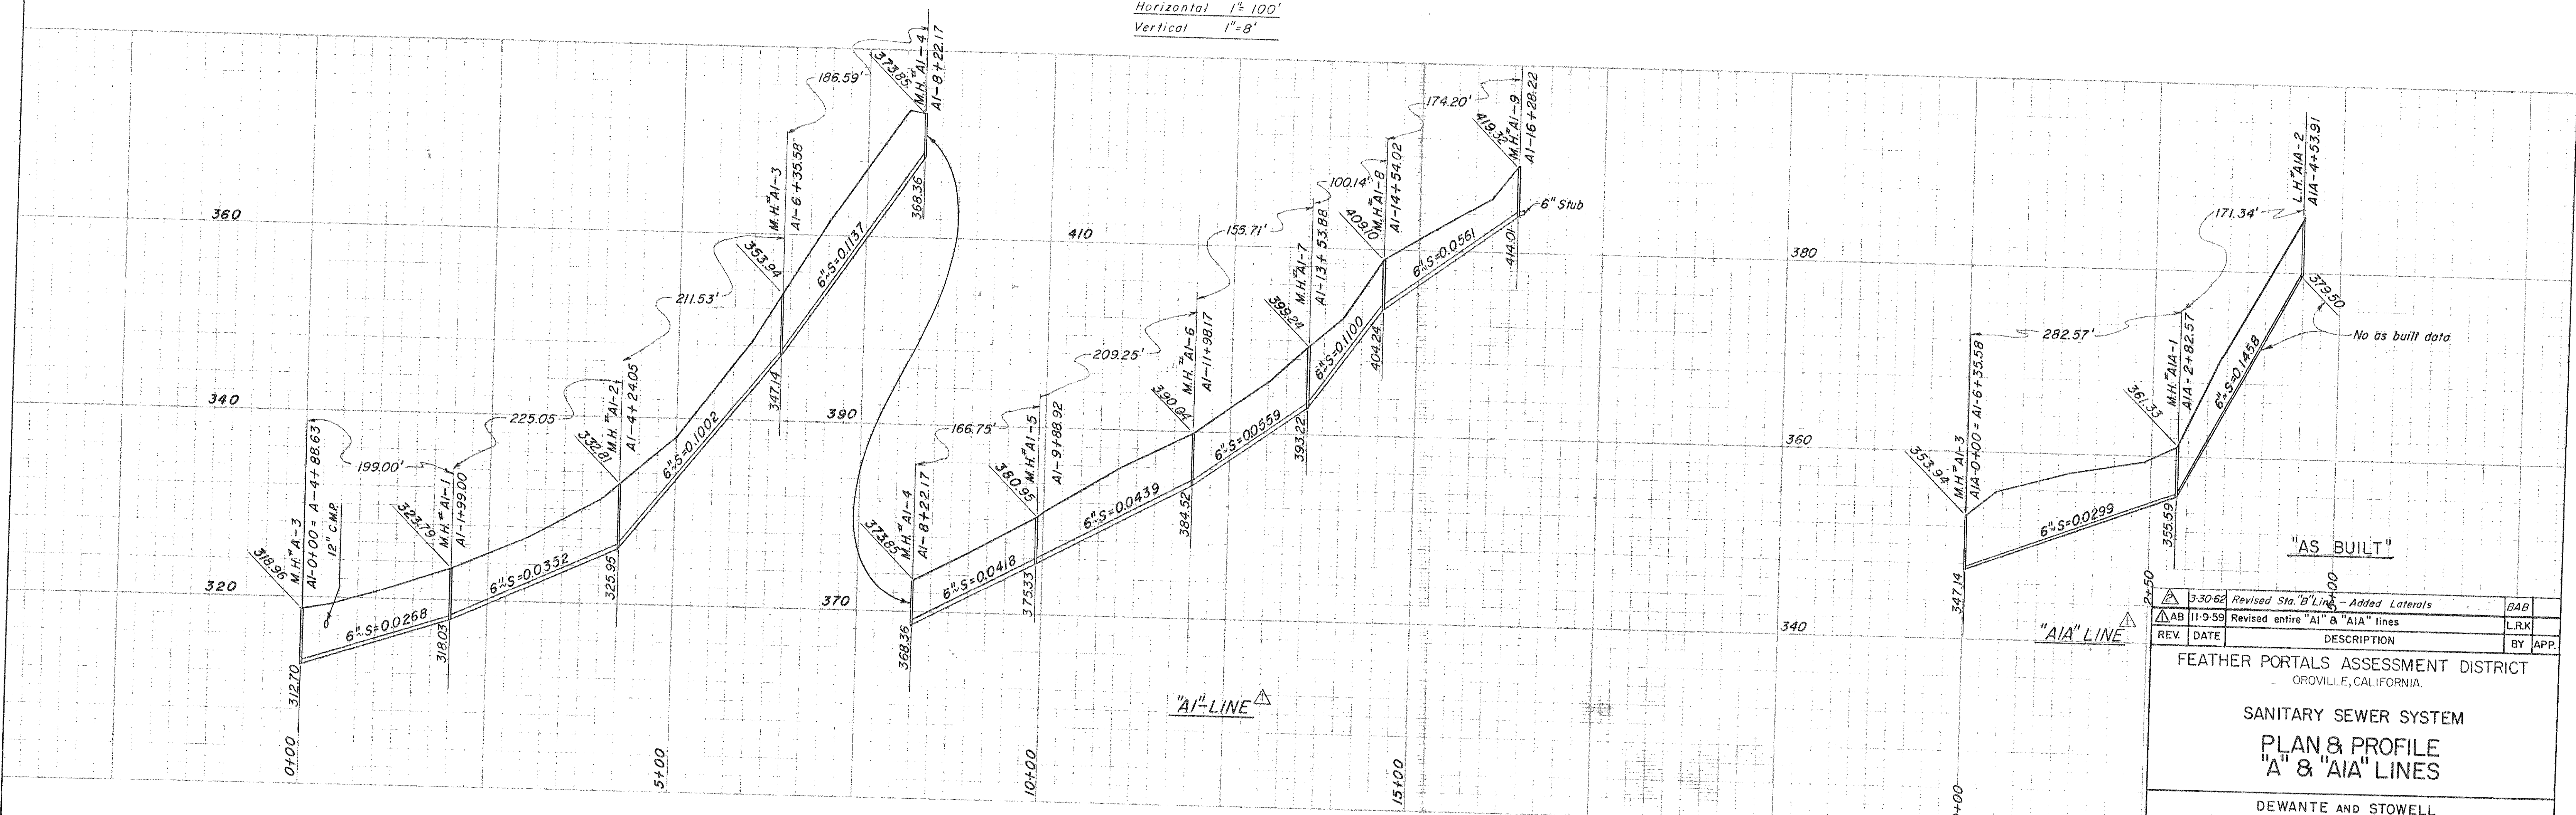

3-30-62	Revised Sta. "B" Line - Added Laterals	BAR
11-9-59	Revised entire "AI" & "AIA" lines	L.R.K.
REV. DATE	DESCRIPTION	BY APP.

FEATHER PORTALS ASSESSMENT DISTRICT
 OROVILLE, CALIFORNIA

SANITARY SEWER SYSTEM
 PLAN & PROFILE
 "AI" & "AIA" LINES

DEWANTE AND STOWELL
 SANITARY AND CIVIL ENGINEERS - SACRAMENTO, CALIFORNIA

DRAWN: G.C.J. SUBMITTED: Edwin R. Stowell
 CHECKED: NEW APPROVED: G.C.J.
 DATE: March '59

SHEET NO. 3
 OF 11