


"B" LINE

Scales:
 Horizontal 1" = 100'
 Vertical 1" = 8'

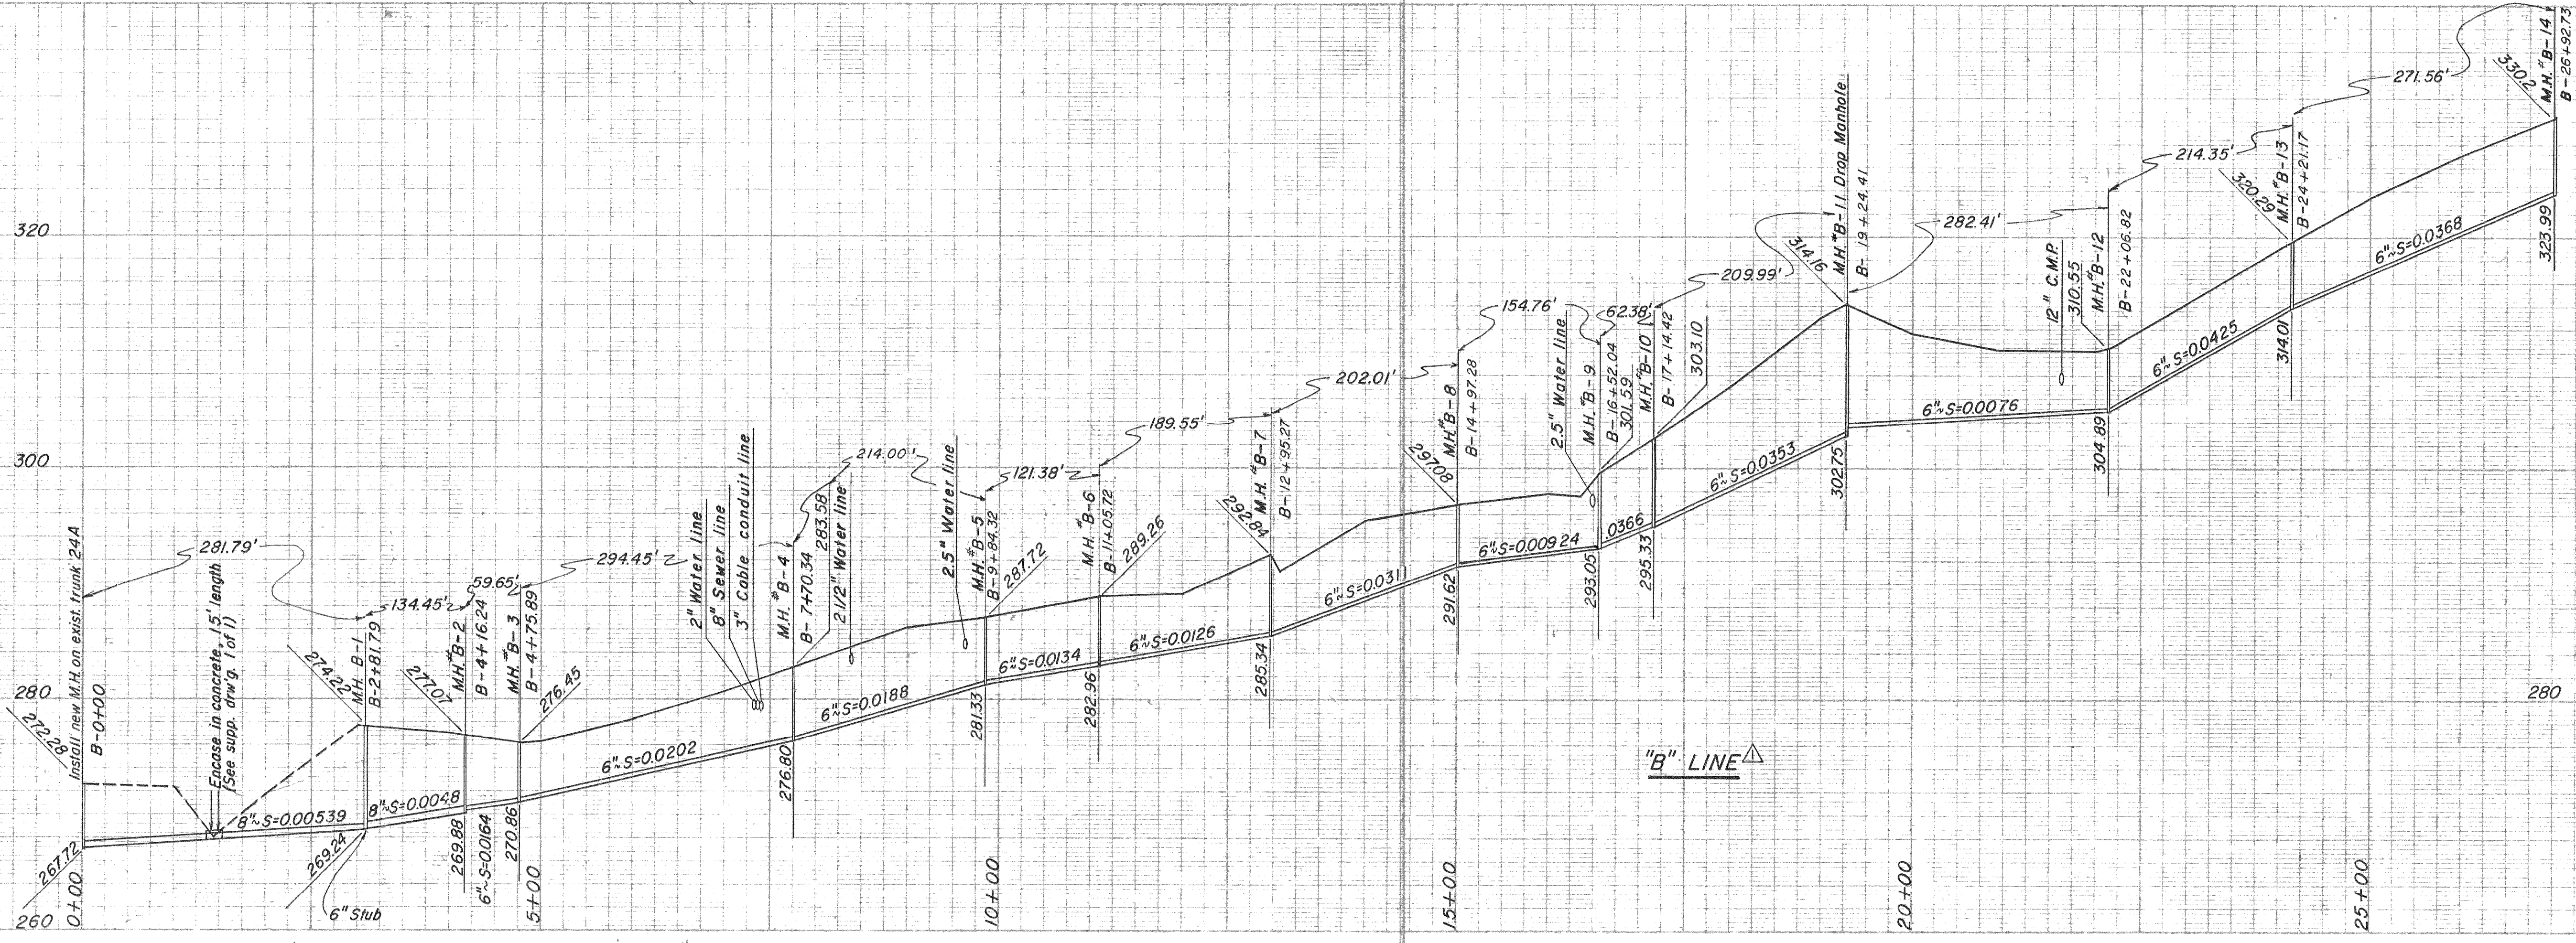

"B" LINE

AS BUILT

3-30-62	Revised Sta. "B" Line - Added Lateral	BAB
11-10-59	Revised entire "B" line	LRK
REV. DATE	DESCRIPTION	BY APP.

FEATHER PORTALS ASSESSMENT DISTRICT
 OROVILLE, CALIFORNIA

SANITARY SEWER SYSTEM
 PLAN & PROFILE
 "B" LINE

DEWANTE AND STOWELL SANITARY AND CIVIL ENGINEERS - SACRAMENTO, CALIFORNIA		
DRAWN: G.C.V.	SUBMITTED: Edwin B. Stowell	SHEET NO. 4
CHECKED: N.E.W.	APPROVED: [Signature]	OF 11
DATE: March '59		

SS 136