



"B" LINE

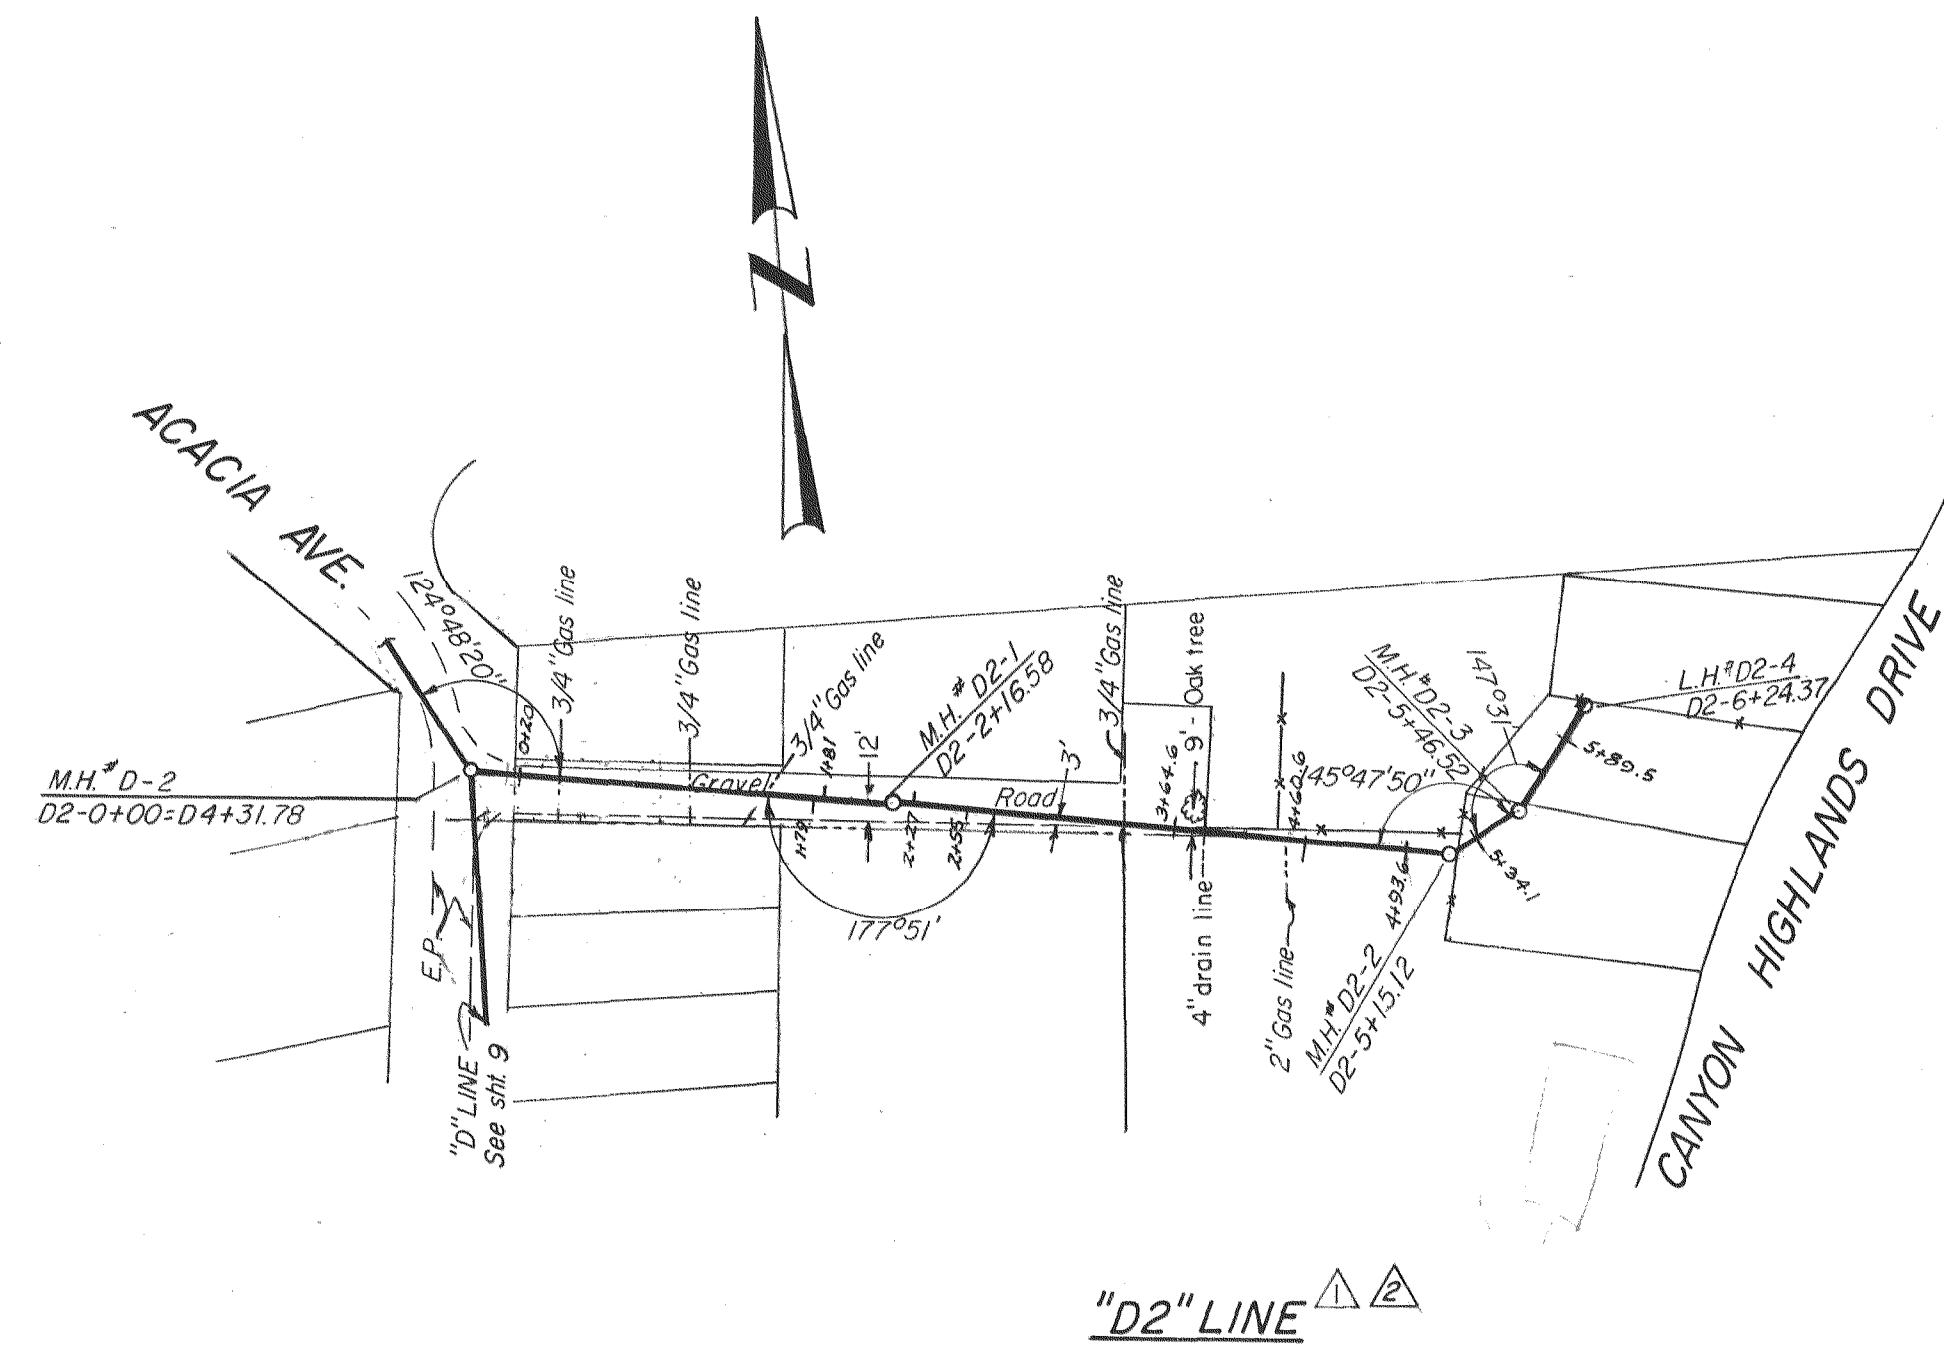


"D2" LINE

Scales
 Horizontal: 1"=100'
 Vertical: 1"=8'

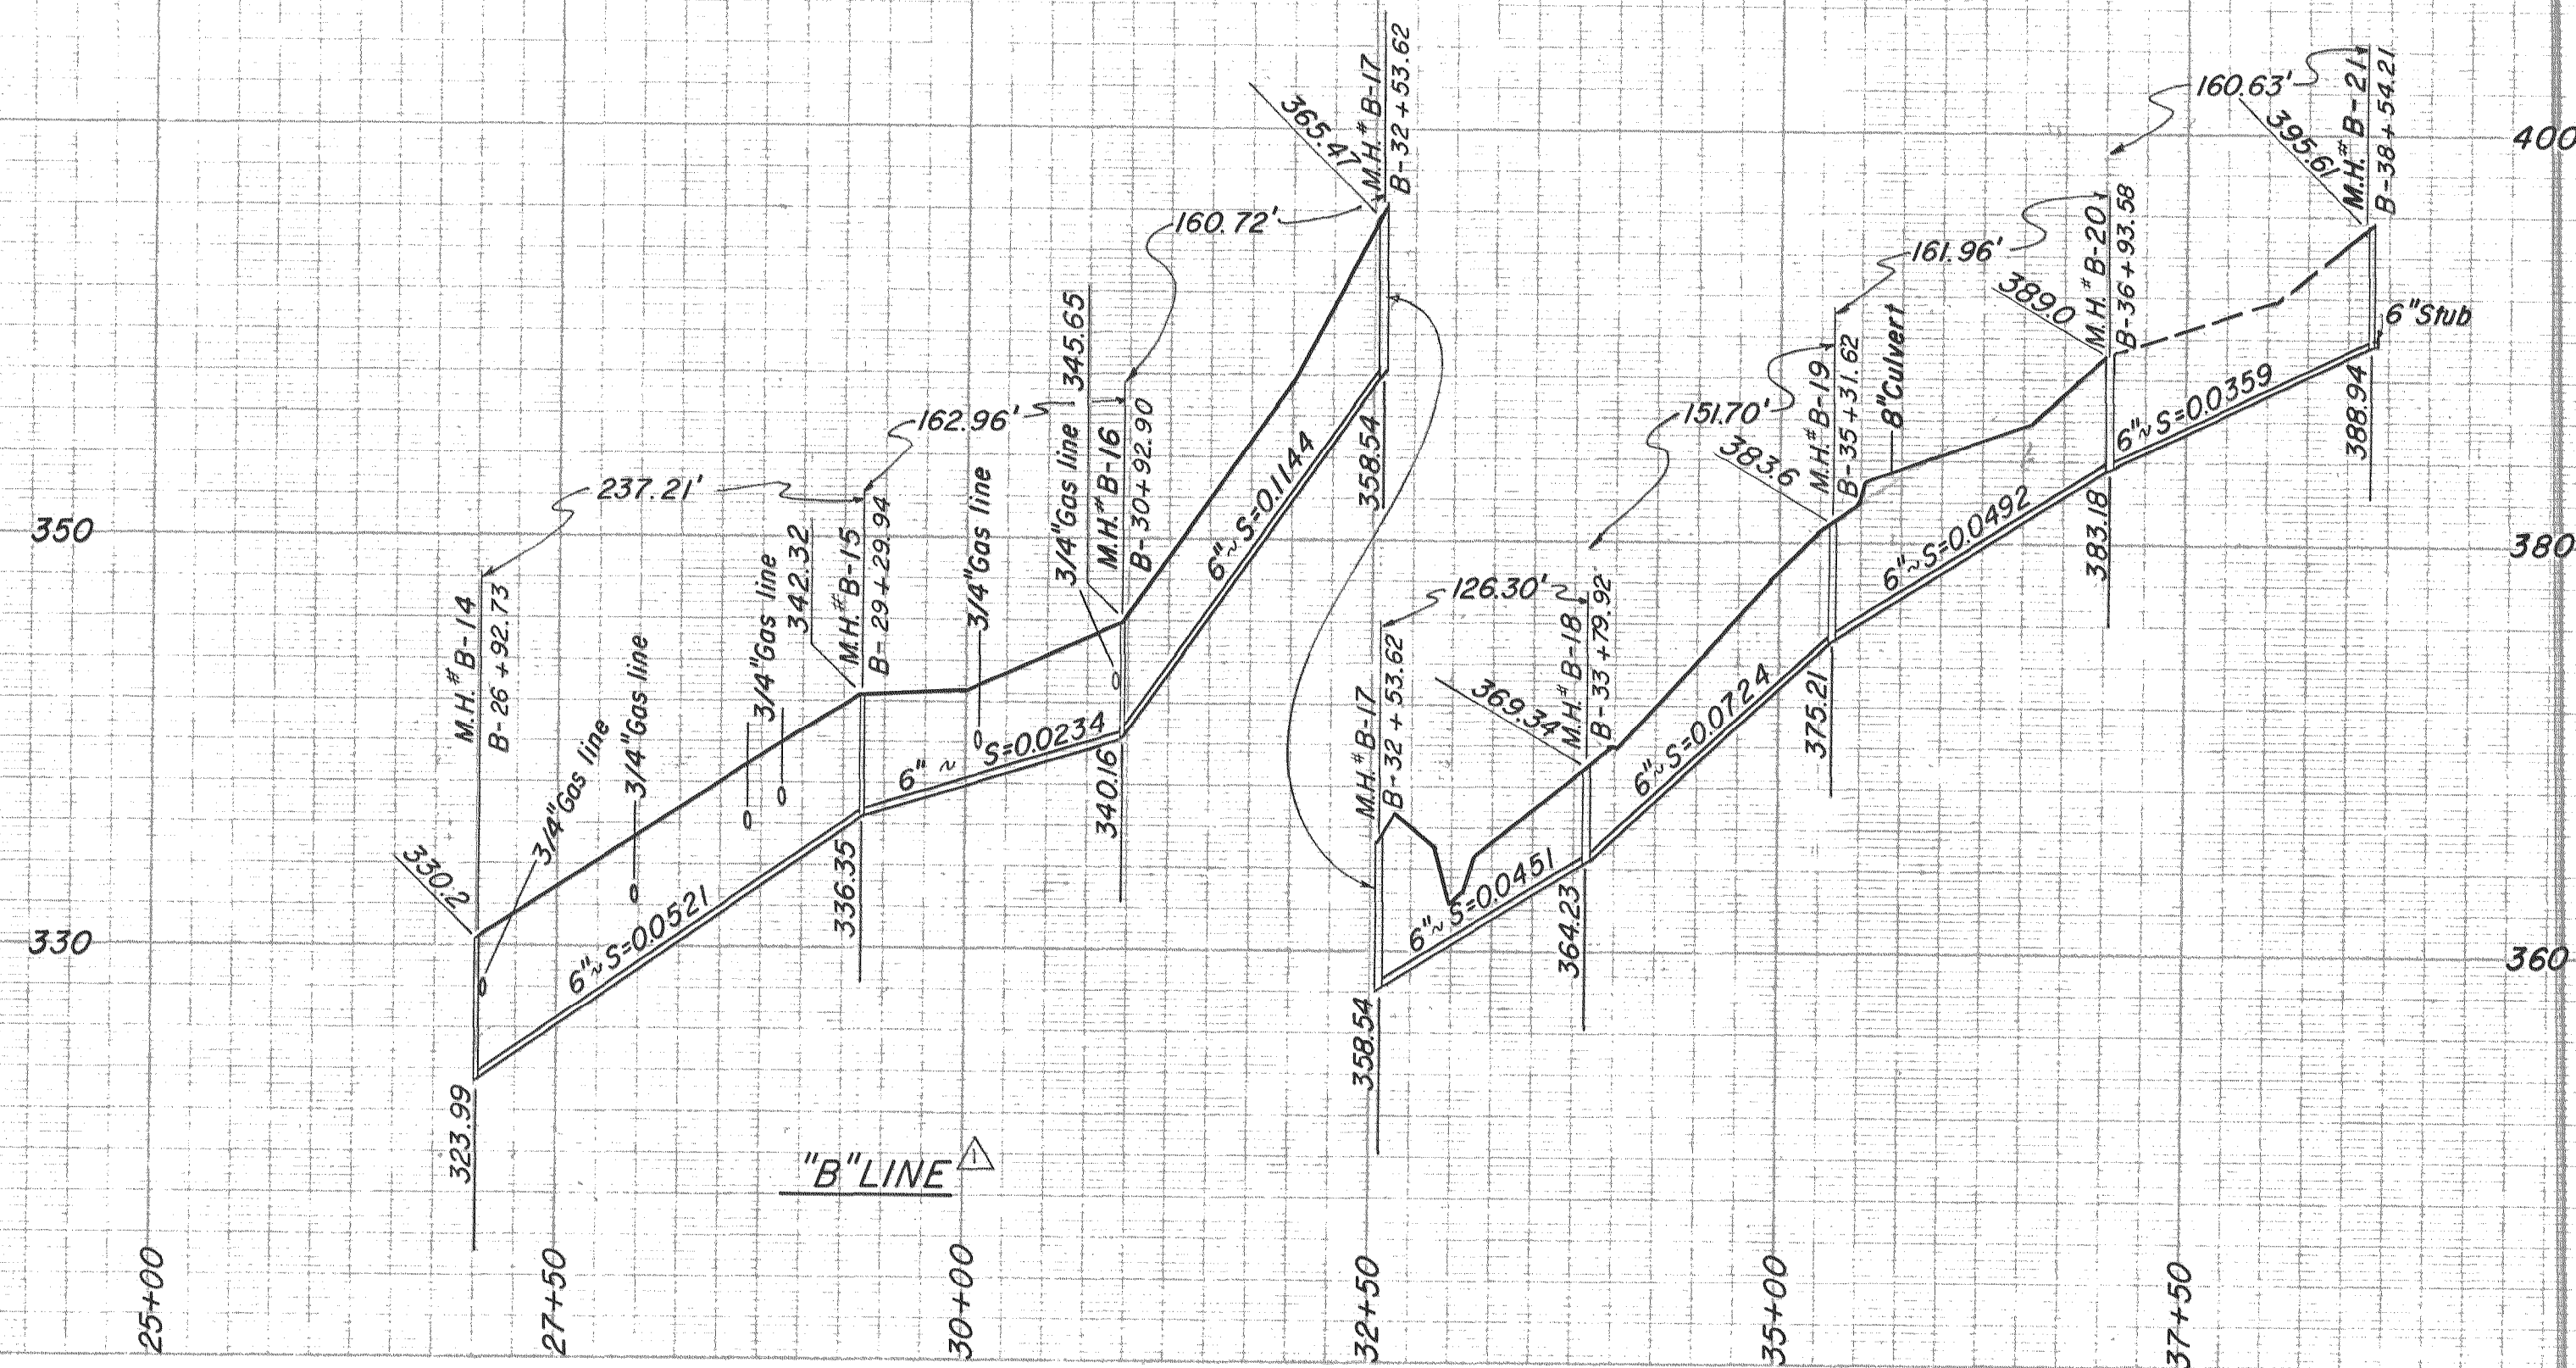

"B" LINE

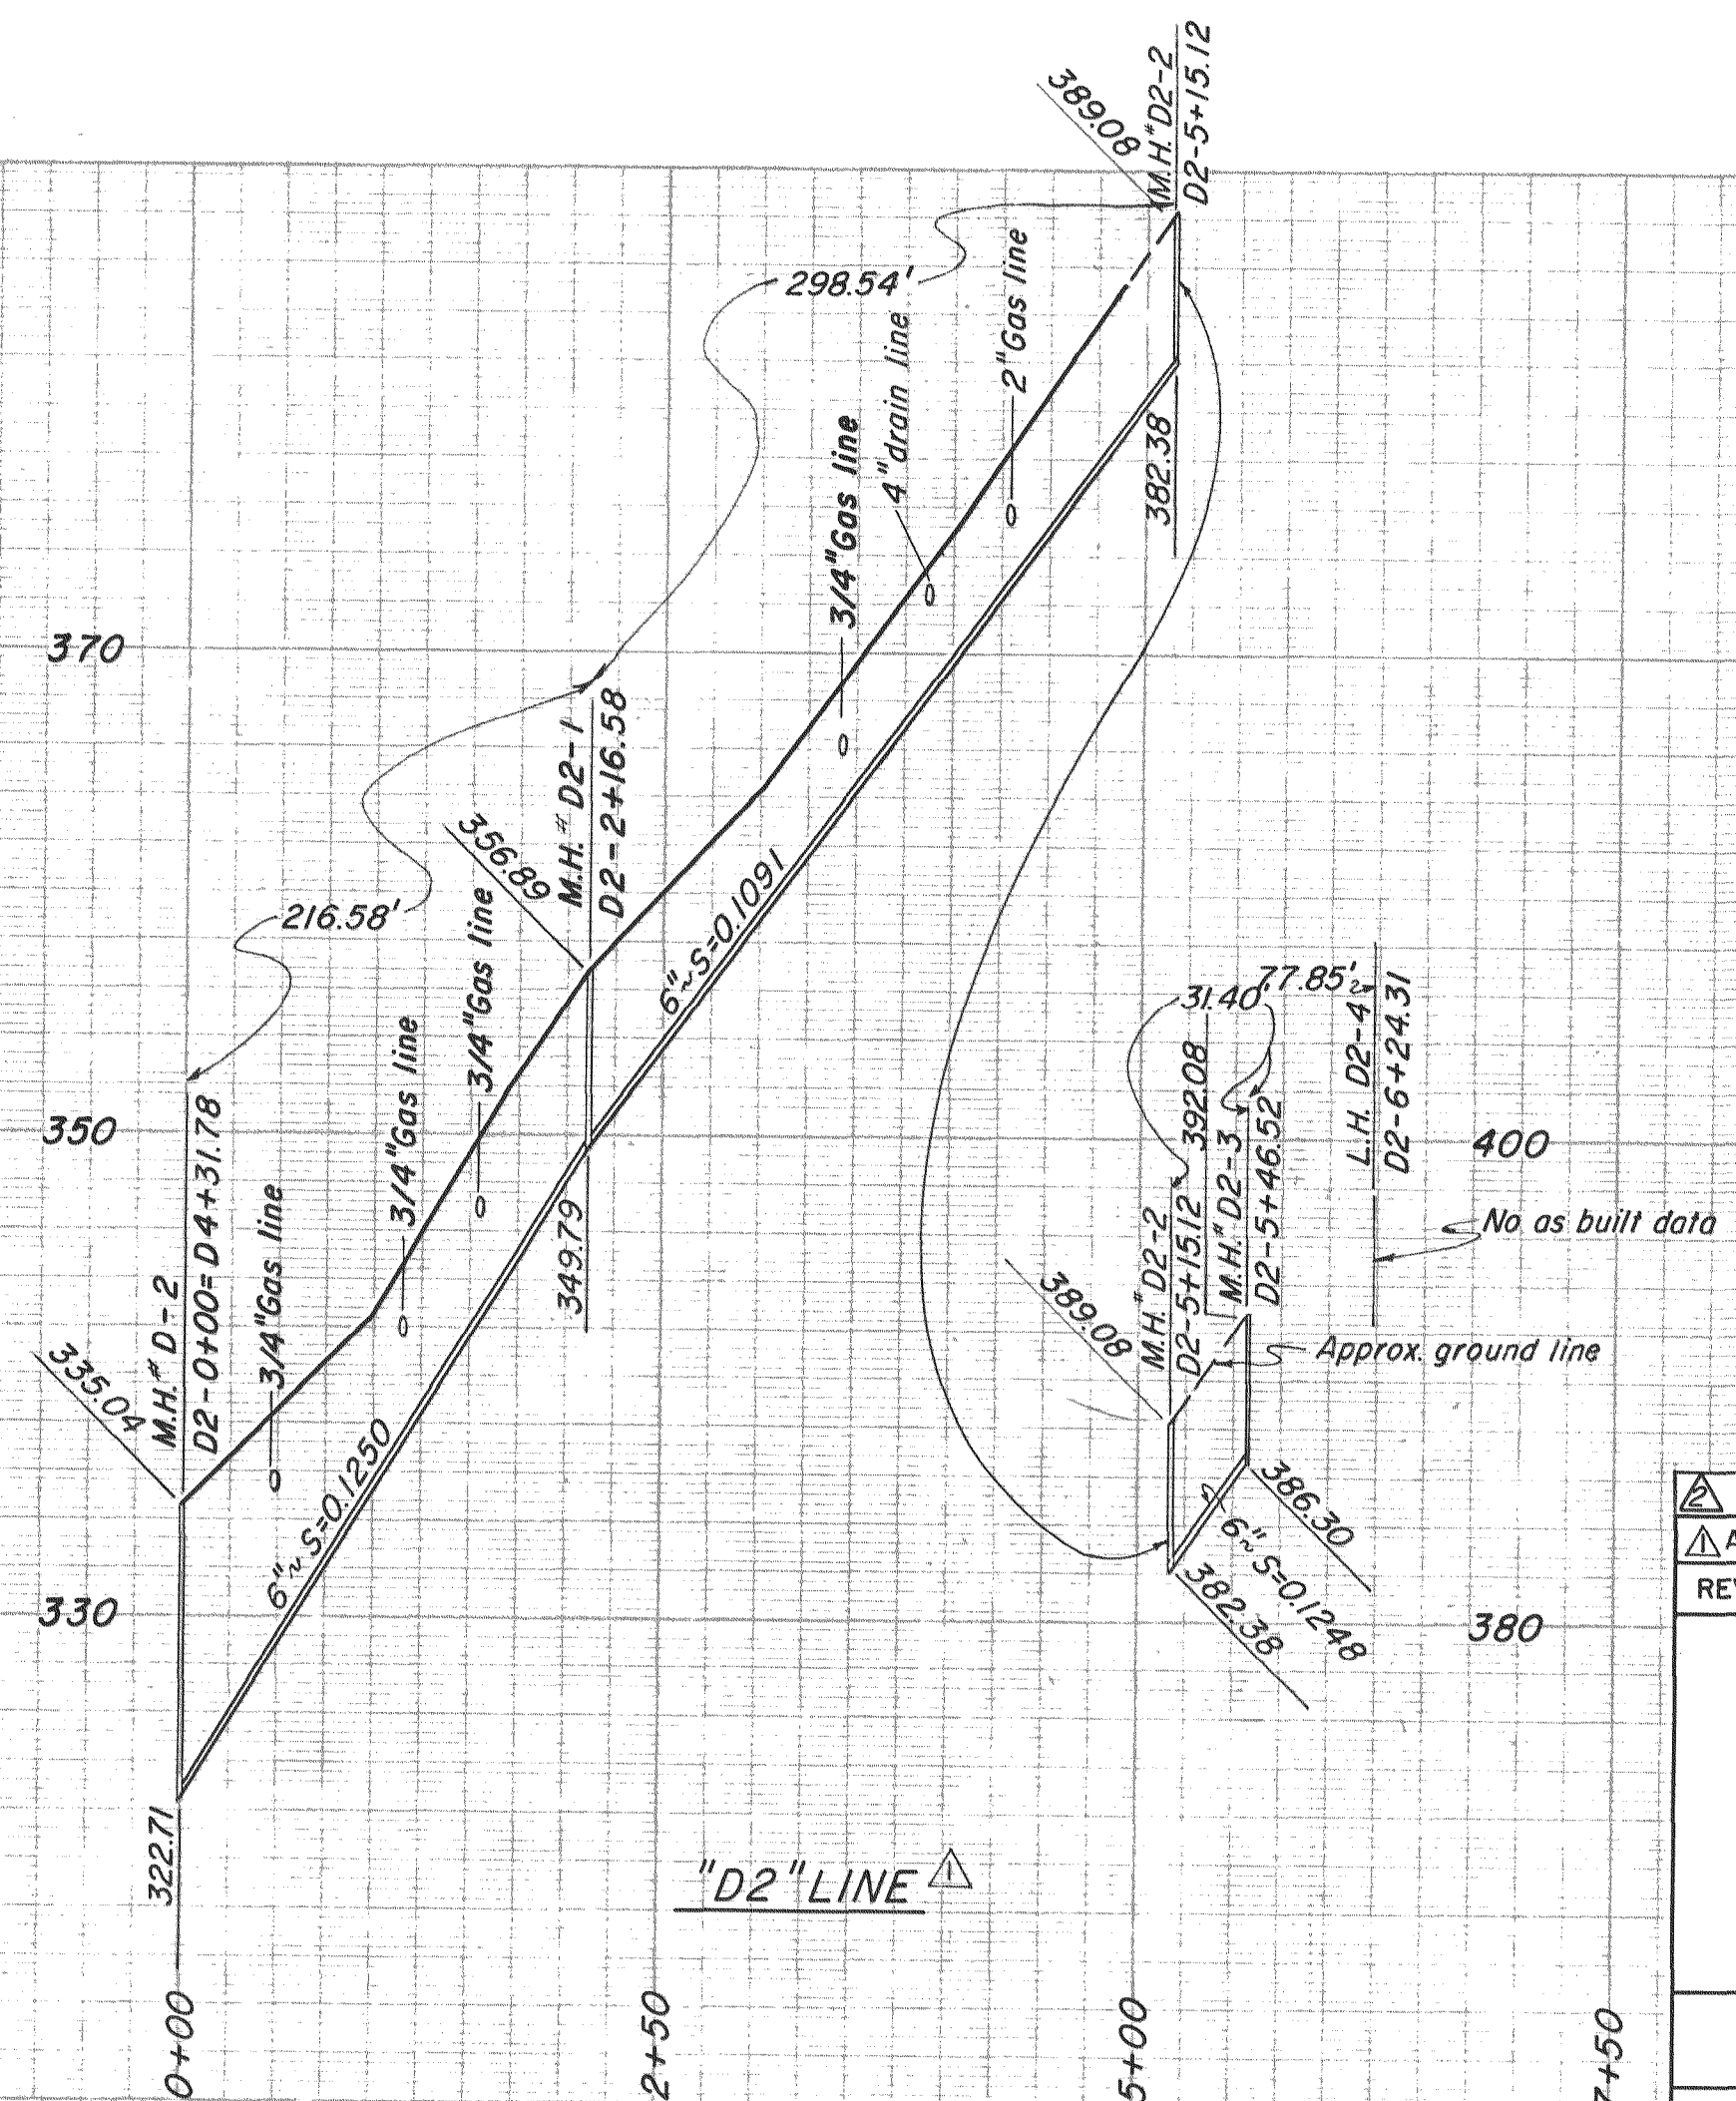

"D2" LINE

AS BUILT			
REV.	DATE	DESCRIPTION	BY APP.
3-30-62		Revised Sta "B" Line - Added Laterals	BAB
AB 11-10-59		Revised entire "B" & "D2" lines	L.R.K.

FEATHER PORTALS ASSESSMENT DISTRICT
 OROVILLE, CALIFORNIA

SANITARY SEWER SYSTEM
PLAN & PROFILE
"B" & "D2" LINES

DEWANTE AND STOWELL
 SANITARY AND CIVIL ENGINEERS - SACRAMENTO, CALIFORNIA.

DRAWN: L.R.K.	SUBMITTED: <i>Edward R. Stowell</i>	SHEET NO. 5
CHECKED: NEW	APPROVED: <i>F. J. Carpenter</i>	OF 11
DATE: March '59		