



"B1" LINE

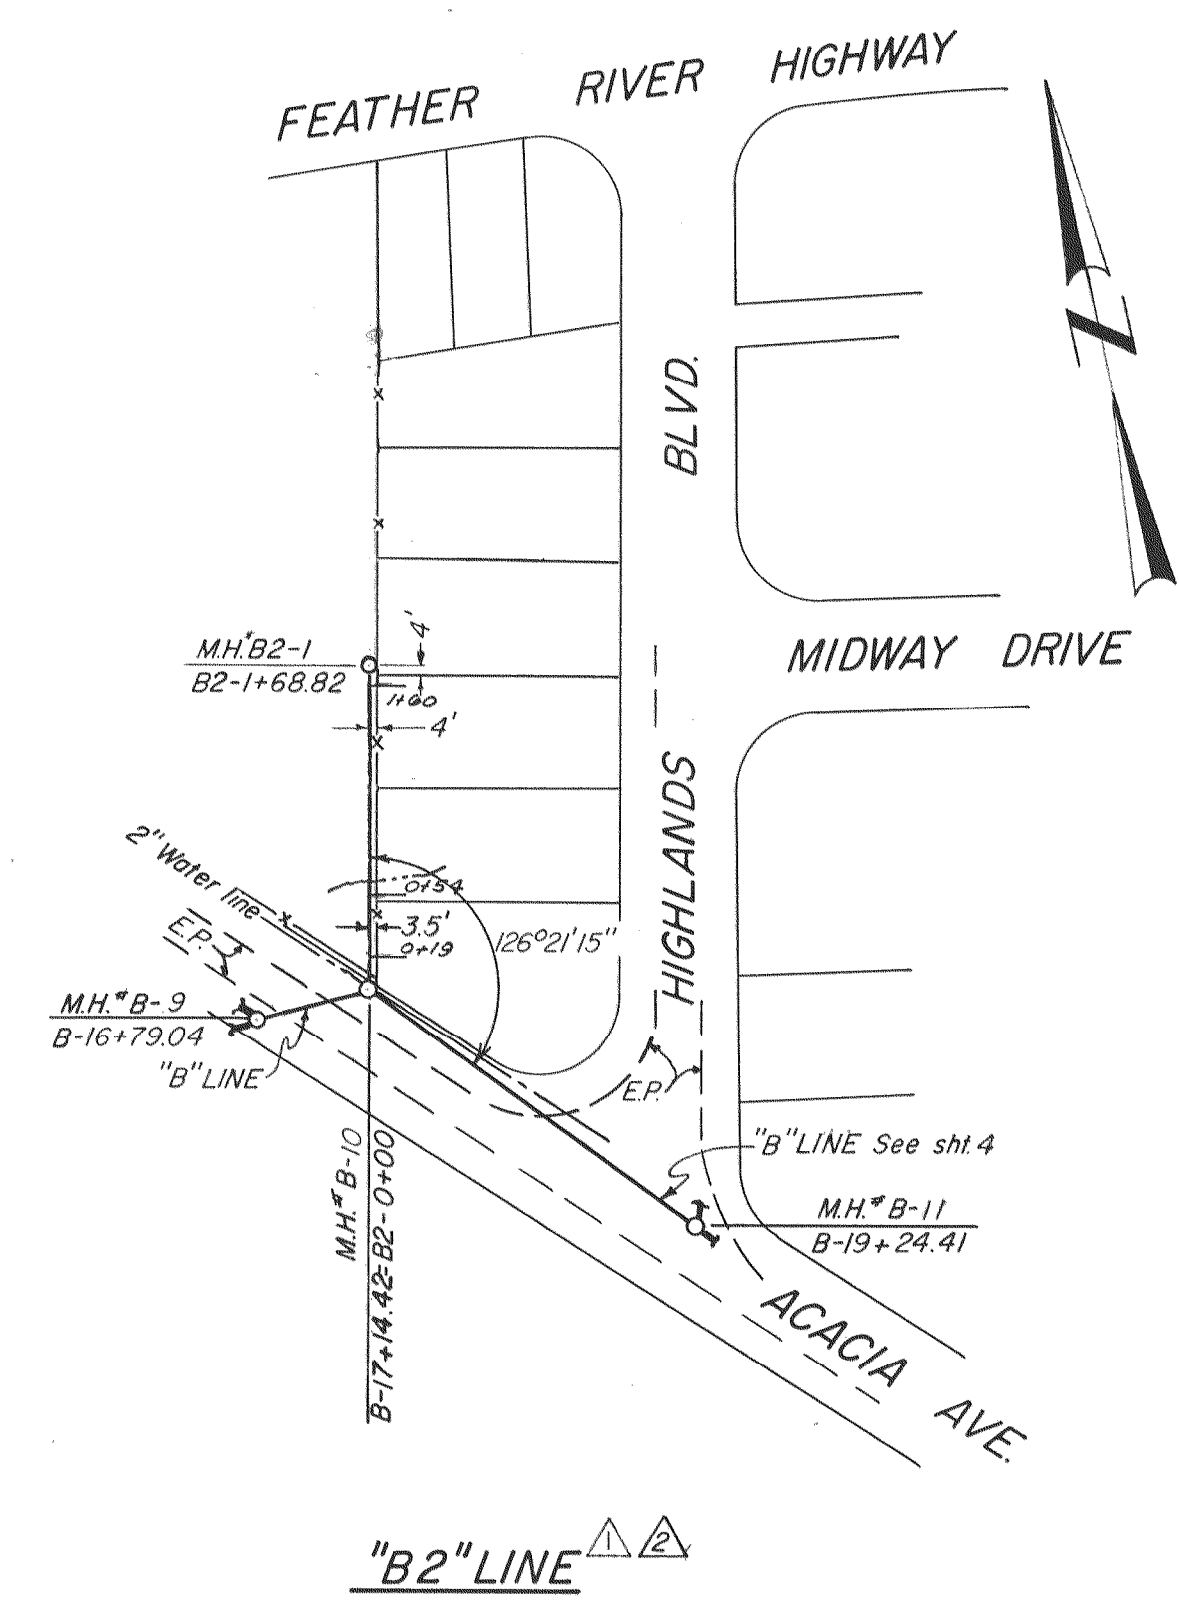


"B2" LINE

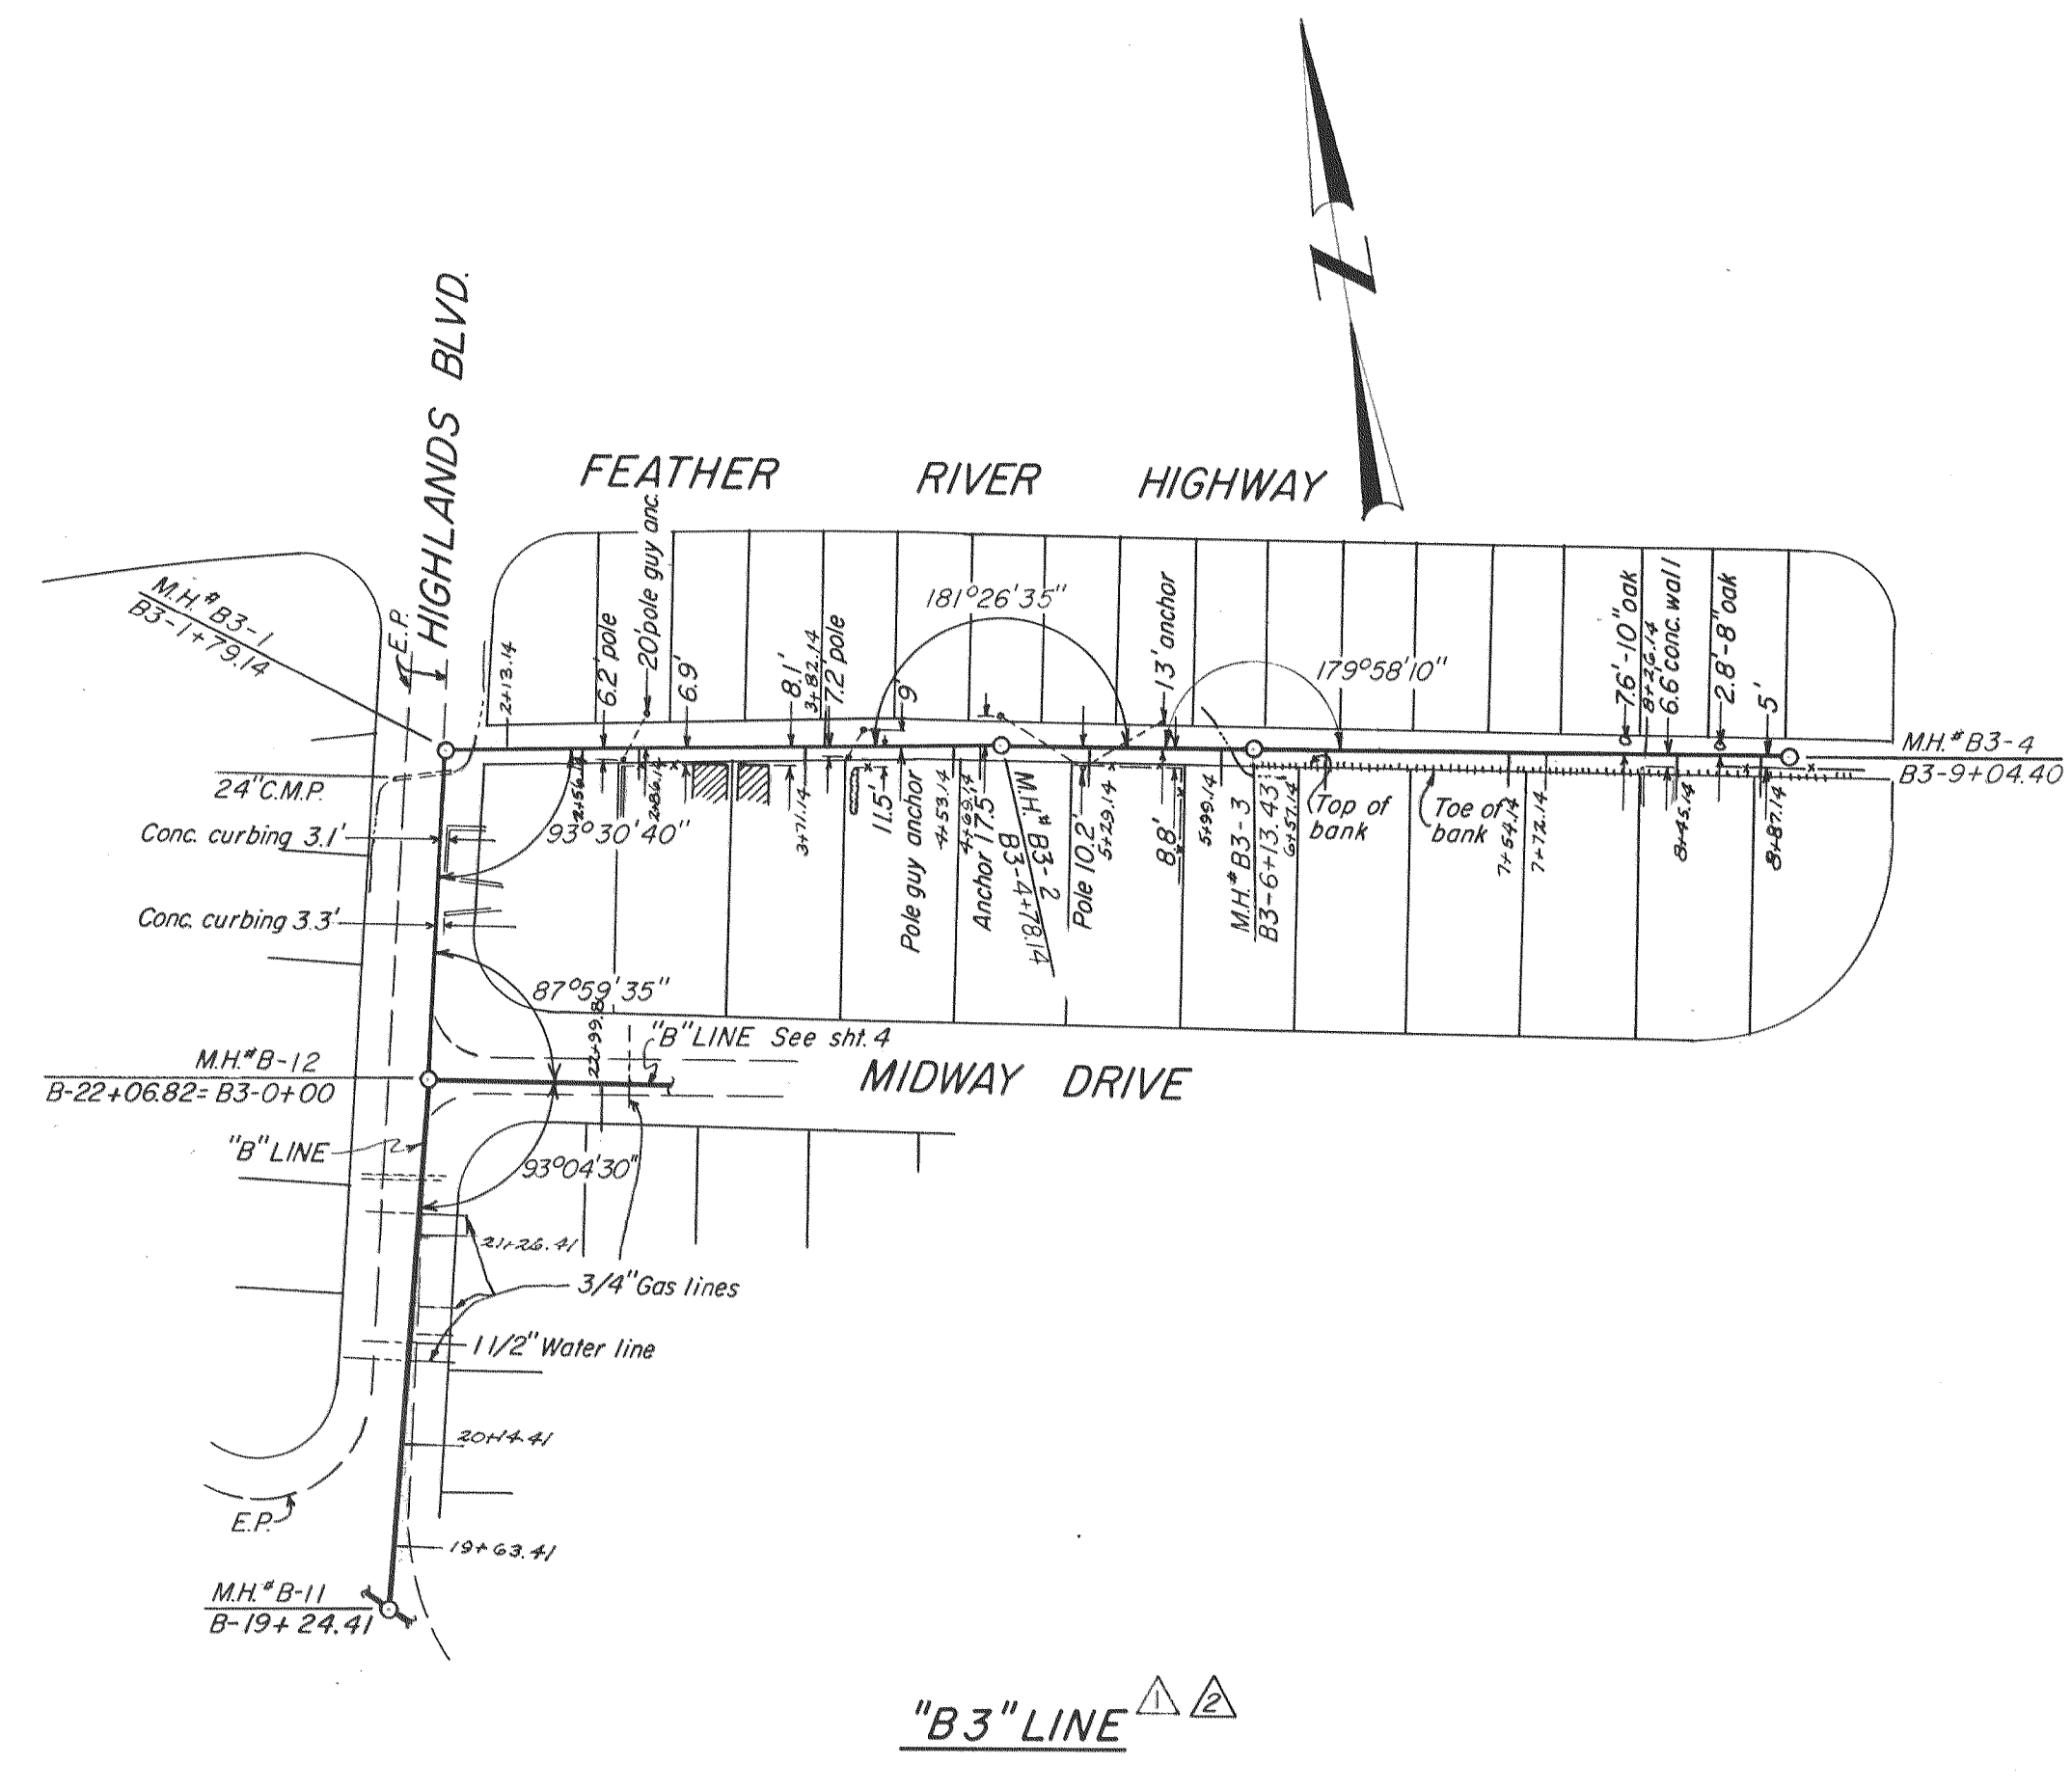


"B3" LINE


Scales:
Horizontal: 1"=100'
Vertical: 1"=8'

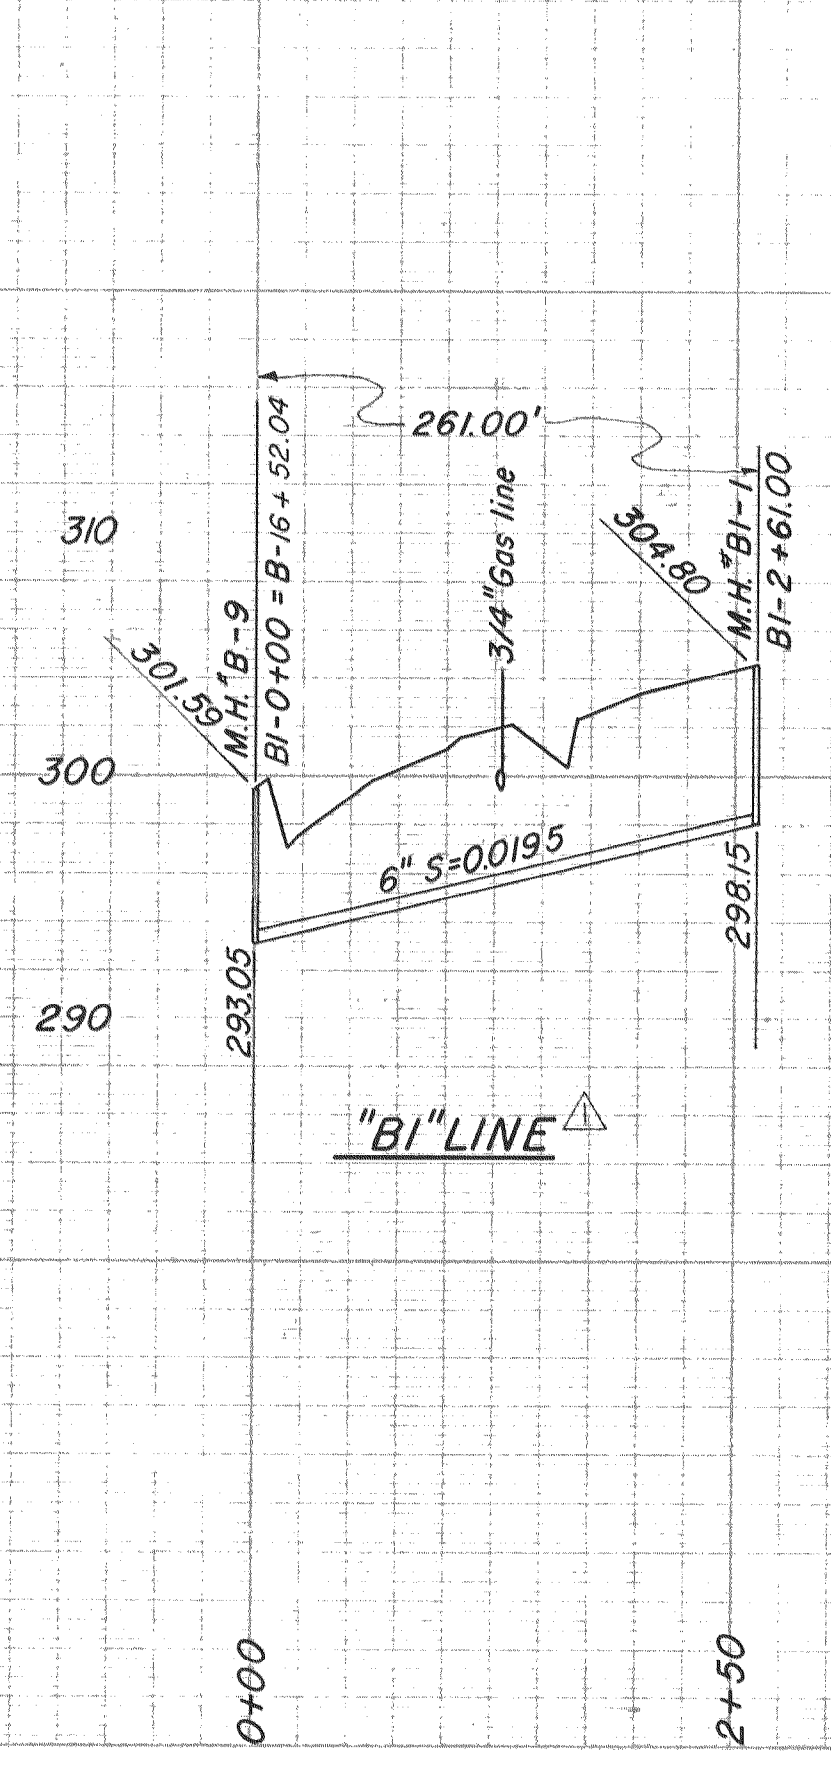

"B1" LINE

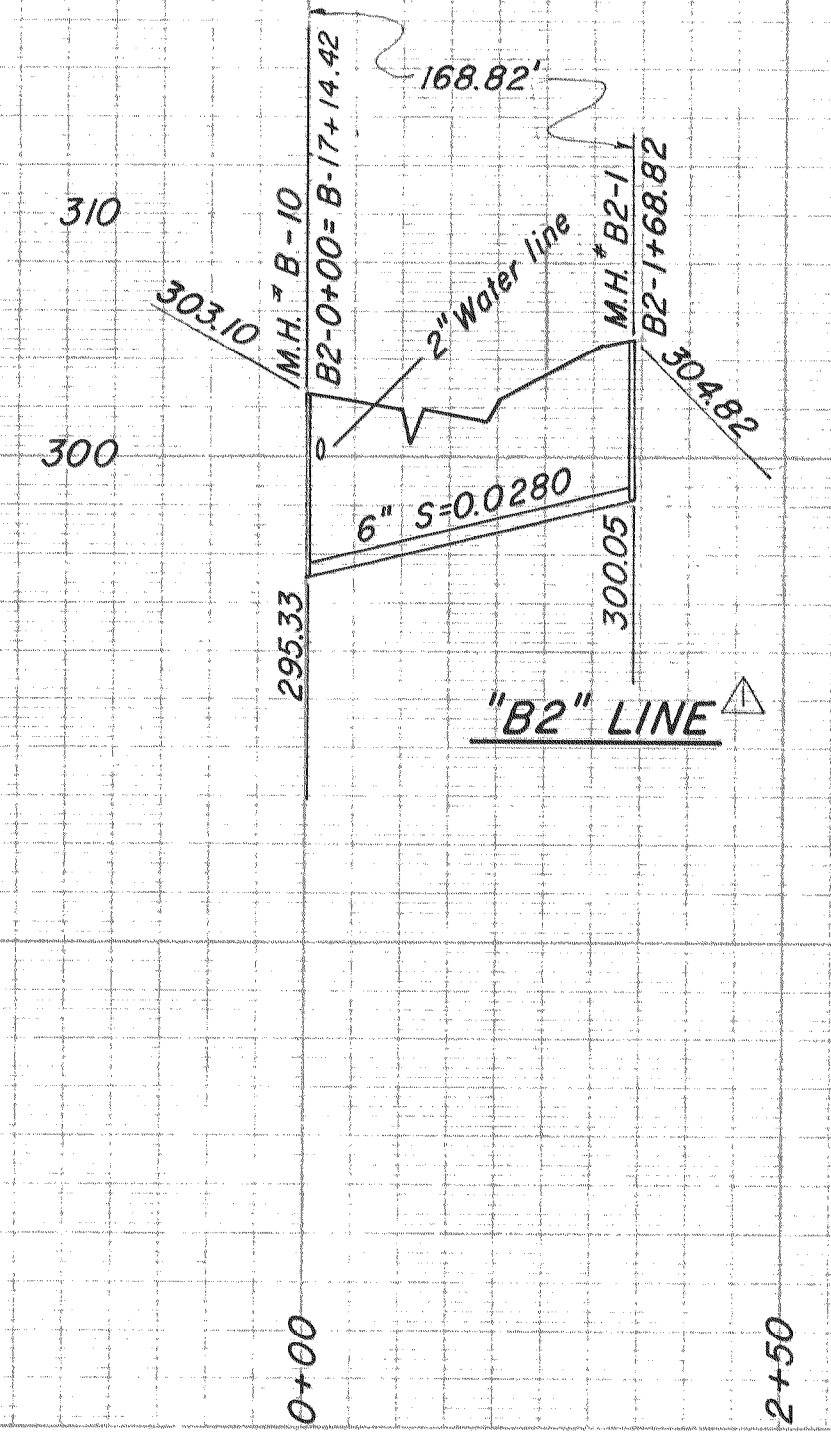

"B2" LINE

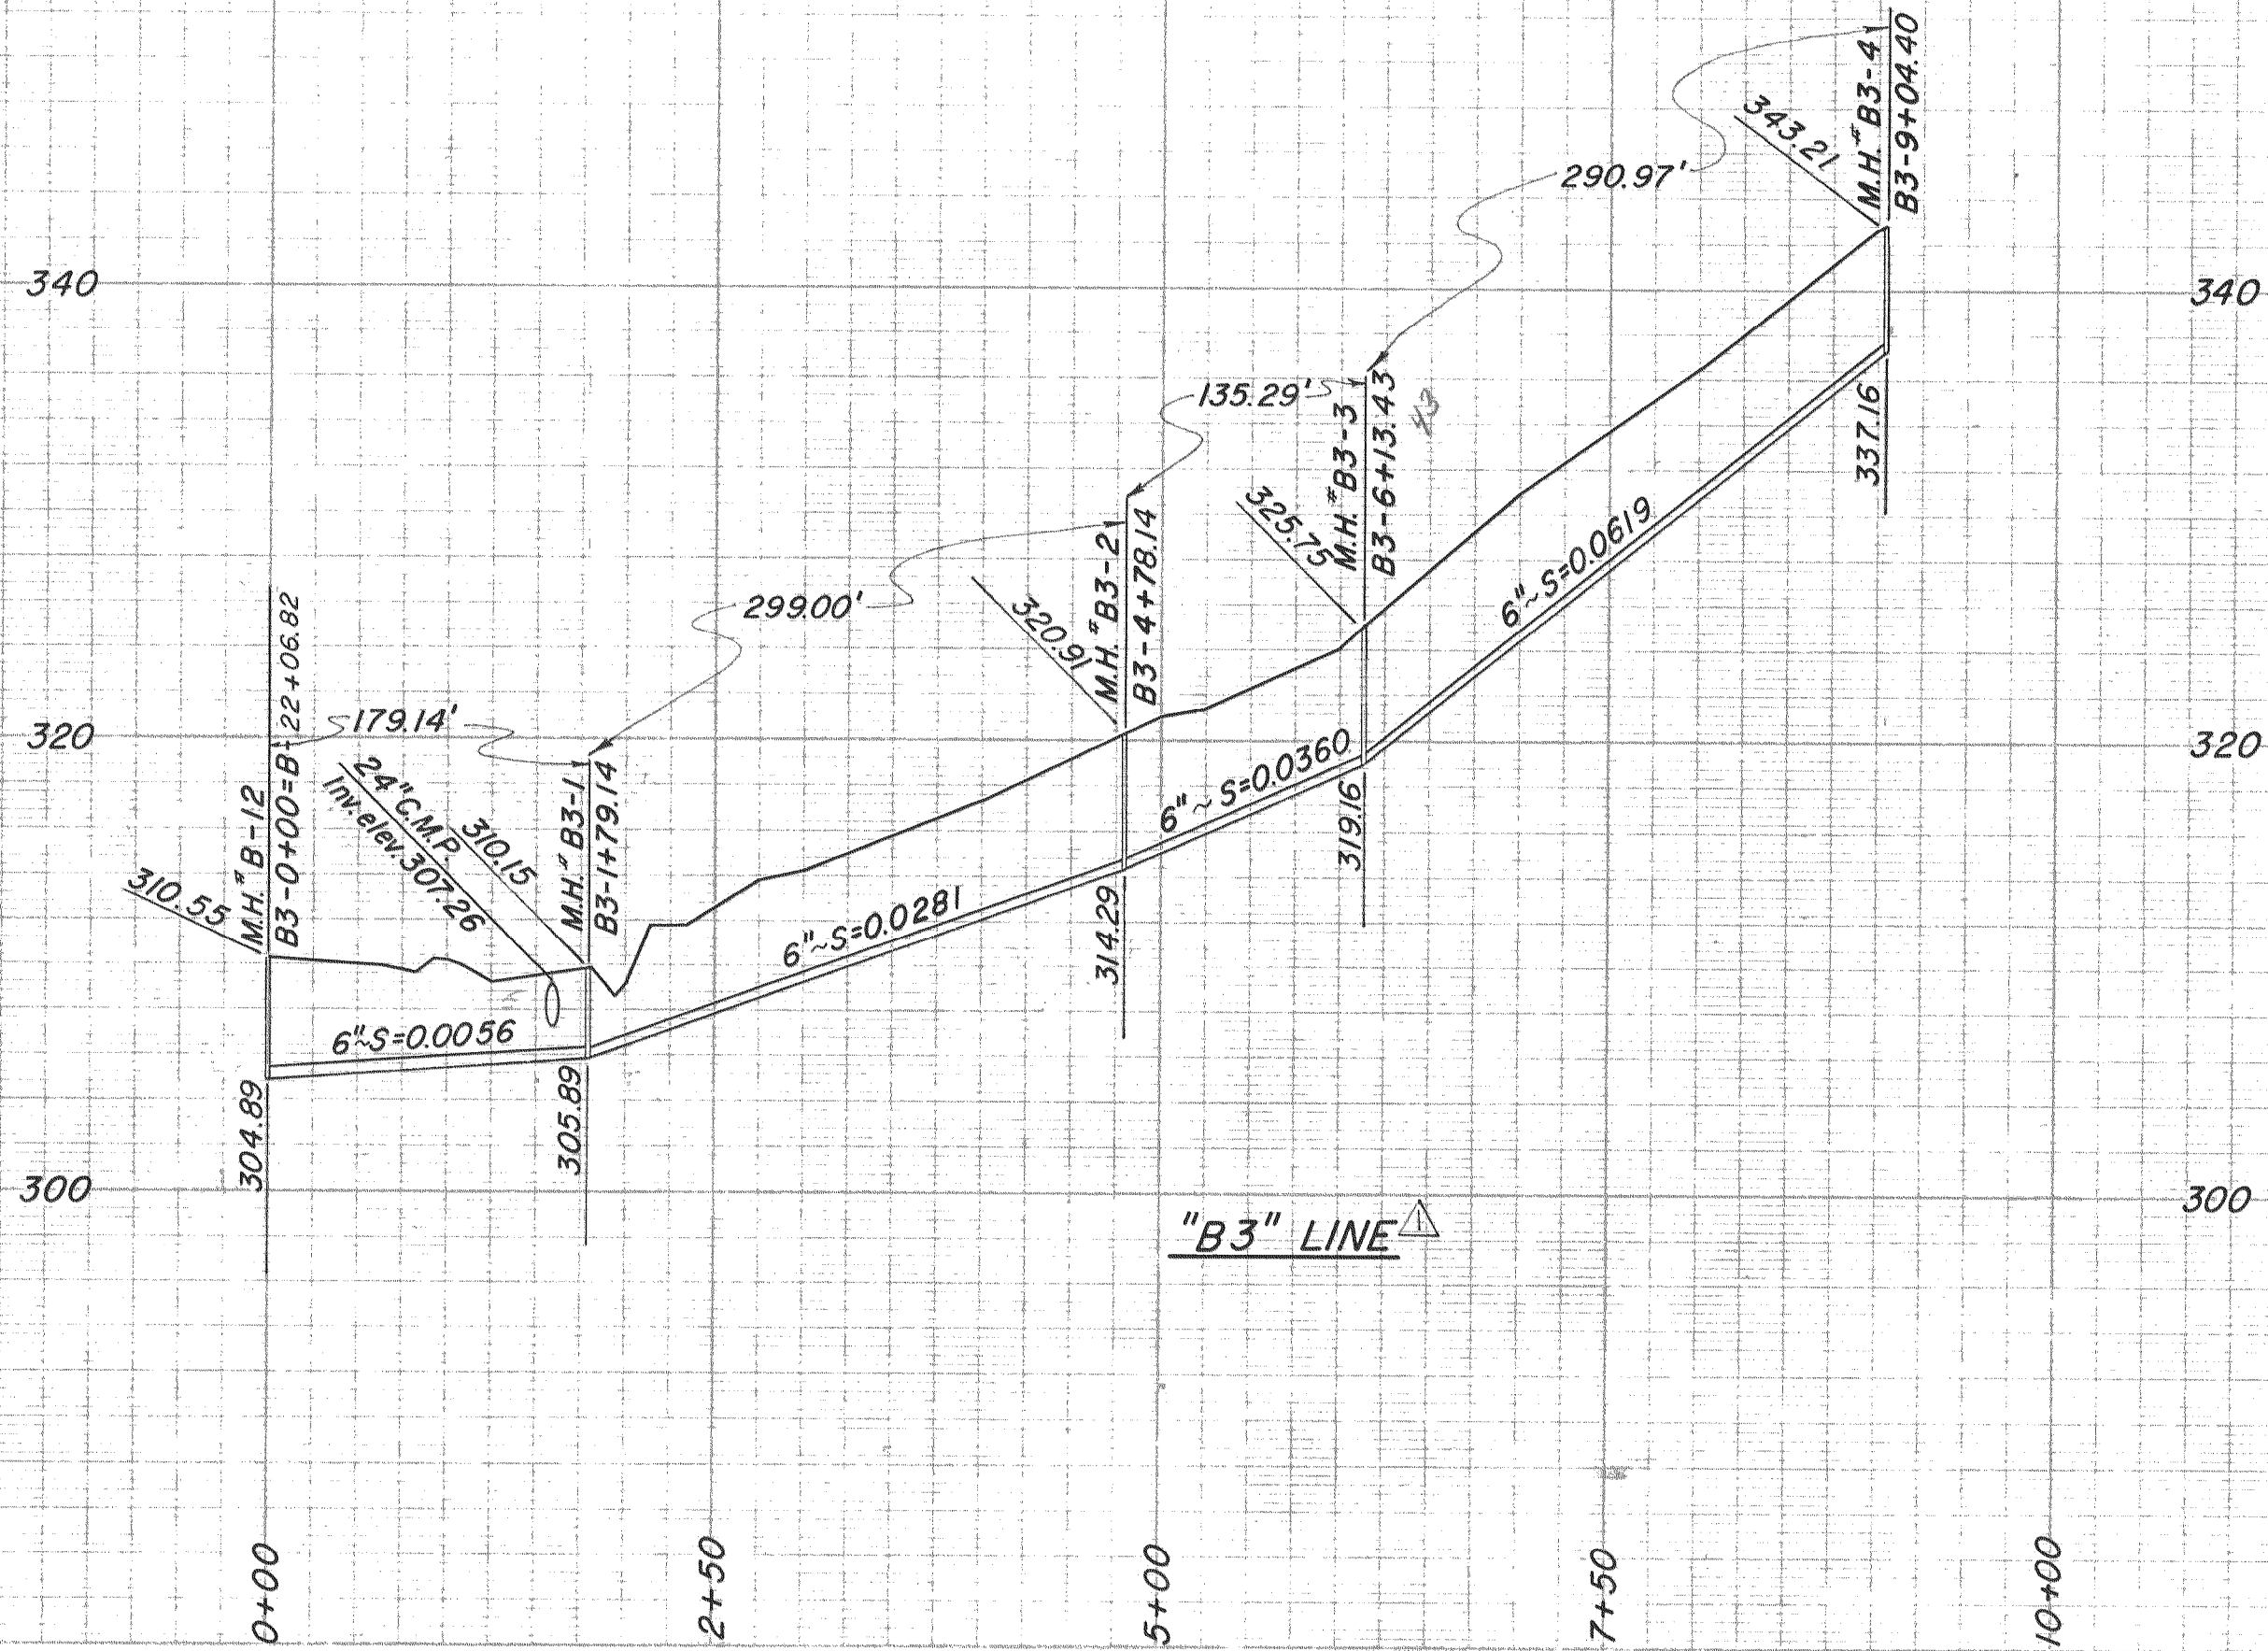

"B3" LINE

AS BUILT				
REV.	DATE	DESCRIPTION	BY	APP.
3.30.62		Revised Sta. "B" Line - Added Laterals	BAB	
Δ AB	11.0.59	Revised entire "B1", "B2" & "B3" lines	L.R.K	

FEATHER PORTALS ASSESSMENT DISTRICT
OROVILLE, CALIFORNIA

SANITARY SEWER SYSTEM
PLAN & PROFILE
"B1", "B2" & "B3" LINES

DEWANTE AND STOWELL
SANITARY AND CIVIL ENGINEERS - SACRAMENTO, CALIFORNIA

DRAWN: L.R.K.	SUBMITTED: <i>Edwin R. Stowell</i>	SHEET NO. 6
CHECKED: NEW.	APPROVED: <i>R.M. Carpenter</i>	OF 11
DATE: March '59		