
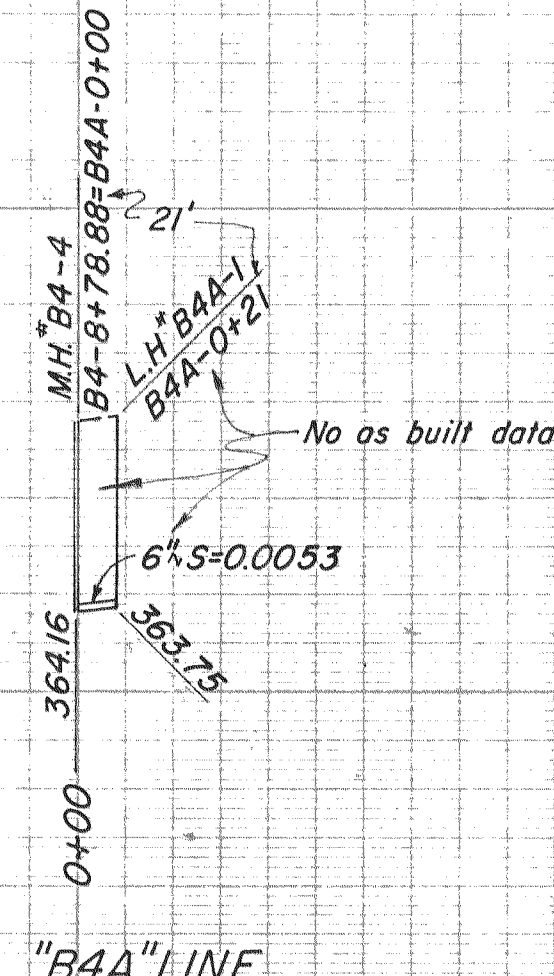
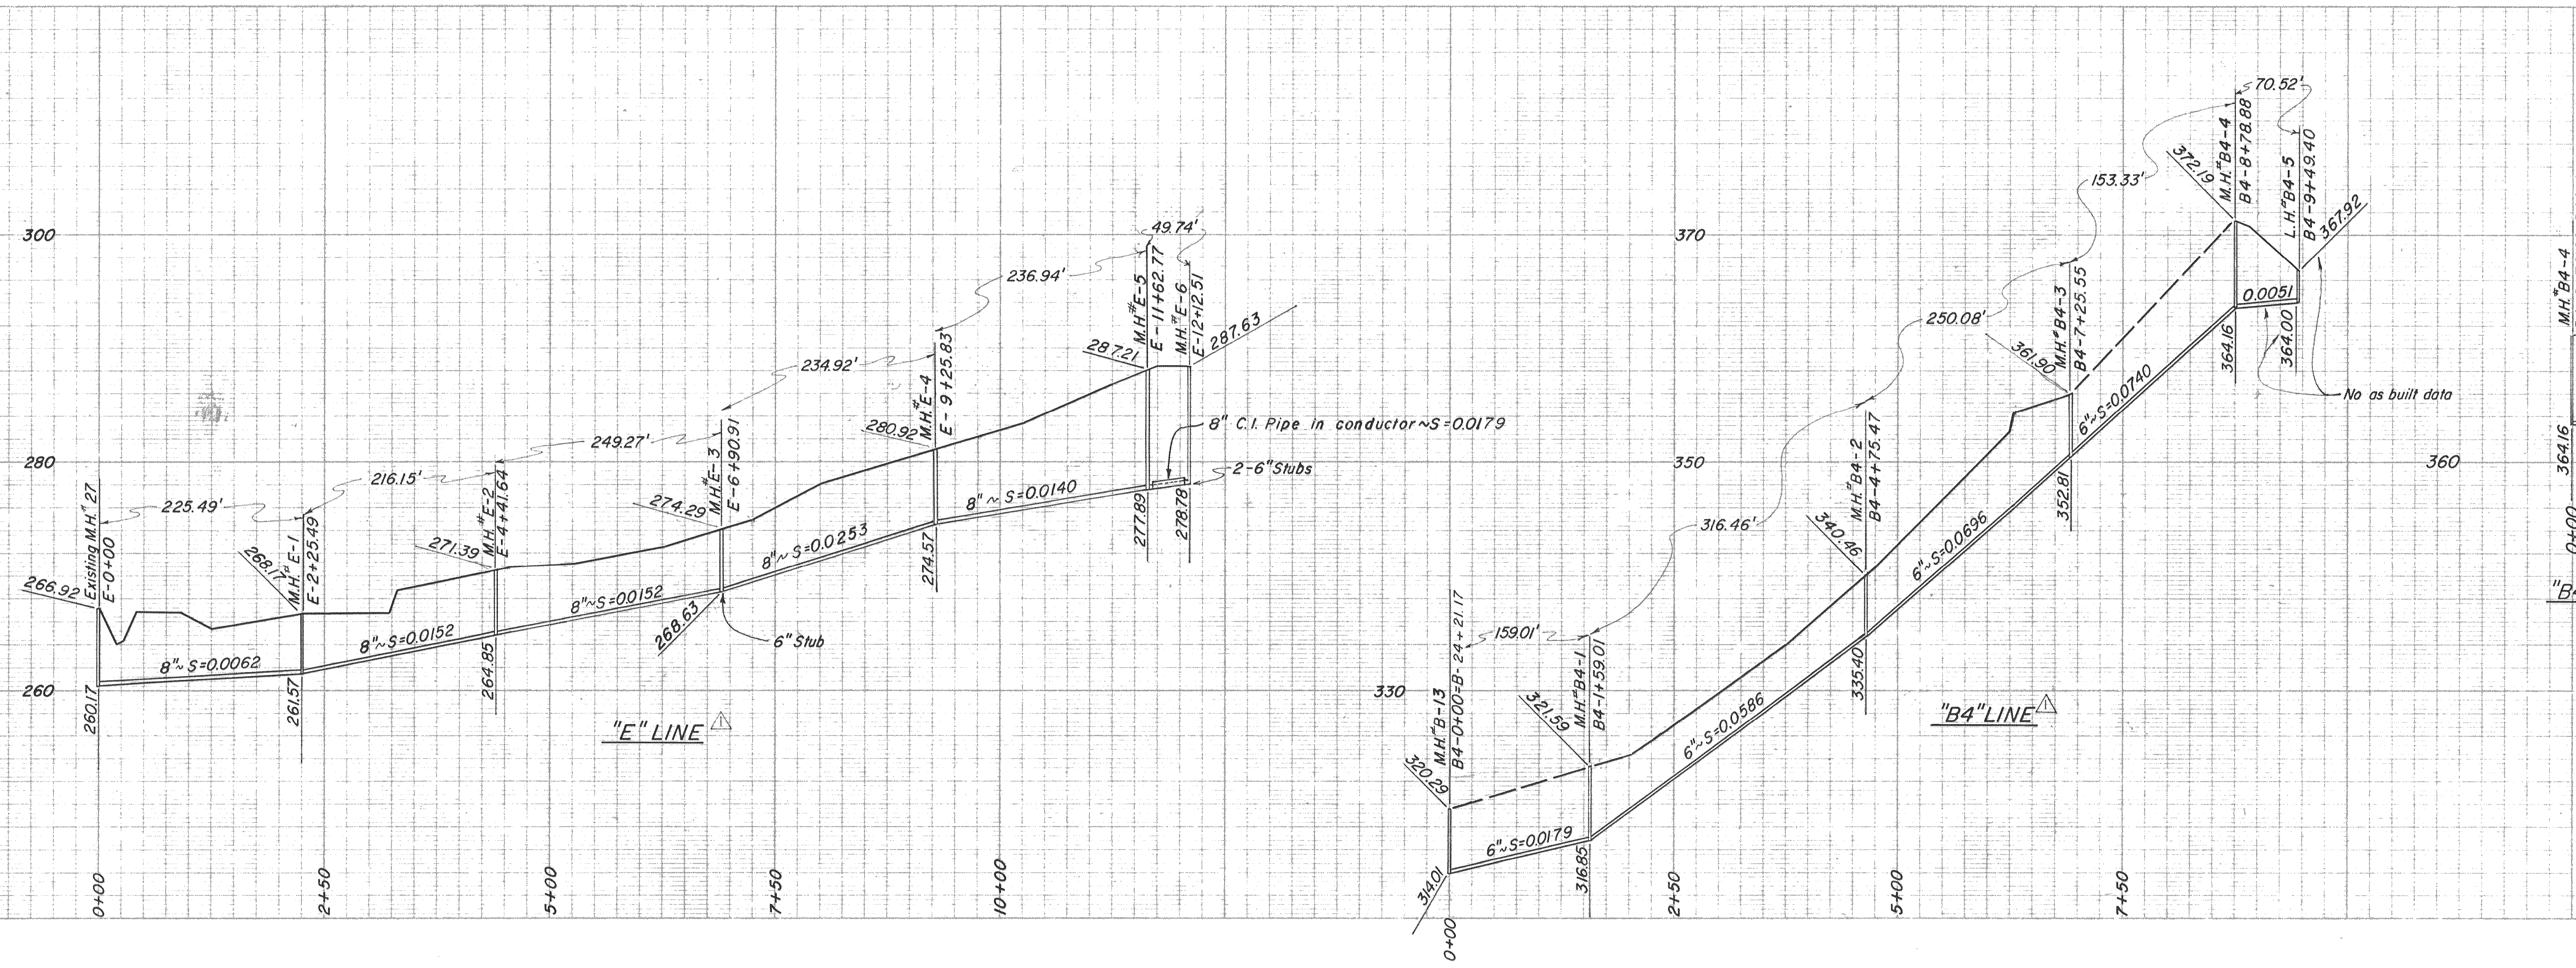


Scales:  
Horizontal: 1"=100'  
Vertical: 1"=8'

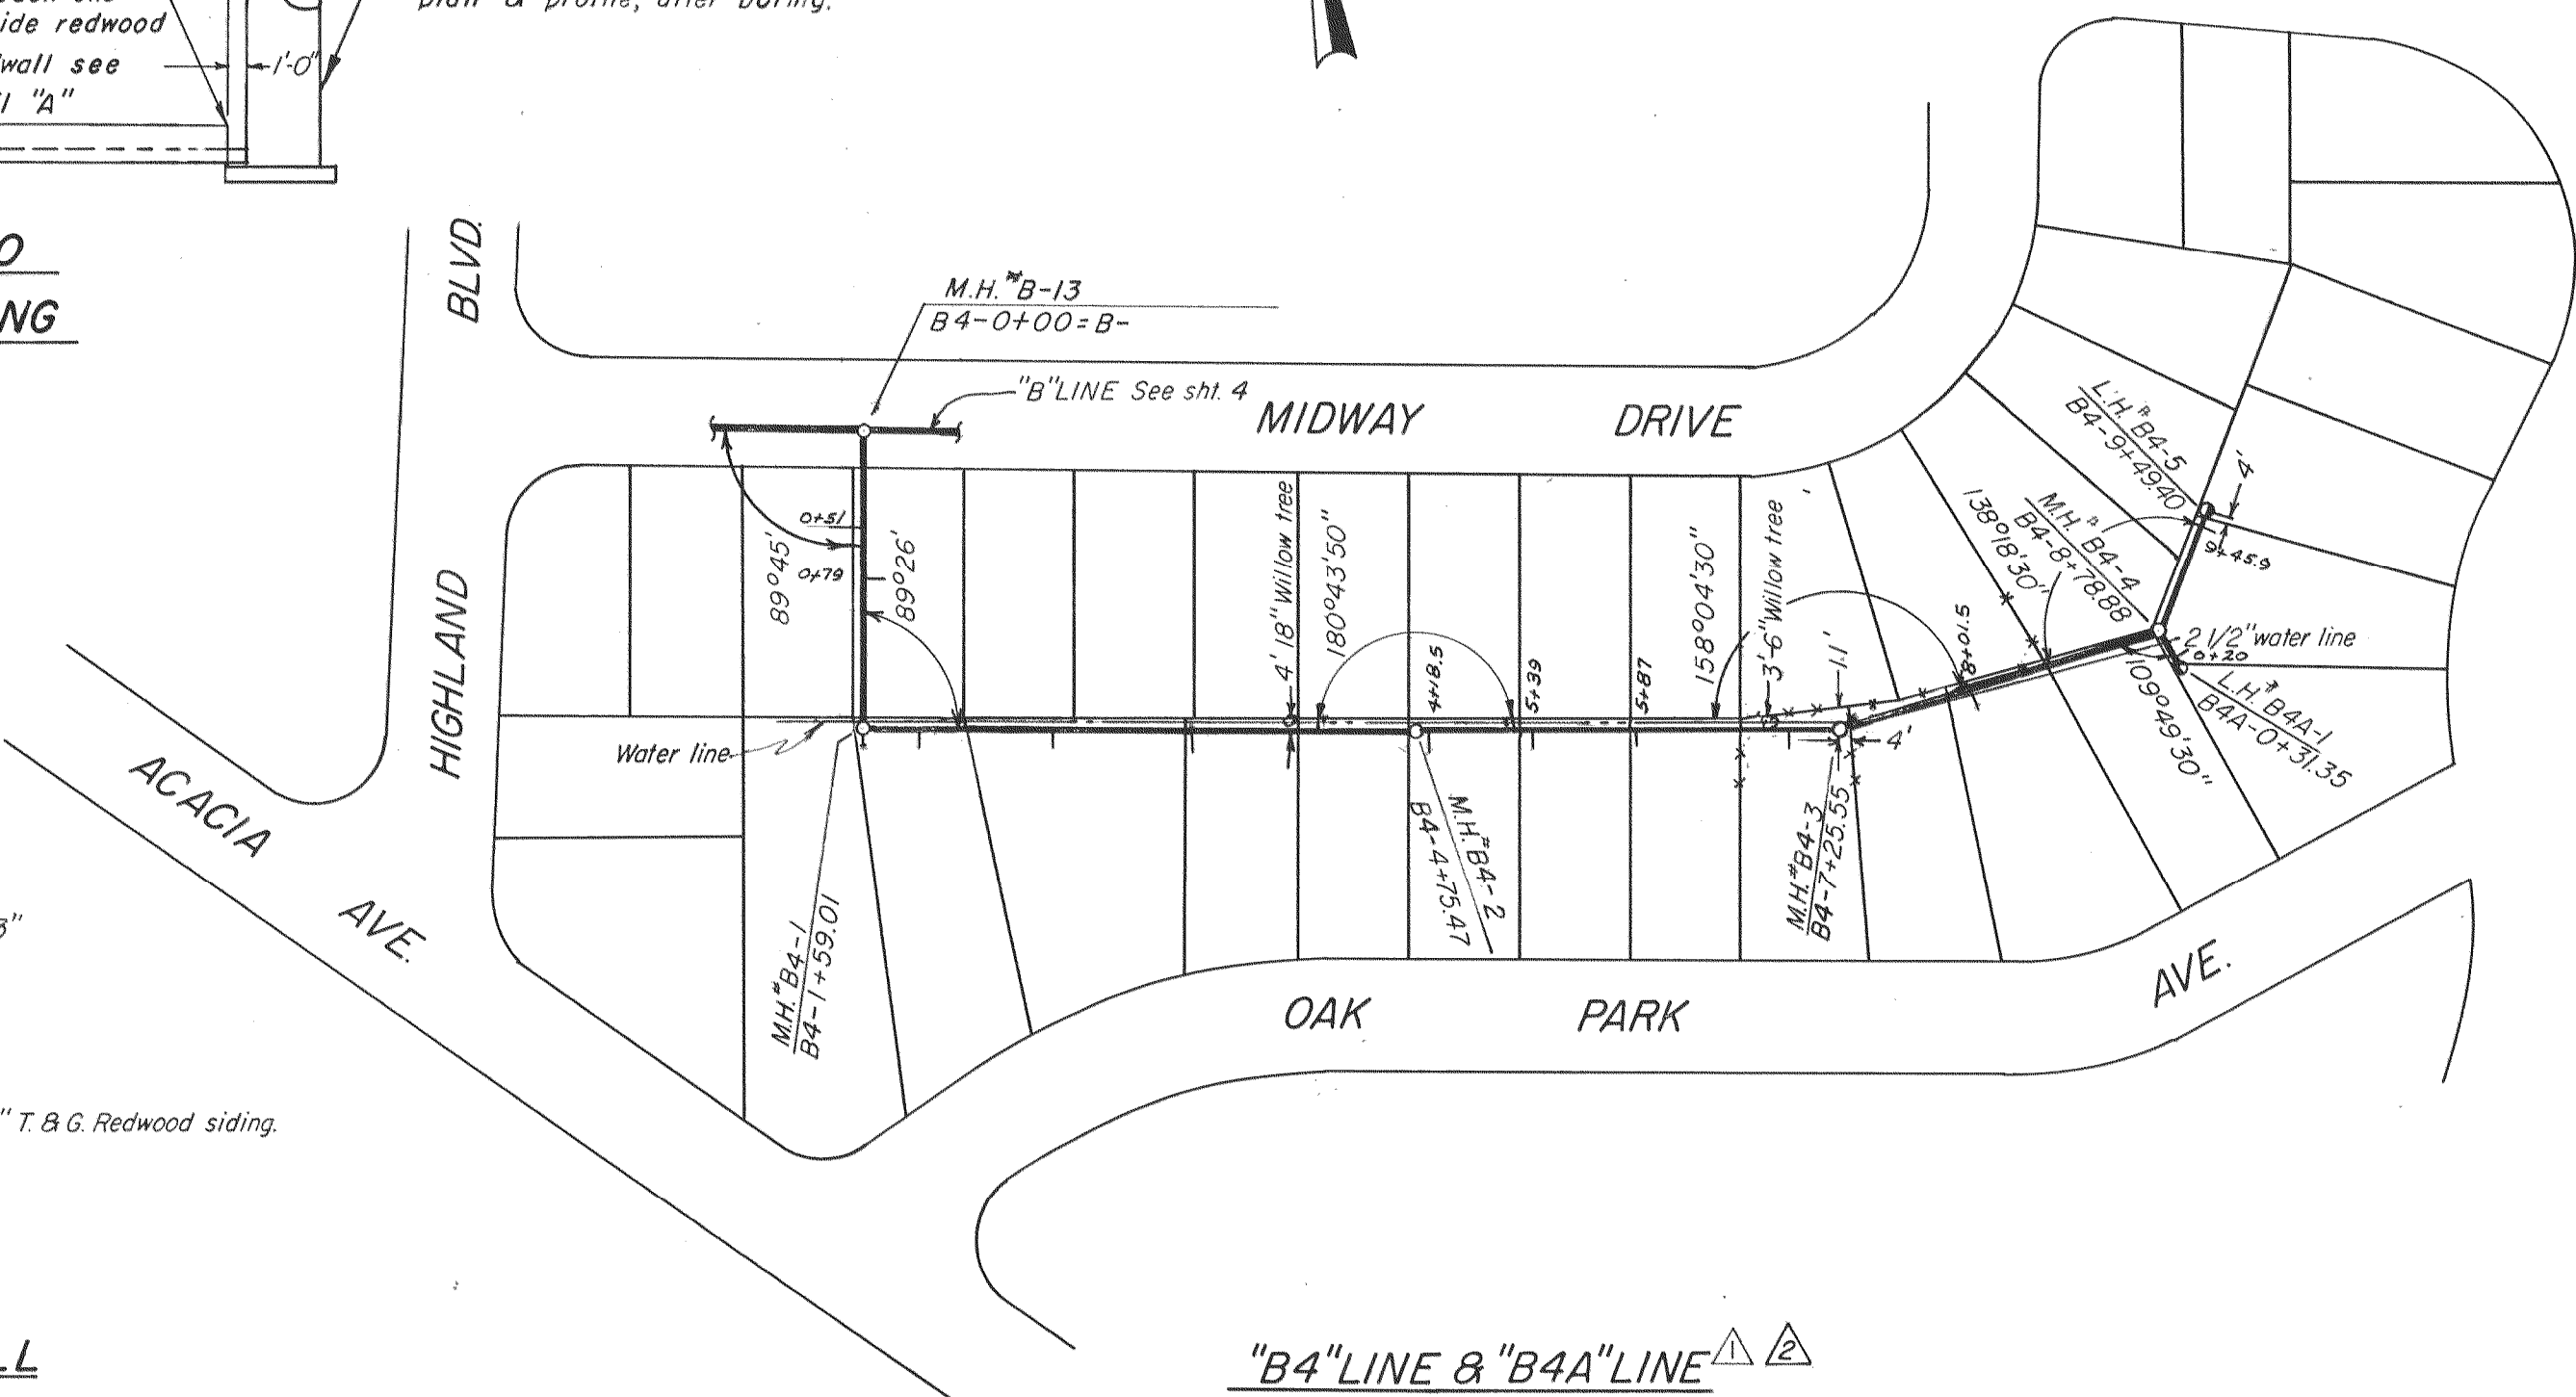

REV.	DATE	DESCRIPTION	BY	APP.
2	3-30-62	Added Laterals		BAB
1	11-2-59	Revised entire "B4", "B4A" & "E" lines		LRK

FEATHER PORTALS ASSESSMENT DISTRICT  
OROVILLE, CALIFORNIA

SANITARY SEWER SYSTEM  
**PLAN & PROFILE  
"B4" & "E" LINES**

DEWANTE AND STOWELL  
SANITARY AND CIVIL ENGINEERS - SACRAMENTO, CALIFORNIA

DRAWN: L.R.K. SUBMITTED: *Edwin R. Stowell* SHEET NO. 7  
 CHECKED: N.E.W. APPROVED: *[Signature]* OF 11  
 DATE: March '59