


"C" & "C1" LINES

"D3" & "D4" LINES

SCALES:
Horizontal: 1"=100'
Vertical: 1"=8'

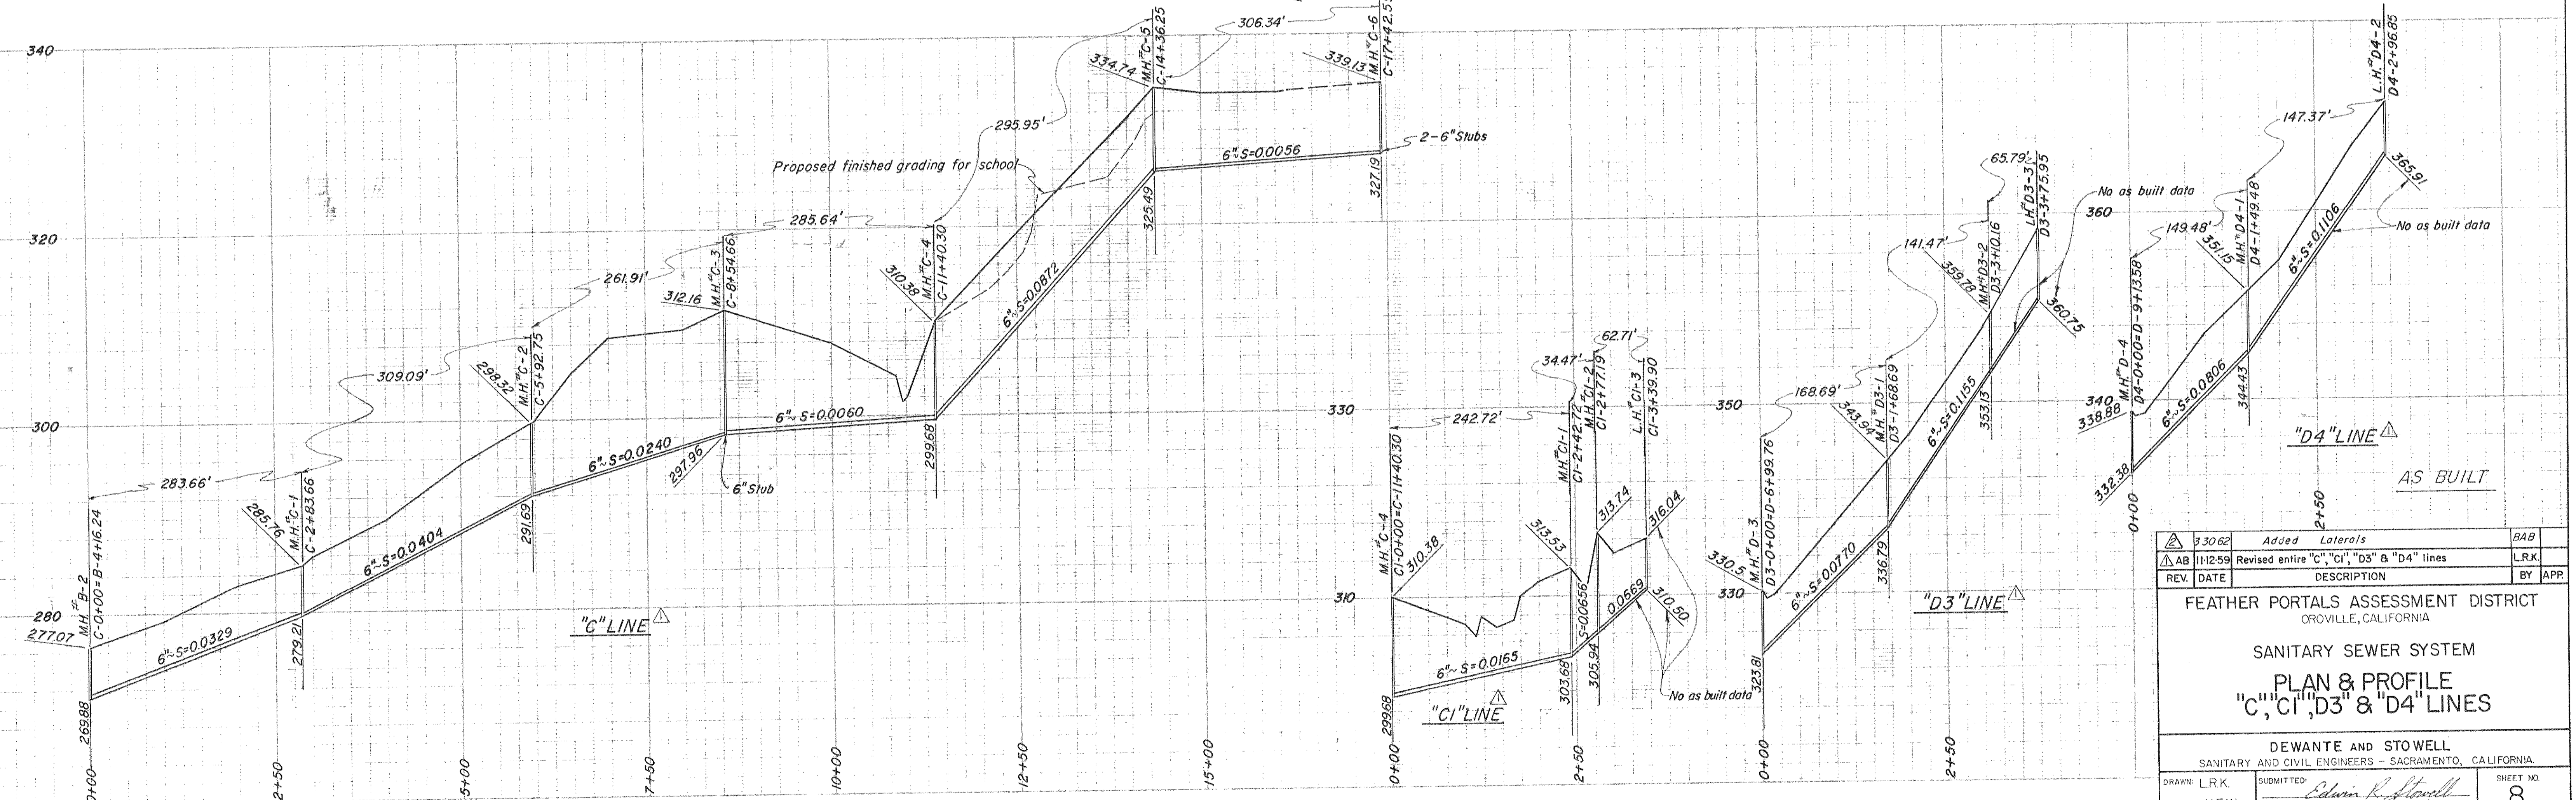

33062	Adjed Laterals	BAB
11259	Revised entire "C", "C1", "D3" & "D4" lines	LRK
REV. DATE	DESCRIPTION	BY APP
FEATHER PORTALS ASSESSMENT DISTRICT ORVILLE, CALIFORNIA		
SANITARY SEWER SYSTEM PLAN & PROFILE "C", "C1", "D3" & "D4" LINES		
DEWANTE AND STOWELL SANITARY AND CIVIL ENGINEERS - SACRAMENTO, CALIFORNIA		
DRAWN: L.R.K.	SUBMITTED: Edwin R. Stowell	SHEET NO. 8
CHECKED: N.E.W.	APPROVED: J.A. Carpenter	OF 11
DATE: March '59		