


Scales:
Horizontal: 1"=100'
Vertical: 1"=8'

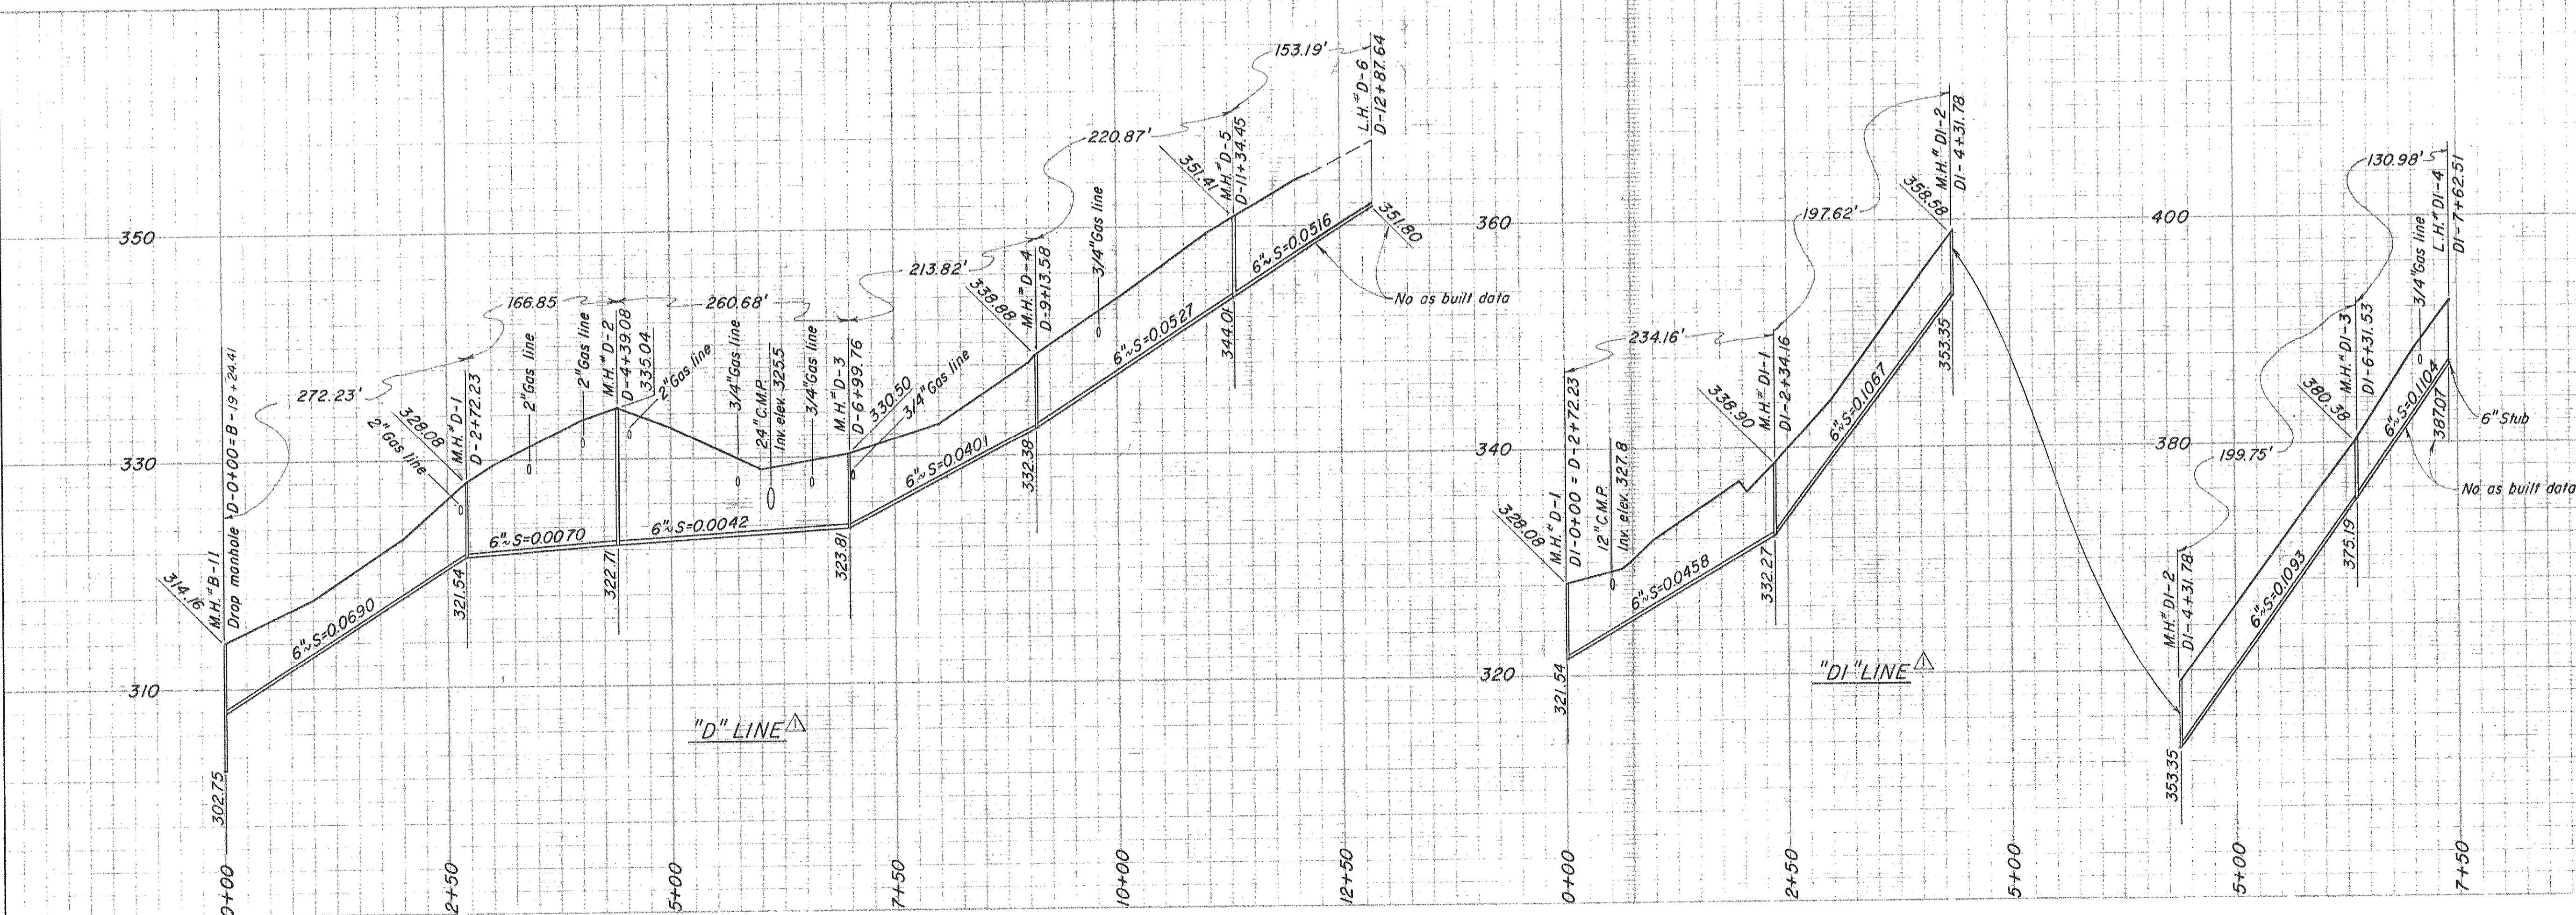

AS BUILT			
REV.	DATE	DESCRIPTION	BY APP.
33062		Added Laterals	BAB
AB	11/12/59	Revised entire "D" & "DI" lines	LRK

FEATHER PORTALS ASSESSMENT DISTRICT
OROVILLE, CALIFORNIA

SANITARY SEWER SYSTEM
PLAN & PROFILE
"D" & "DI" LINES

DEWANTE AND STOWELL
SANITARY AND CIVIL ENGINEERS - SACRAMENTO, CALIFORNIA

DRAWN: L.R.K.	SUBMITTED: <i>Robert R. Stowell</i>	SHEET NO: 9
CHECKED: N.E.W.	APPROVED: <i>J.M. Carpenter</i>	OF 11
DATE: March '59		