



"E1" LINE $\triangle \triangle$

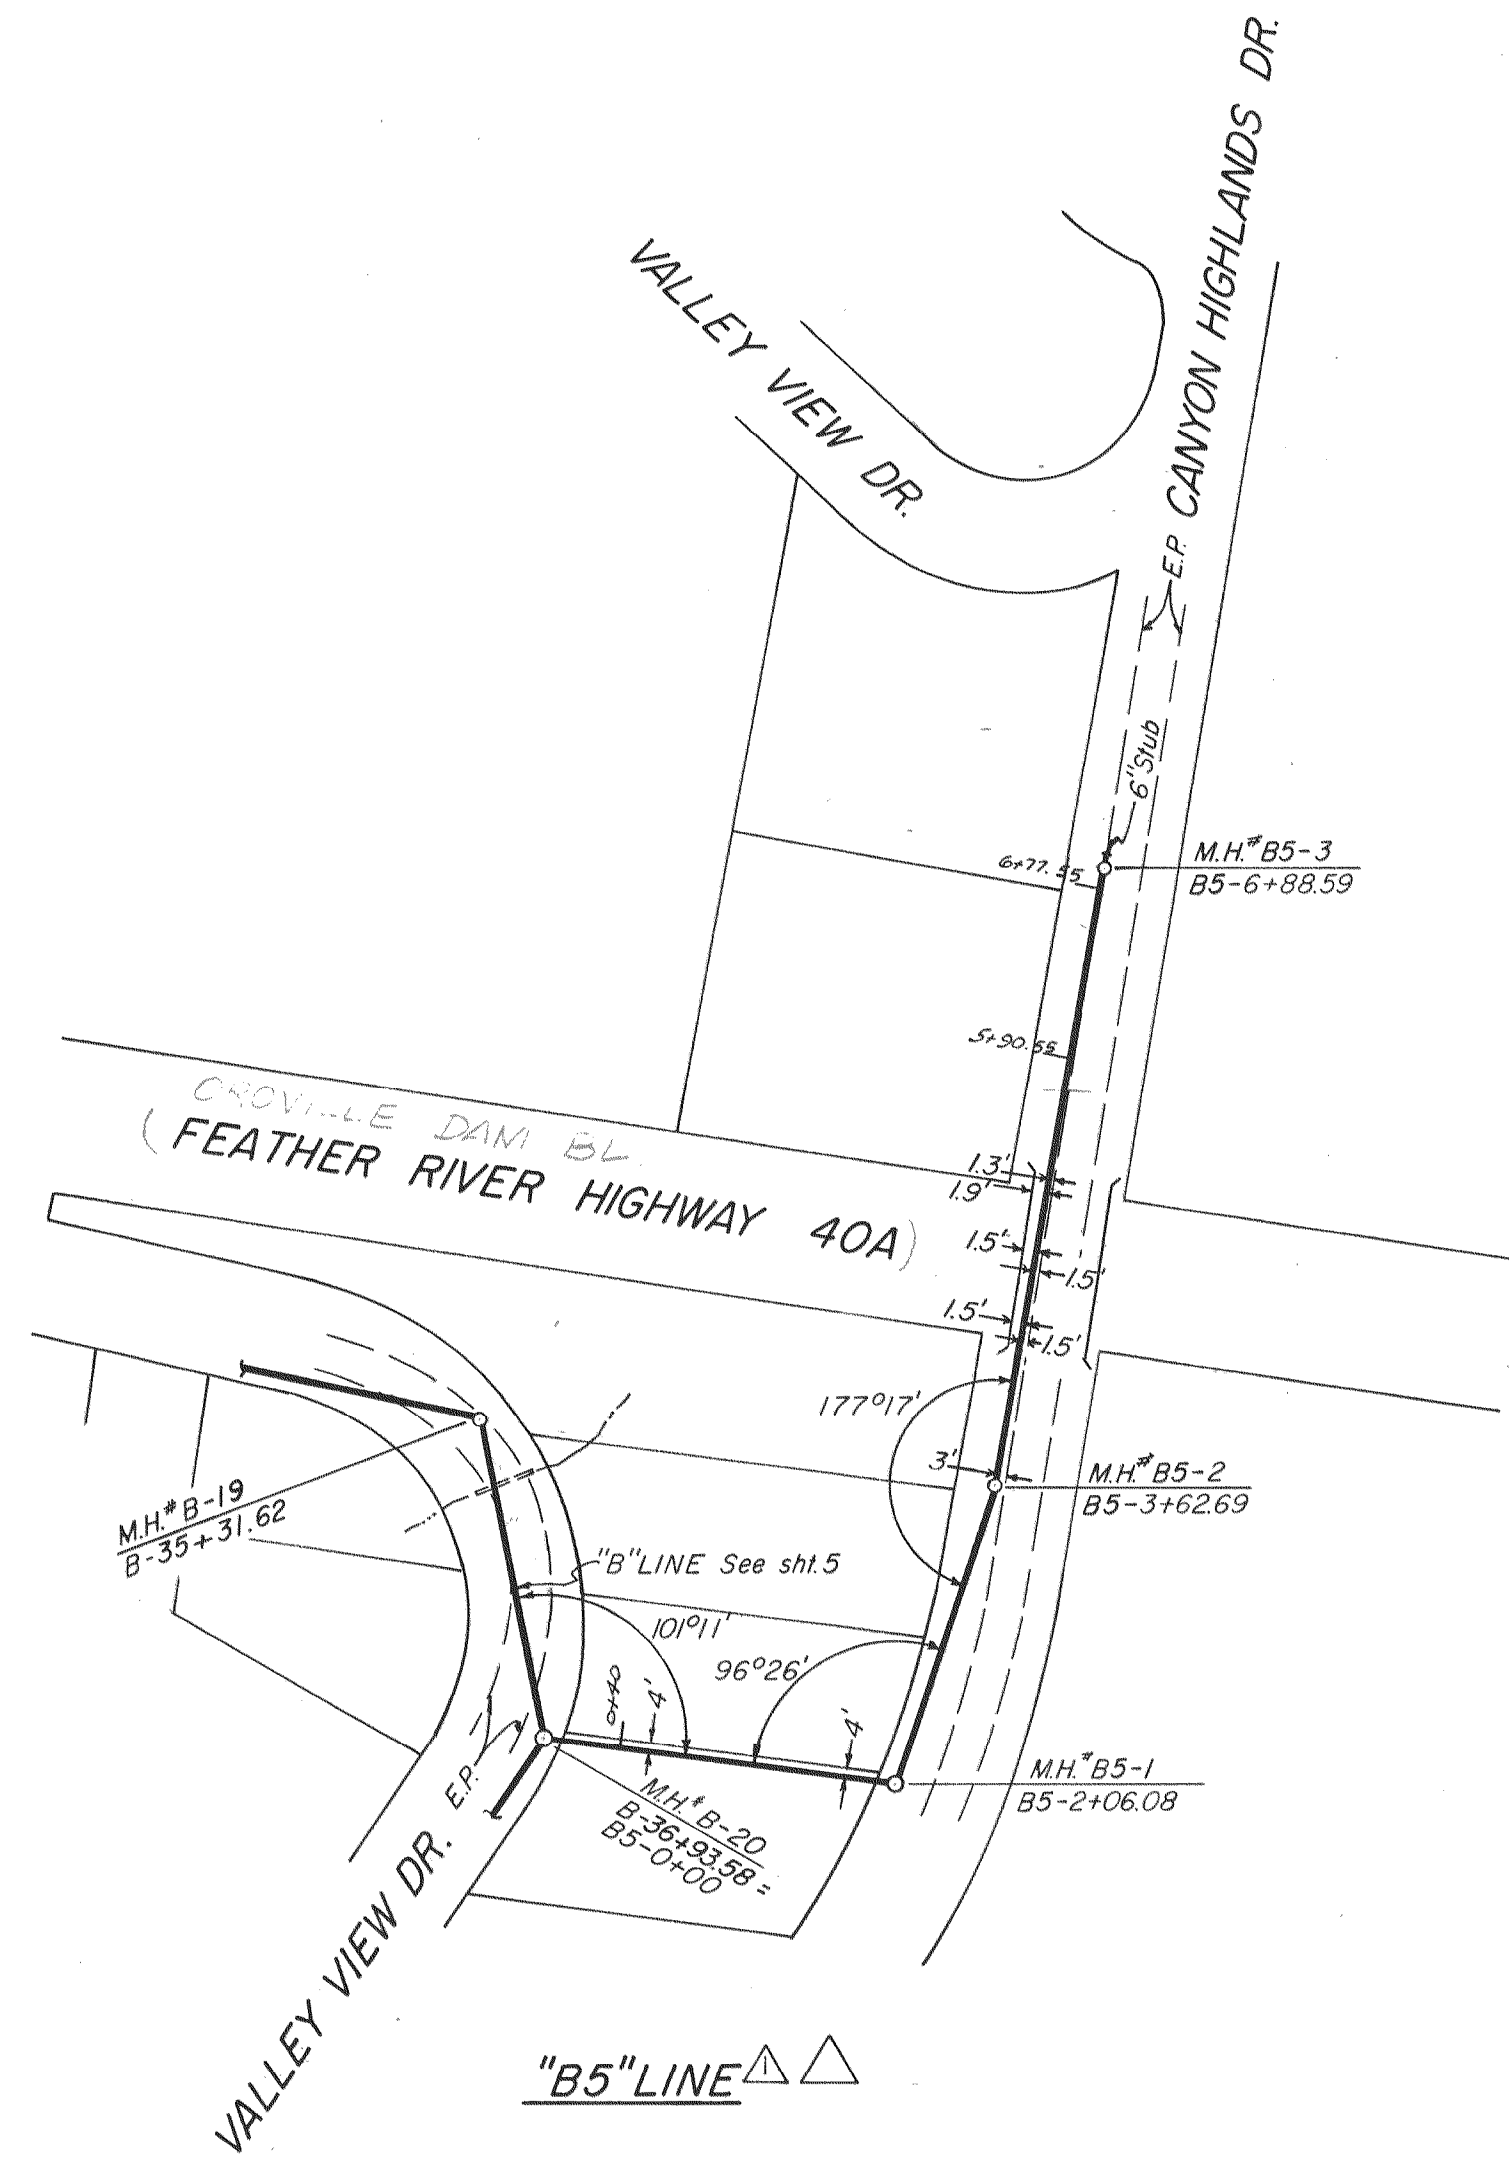


"B5" LINE $\triangle \triangle$

Scales:
Horizontal: 1"=100'
Vertical: 1"=8'

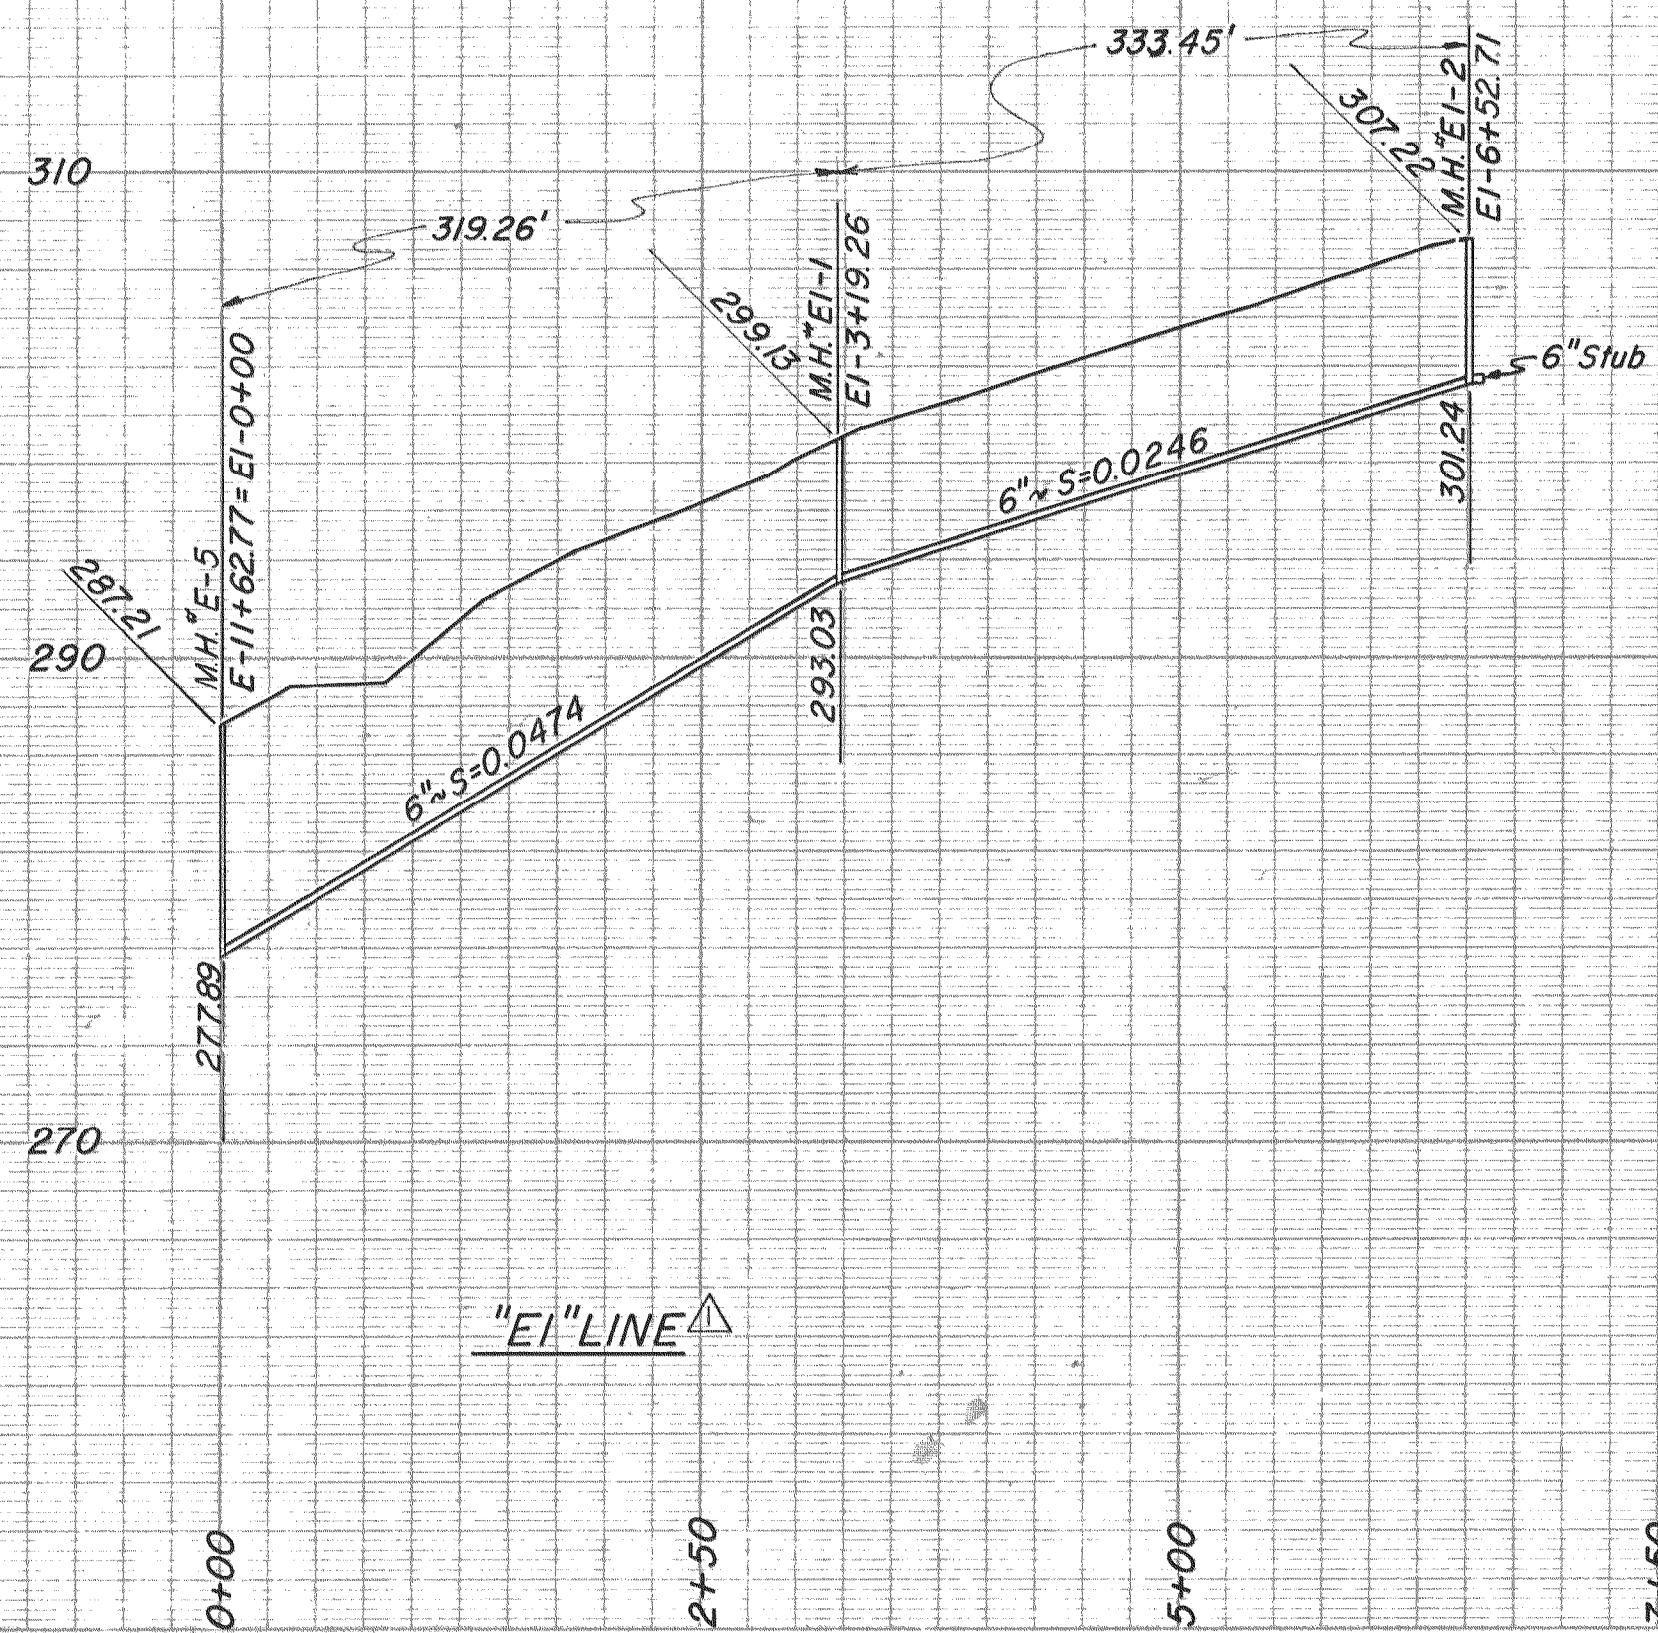

"E1" LINE $\triangle \triangle$

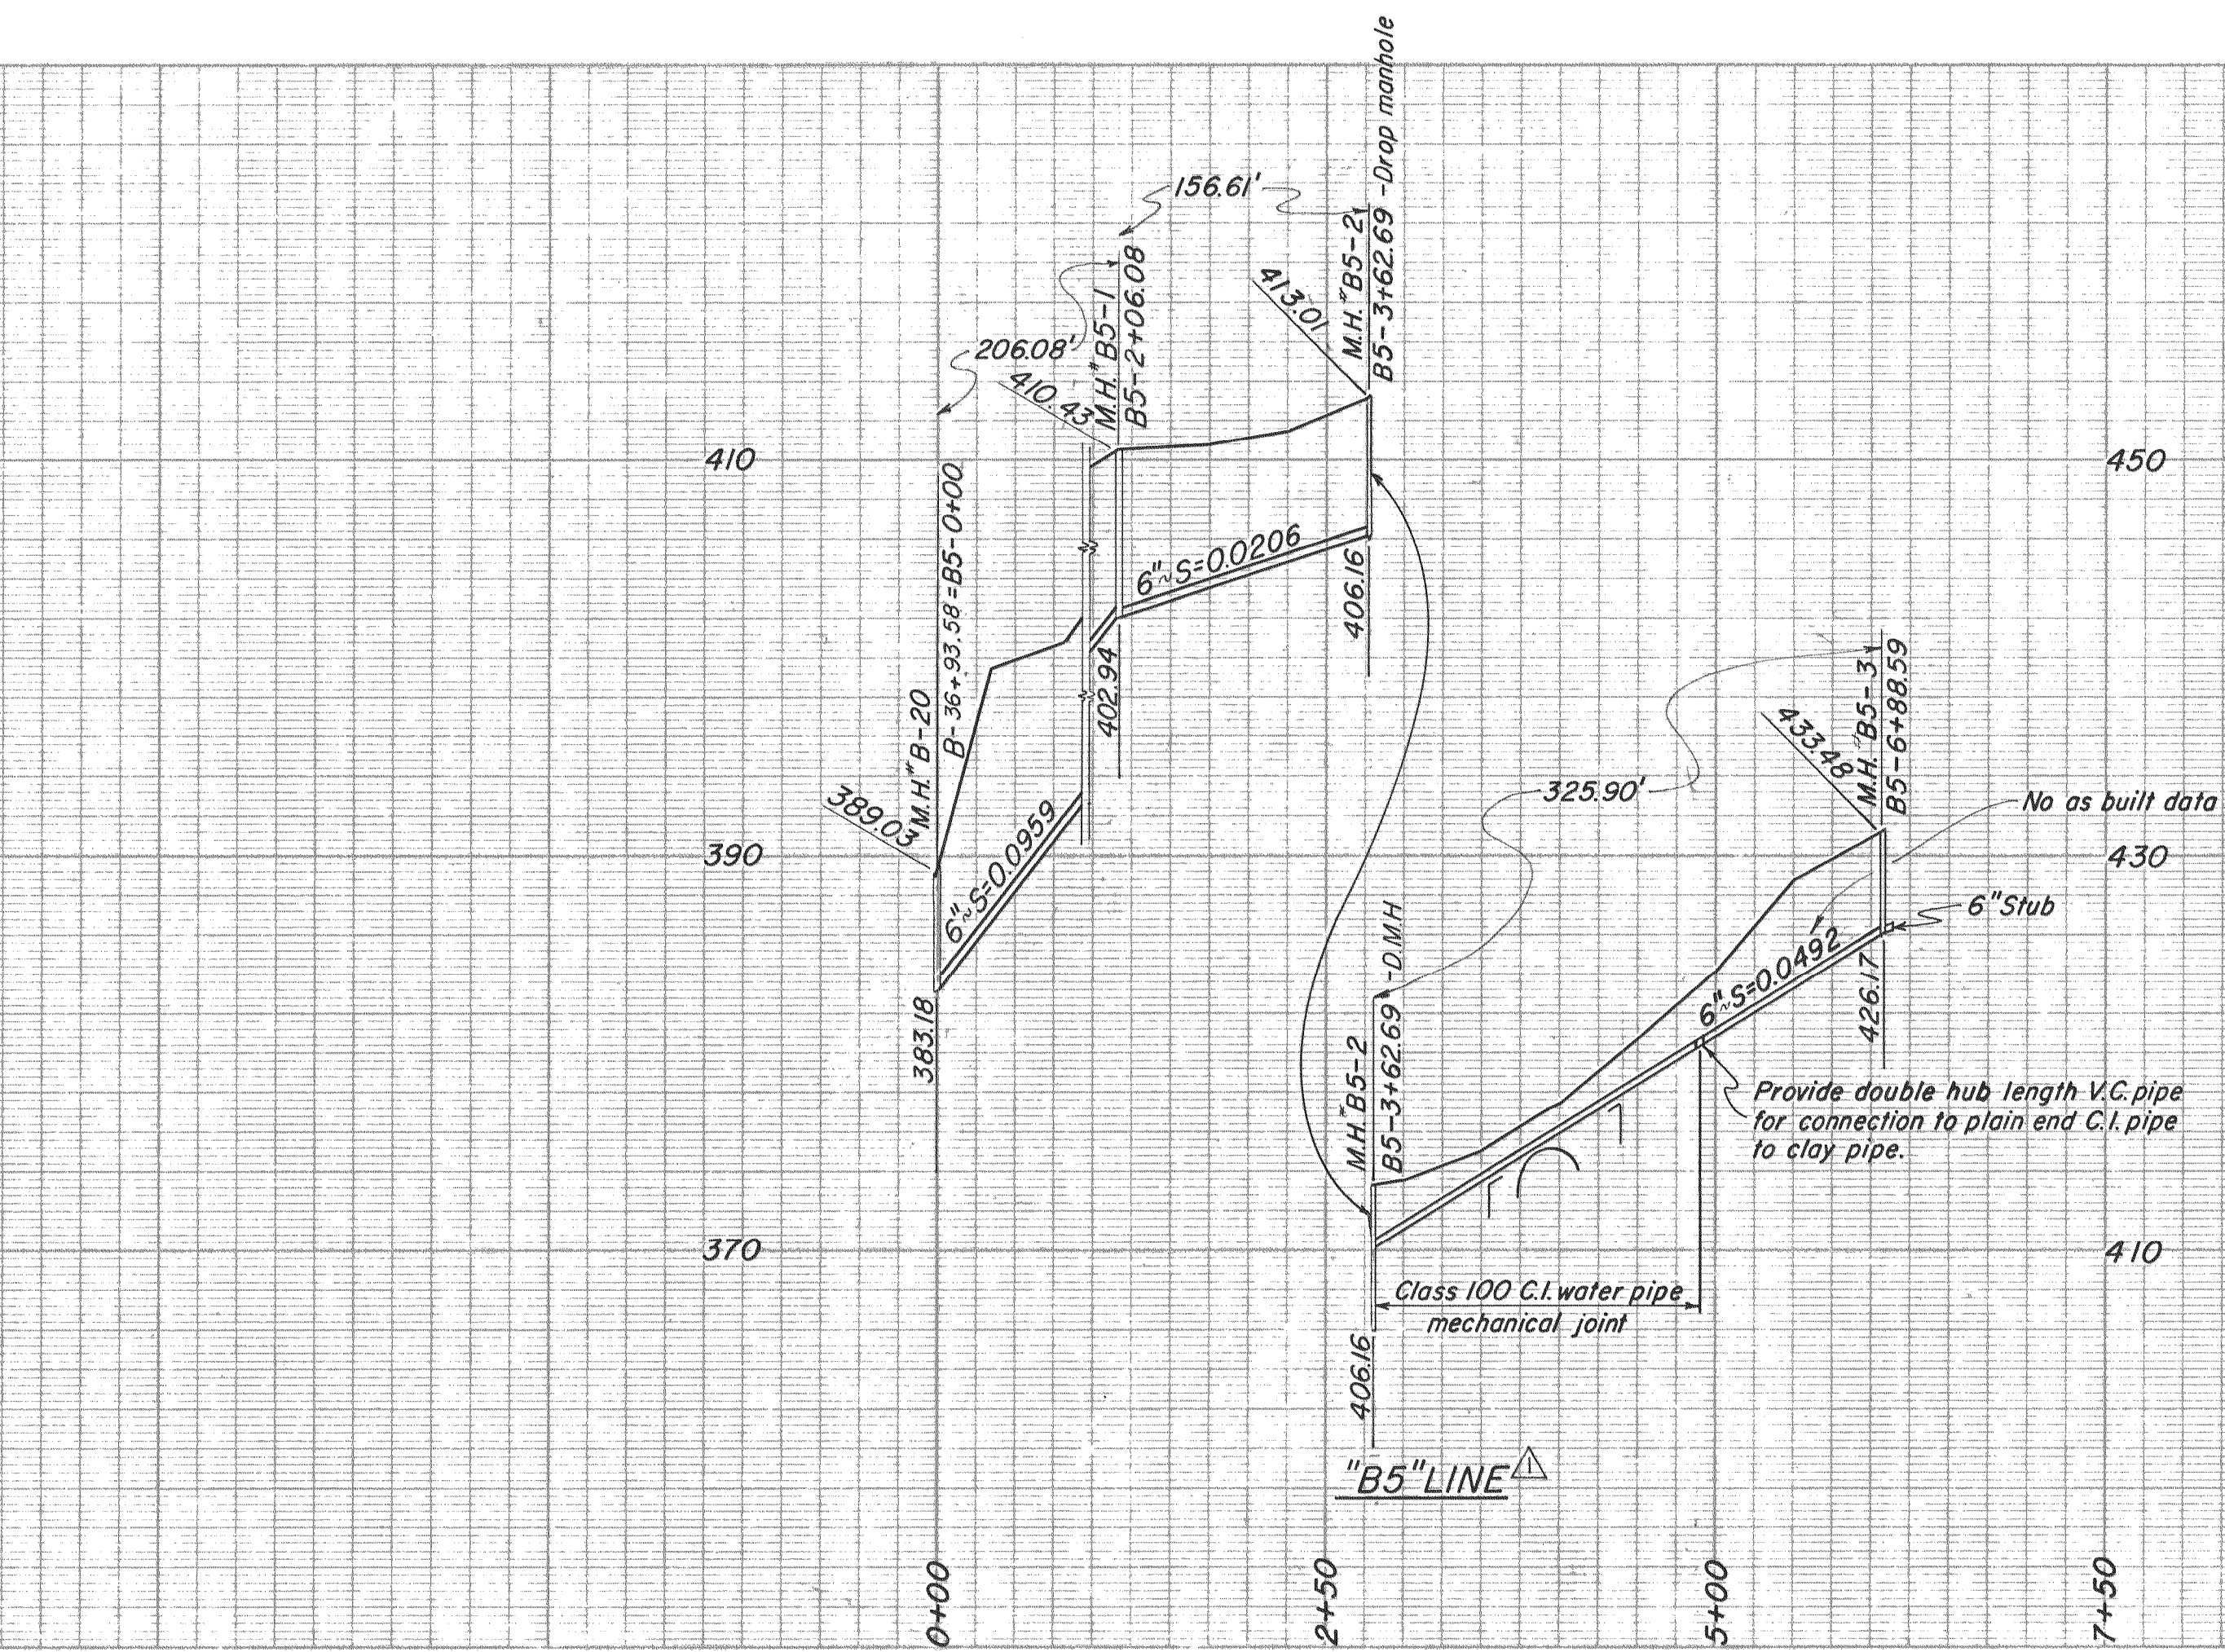

"B5" LINE $\triangle \triangle$

AS BUILT		
33062	Added Laterals	BAB
AB 11359	Revised entire "E1" & "B5" lines	LRK
REV. DATE	DESCRIPTION	BY APP.
FEATHER PORTALS ASSESSMENT DISTRICT OROVILLE, CALIFORNIA		
SANITARY SEWER SYSTEM PLAN & PROFILE "E1" & "B5" LINES		
SANITARY AND CIVIL ENGINEERS - SACRAMENTO, CALIFORNIA		
DRAWN: L.R.K.	SUBMITTED: <i>Edwin R. Stappell</i>	SHEET NO. 10
CHECKED: N.E.W.	APPROVED: <i>R. J. Carpenter</i>	OF 11
DATE: March '59		