
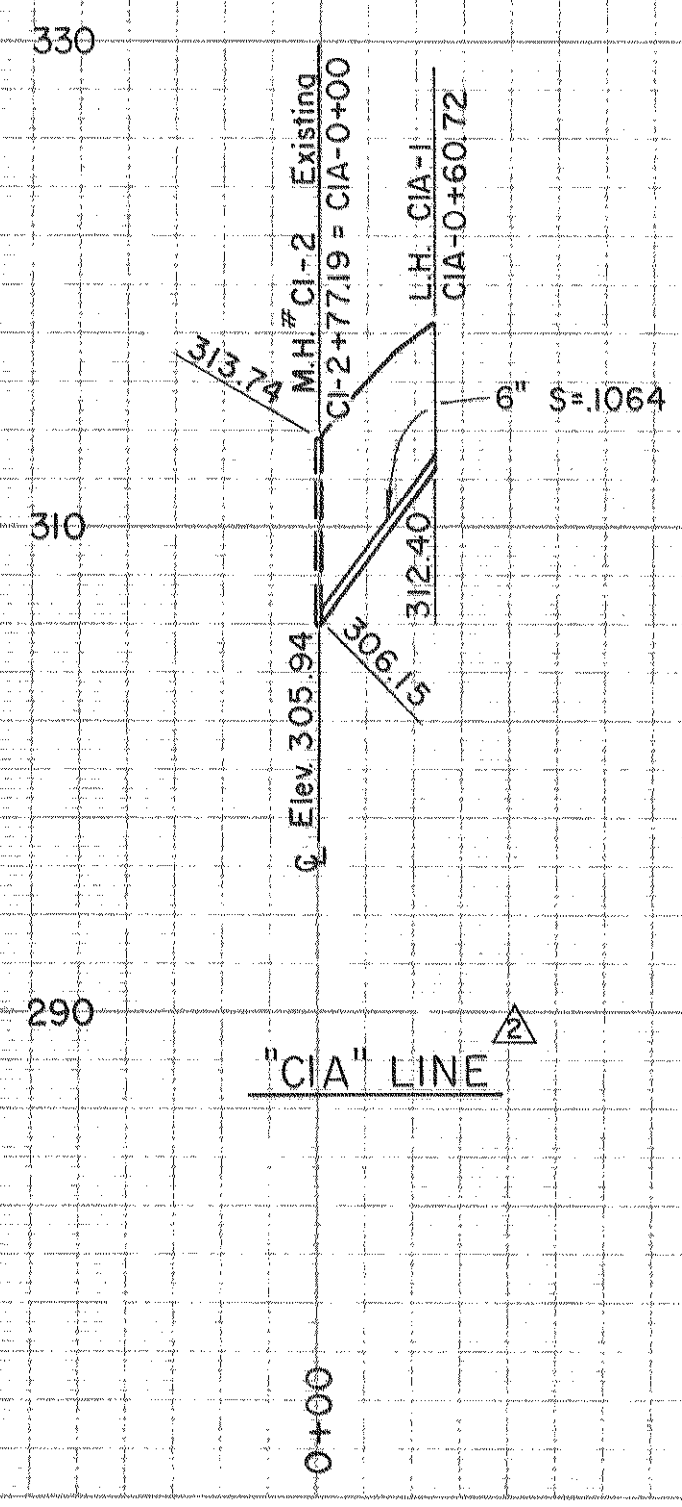


Scales:  
 Horizontal: 1"=100'  
 Vertical: 1"=8'

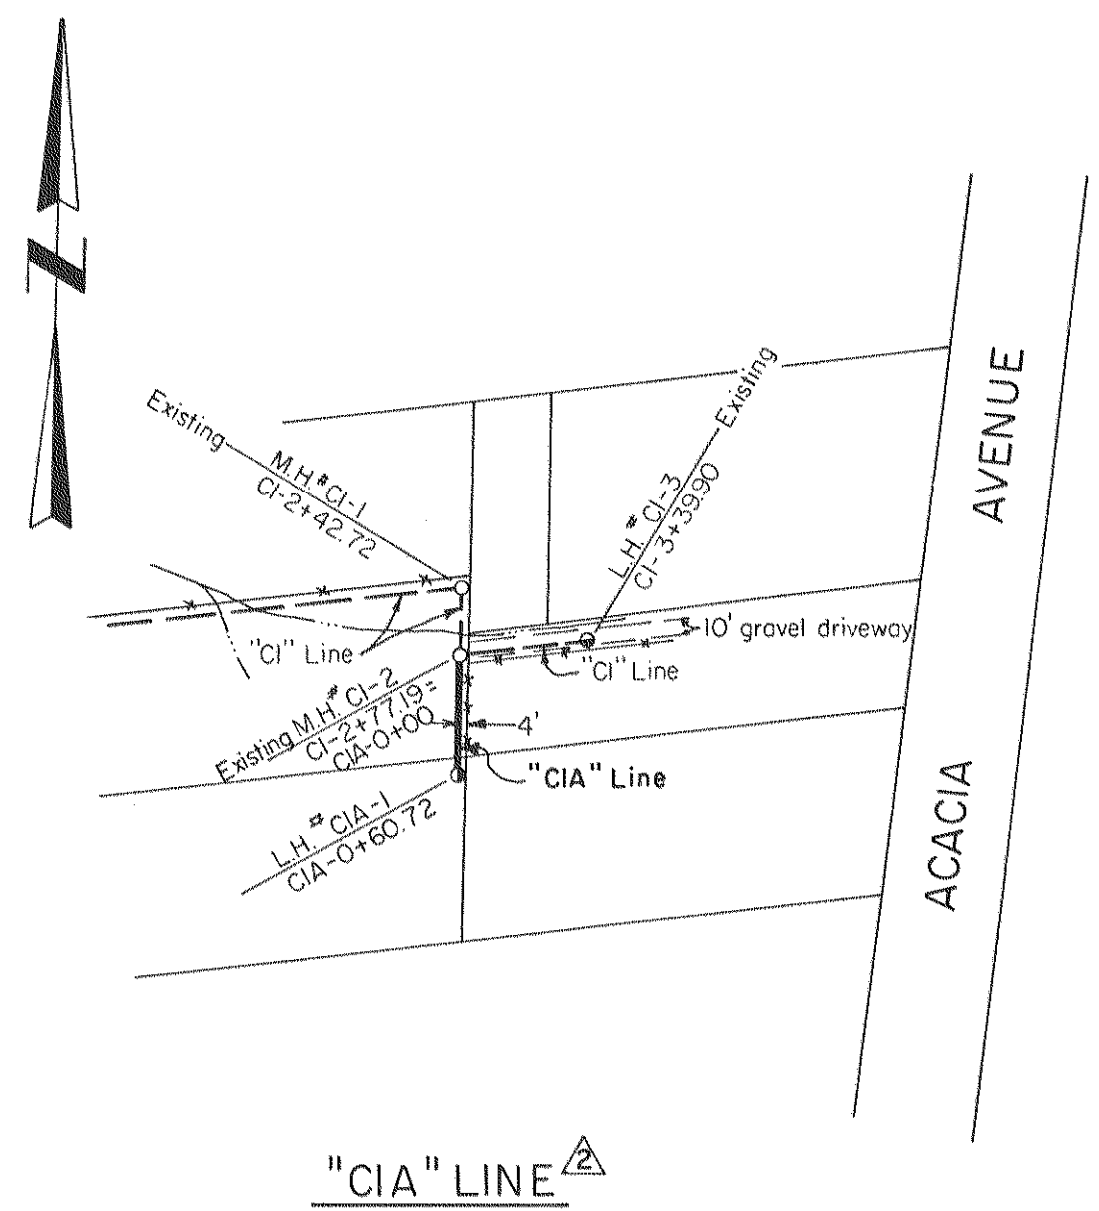

AS BUILT

REV.	DATE	DESCRIPTION	BY	APP.
12-59		Added "CIA" line, NOT BUILT	L.R.K.	
AB 11/3/59		Revised entire "D3A" & "D4A" lines	L.R.K.	

FEATHER PORTALS ASSESSMENT DISTRICT  
 OROVILLE, CALIFORNIA

SANITARY SEWER SYSTEM  
 PLAN & PROFILE  
 "D3A", "D4A" & "CIA" LINES

DEWANTE AND STOWELL  
 SANITARY AND CIVIL ENGINEERS - SACRAMENTO, CALIFORNIA

DRAWN: L.R.K.	SUBMITTED:	SHEET NO.
CHECKED: E.R.S.	APPROVED:	1
DATE: April 1959		OF 1