


DELETE PUMP STATION, FORCE MAIN, 6" GRAVITY LINE 67+85 TO 70+60, M.H.'S 22-24 & CLEANOUTS.

Scales:
 Horizontal: 1"=100'
 Vertical: 1"=4' & 1"=8'

AS BUILT			
REVISION	DATE	DESCRIPTION	BY APPD
Δ AB	5-10-61	Changed elevations & angles.	RAB RHD
CITY OF OROVILLE BUTTE COUNTY, CALIFORNIA COUNTY HOSPITAL SEWERAGE FACILITIES PLAN & PROFILE SEWER LINE			
DEWANTE AND STOWELL SANITARY AND CIVIL ENGINEERS - SACRAMENTO, CALIFORNIA			
DRAWN: L.R.K.	CHECKED: J.P.E.	DATE: March 1960	SUBMITTED: <i>R.H. Dewante</i> APPROVED: <i>J.P. E.</i> SHEET NO. 5 OF 8

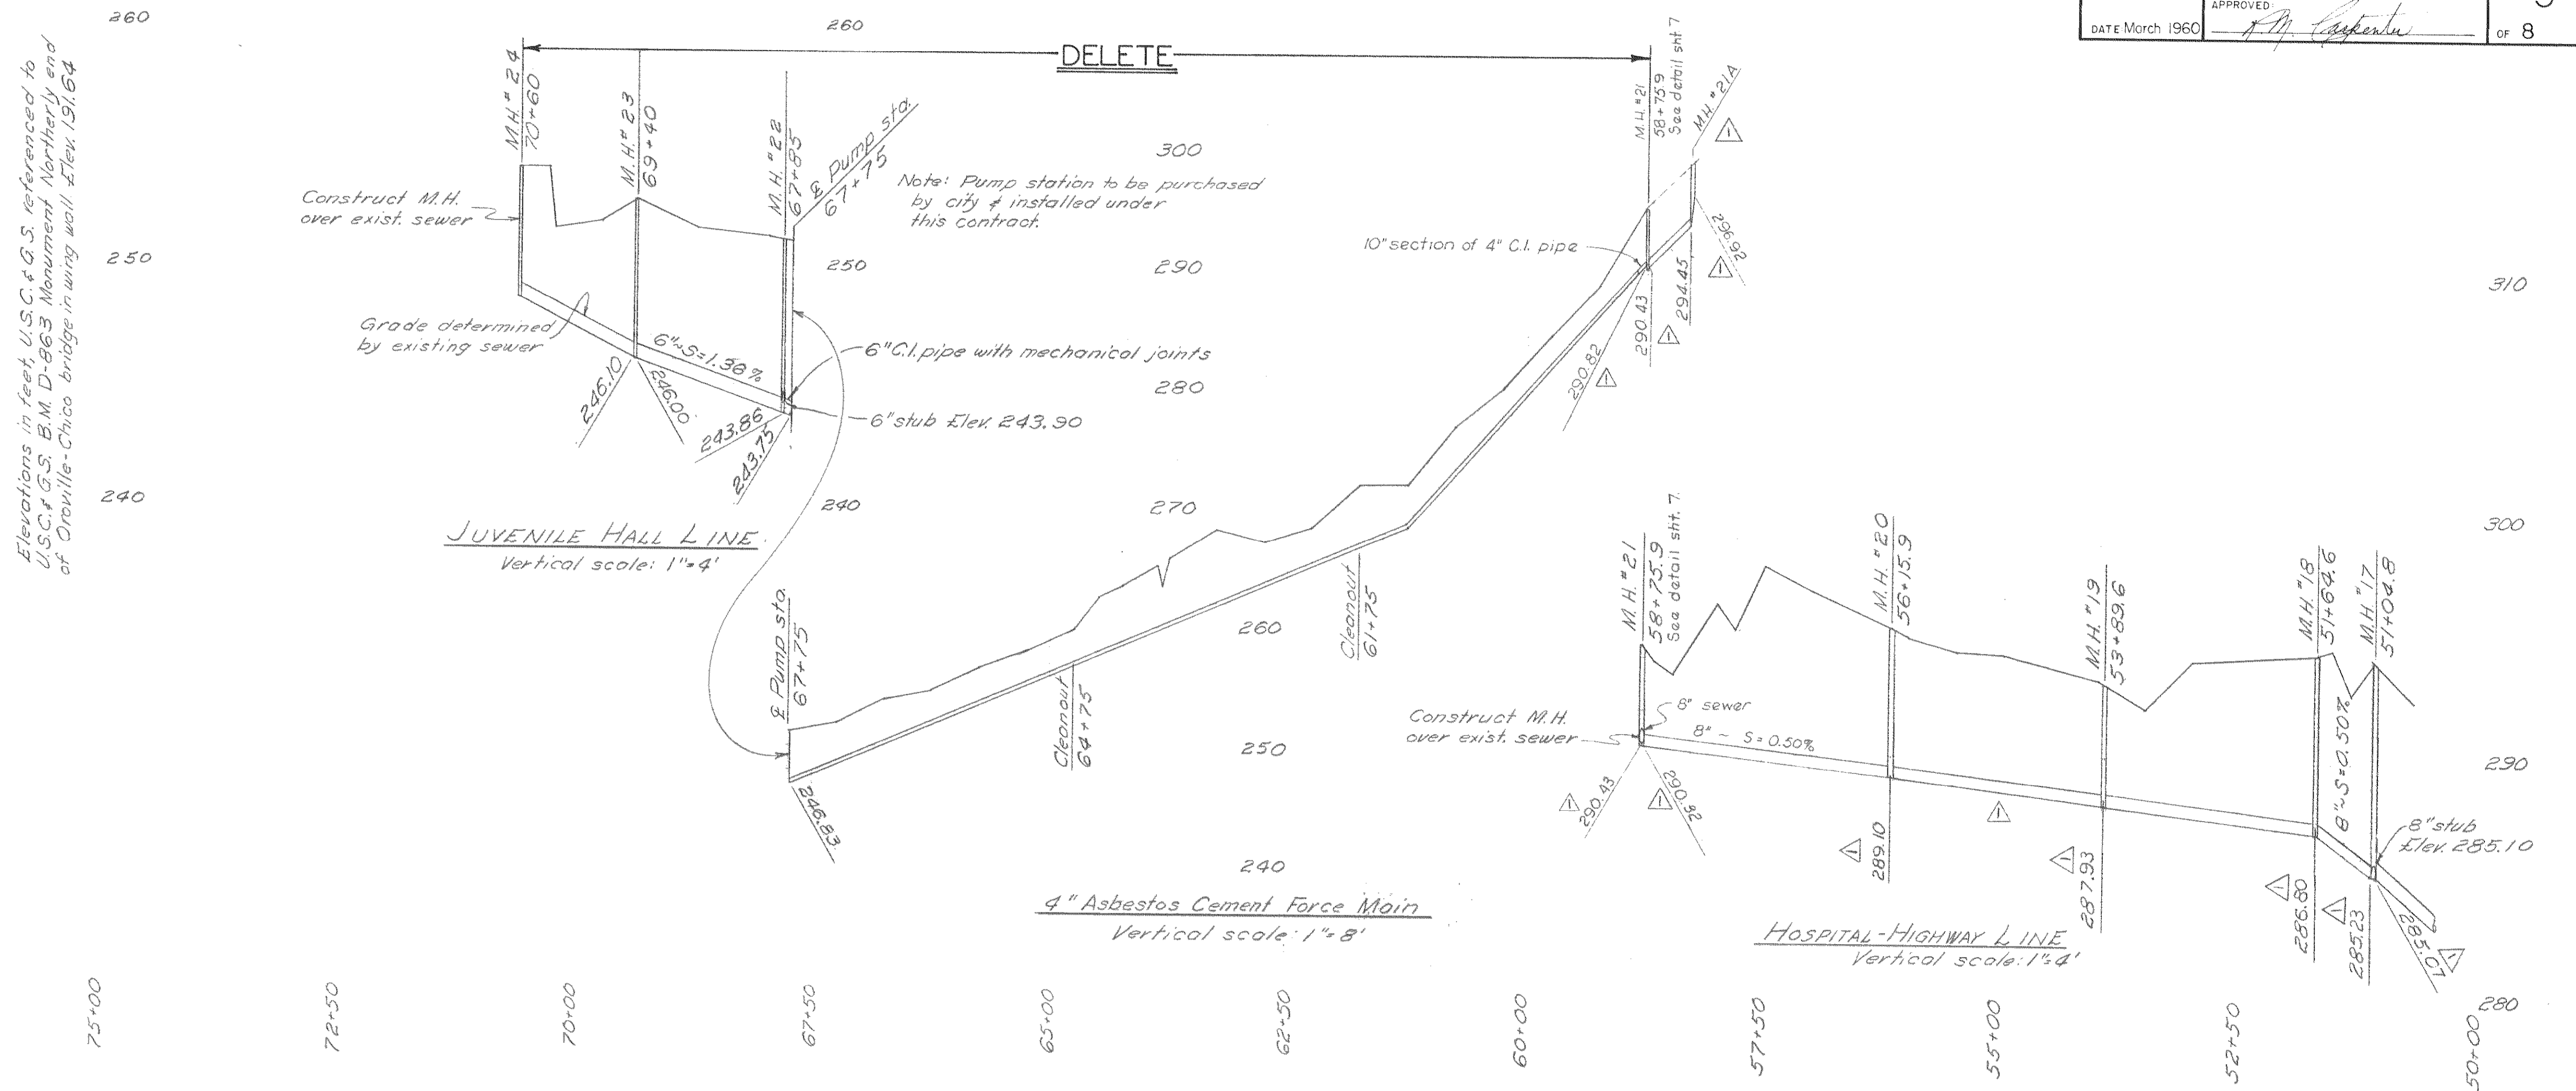

78+00
77+50
75+00
72+50
70+00
67+50
65+00
62+50
60+00
57+50
55+00
52+50
50+00