


MONTGOMERY STREET LINE
 Scales:
 Horizontal: 1"=50'
 Vertical: 1"=4'



AS BUILT

REVISION	DATE	DESCRIPTION	BY	APPD
△ A.B.	5-10-61	Changed elevation.	R.A.B.	R.H.D.
CITY OF OROVILLE BUTTE COUNTY, CALIFORNIA COUNTY HOSPITAL SEWERAGE FACILITIES PLAN & PROFILE SEWER LINE				
DEWANTE AND STOWELL SANITARY AND CIVIL ENGINEERS - SACRAMENTO, CALIFORNIA				
DRAWN: L.R.K.	CHECKED: H.J.M.	SUBMITTED: <i>R. DeWante</i>	APPROVED: <i>A.M. Carpenter</i>	SHEET NO. 2
DATE: March 1960				OF 8

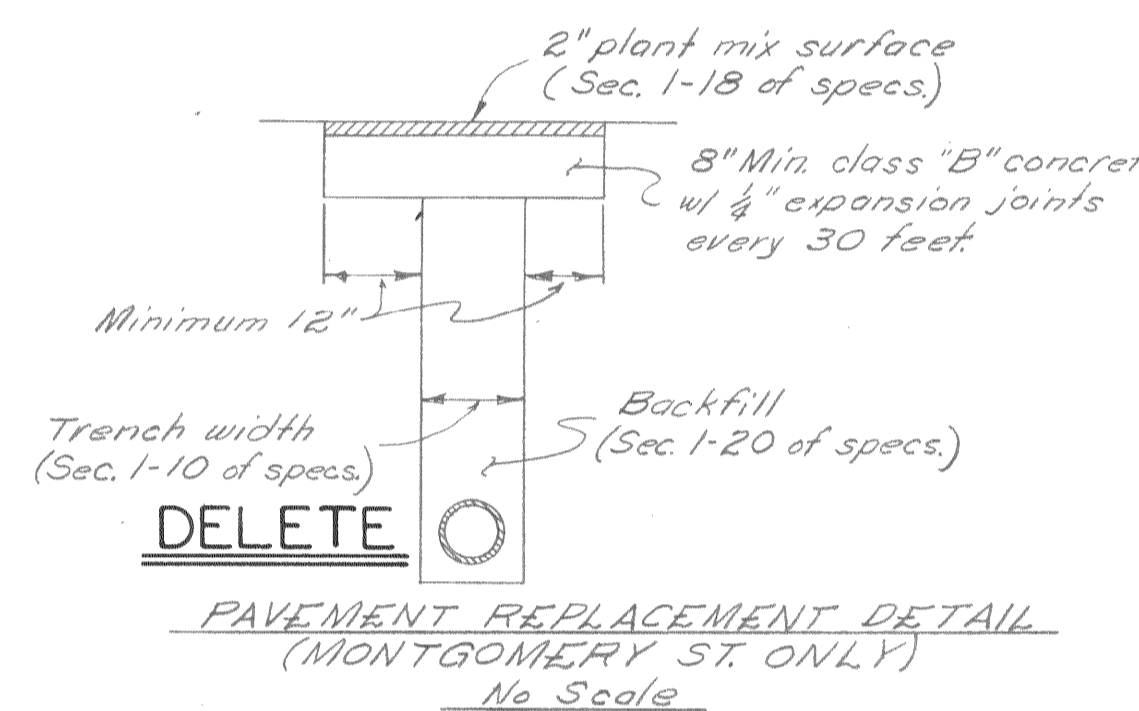