
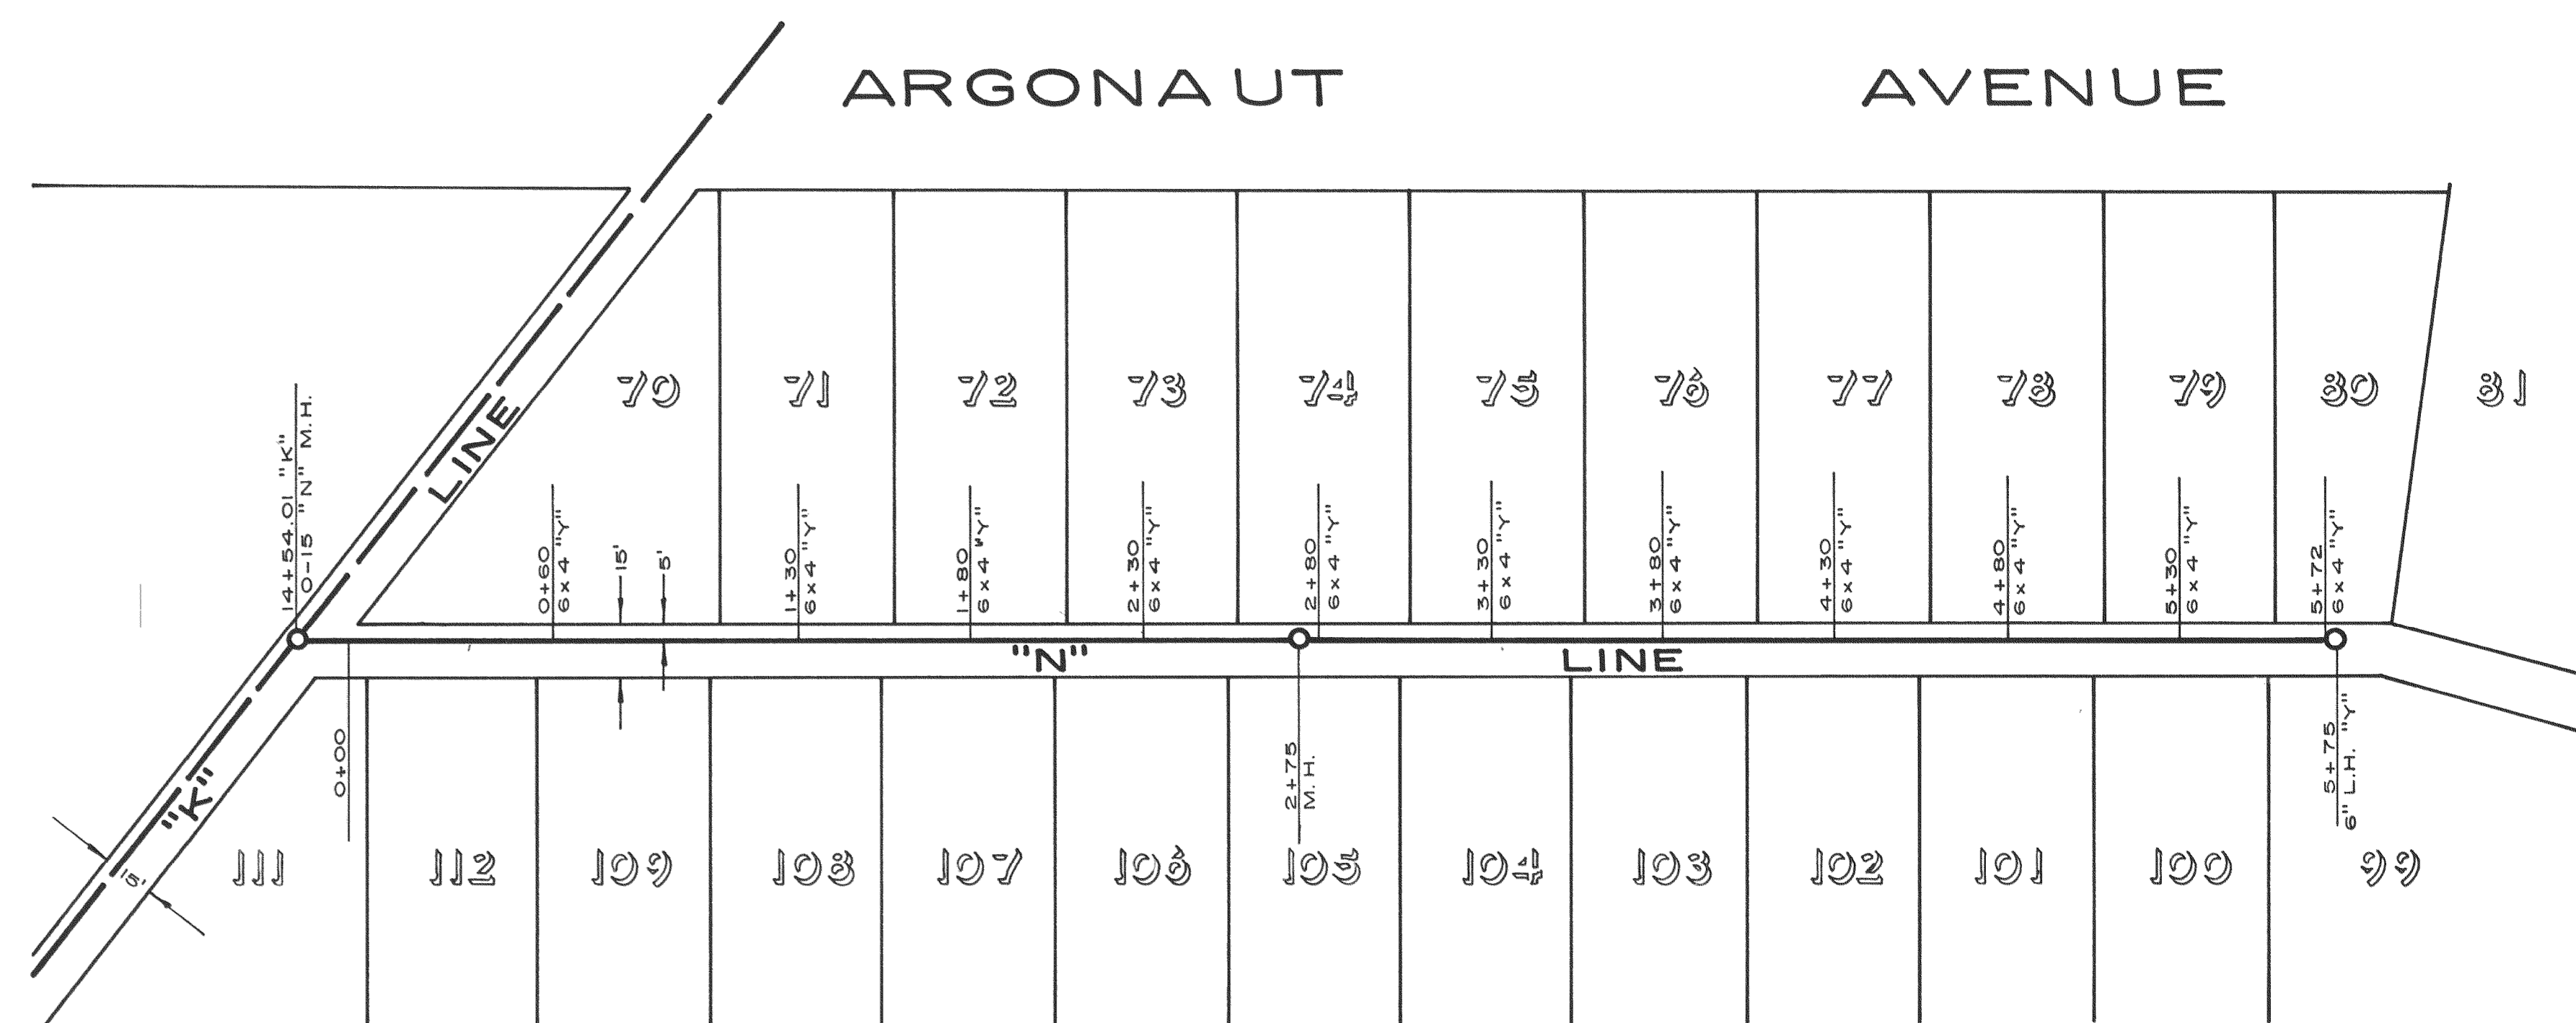


SCALE: 1" = 40' - HORIZ.
 1" = 4' - VERT.

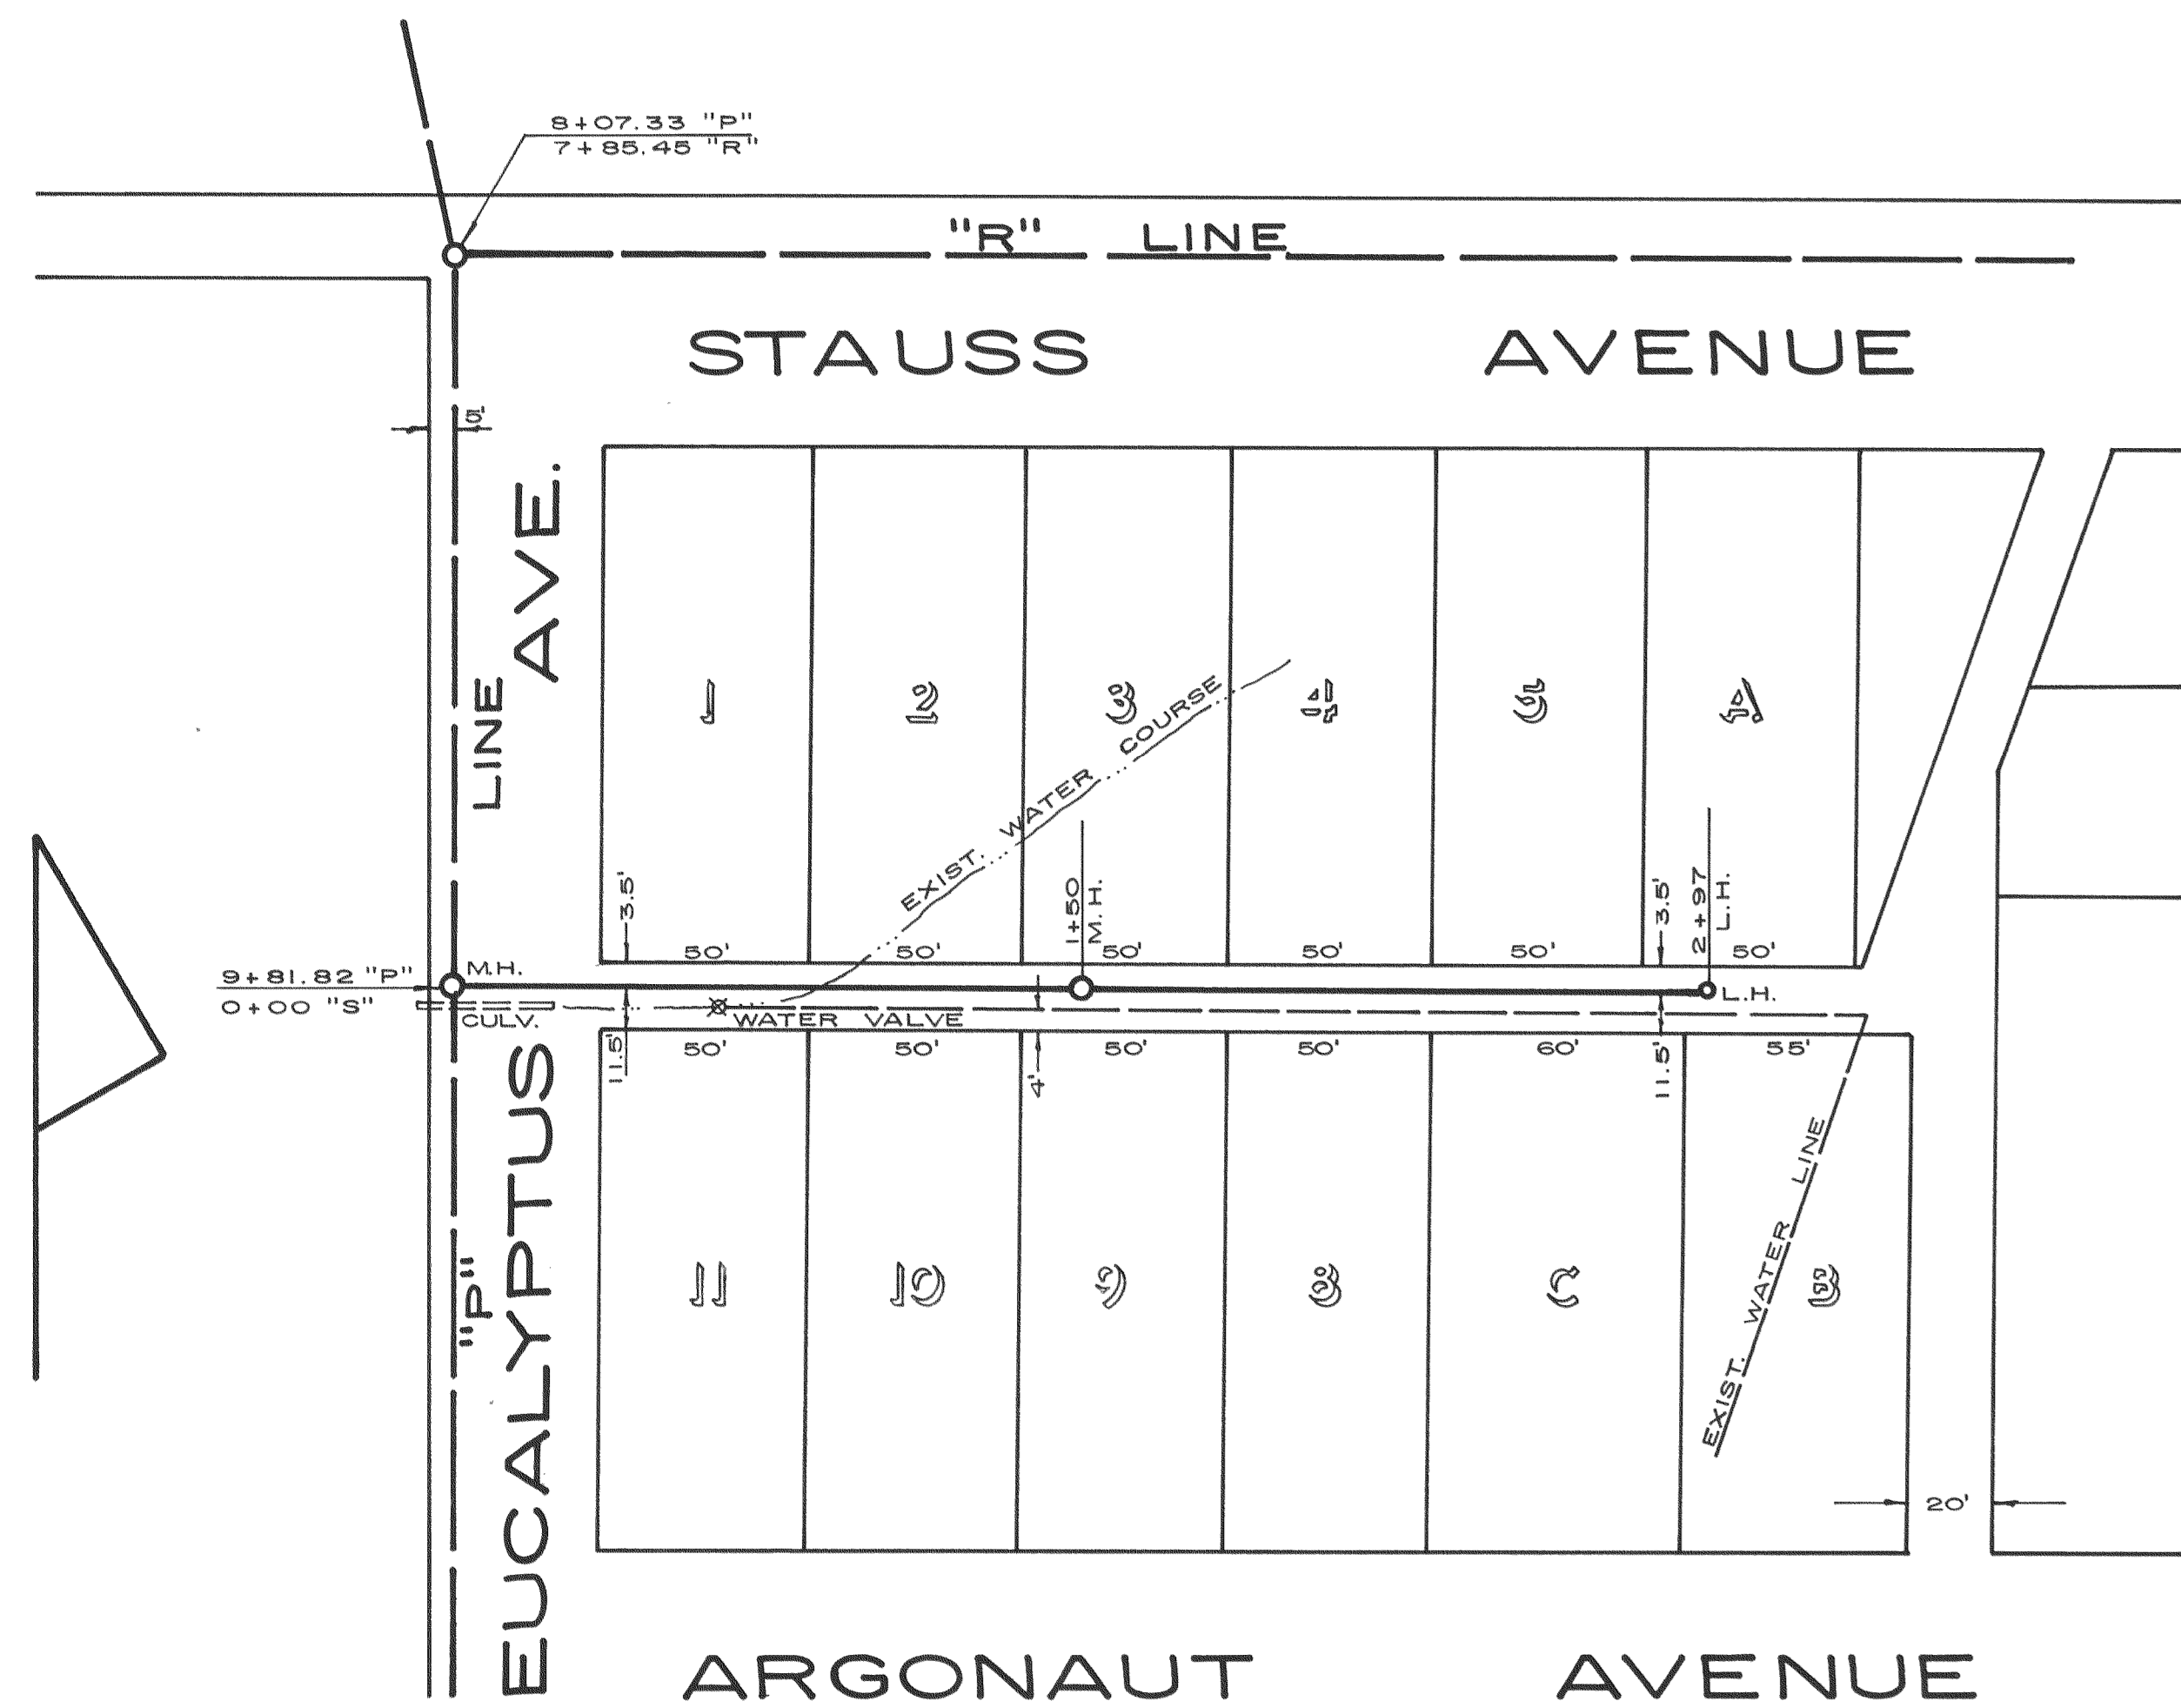

REDRAWN ON LINEN - 1/20/89 - N.A.W.
"S" LINE & "N" LINE
 GRAND VIEW SUBDIVISION
CITY OF OROVILLE
 SANITARY SEWER
 in ALLEY between STAUSS
 & ARGONAUT EAST EUCALYPTUS
 & EAST of CAMPBELL