
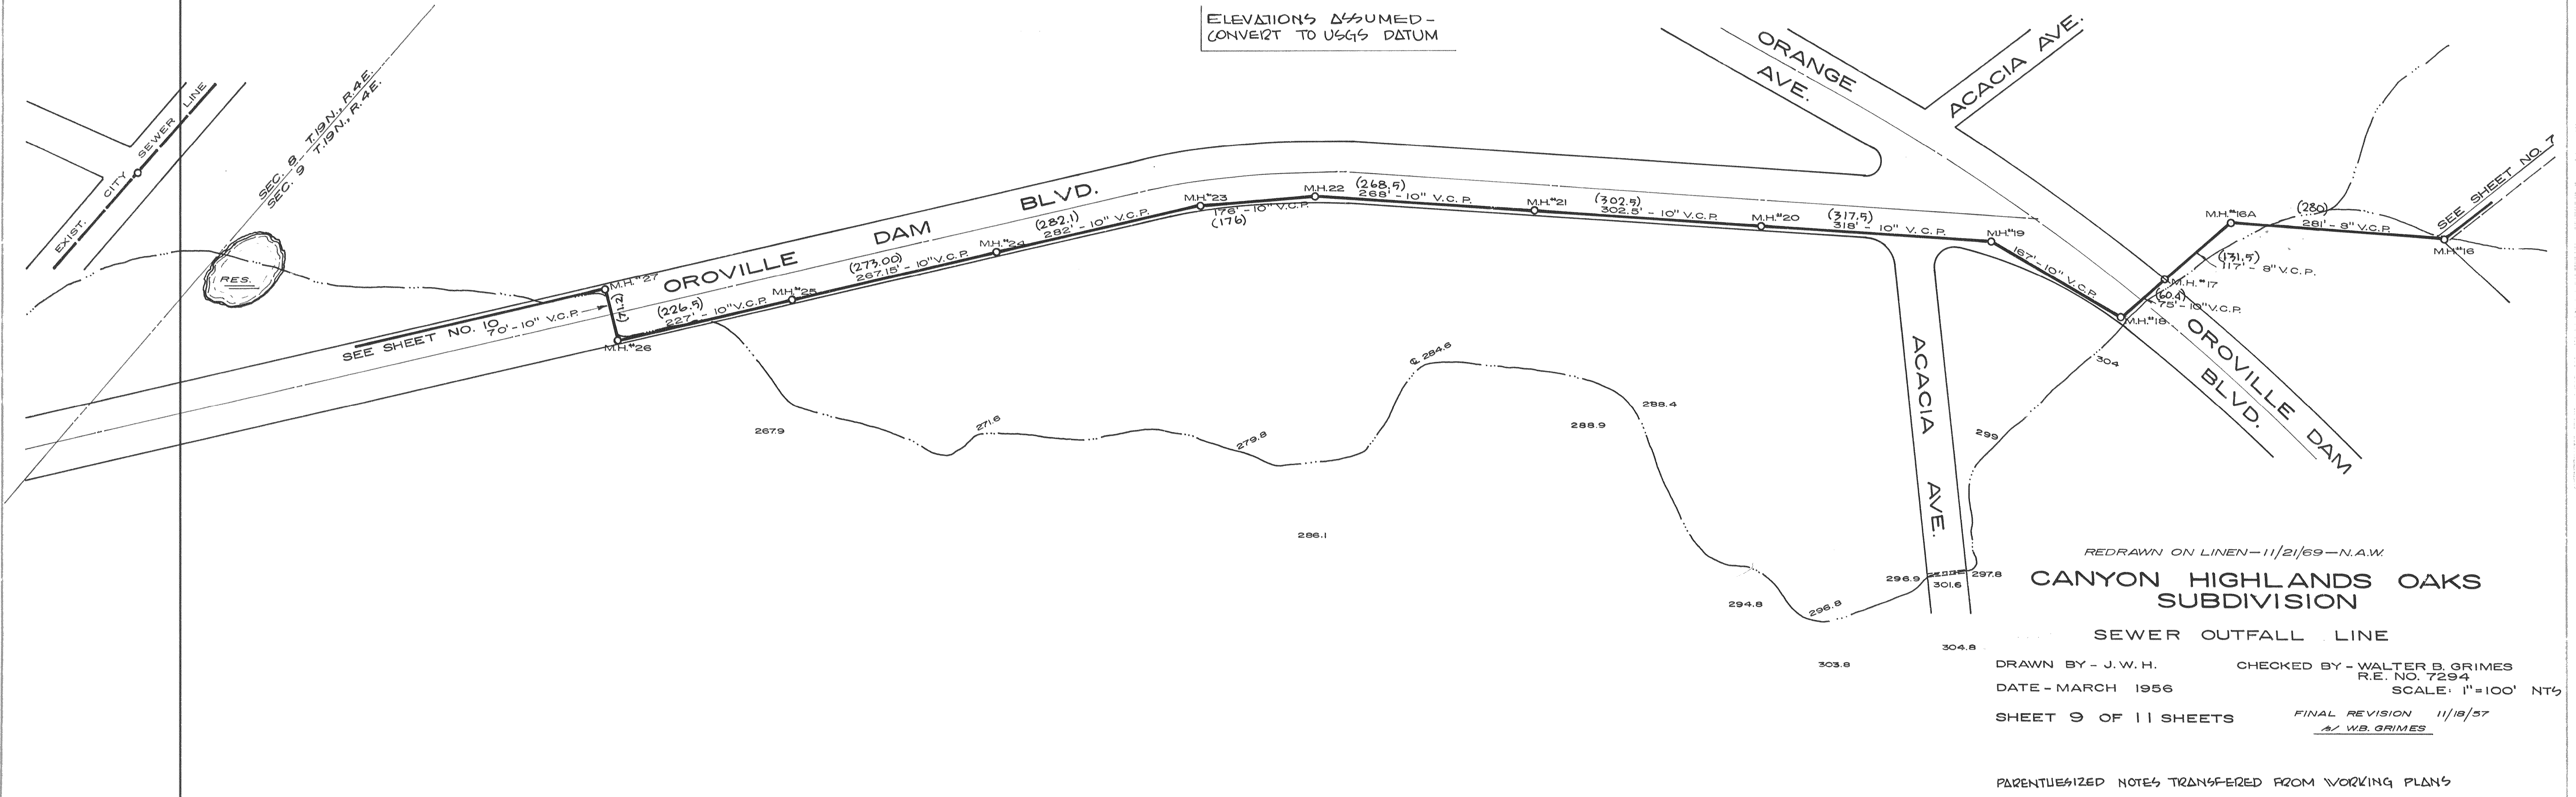


PROFILE	SUBMITTED	DATE
NOTE BOOK	DESIGNED	
R.M. NO. 1170	CHECKED	
SECTIONAL MATERIAL	APPROVED	

PLAN	SUBMITTED	DATE
NOTE BOOK	DESIGNED	
R.M. NO. 1170	CHECKED	
R.E. NO. 7294	APPROVED	

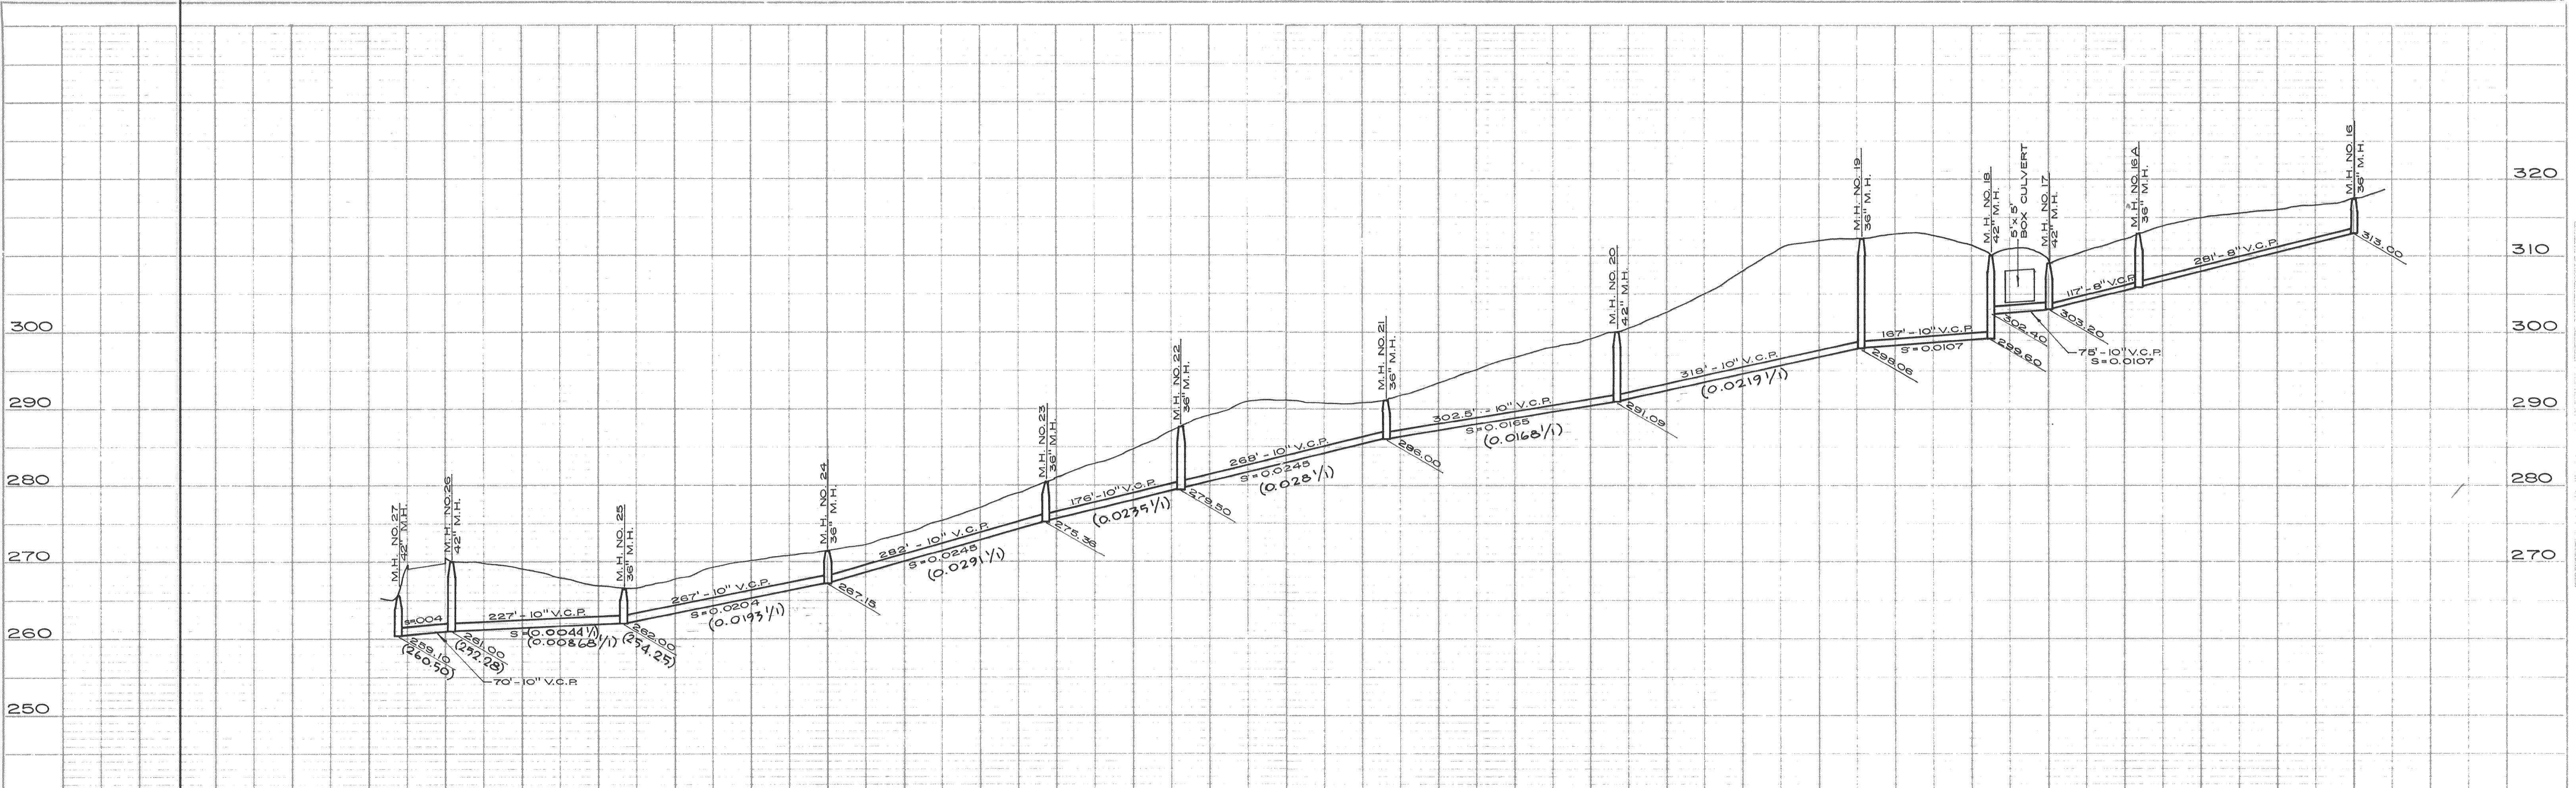

REDRAWN ON LINEN - 11/21/69 - N.A.W.
CANYON HIGHLANDS OAKS SUBDIVISION
SEWER OUTFALL LINE
 DRAWN BY - J. W. H. CHECKED BY - WALTER B. GRIMES
 DATE - MARCH 1956 R.E. NO. 7294
 SCALE: 1"=100' NT'S
 SHEET 9 OF 11 SHEETS FINAL REVISION 11/18/57
 A/ W.B. GRIMES

PARENTHEZIZED NOTES TRANSFERRED FROM WORKING PLANS