


Scale:
 1" = 50' - Horiz.
 1" = 5' - Vert.

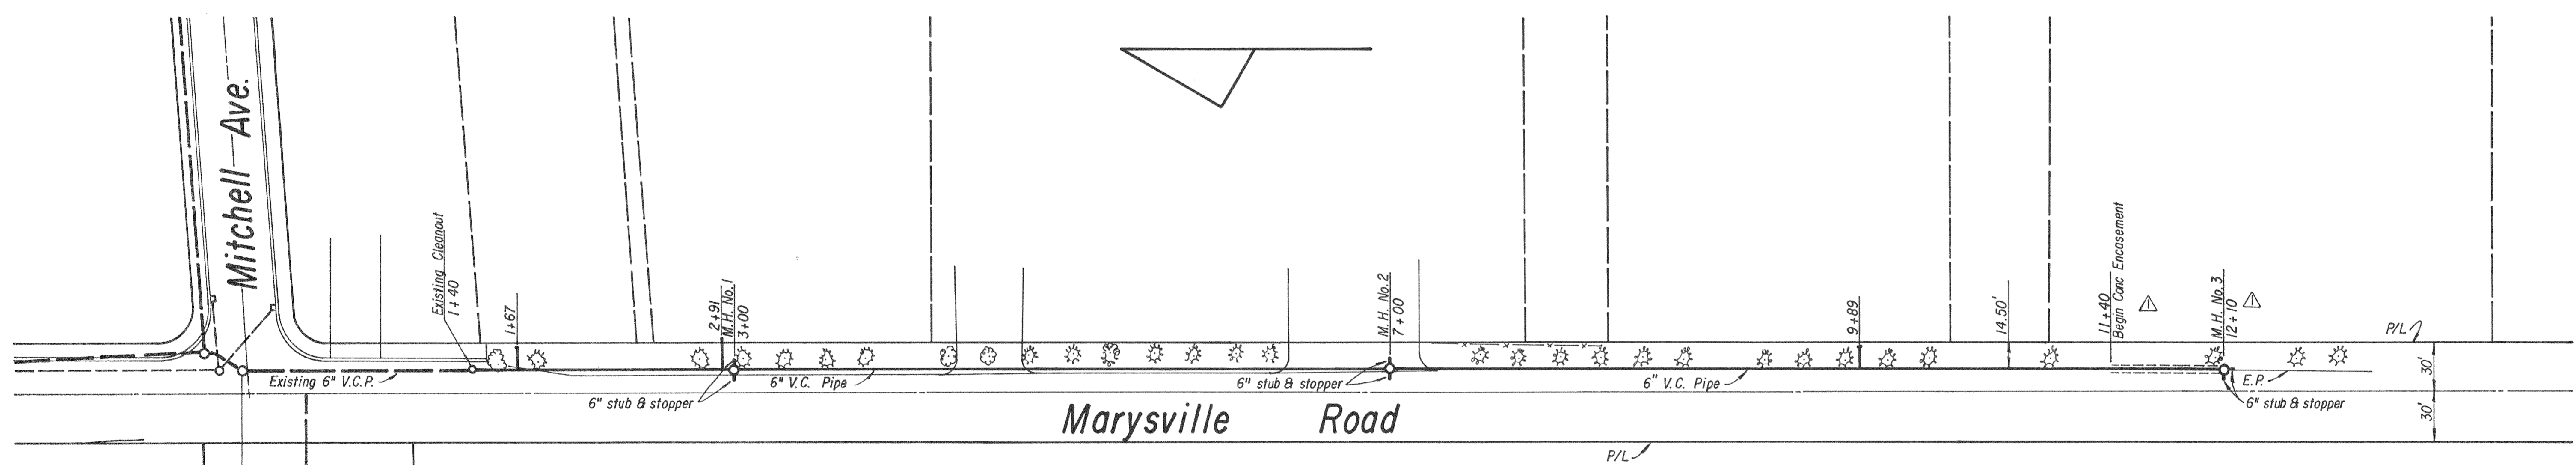

Tentative study 7-10-67 shows property could be sewerd to a point 500 feet West of existing 6" main in Feather River Blvd. (at 0.005V).

Redrawn on linen - 5/5/70 - N.A.B.

△	3JUN64	"AS BUILT"		
REV	DATE	DESCRIPTION	APPD	BY
CITY of OROVILLE				
SEWER MAIN EXTENSIONS PROJECT FEATHER RIVER BLVD. SOUTH of MITCHELL AVENUE				
DRAWN BY	APPROVED BY -			
F.D.	/s/ EDWIN R. STOWELL			
DATED				
13 NOV 62				
PROJECT				
62-14				