


**ABBREVIATIONS**

ACP	Asbestos Cement Pipe
EL	Elevation
SDMH	Storm Drain Man Hole
M	Minimum
Mx	Maximum

**AS BUILT**  
DATE: APR 17 1963  
PROJECT ENGINEER: [Signature]

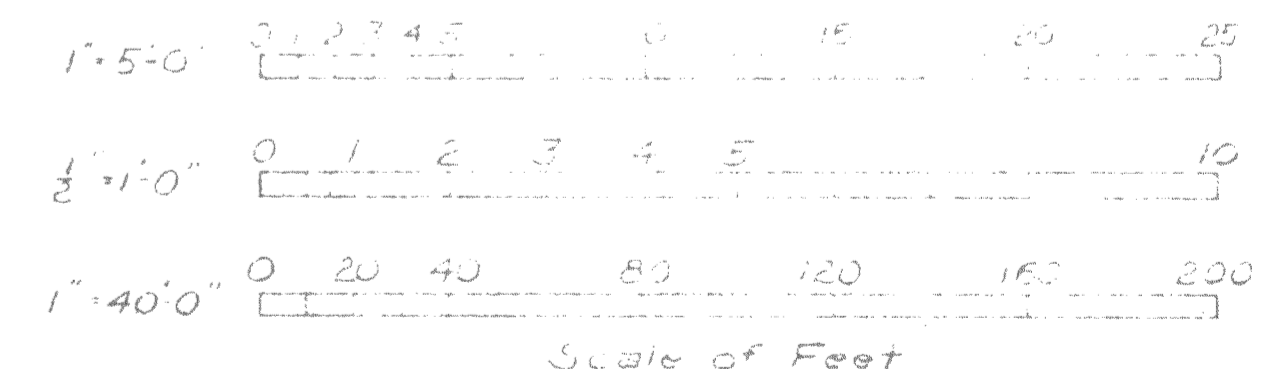

**SAFETY - as Necessary as WATER**

STATE OF CALIFORNIA  
THE RESOURCES AGENCY OF CALIFORNIA  
DEPARTMENT OF WATER RESOURCES  
DIVISION OF DESIGN AND CONSTRUCTION

STATE WATER FACILITIES  
OROVILLE DIVISION  
CONSTRUCTION HEADQUARTERS  
NEW SUB DRAIN AT SEWAGE  
LIFT STATION

Sheet 6 of 8

REVIEWED—STAFF ENGINEERING, BR.									
DESIGNED	DATE	DRAWN	DESCRIPTION	SUB.	APP'D				
NEWTON		FURVIS							
CHECKED		REVIEWED							
[Signature]		[Signature]							

SUBMITTED: [Signature]	DATE: APR 17 1963
APPROVAL RECOMMENDED: [Signature]	
DRAWING NO. A-12 G16 SS-260	