

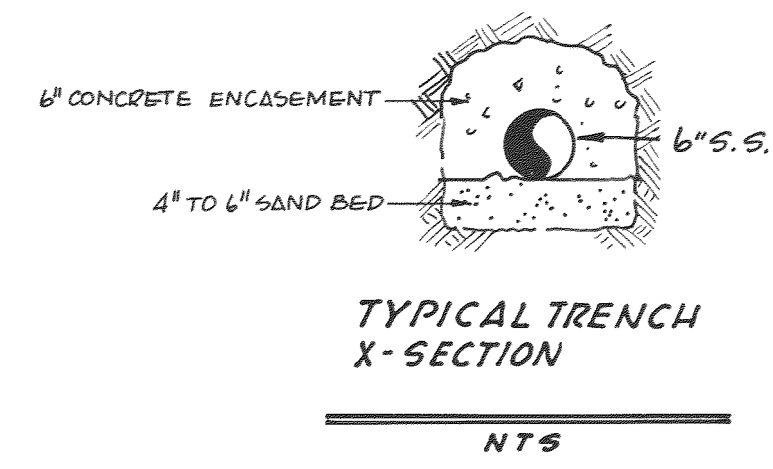


SCALE 1"=40'

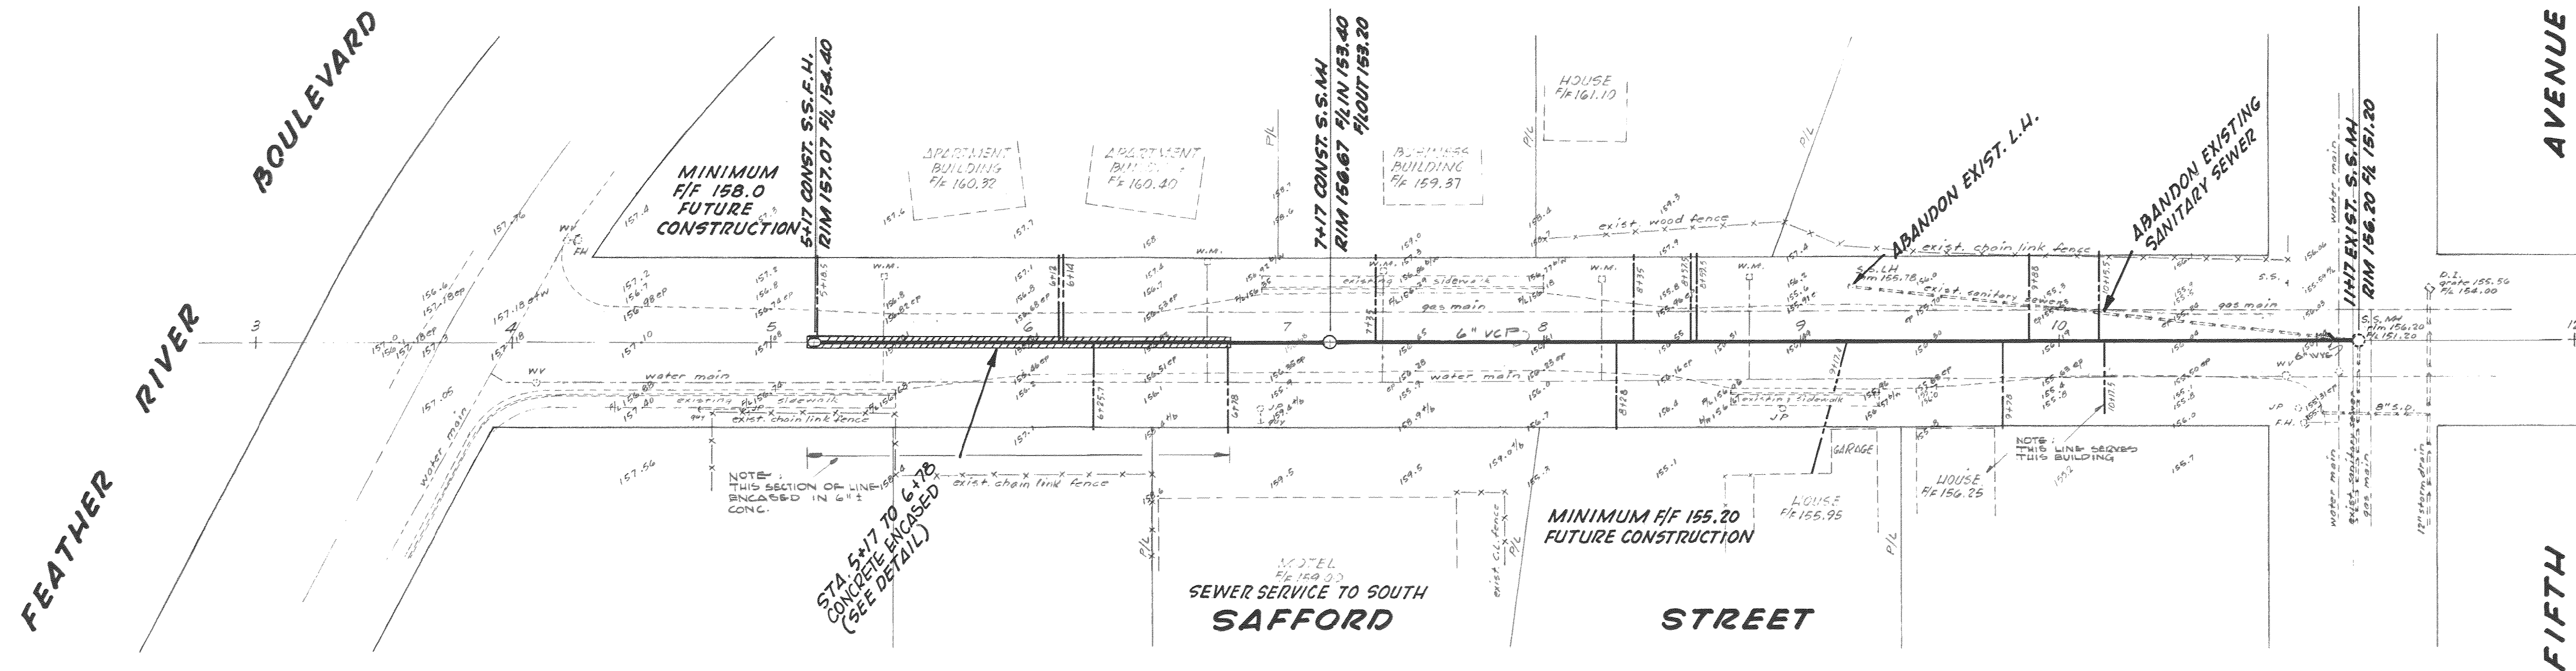

NOTE:
ALL CONSTRUCTION SHALL CONFORM TO CITY OF OROVILLE STANDARDS AND SPECIFICATIONS.

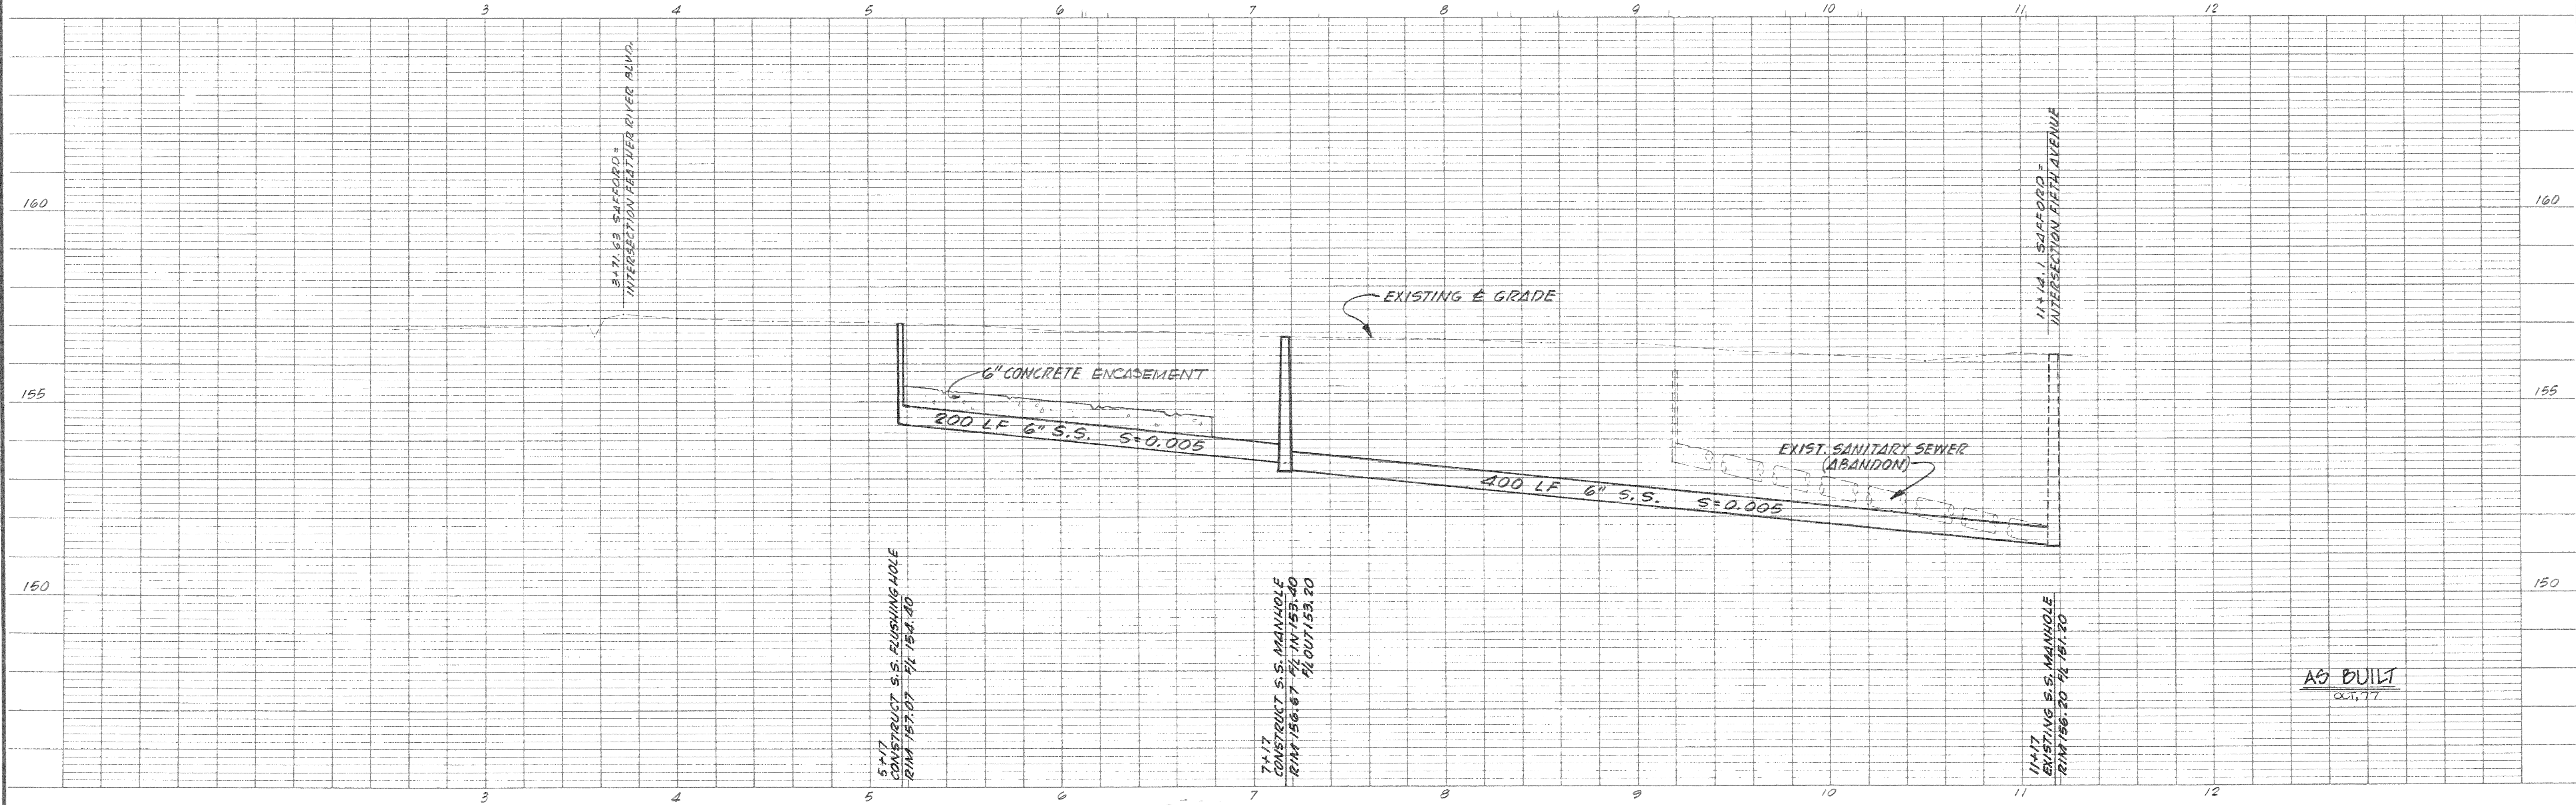

AS BUILT
02/17

DATE	NO	REVISION	BY	APP'D

FIELD BOOK
ELEVATION DATUM

DRAWN
L. ALDRICH

DESIGNED
F. D. P.

CHECKED

SCALE 1"=40'

APPROVED

DATE 8/15/77

GEDDIS
DRISCOLL
AND
ASSOCIATES

ENGINEERING
SURVEYING
PLANNING

1638 HUNTON STREET
OROVILLE, CALIF. 95965
(916) 538-2068

SANITARY SEWER IMPROVEMENTS
CITY OF OROVILLE
SAFFORD STREET WEST OF FIFTH AVENUE
AS BUILT OCTOBER 30, 1977

SHEET
1 OF **1**
SHEETS
JOB NO 77-192

SS-279-1-1