


AS BUILT DATA

AS BUILT DATA

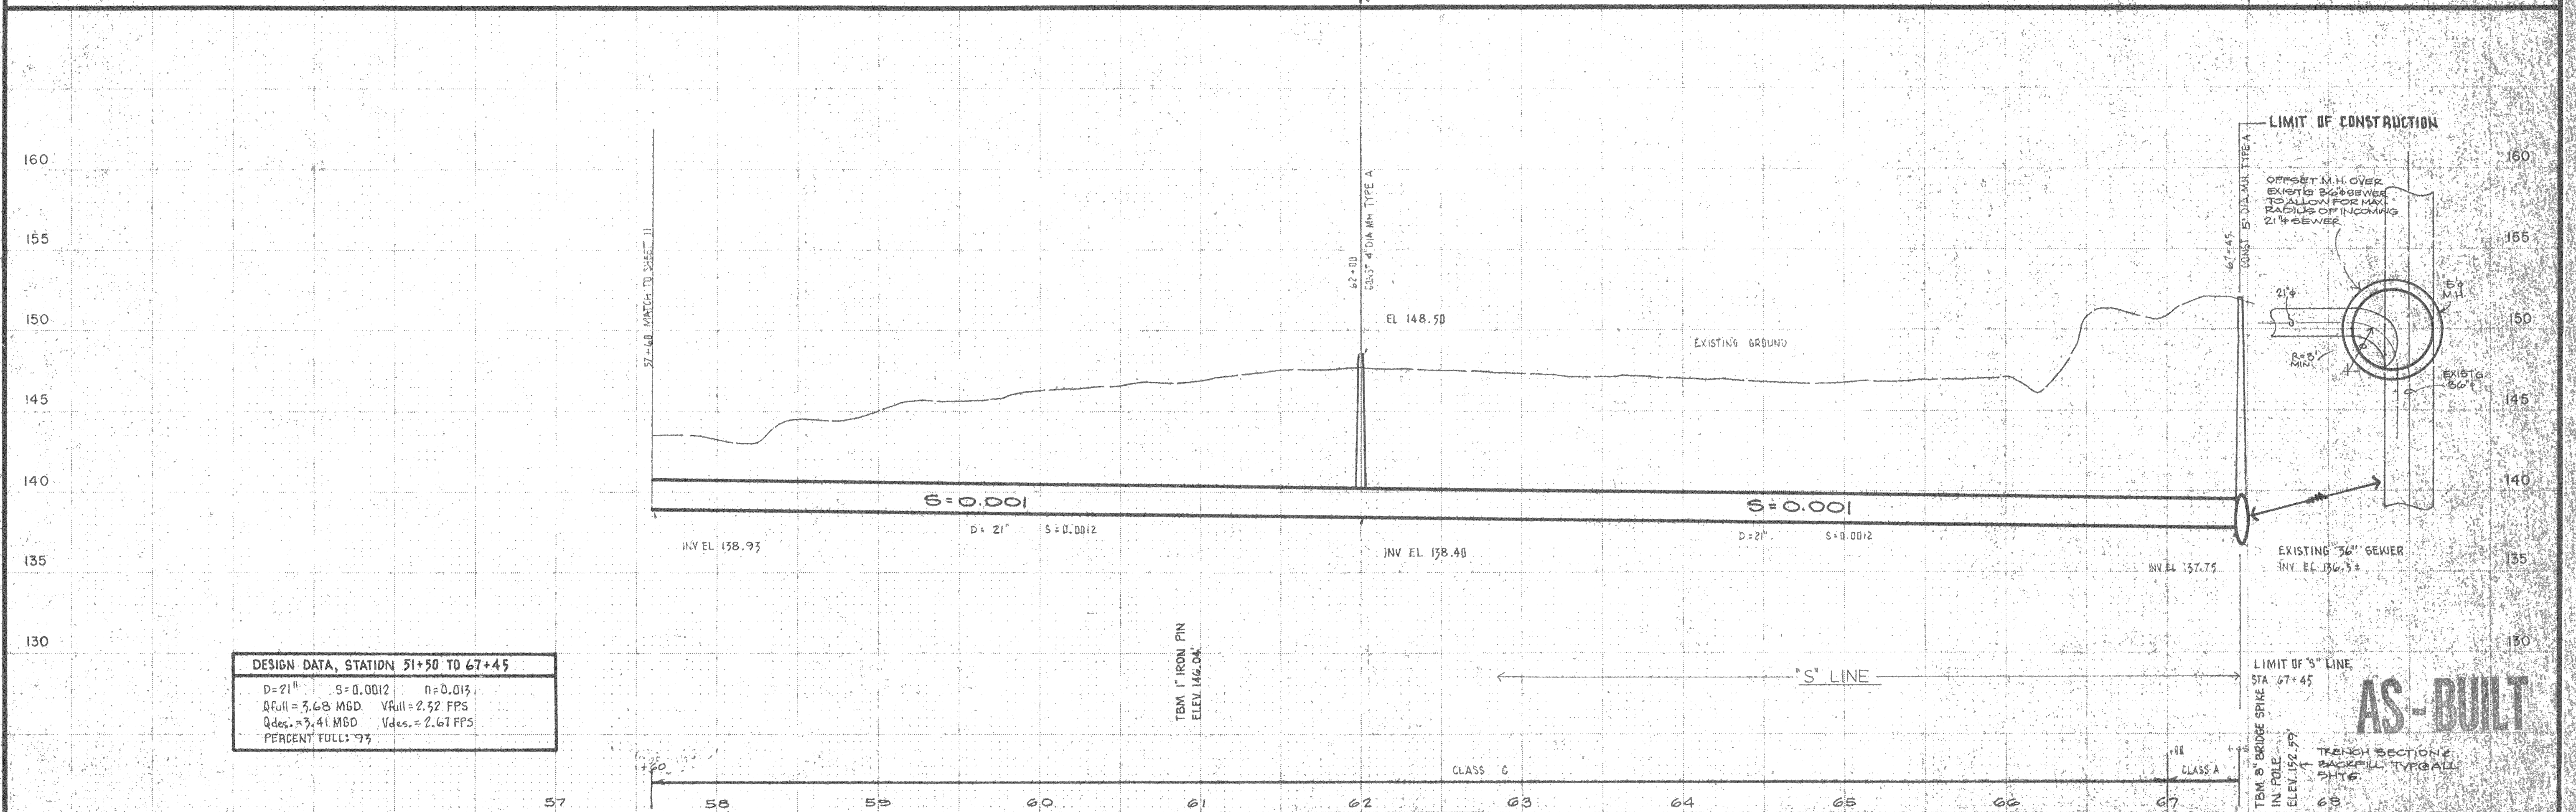

DESIGN DATA, STATION 51+50 TO 67+45
 D=21" S=0.0012 n=0.015
 Q_{full} = 3.68 MGD V_{full} = 2.52 FPS
 Q_{des} = 3.41 MGD V_{des} = 2.67 FPS
 PERCENT FULL: 93

AS-BUILT

RINGEL & ASSOCIATES, INC

DES. EAR				
DR. W.K.J., 6B				
CHK. G.B., W.K.J.				
APPD. <i>[Signature]</i>	NO.	DATE	REVISION	BY

"S" LINE

SEWERAGE COMMISSION,
 OROVILLE REGION
 OROVILLE, CALIFORNIA

PLAN AND PROFILE
SC-OR WEST INTERCEPTOR

SHEET 12 OF 20
 DATE AUG 11 1974
 PROJ. NO. 2316