



THE EXISTENCE AND LOCATION OF ALL UTILITIES SHALL BE VERIFIED BY THE CONTRACTOR.

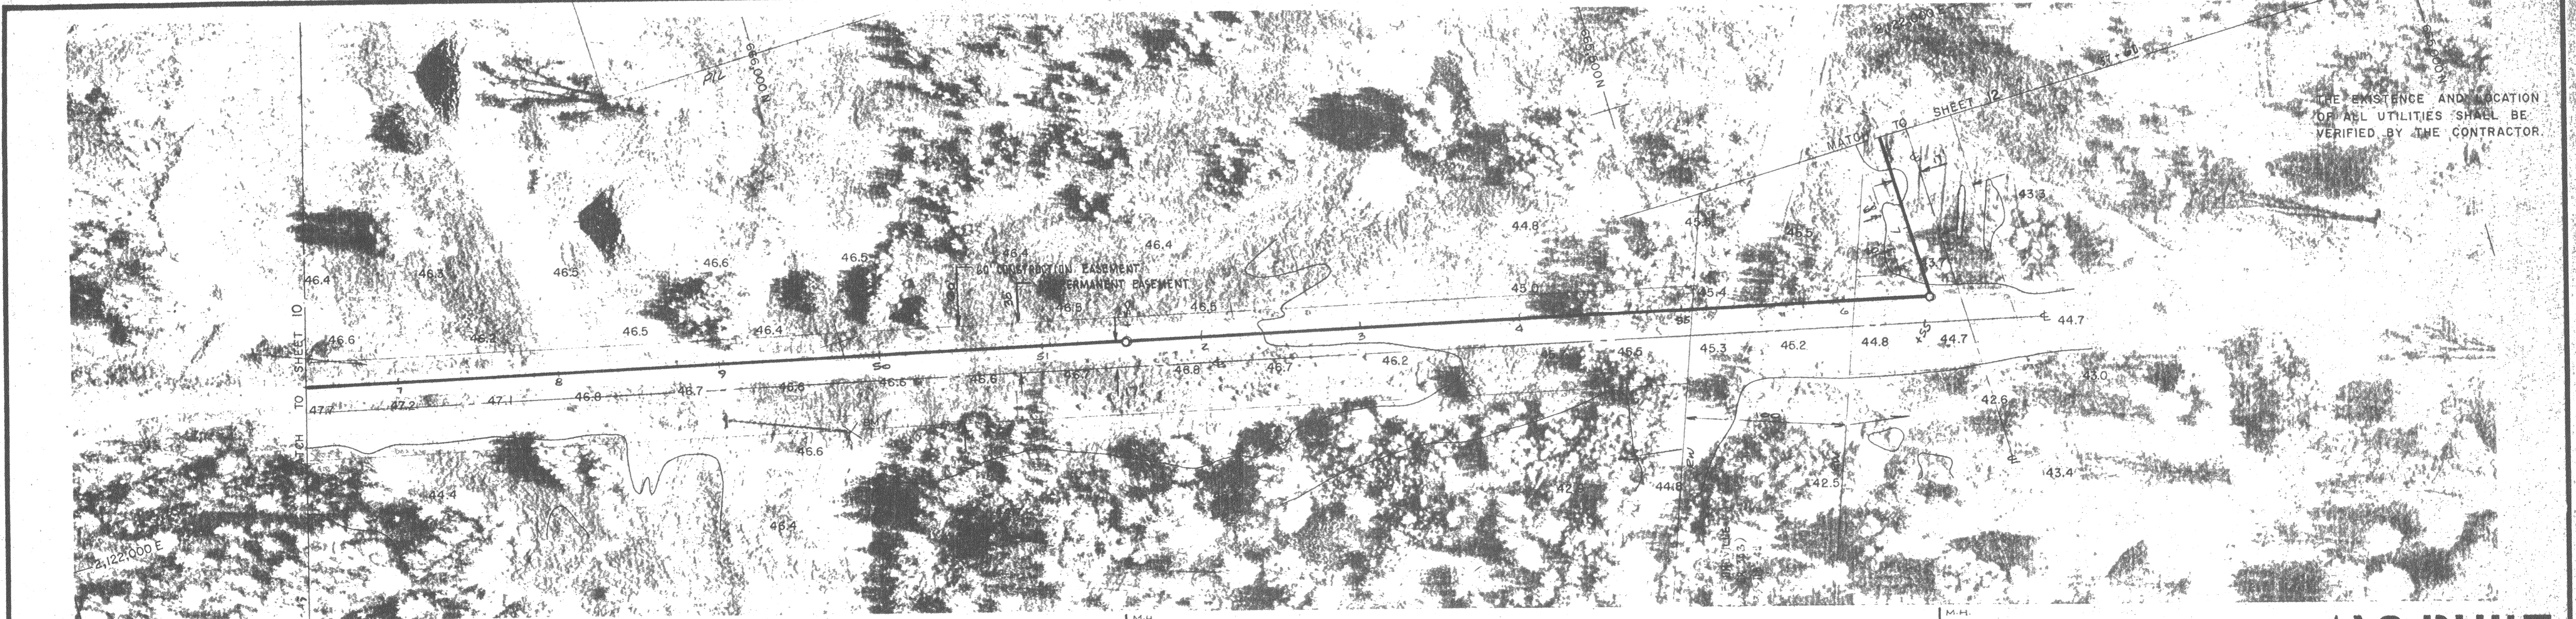

AS BUILT DATA

AS BUILT DATA

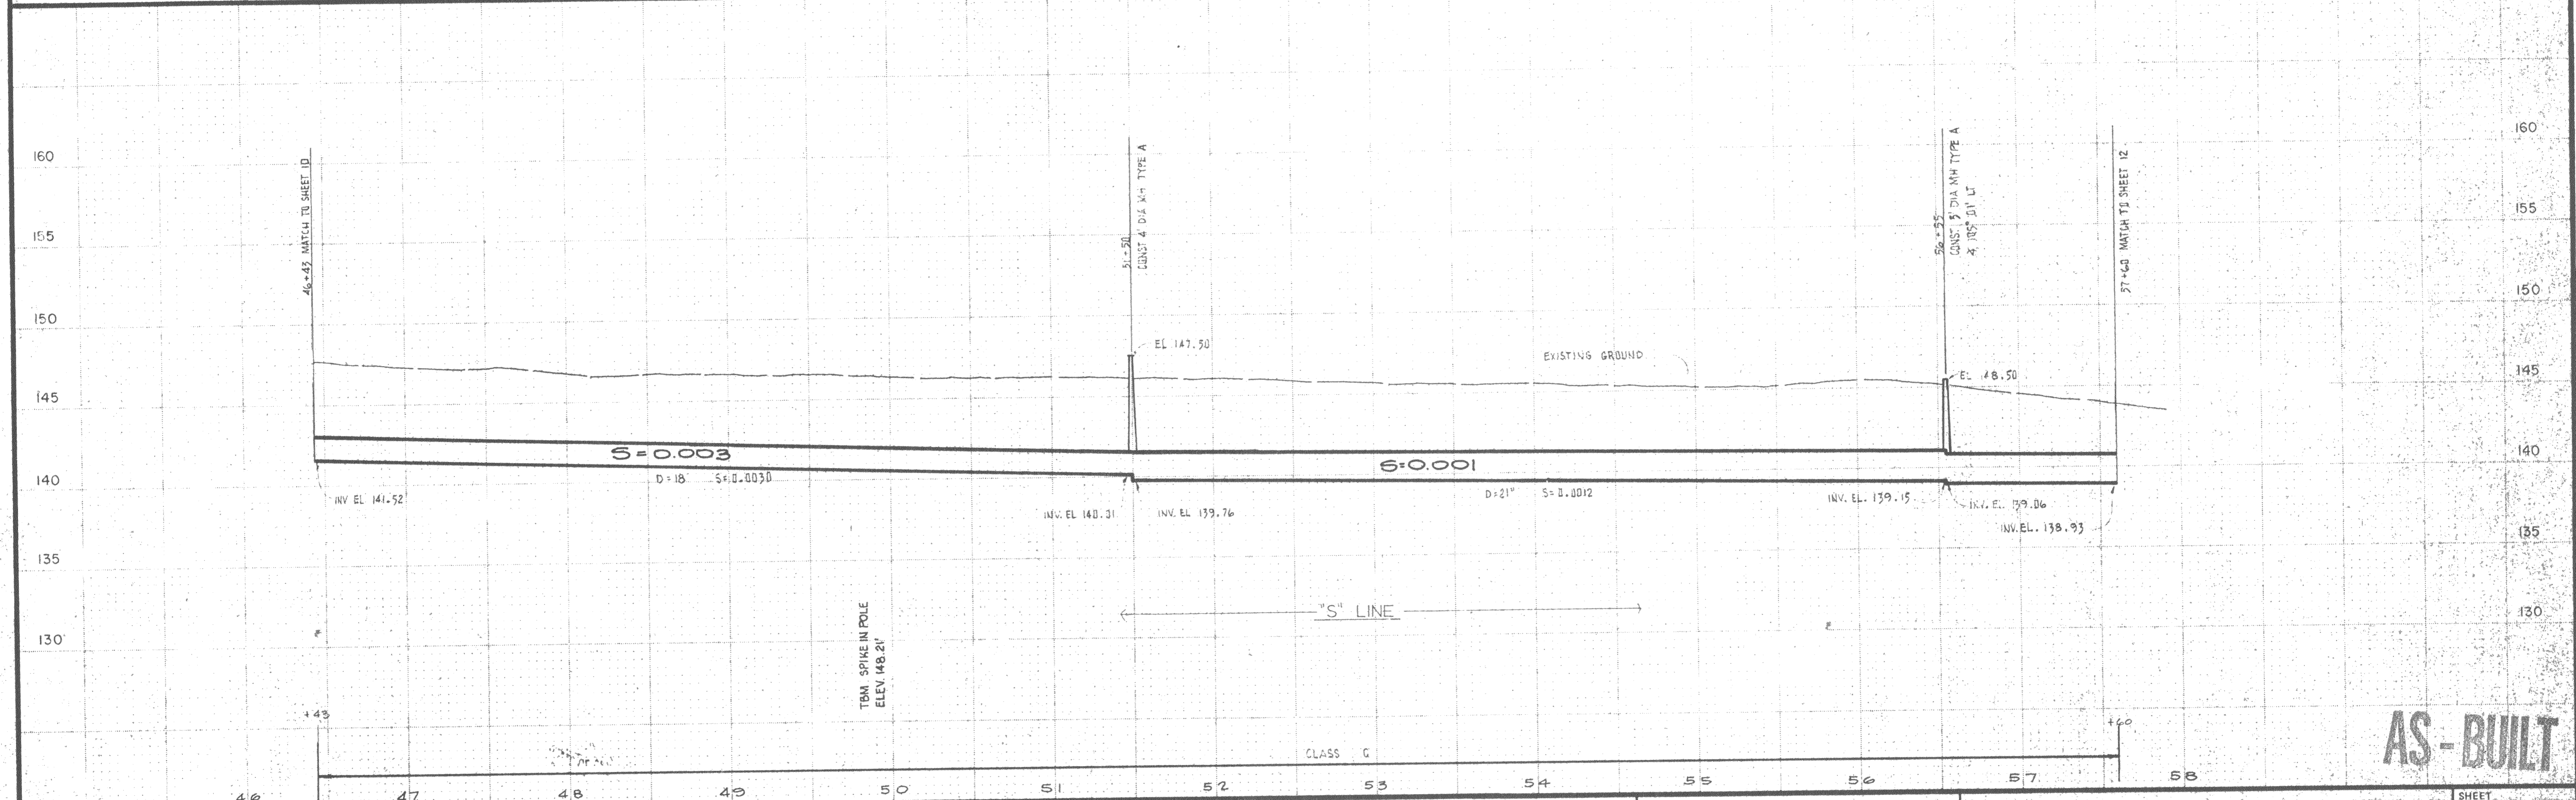

AS BUILT

RINGEL & ASSOCIATES, INC

DES. EAR

DR. W.K.J. GB

CHK. GB, W.K.J.

APPD. *[Signature]*

NO.	DATE	REVISION	BY	APPD.

"S" LINE

SEWERAGE COMMISSION,
OROVILLE REGION
OROVILLE, CALIFORNIA

PLAN AND PROFILE
SC-OR WEST INTERCEPTOR

AS-BUILT

SHEET 11 OF 20

DATE AUG. 1, 1974

PROJ. NO. 2316