



THE EXISTENCE AND LOCATION OF ALL UTILITIES SHALL BE VERIFIED BY THE CONTRACTOR

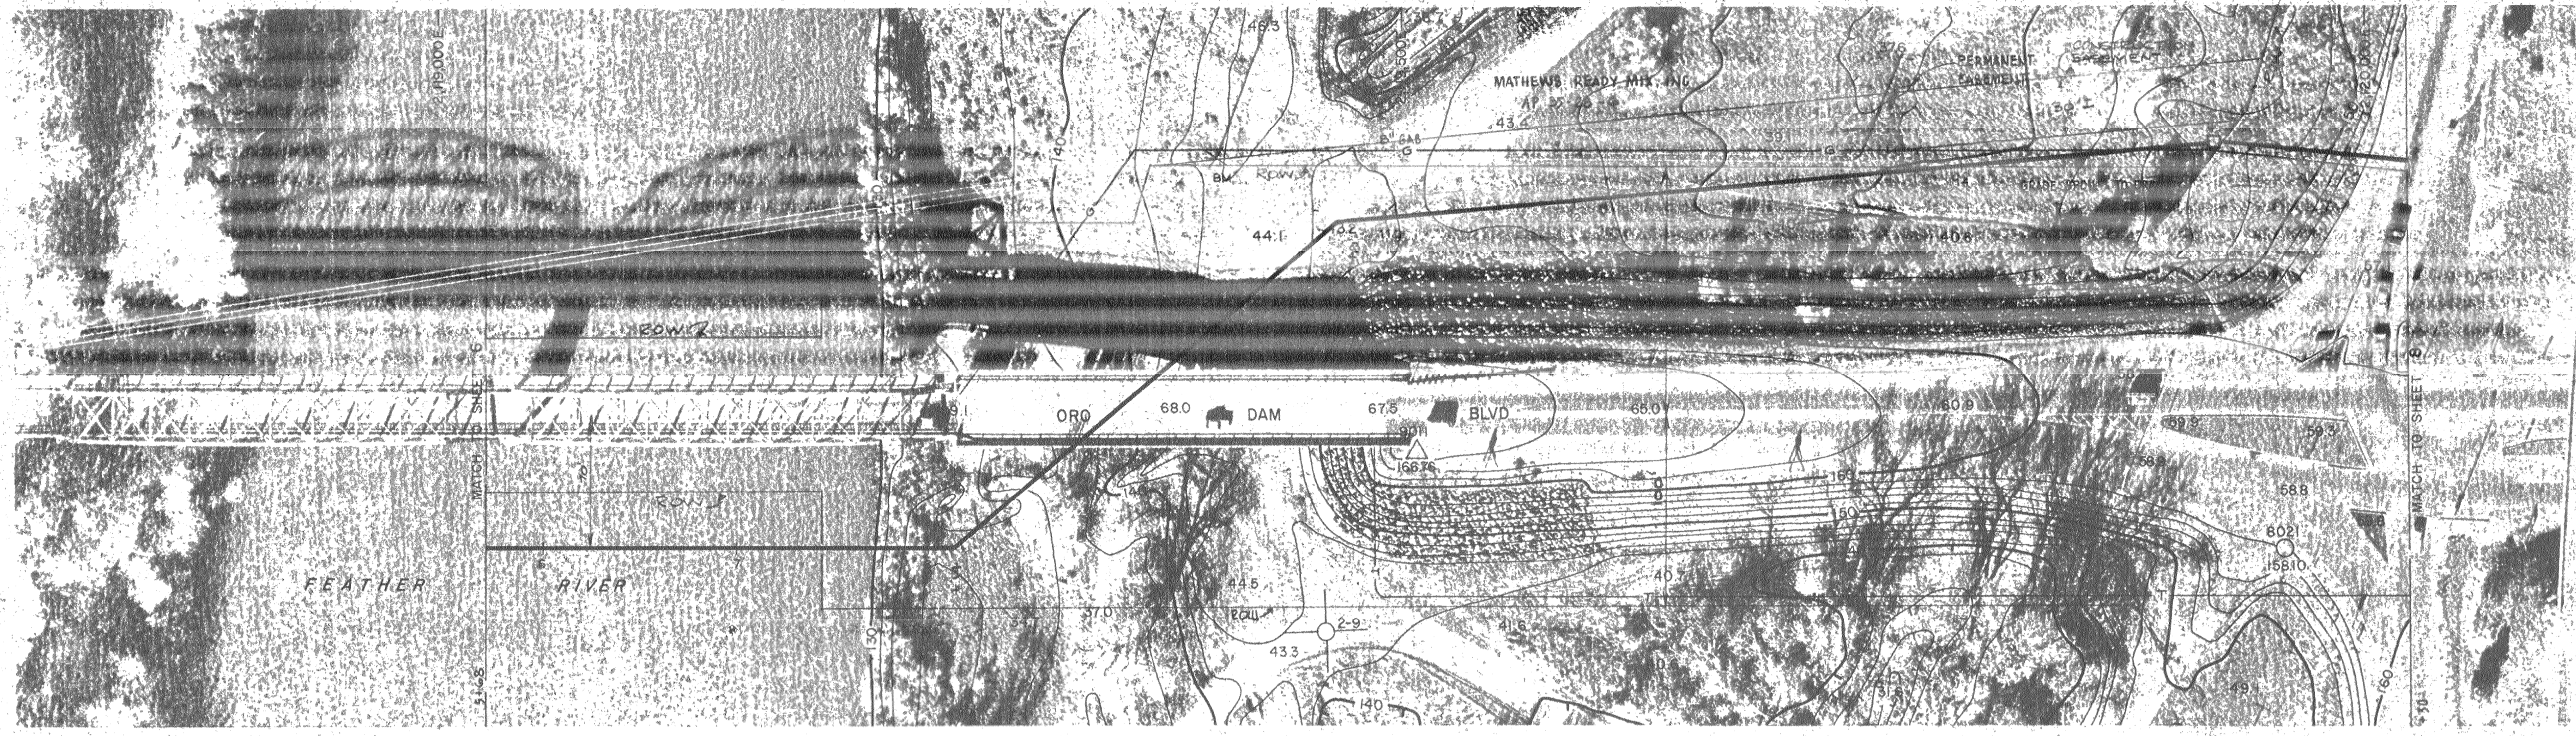

AS BUILT DATA

AS BUILT DATA

SEE AS-BUILT GRADE CHANGE AS SHOWN BELOW

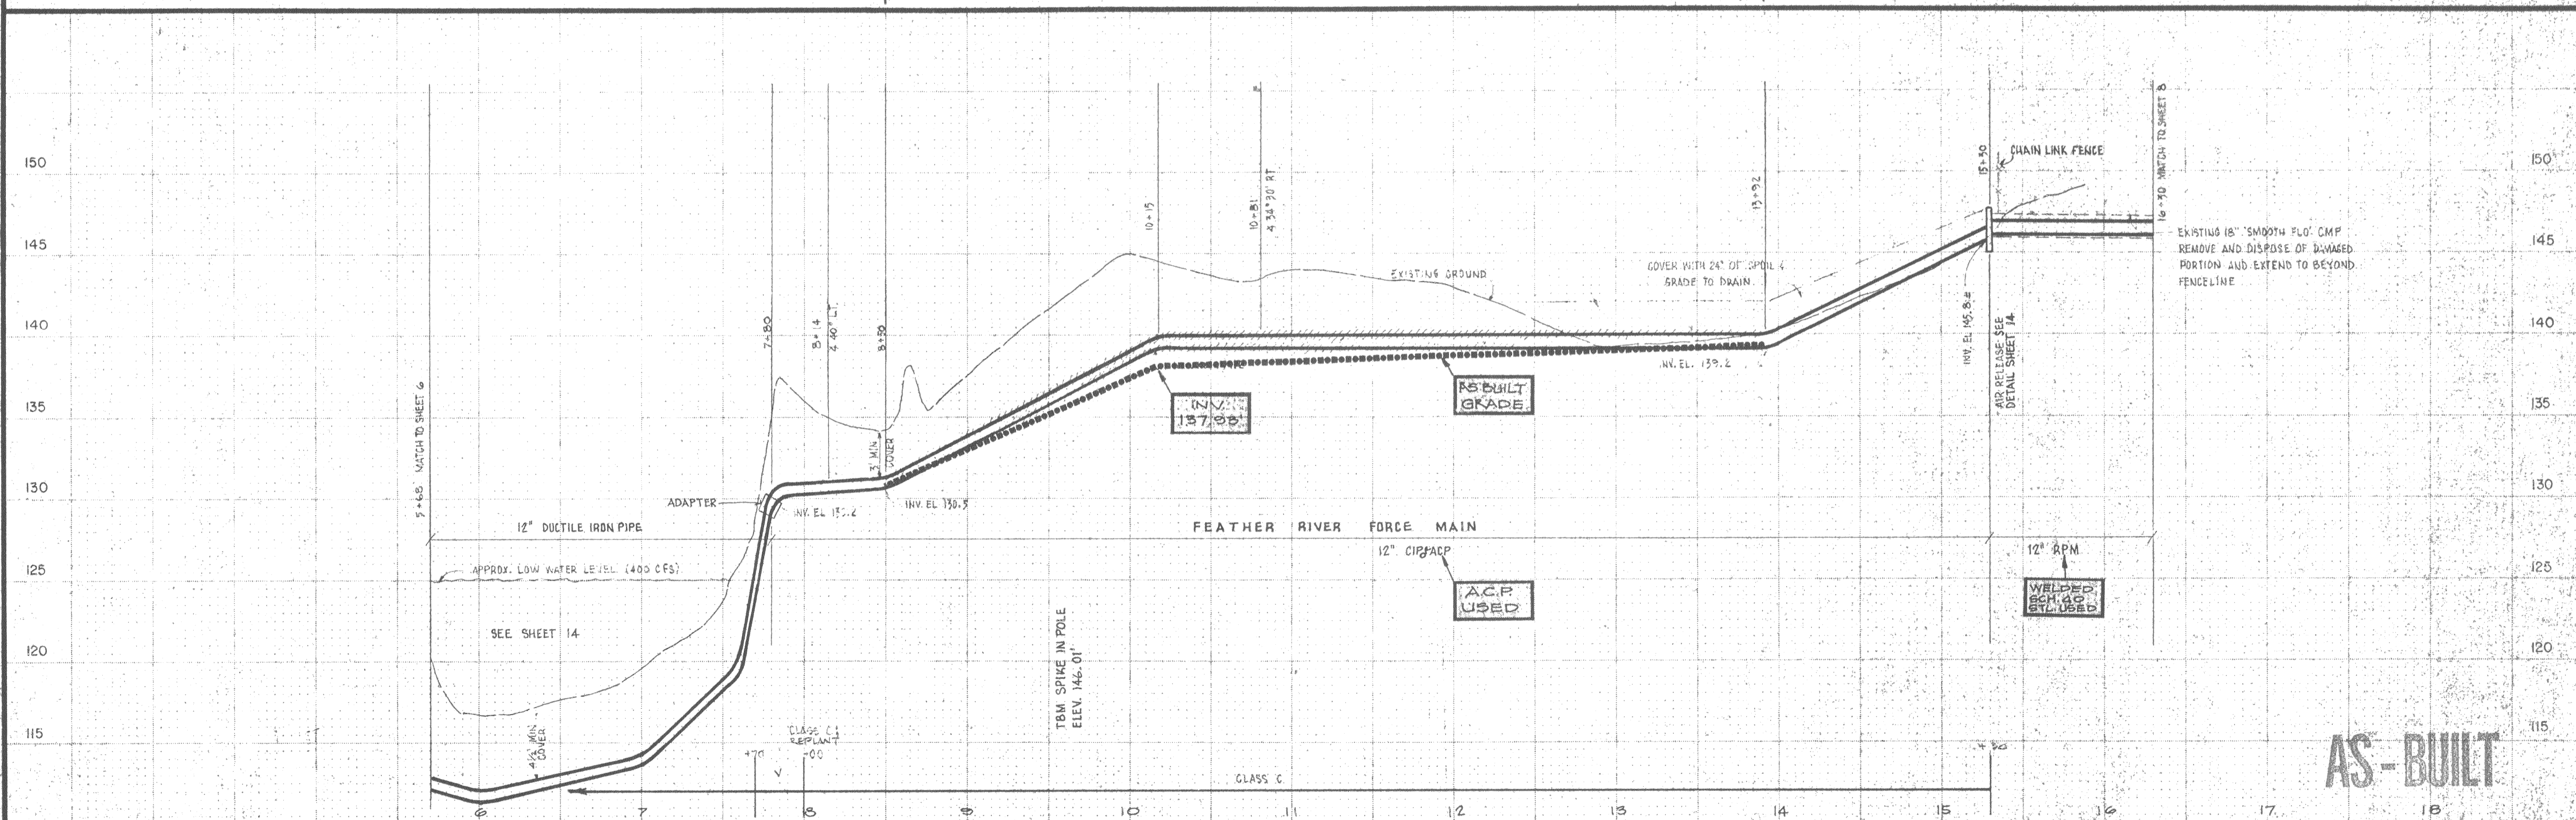

| | | | | | | | | | | |
|----------|--------------------------|-------------------|-----|------|----------|----|-------|---|--|-------------------|
| AS-BUILT | RINGEL & ASSOCIATES, INC | DES. EAR | NO. | DATE | REVISION | BY | APPD. | SEWERAGE COMMISSION, OROVILLE REGION OROVILLE, CALIFORNIA | PLAN AND PROFILE SC-OR WEST INTERCEPTOR | SHEET |
| | | DR. W.K.J., G.B. | | | | | | | | 7 OF 20 |
| | | CHK. G.B., W.K.J. | | | | | | | | DATE AUG. 1, 1974 |
| | | APPD. [Signature] | | | | | | | | PROJ. 2316 |

AS-BUILT