


AS BUILT DATA

AS BUILT DATA

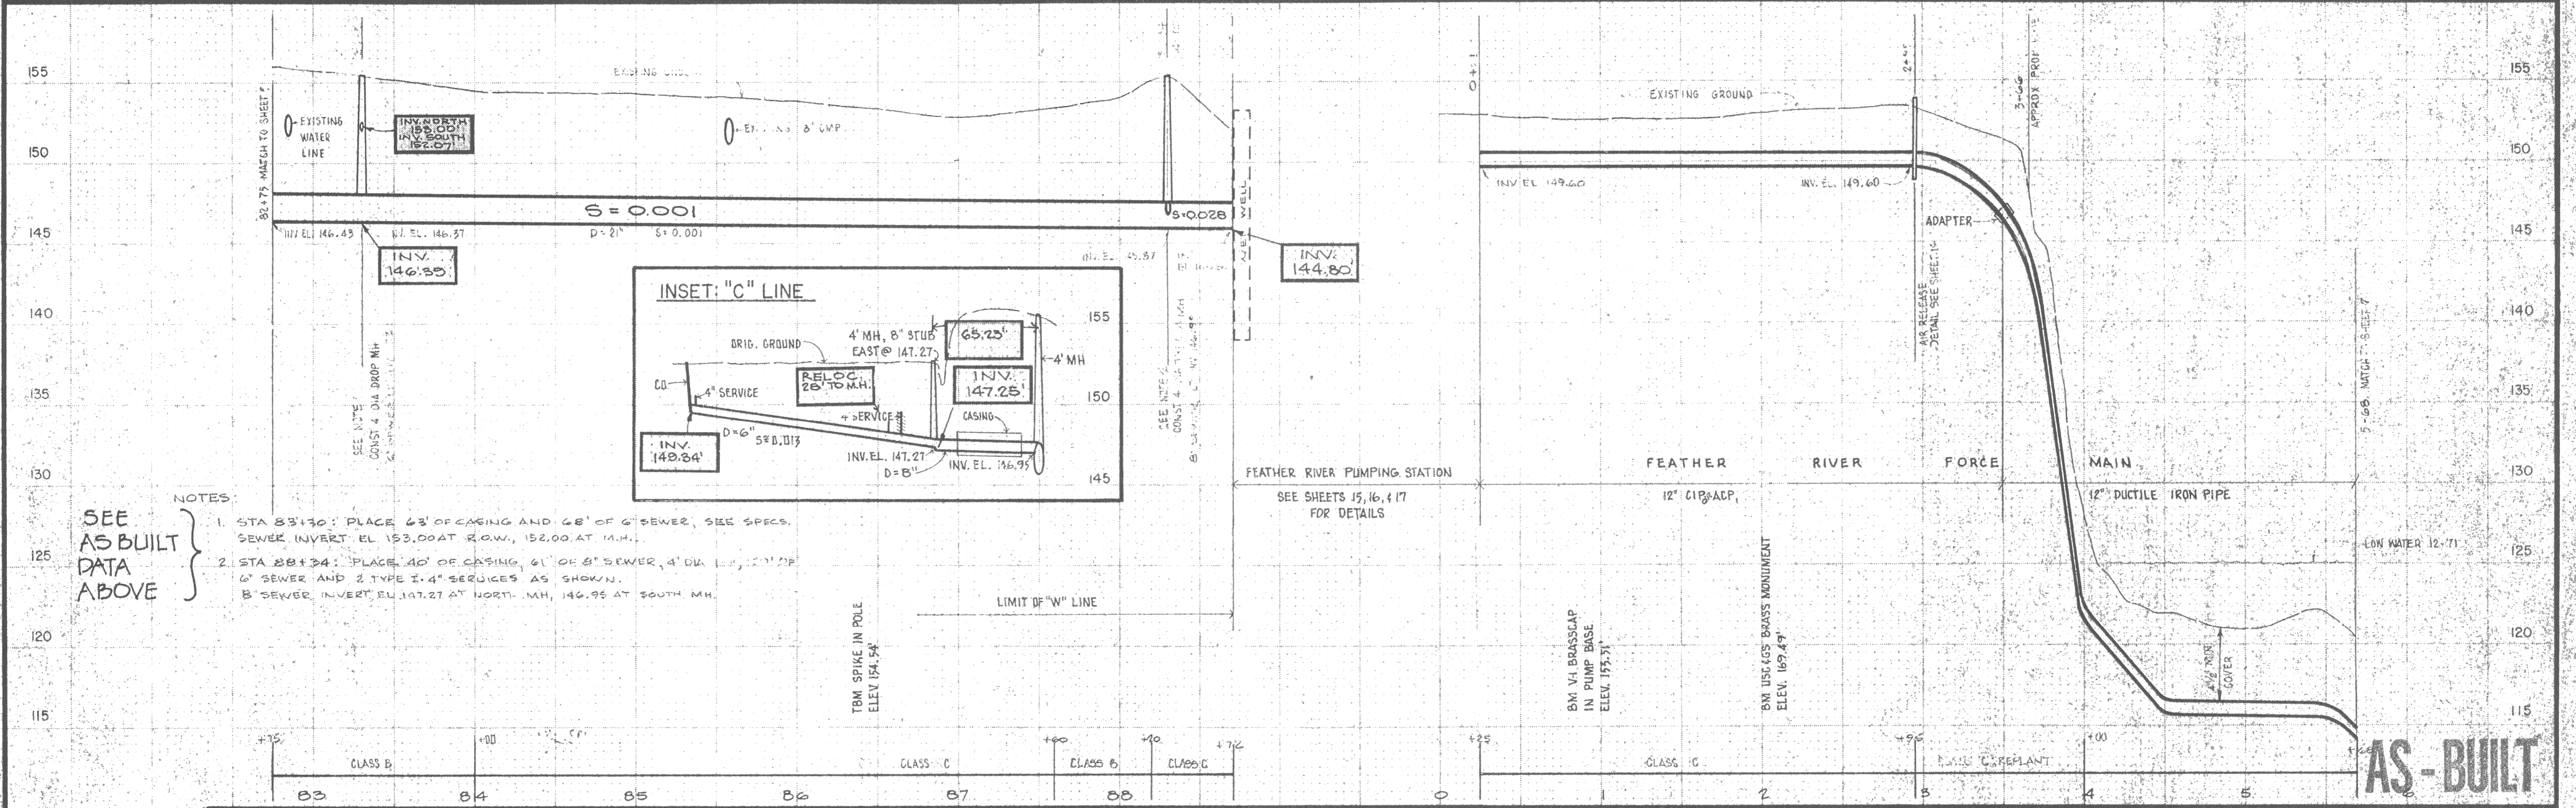

SEE AS BUILT DATA ABOVE

- NOTES:
- STA 83+30: PLACE 63' OF CASING AND 68' OF 6" SEWER, SEE SPECS. SEWER INVERT EL 153.00 AT ROW, 152.00 AT M.H.
  - STA 84+34: PLACE 40' OF CASING, 61' OF 8" SEWER, 4' DIA. 12" DIA. 6" SEWER AND 2 TYPE 2.4" SERVICES AS SHOWN. B' SEWER INVERT EL 147.27 AT NORTH M.H., 146.95 AT SOUTH M.H.

AS-BUILT	RINGEL & ASSOCIATES, INC		DES. EAR		"W" LINE; FEATHER RIVER PUMP STATION; FEATHER RIVER FORCE MAIN		SEWERAGE COMMISSION, OROVILLE REGION OROVILLE, CALIFORNIA		PLAN AND PROFILE		SHEET 6 OF 20
			DR. WJK, GB CHK. GB, WJK APPD. <i>[Signature]</i>						SC-OR WEST INTERCEPTOR		
				NO. DATE		REVISION		BY		APPD.	