



THE EXISTENCE AND LOCATION OF ALL UTILITIES SHALL BE VERIFIED IN THE FIELD.

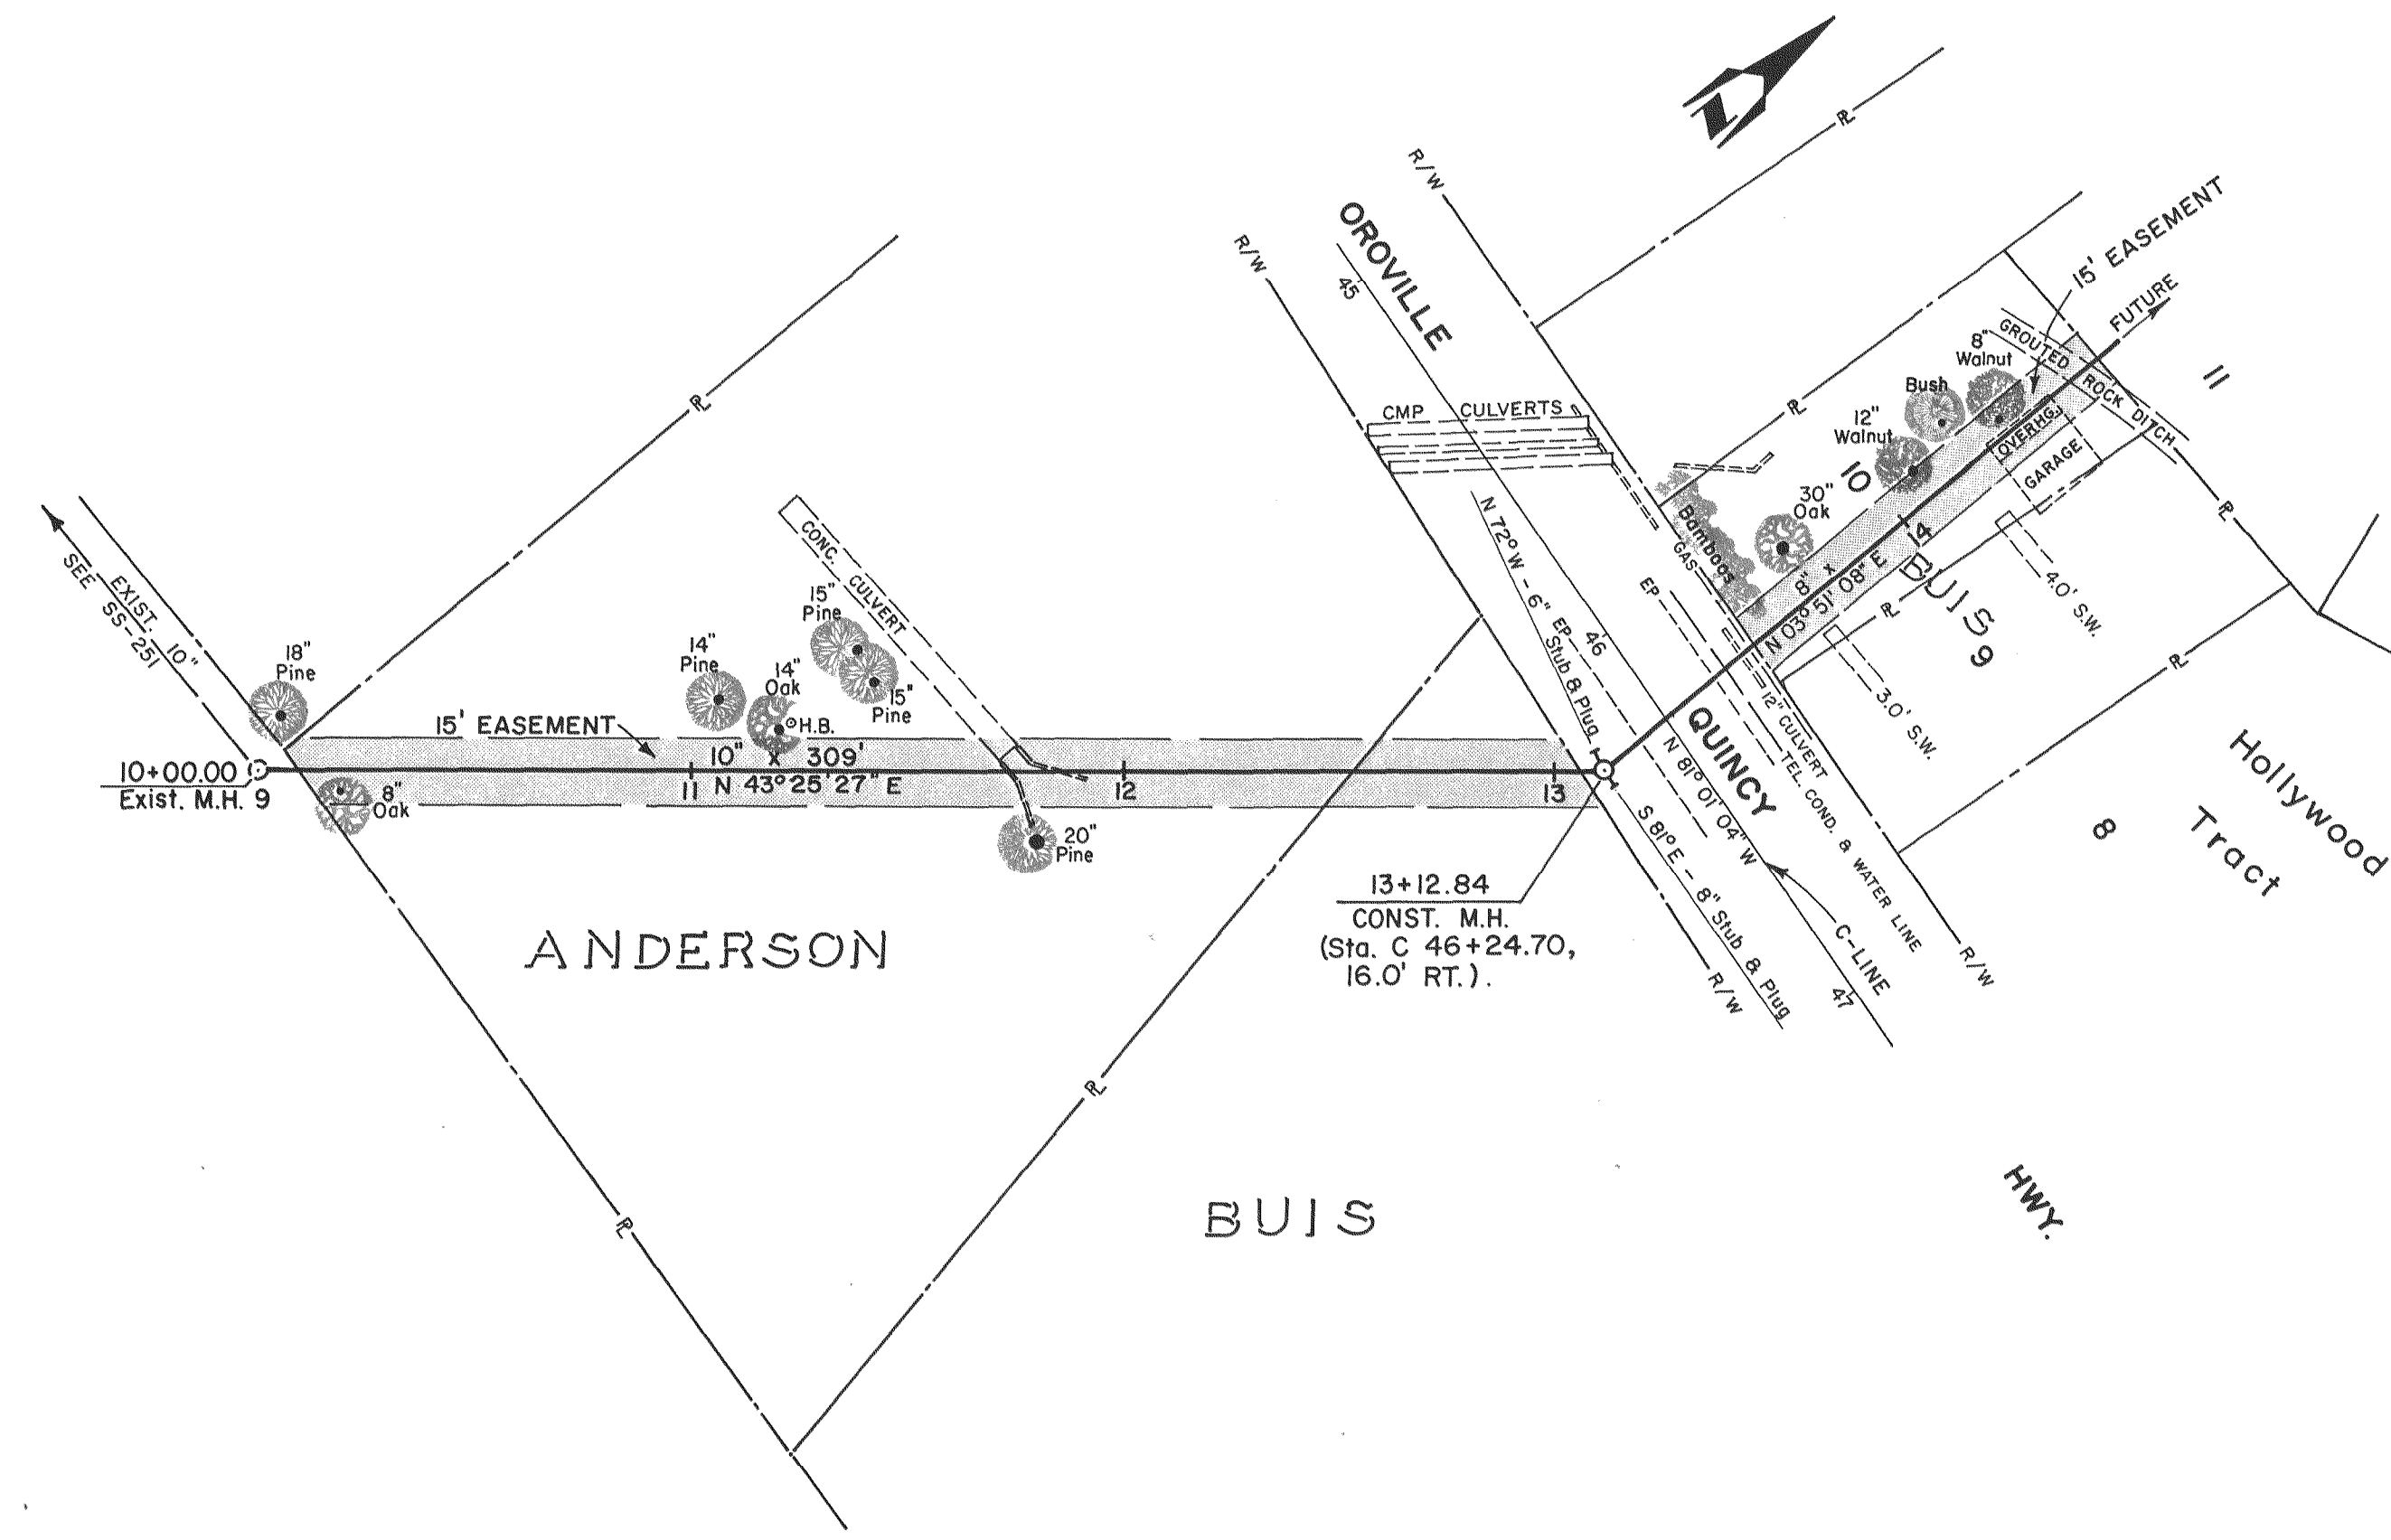


NOTE: BASIS OF BEARING IS IDENTICAL WITH BUTTE COUNTY PROJECT 21554-70-2 (EASEMENTS IDENTICAL WITH DEEDS).

PLAN SCALE: 1" = 40'

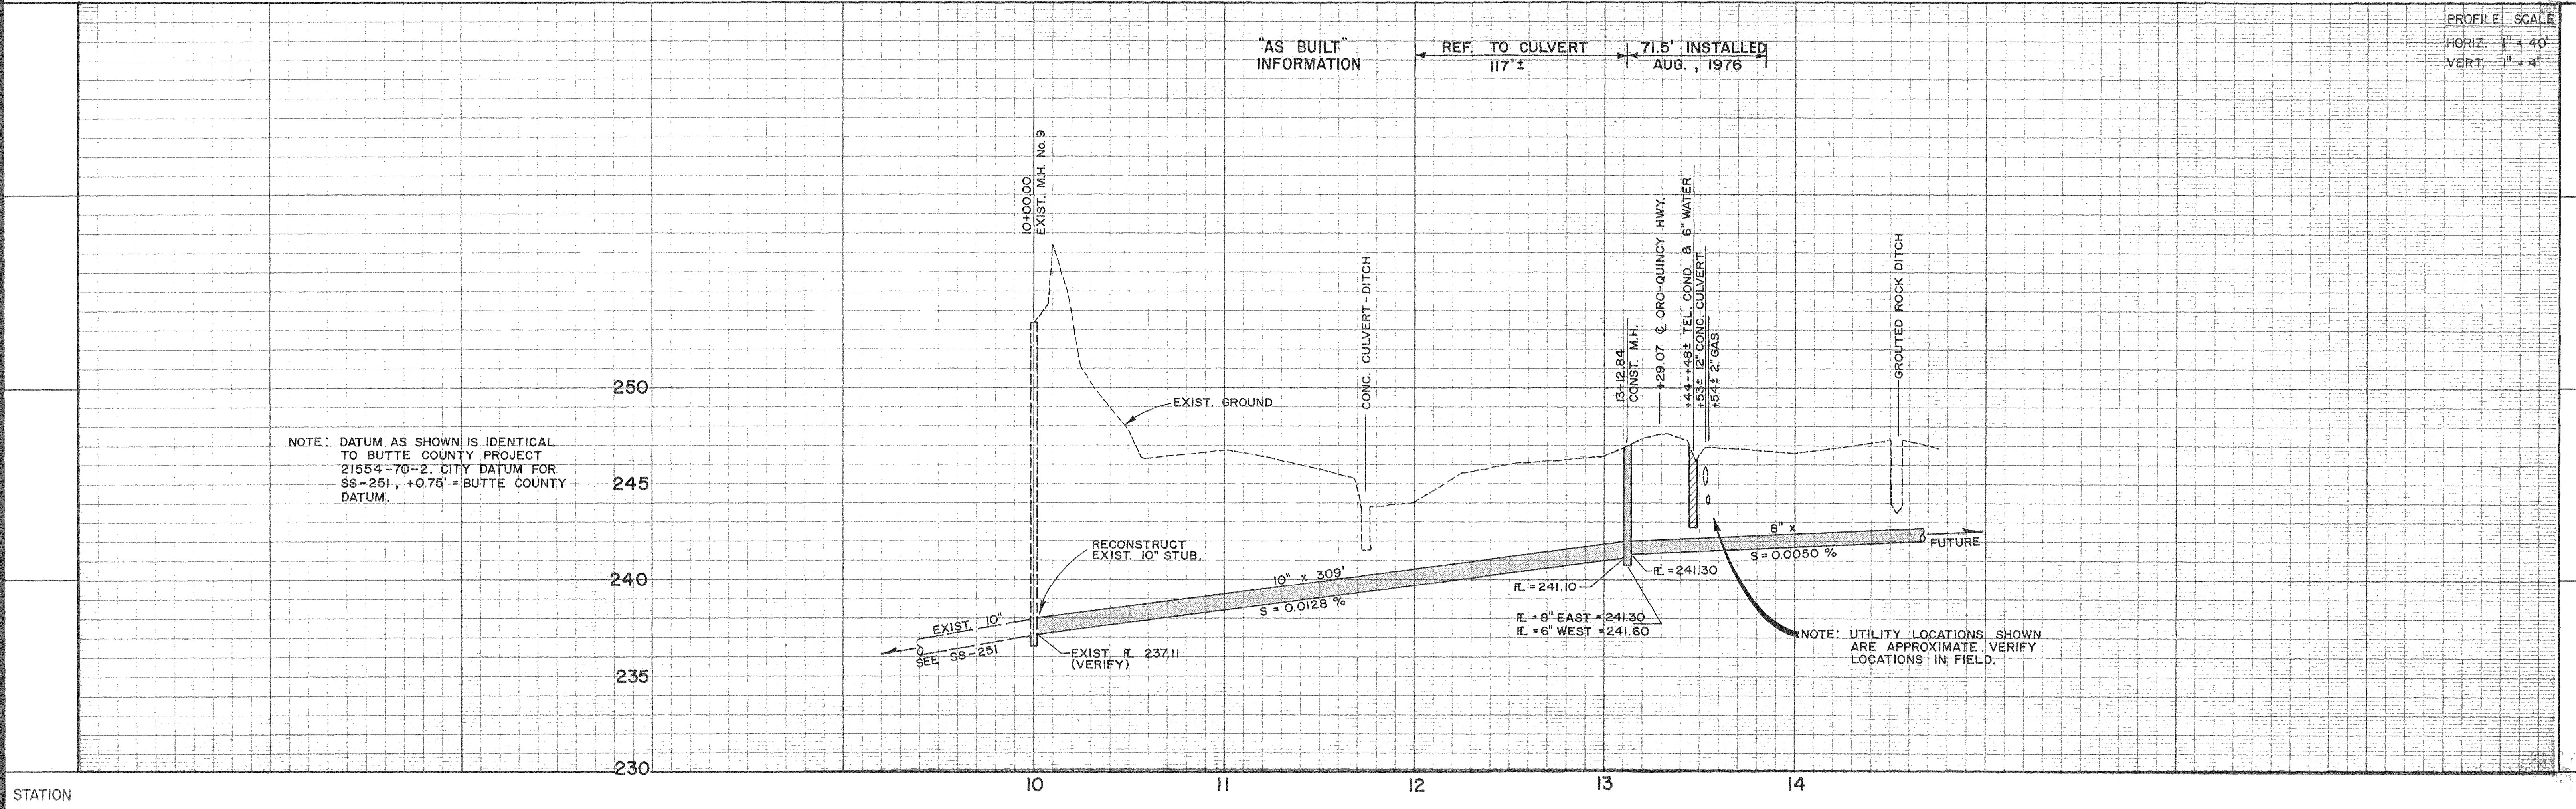

NOTE: DATUM AS SHOWN IS IDENTICAL TO BUTTE COUNTY PROJECT 21554-70-2. CITY DATUM FOR SS-251, +0.75' = BUTTE COUNTY DATUM.

PROFILE SCALE
 HORIZ. 1" = 40'
 VERT. 1" = 4'
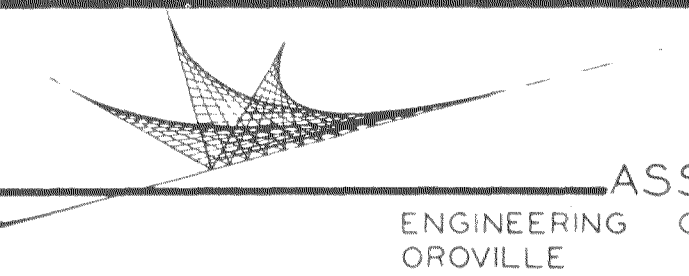
<p>76453</p>  <p>COOK ASSOCIATES ENGINEERING CONSULTANTS OROVILLE CALIFORNIA</p>	<h2 style="margin: 0;">CITY OF OROVILLE</h2>	<h3 style="margin: 0;">OROVILLE - QUINCY HIGHWAY SEWER EXTENSION</h3>	<p>AS BUILT</p> <p>3/28/77</p>
			<p>JULY, 1976 DATE</p> <p>SHEET 1</p> <p>OF 1 SHEETS</p> <p style="font-size: 24pt; font-weight: bold;">SS 268</p>