


NOTE: POLE AND ANCHOR LOCATION SUBJECT TO P.G. & E. REQUIREMENTS

★ NOTE: PLACE FULL WATER & SEWER PIPE SECTIONS AT CROSSING.

- LEGEND**
- (P) SEE PLANS FOR LOCATION
 - (S) SEE SPECIFICATIONS
 - (V) VARIES WITH MANUFACTURER (SEE NOTE ①)
- NOTES**
- ① ALL DIMENSIONS SHOWN ARE MINIMUM.
 - ② ALL WETWELL CONSTRUCTION SHALL CONFORM TO THE REQUIREMENTS FOR MANHOLE CONST. (S)
 - ③ STRUCTURE EXCAVATION AND BACKFILL, INCLUDING PUMP STATION, SHALL EQUAL THAT AS REQUIRED FOR MANHOLE CONSTRUCTION (S)
 - ④ ELEC. SERVICE SHALL CONFORM TO P.G. & E. REQUIREMENTS AND ALL APPLICABLE CODES.
 - ⑤ SEE ELECTRICAL DETAILS
 - ⑥ PROVIDE COUPLINGS IN SUCTION PIPING - DRESSER STYLE 98 OR EQUAL FOR 8\"/>
 - ⑦ AERATOR PIPING TO BE RIGID PVC PIPE, SCHEDULE 80 WITH TYPE I THREAD X THREAD FITTINGS, BALL VALVE ASSEMBLY GSR # 1022-TXT-015 OR EQUAL

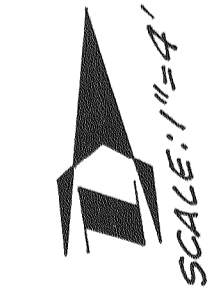

SEE SHEET C5 FOR DUPLEX SEWAGE PUMPING STATION DETAILS.

AS BUILT 7/6/81

SCHEDULE "A2"

COOK ASSOCIATES
ENGINEERING CONSULTANTS
2060 PARK AVENUE, OROVILLE, CALIFORNIA 95965

CITY OF OROVILLE
Industrial Unit No. 2
E.D.A. PROJECT NO. 07-01-02169
DUPLEX SEWAGE PUMPING STATION



REVISION	DATE

S. JACKSON 1/80
DRAWN DATE
D.J.C. 1/80
APPROVED DATE
A-361
FILE NO.
SHEET NO.
C4
OF 27 SHTS
JOB NO. 79487