


CANYON HIGHLANDS
 UNIT #3
 SEWER LINE
 6" PVC (SEWER MAIN)

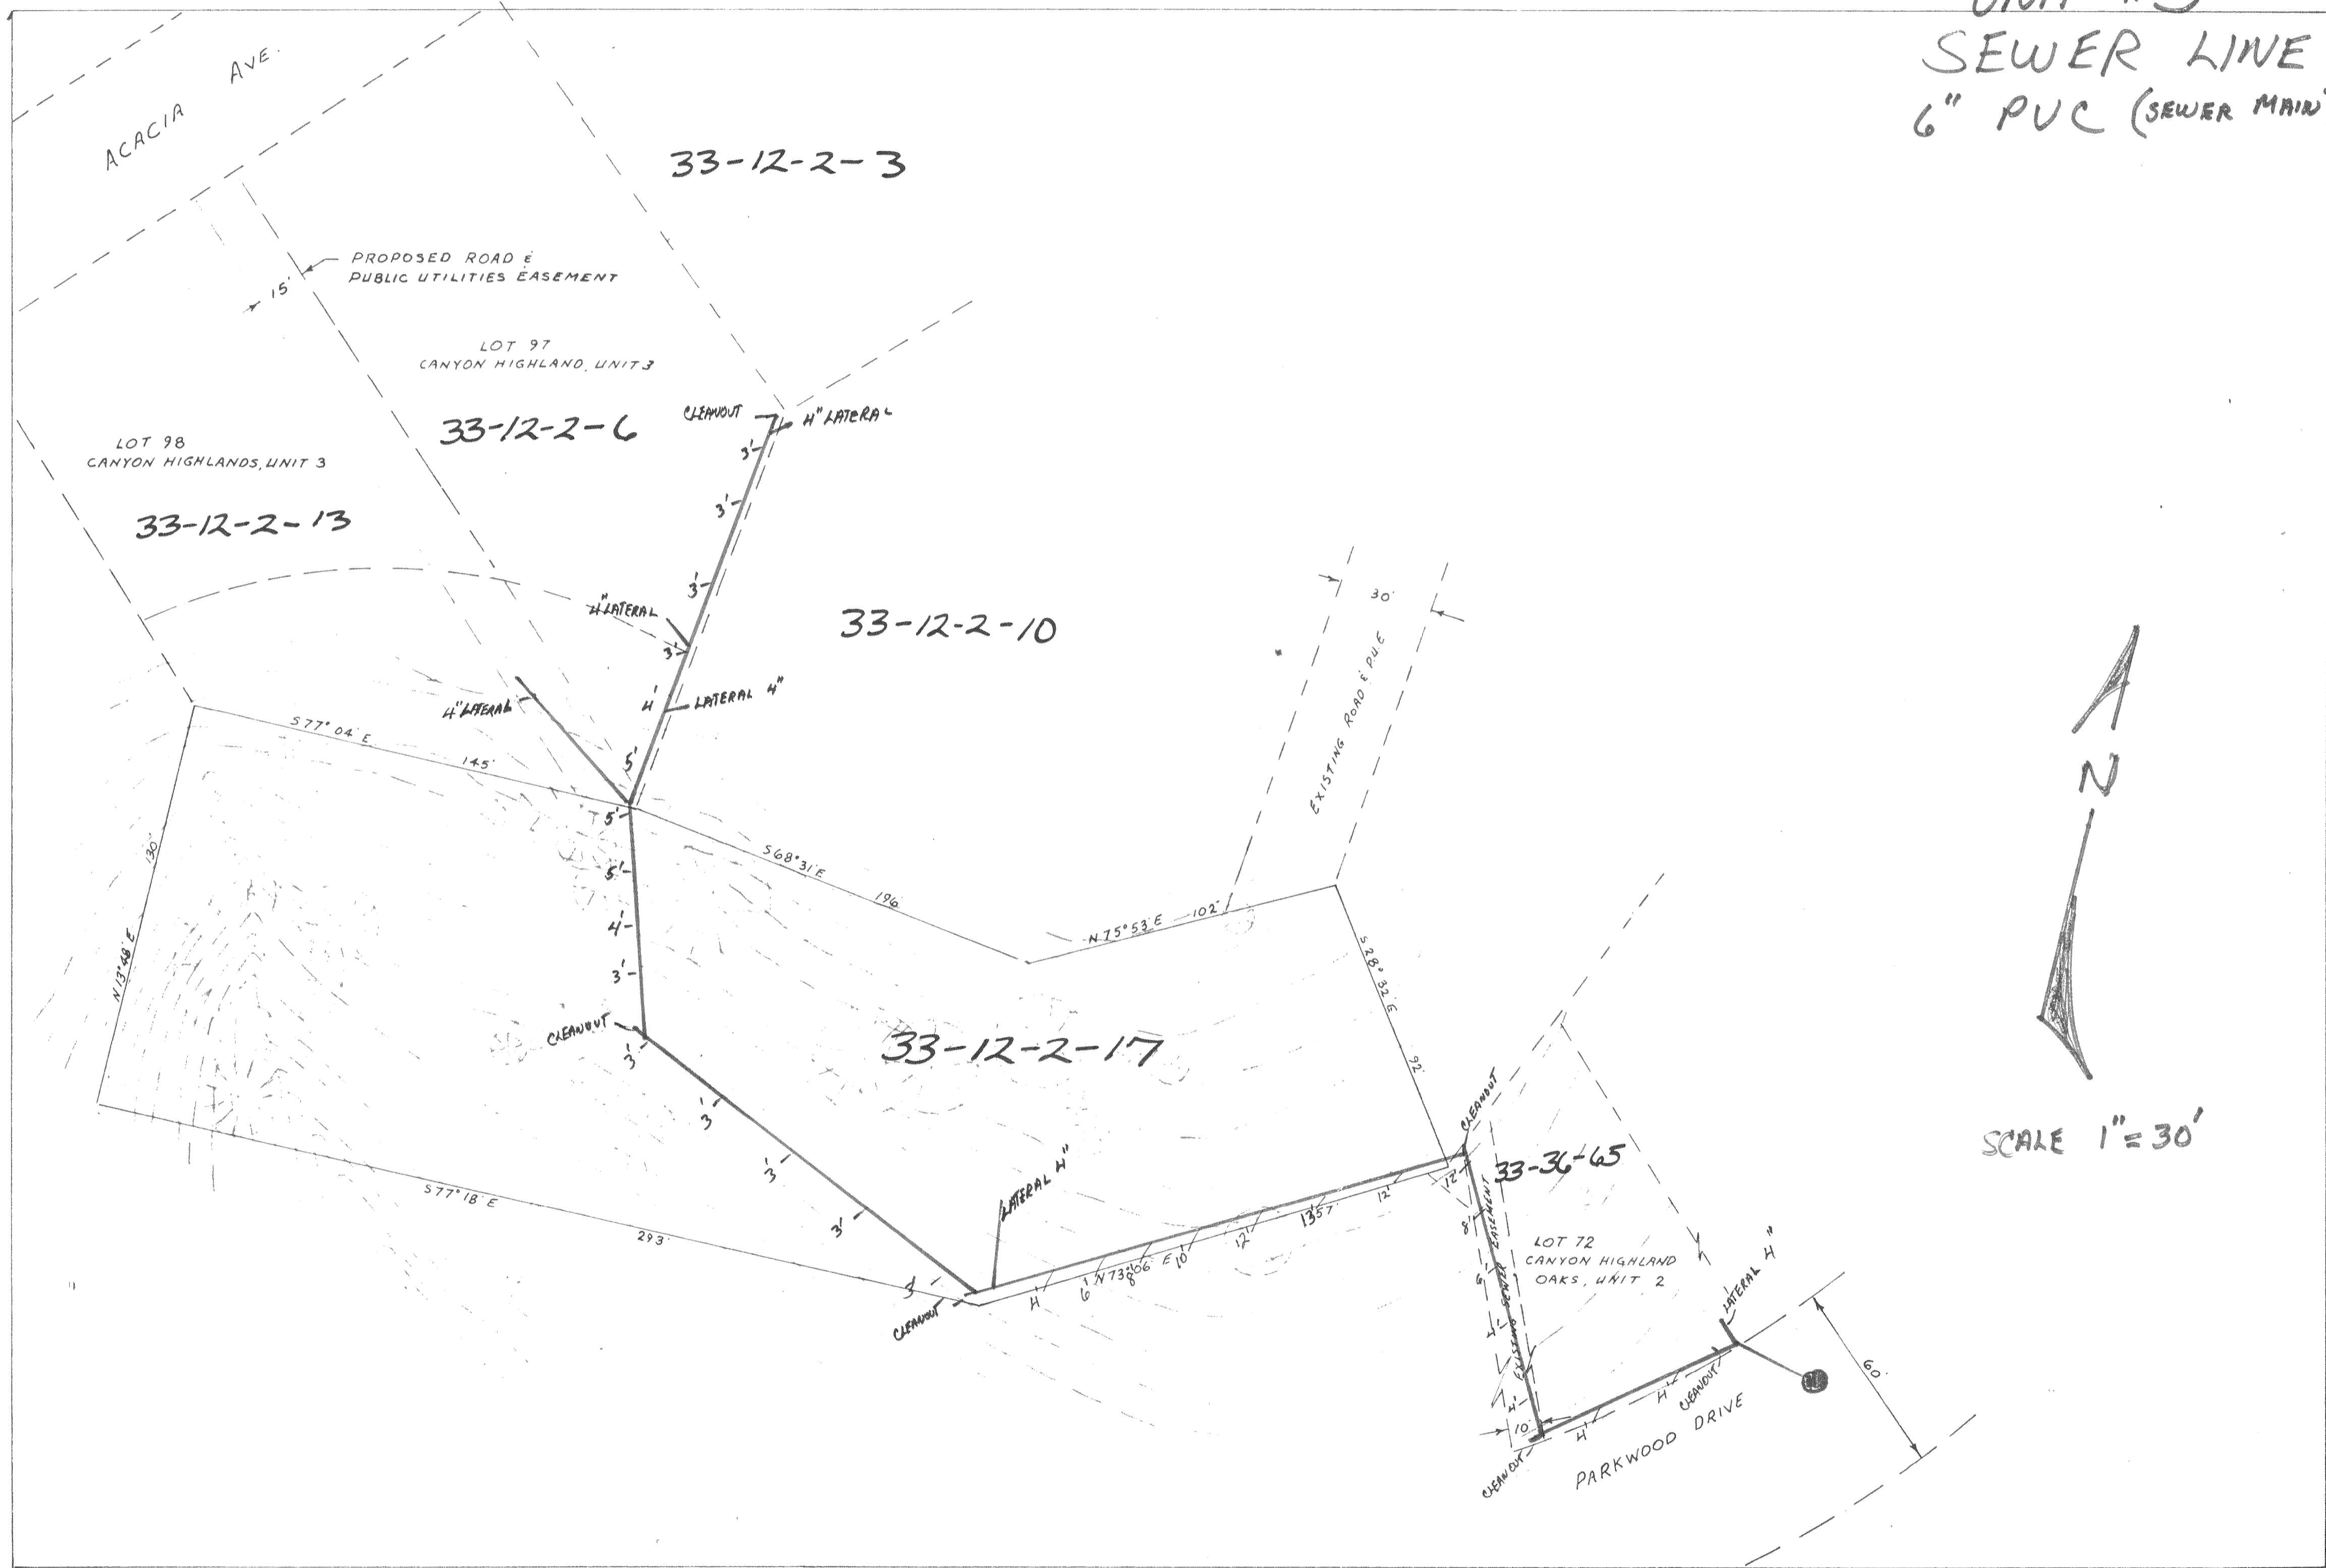

* PRIVATE LINE 55-300