



CONCRETE ENCASUREMENT TO BE USED ONLY WHERE DESIGNATED ON PLANS.

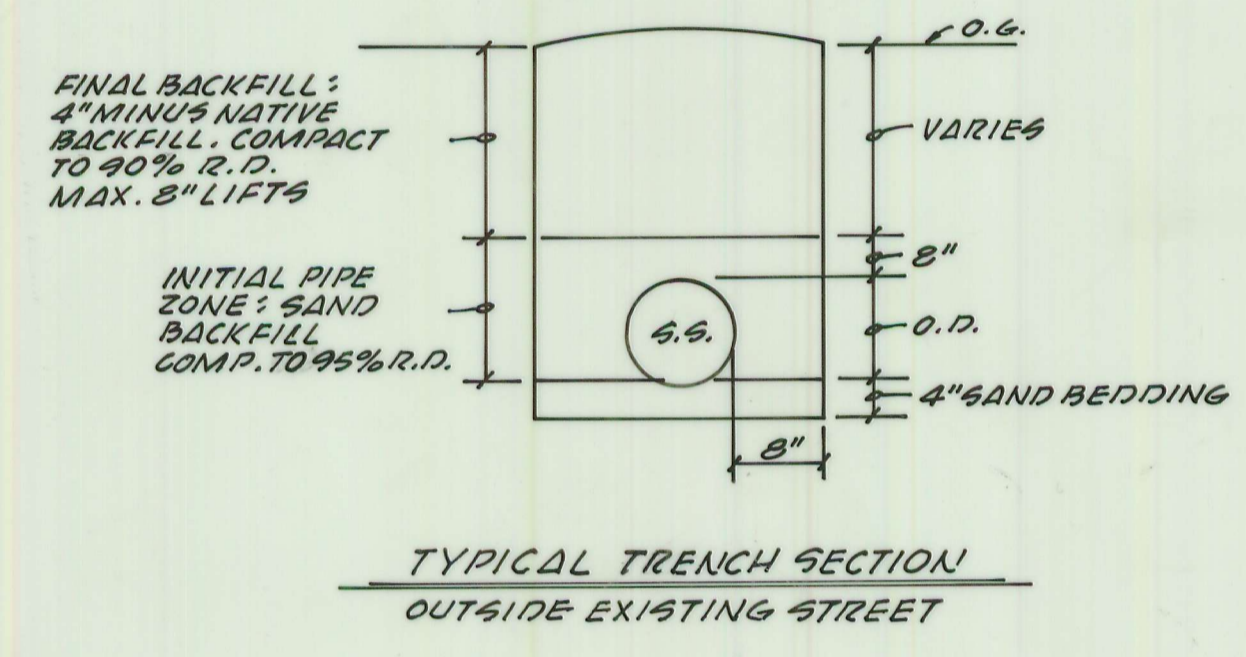

NOTE: CITY'S CONTRACTOR TO OBTAIN ENCROACHMENT PERMIT FROM COUNTY. TO NAME COUNTY AS ADDITIONAL INSURED, TO PROVIDE 1 YEAR \$1000 MAINTENANCE BOND TO COUNTY OF BUTTE.

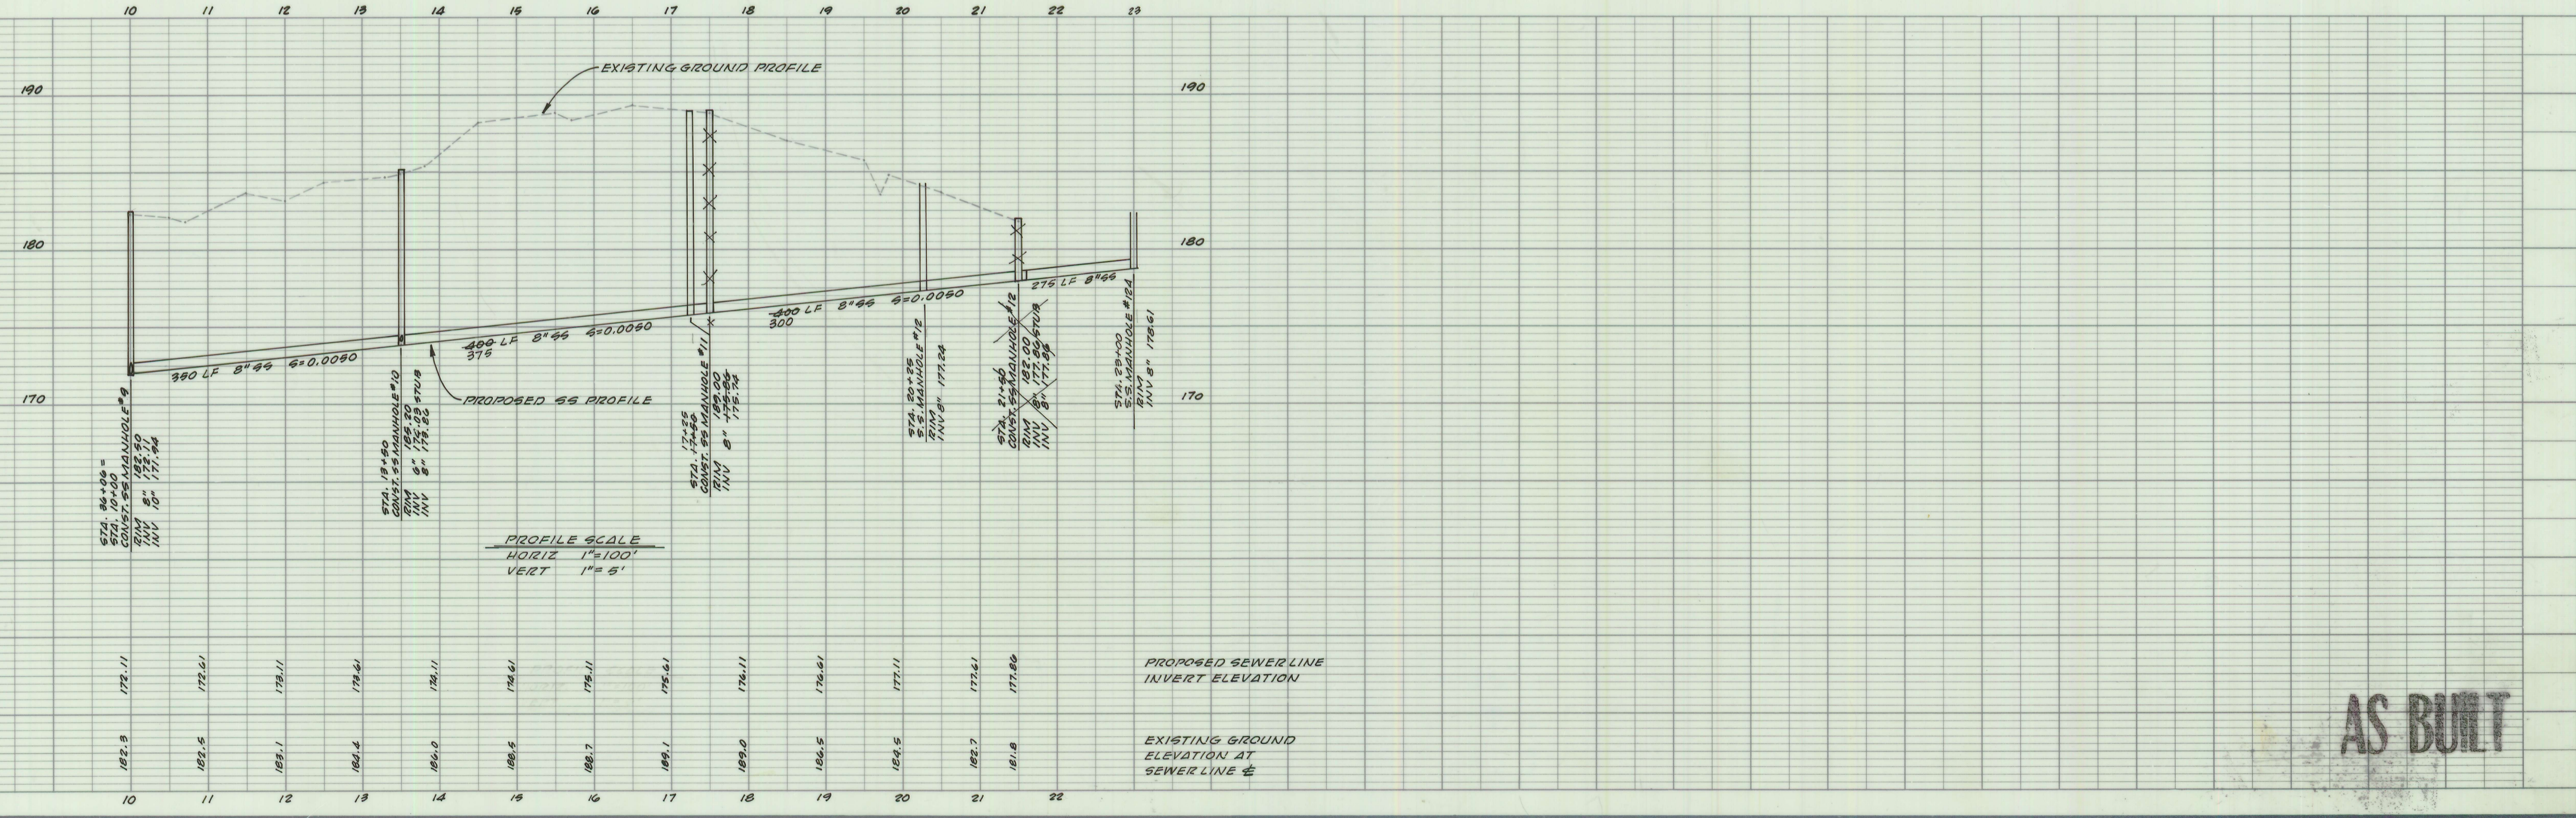

AS BUILT

11/15/16 AS BUILT DATE NR REVISION BY APP'D	LA FIELD BOOK ELEVATION DATUM	DRAWN LANE DESIGNED CHECKED A. G. P. SCALE AS SHOWN	APPROVED DATE	 BARNHART BROWN & ASSOCIATES A CALIFORNIA CORPORATION P.O. Box 1576 Oroville, CA 95965 916/534-1911 CIVIL ENGINEERS • LAND SURVEYORS	CITY OF OROVILLE GROVILLE MUNICIPAL AIRPORT SEWER EXTENSION	SHEET 3 OF 5 SHEETS JOB NO 85110
---	-------------------------------------	---	------------------	--	--	---

SS-316C