


VEATCH

STREET

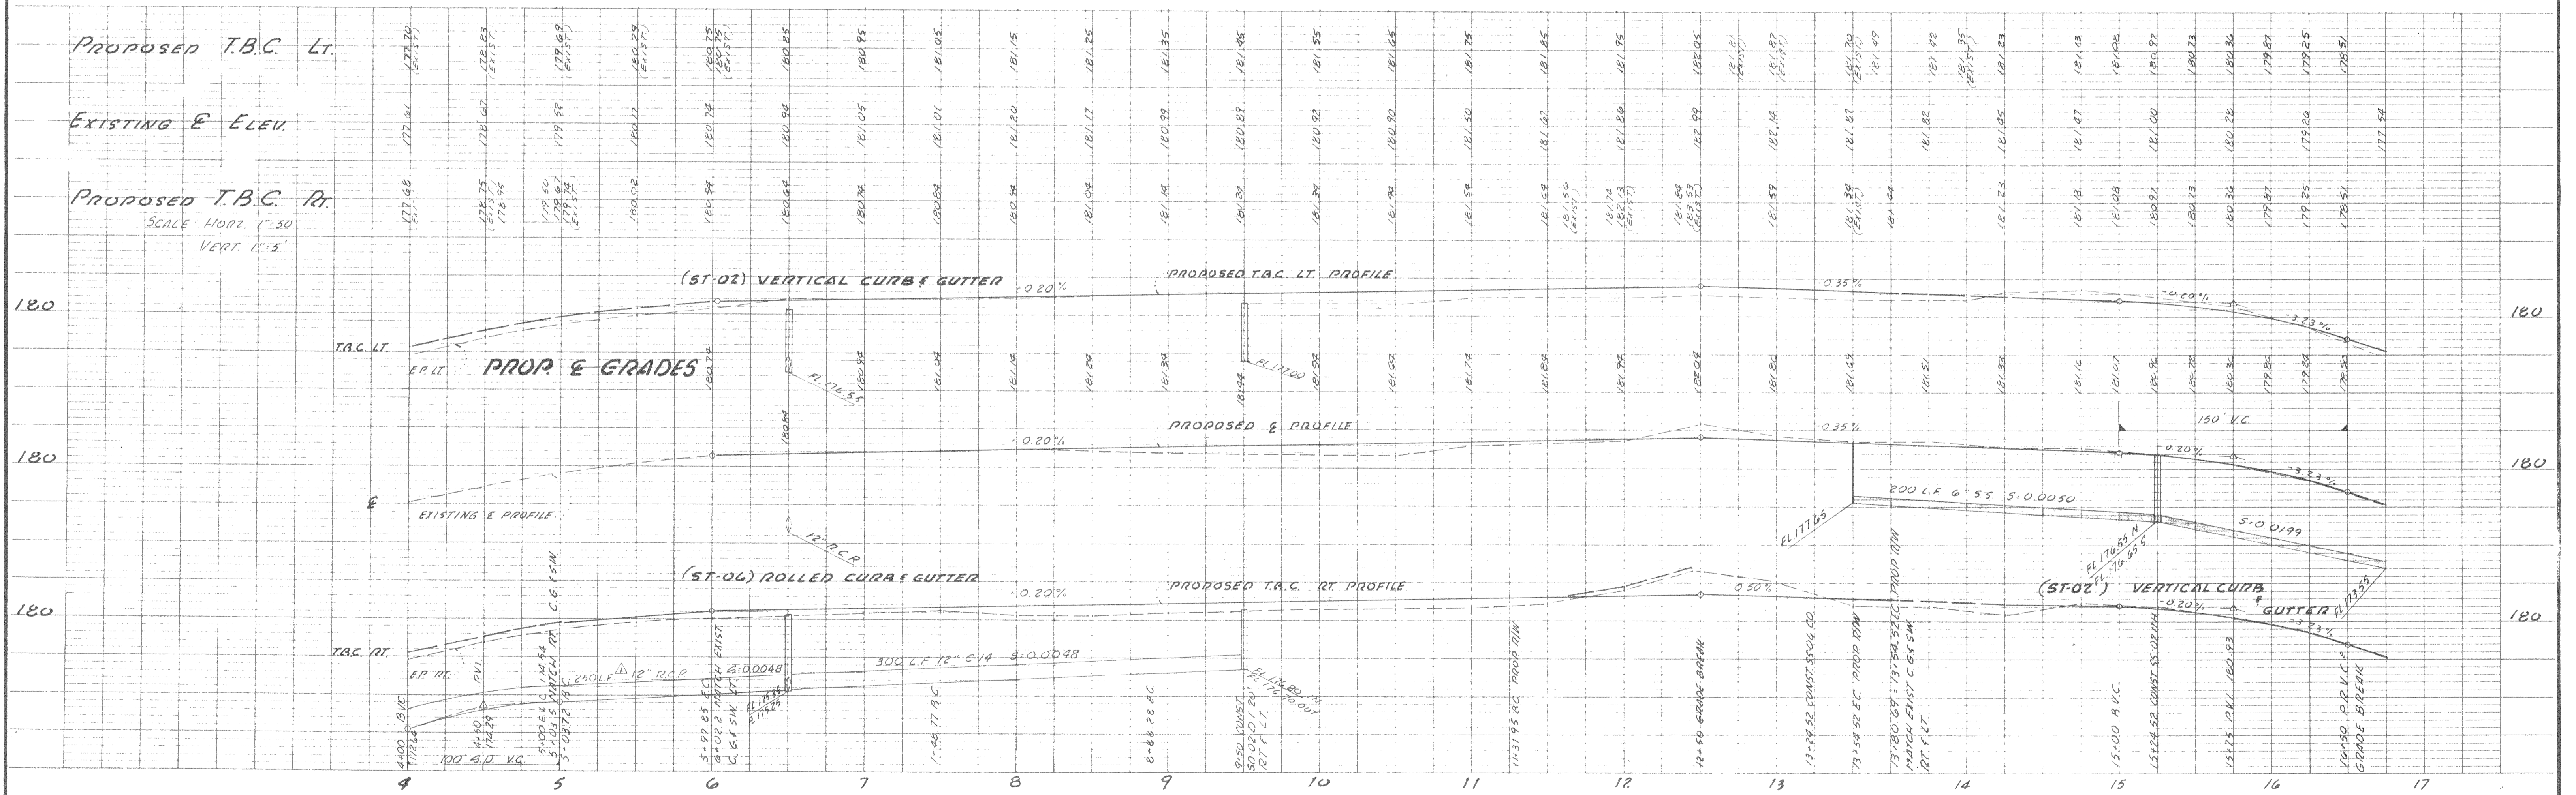

| | | | | | | | |
|---|--|---|--|--|---|---|--|
| 9.16.80 2.26.81 DATE REVISION BY APP'D | ADD 6.0 5.10 4.00 6.50 REMOVE DRY WELLS MOVE 4B & WATER LINES | FIELD BOOK ELEVATION DATUM TBM #1 ELEV 189.76 FOUND RR SPIKE 05 W/EN IN U.S. & S.M. COR PINE F MATCH ELL CITY OF OROVILLE DATUM | DRAWN 11.79 DESIGNED CHECKED SCALE AS SHOWN APPROVED DATE 16 Oct 1980 | | ENGINEERING SURVEYING PLANNING 463 ORO DAM ALVD SU. 11 OROVILLE, CALIF. 95965 (916) 535-2068 | IMPROVEMENT PLANS FOR: VEATCH STREET (STA 4+00 TO STA 17+00) CITY OF OROVILLE, CALIFORNIA | SHEET 3 OF 5 SHEETS JOB NO. 79-114 |
|---|--|---|--|--|---|---|--|