

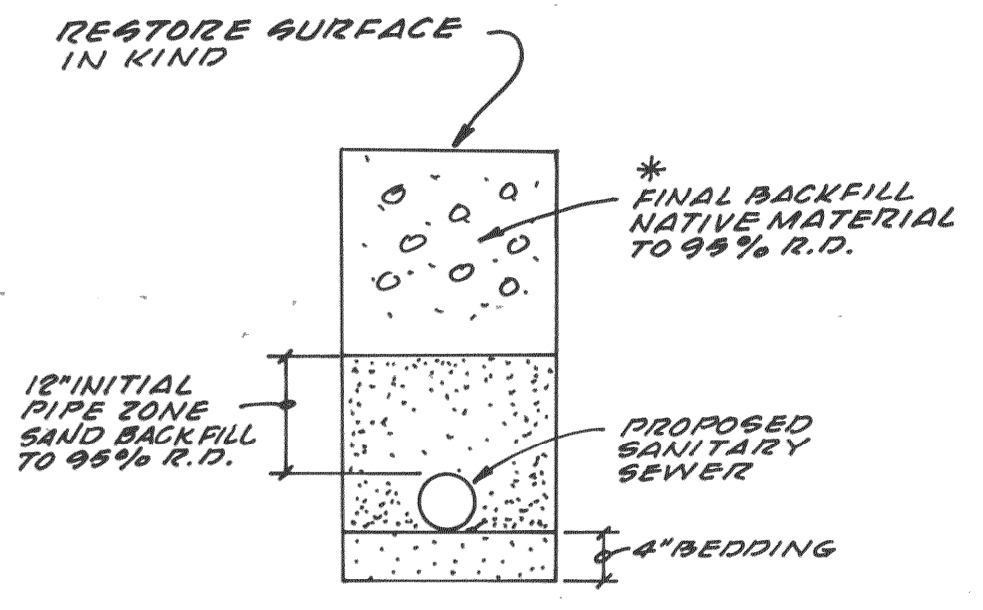


SCALE 1" = 20'
CONTOUR INTERVAL = 1'

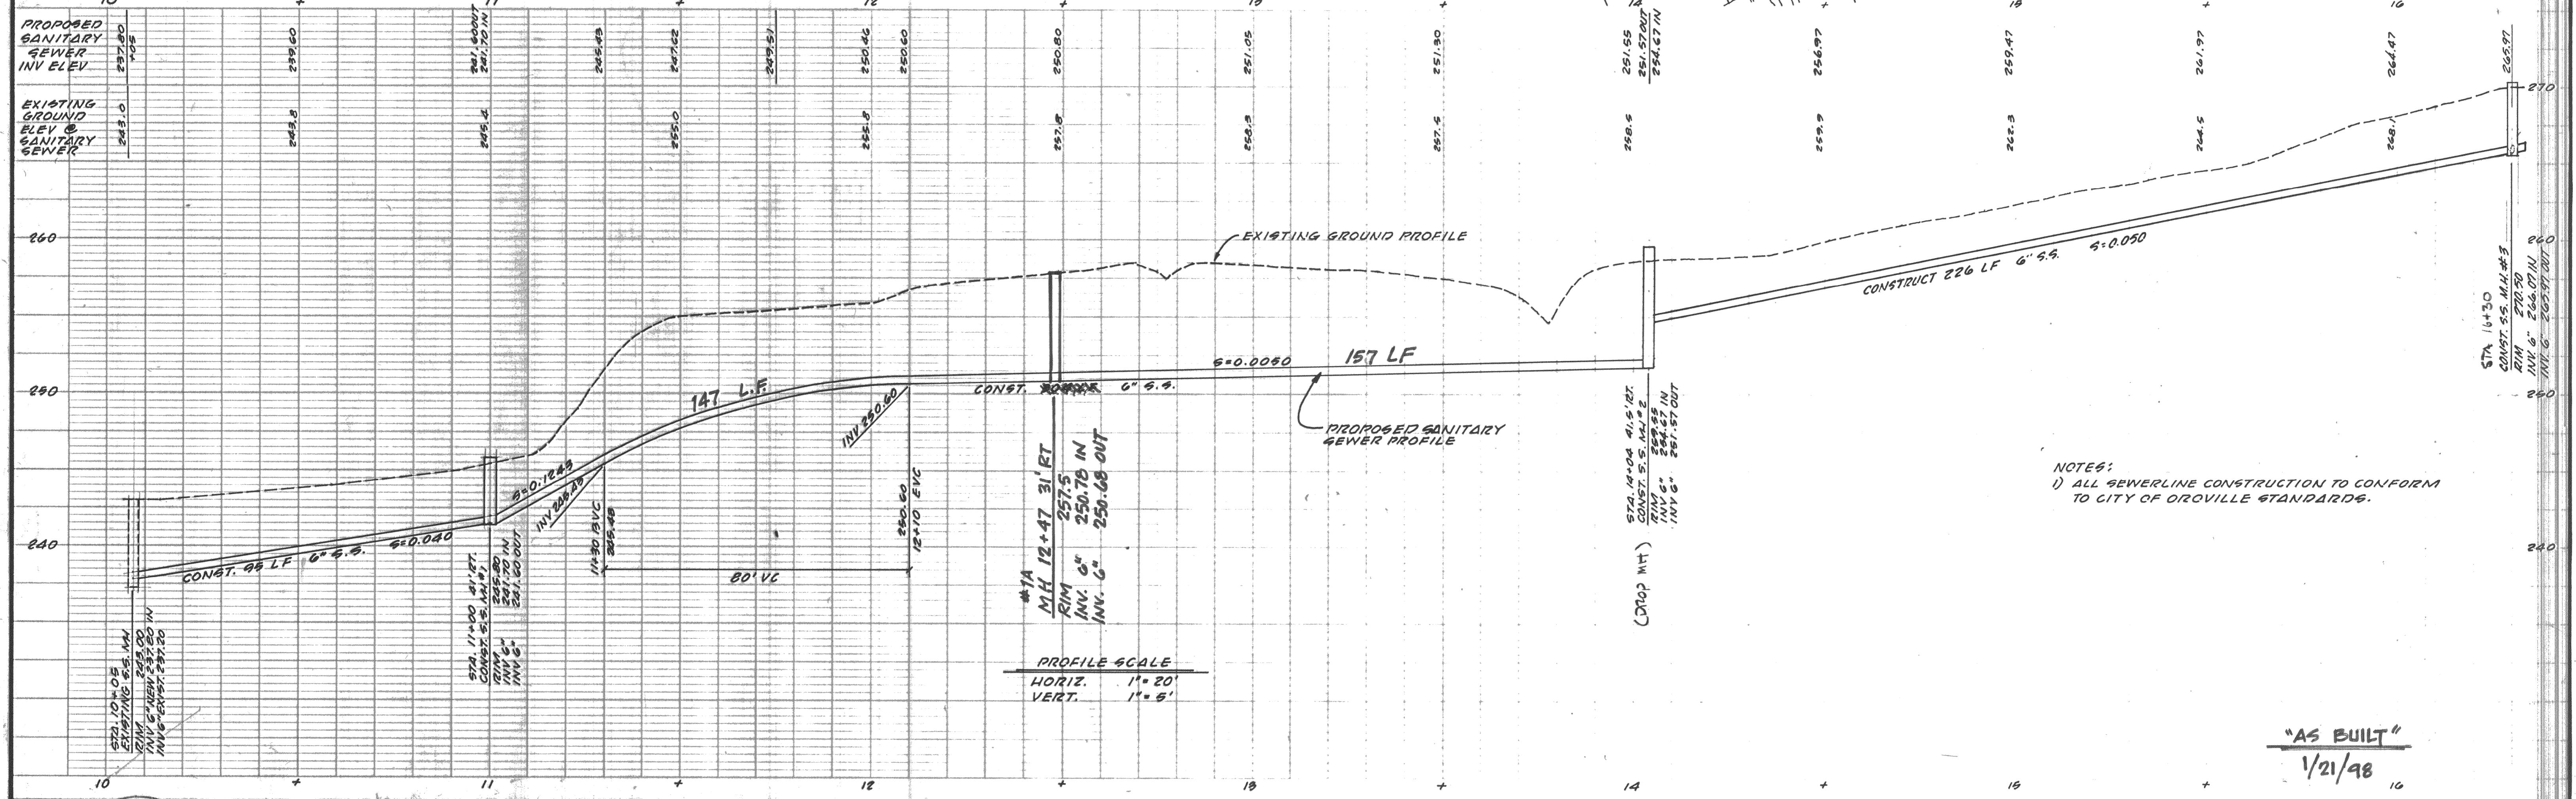


TYPICAL TRENCH SECTION

* AT CHURCH DRIVEWAY CROSSING FINAL BACKFILL TO BE 3/4" AB TO 95% R.D.

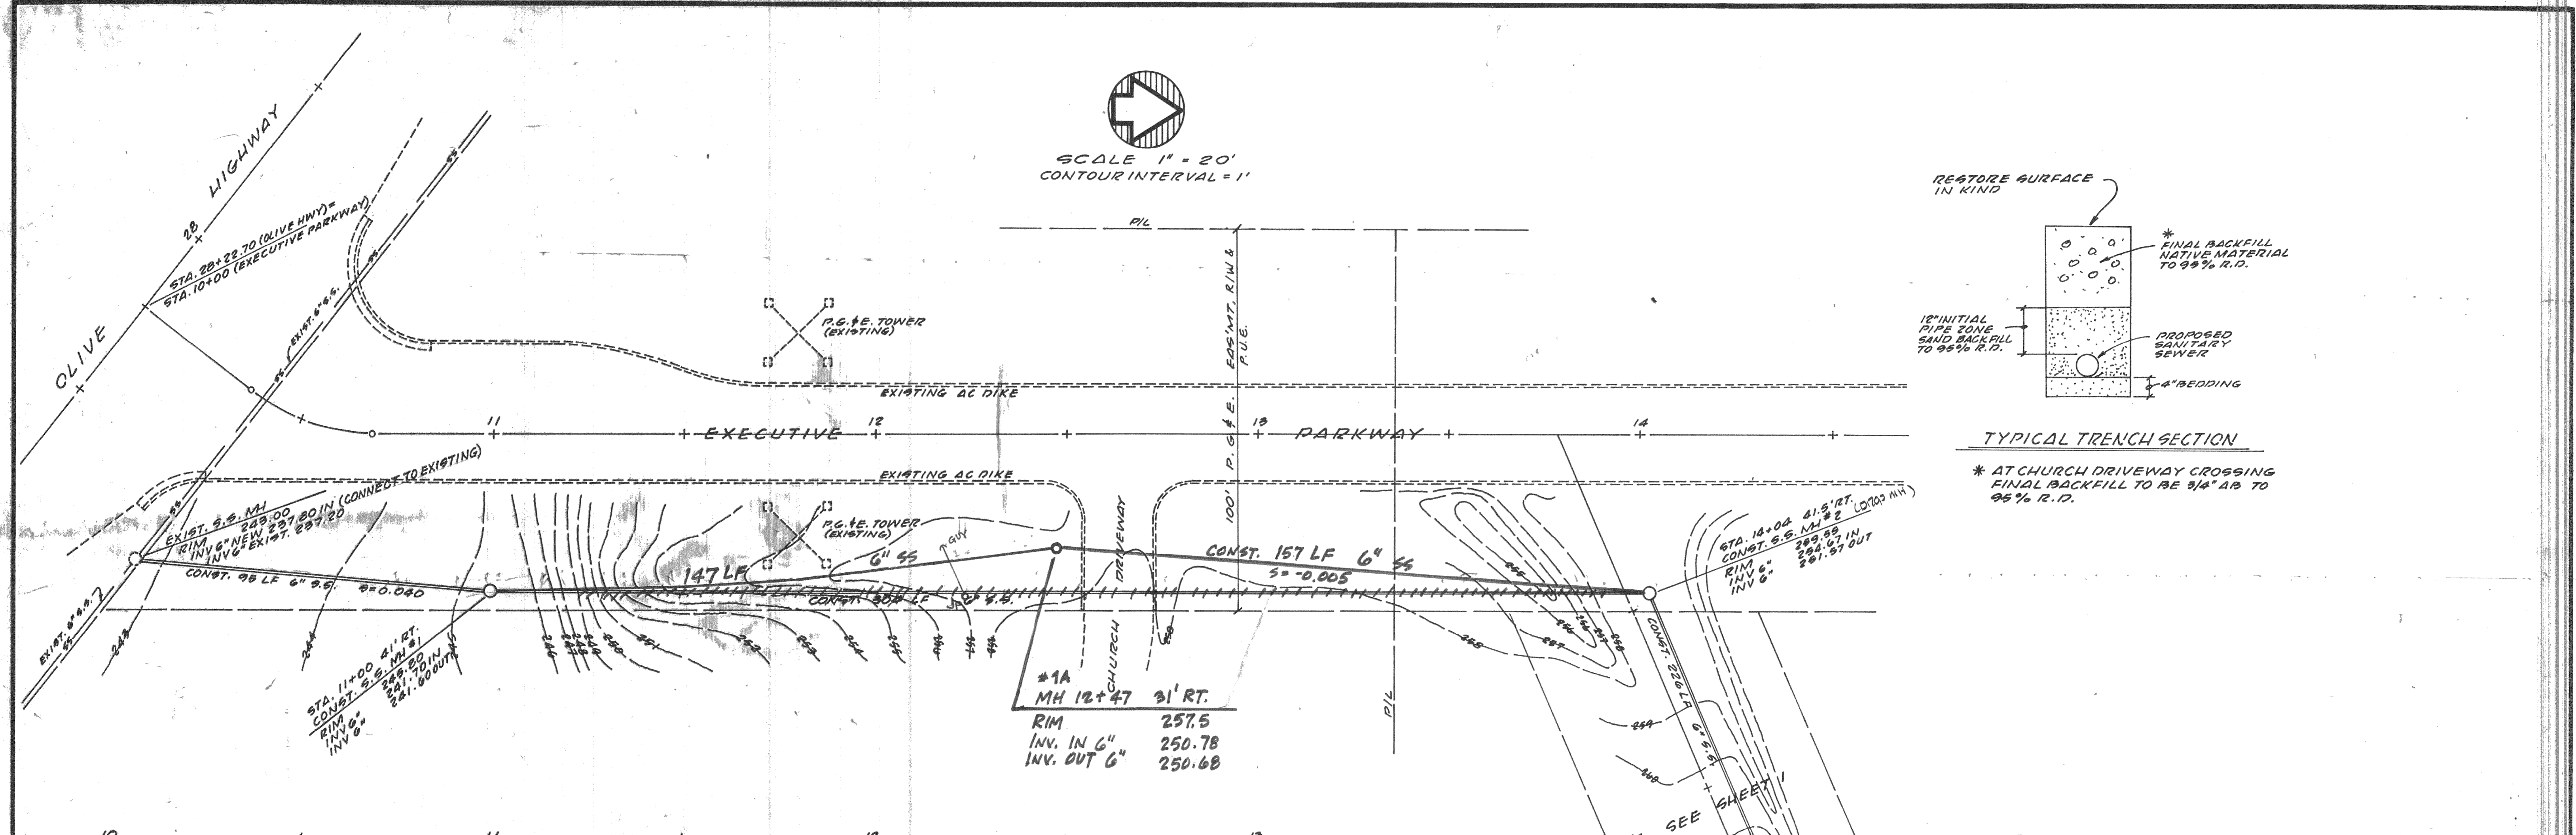

NOTE:
1) ALL SEWERLINE CONSTRUCTION TO CONFORM TO CITY OF GROVILLE STANDARDS.

"AS BUILT"
1/21/98

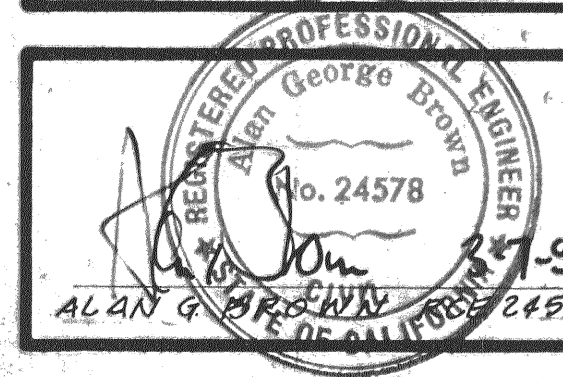

DATE	REVISION	BY	APP'D
2/7/88	CHANGE 0.5 LINE BETWEEN M.H. #2 & M.H. #3	W.F. A.G.B.	
3/18/88	IDENTIFY R/W & R.U.E.	DER. A.G.B.	

FIELD BOOK	DESIGNED LANE
ELEVATION DATUM	CHECKED A.G.B.
SCALE AS SHOWN	APPROVED

APPROVED: *W.F. A.G.B.* DATE: 2/4/88

Barnhart Brown & Associates
A CALIFORNIA CORPORATION
P.O. Box 1576, Oroville, CA 95965, 916.534.1911
CIVIL ENGINEERS • LAND SURVEYORS

SANITARY SEWER PLAN FOR GROVILLE EXECUTIVE PARK PHASE I
SHEET 2 OF 2
CITY OF GROVILLE, CA. JOB NO. 87052
DATE: 1/21/98