


PLAN
 DRAWING NO. _____
 DATE _____
 BY _____
 CHECKED _____
 DATE _____
 NO. _____

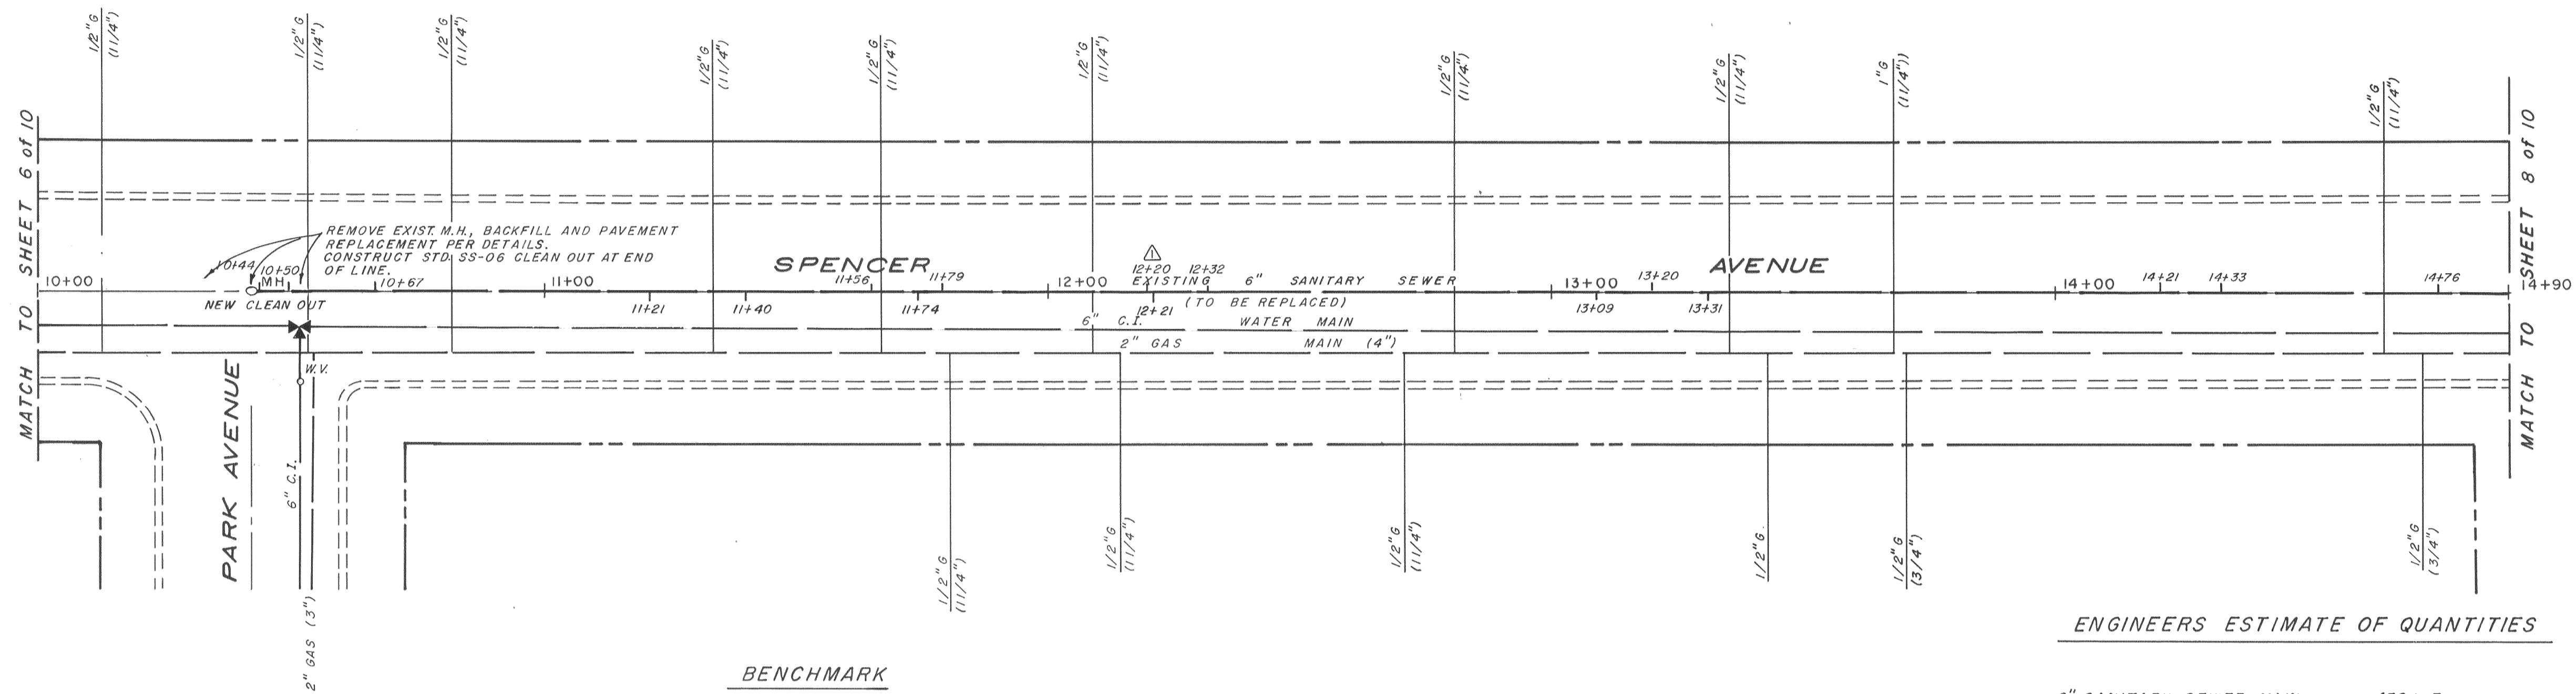


BENCHMARK
 TOP OF FIRE HYDRANT IN THE N.E. CORNER
 OF SPENCER AVE & ORO AVE
 ELEV. 212.51

ENGINEERS ESTIMATE OF QUANTITIES

6" SANITARY SEWER MAIN	470 L.F.
SS-01 SERVICE CONNECTIONS	17 EA
SS-06 CLEAN OUT	2 EA
PAVEMENT REPLACEMENT	2580 S.F.
REMOVE ABANDONED MANHOLE	1 EA

SCALE
 HORIZ. 1" = 20'
 VERT. 1" = 2'

PROFILE
 DRAWING NO. _____
 DATE _____
 BY _____
 CHECKED _____
 DATE _____
 NO. _____

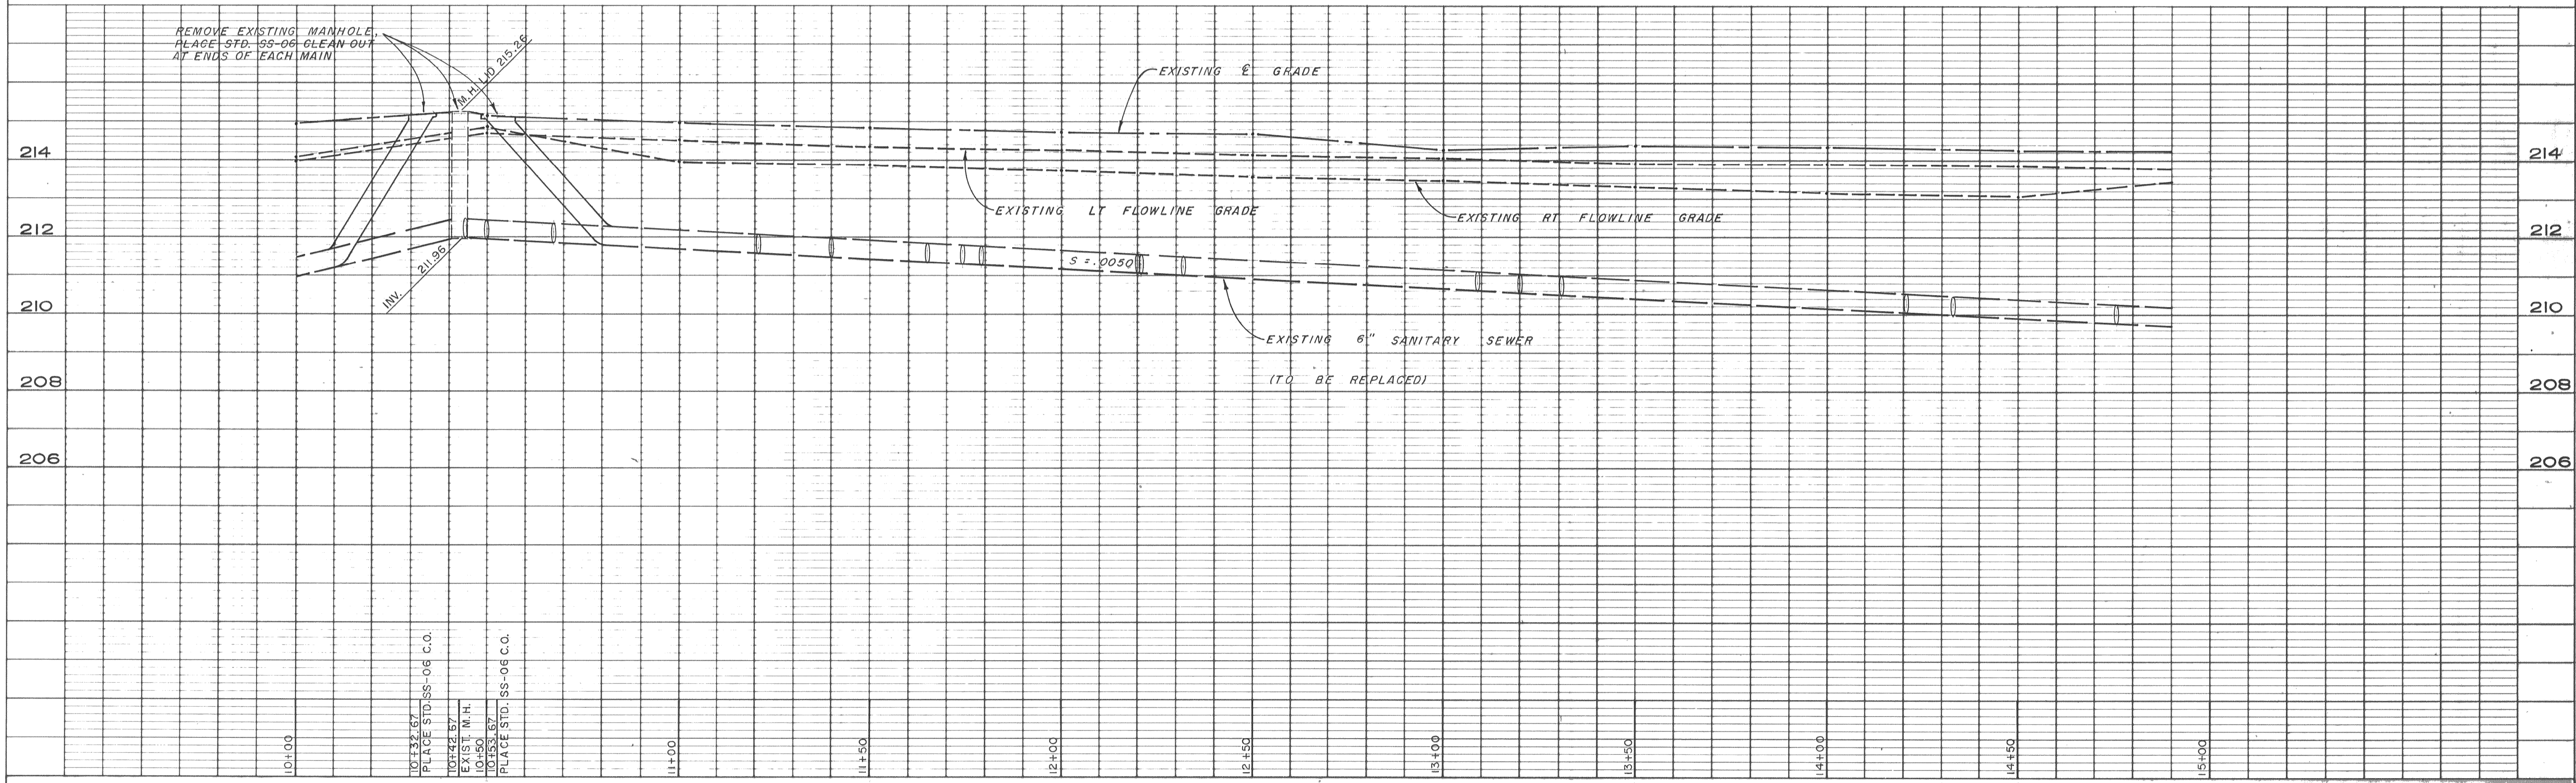

REMOVE EXISTING MANHOLE,
 PLACE STD. SS-06 CLEAN OUT
 AT ENDS OF EACH MAIN

10+00
 10+32.67
 PLACE STD. SS-06 C.O.
 10+44.57
 EXIST. M.H.
 10+50
 21.95
 PLACE STD. SS-06 C.O.
 11+00
 11+50
 12+00
 12+50
 13+00
 13+50
 14+00
 14+50
 15+00

5-15-92	▲	SANITARY SEWER STUB LOCATION	T.F.	J.J.	FIELD BOOK	DRAWN T.F.	APPROVED			CITY OF OROVILLE PUBLIC WORKS DEPARTMENT 1675 MONTGOMERY ST. OROVILLE, CA 95965 (916) 538-2420	SANITARY SEWER REPLACEMENT PROJECT SPENCER AVENUE	AS-BUILT SHEET 7 OF 10 SHEETS JOB NO.
					ELEVATION DATUM	DESIGNED J.J.						
						CHECKED J.J.						
						SCALE						
DATE NO.		REVISION		BY	APP'D		DIRECTOR PUBLIC WORKS	DATE				