
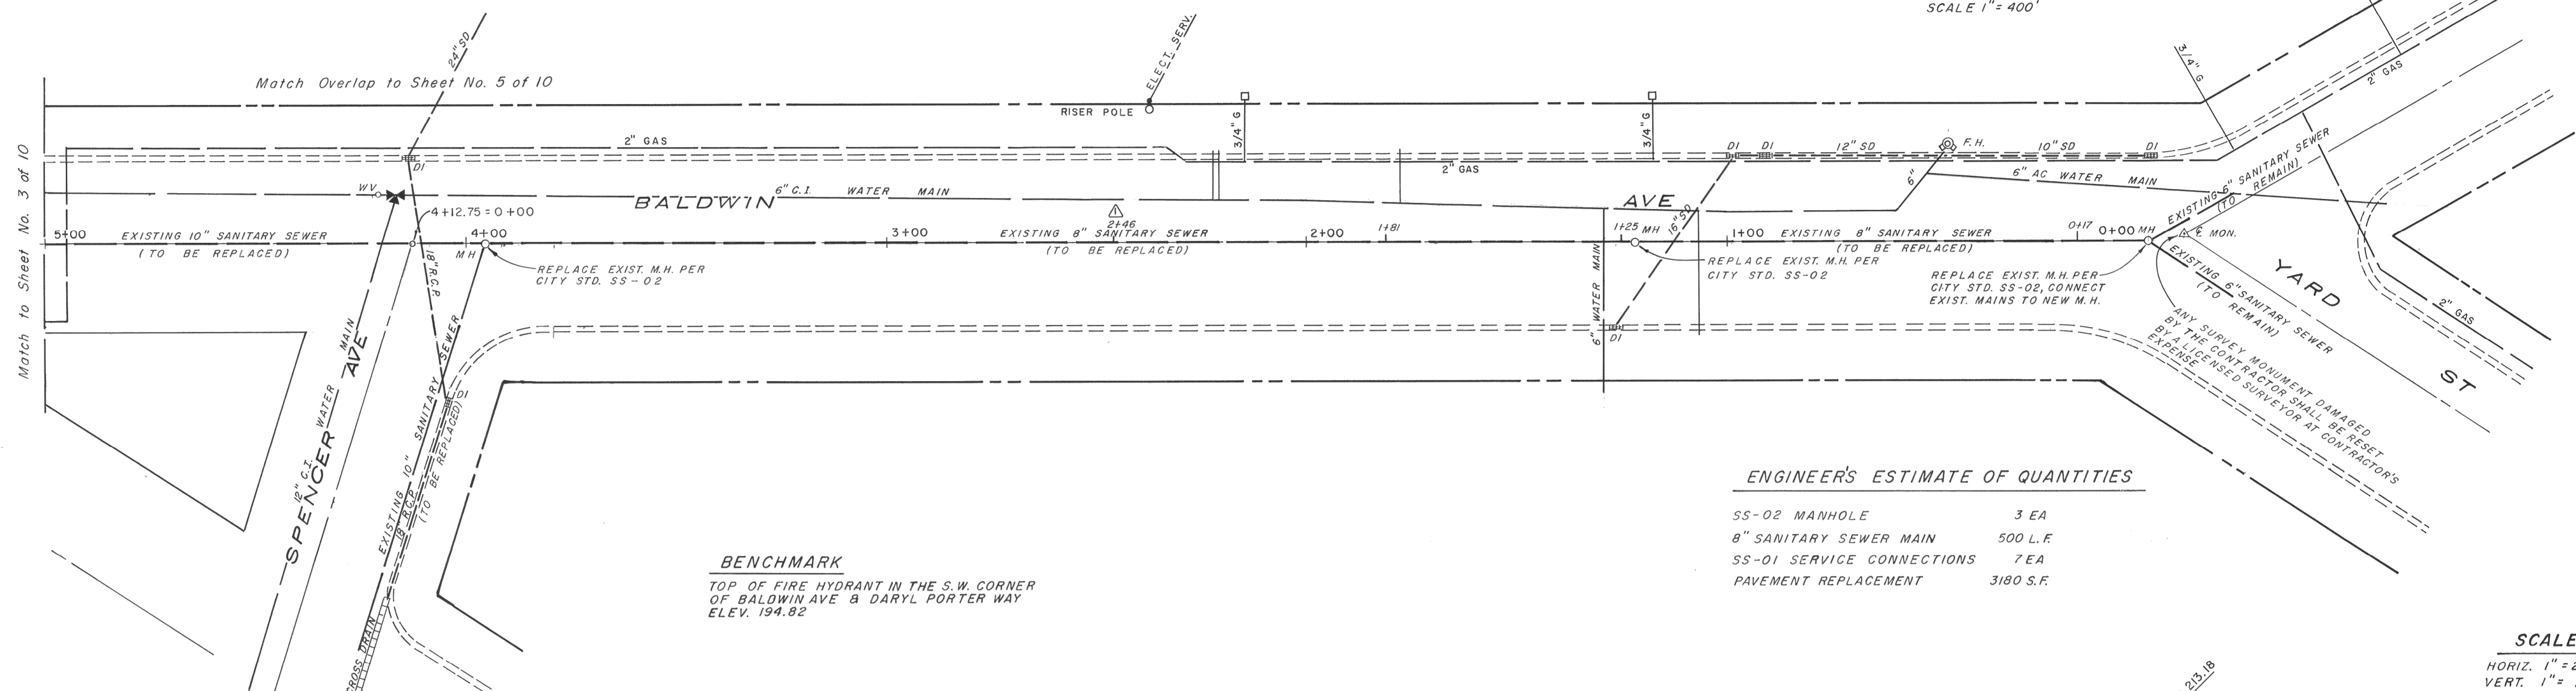


PLAN
 DATE: _____ BY: _____
 SUBMITTED: _____
 NOTE BOOK: _____
 CHANGES CHECKED: _____
 ALIGNMENT CHECKED: _____
 PT. OF WAY CHECKED: _____
 No. _____


PROFILE
 DATE: _____ BY: _____
 SUBMITTED: _____
 NOTE BOOK: _____
 CHANGES CHECKED: _____
 GRADES CHECKED: _____
 B.M.'S NOTED: _____
 STRUCTURE NOTATIONS CHECKED: _____
 No. _____

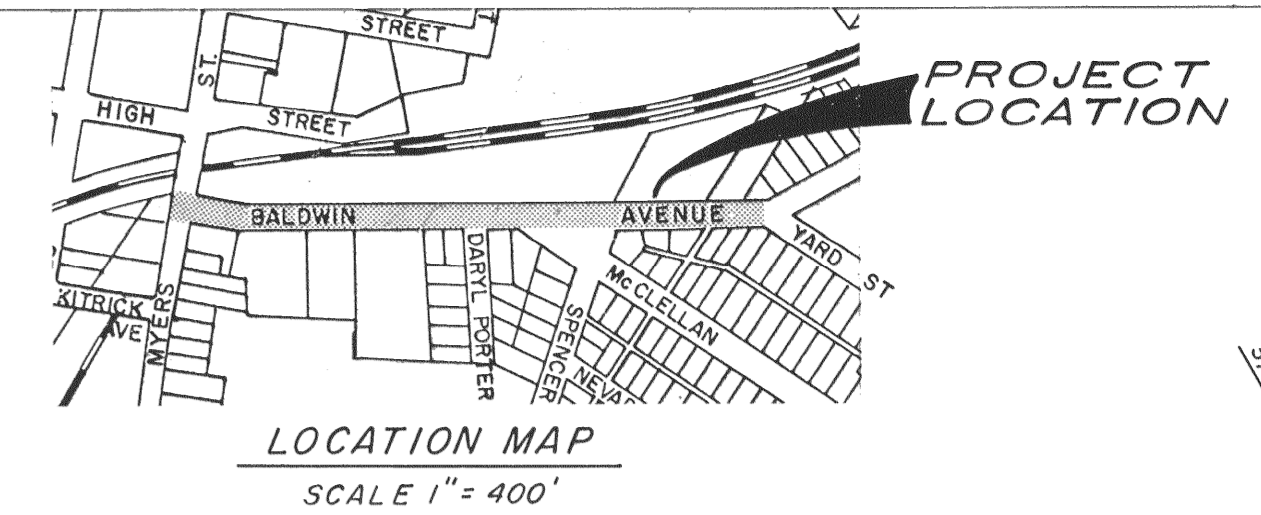

ENGINEER'S ESTIMATE OF QUANTITIES

SS-02 MANHOLE	3 EA
8" SANITARY SEWER MAIN	500 L.F.
SS-01 SERVICE CONNECTIONS	7 EA
PAVEMENT REPLACEMENT	3180 S.F.

SCALE
 HORIZ. 1" = 20'
 VERT. 1" = 2'

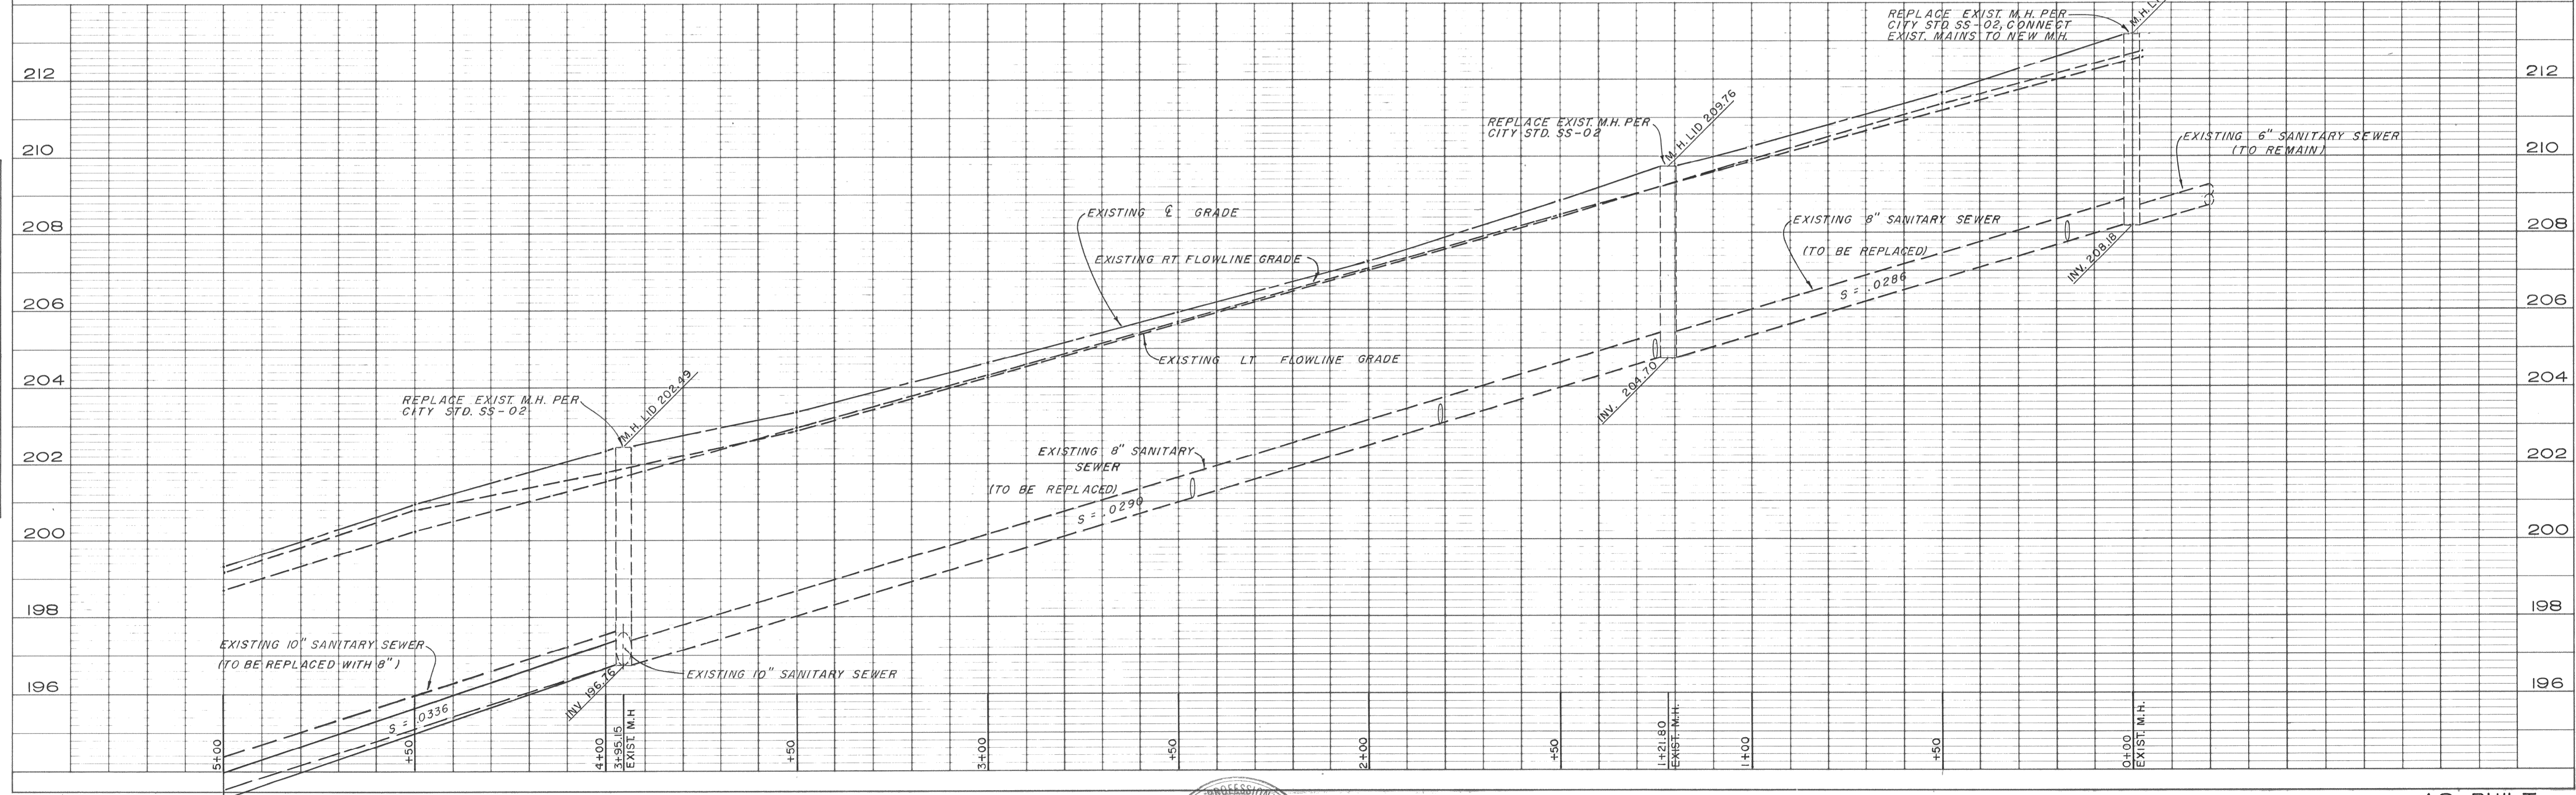

5-15-92 DATE NO.	SANITARY SEWER STUB LOCATION REVISION	T.F. J.J. BY APP'D	FIELD BOOK ELEVATION DATUM	DRAWN T.F. DESIGNED J.J. CHECKED J.J. SCALE	APPROVED Mike Grimes DIRECTOR PUBLIC WORKS	CITY OF OROVILLE PUBLIC WORKS DEPARTMENT 1675 MONTGOMERY ST. OROVILLE, CA 95965 (916) 538-2420	AS-BUILT SHEET 2 OF 10 SHEETS JOB NO. SS-337
---------------------	------------------------------------------	-----------------------	-------------------------------	---------------------------------------------------------------	------------------------------------------------------	------------------------------------------------------------------------------------------------------------	----------------------------------------------------------