

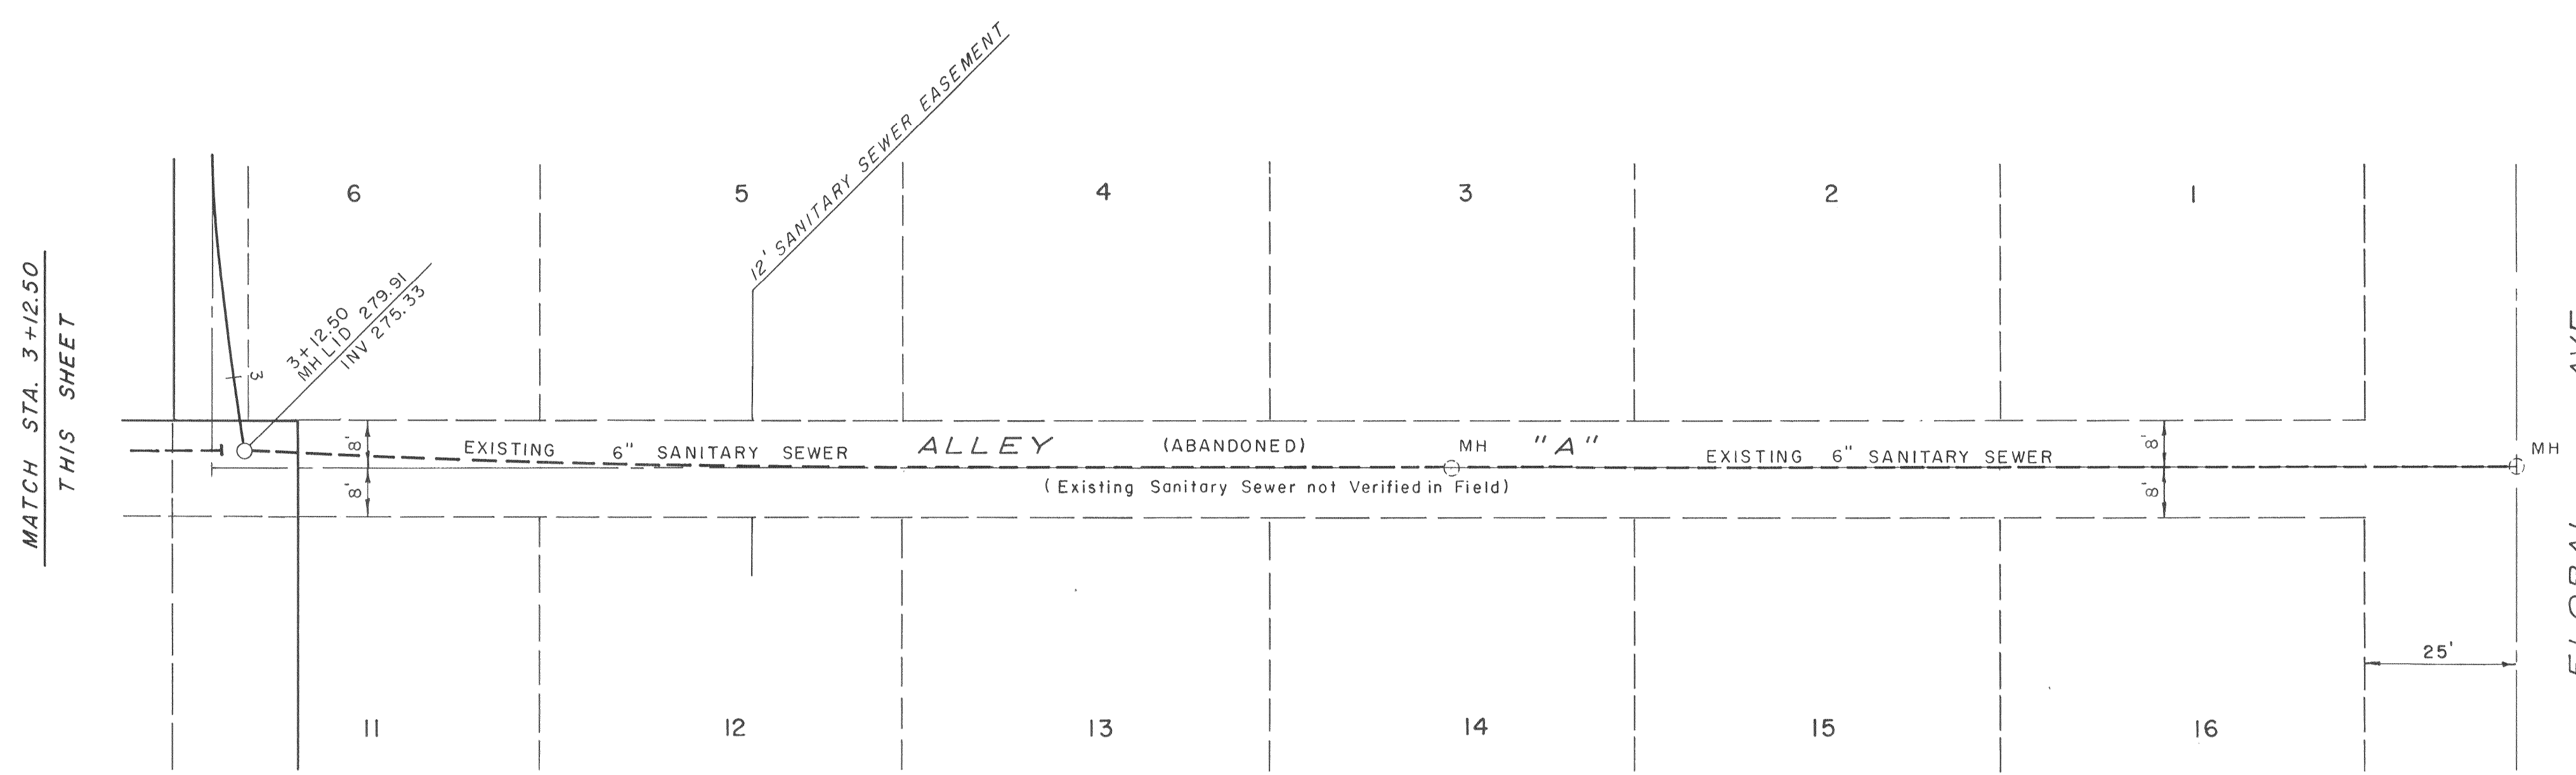
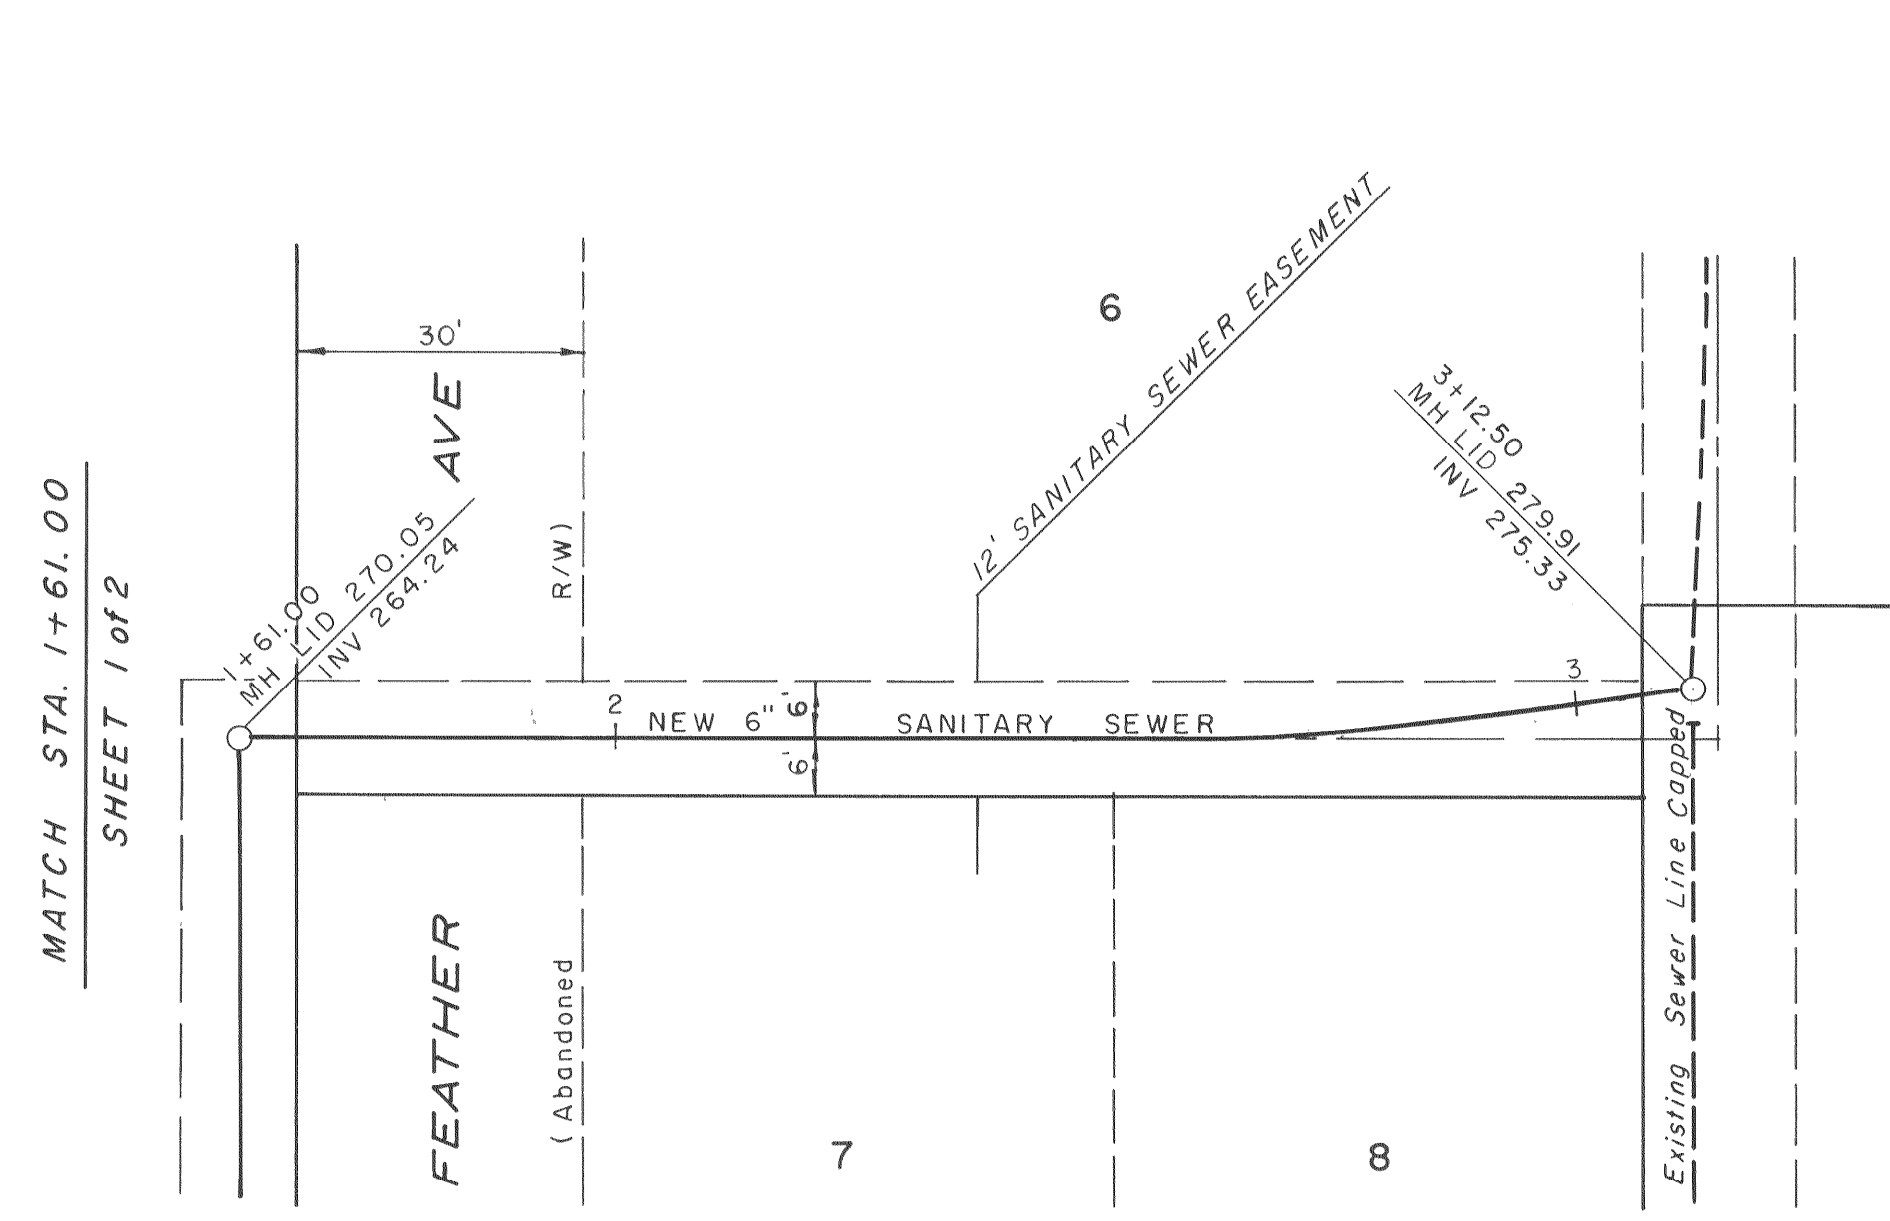


PLAN SURVEYED, PLOTTED, & CHECKED BY: [] DATE: []
 NOTE BOOK NO. []
 STRUCTURE NOTATIONS CHECKED []

PROFILE SURVEYED, PLOTTED, & CHECKED BY: [] DATE: []
 NOTE BOOK NO. []
 STRUCTURE NOTATIONS CHECKED []

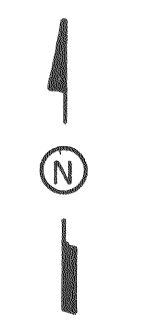

SCALE
 HORZ - 1" = 20'
 VERT - 1" = 2'

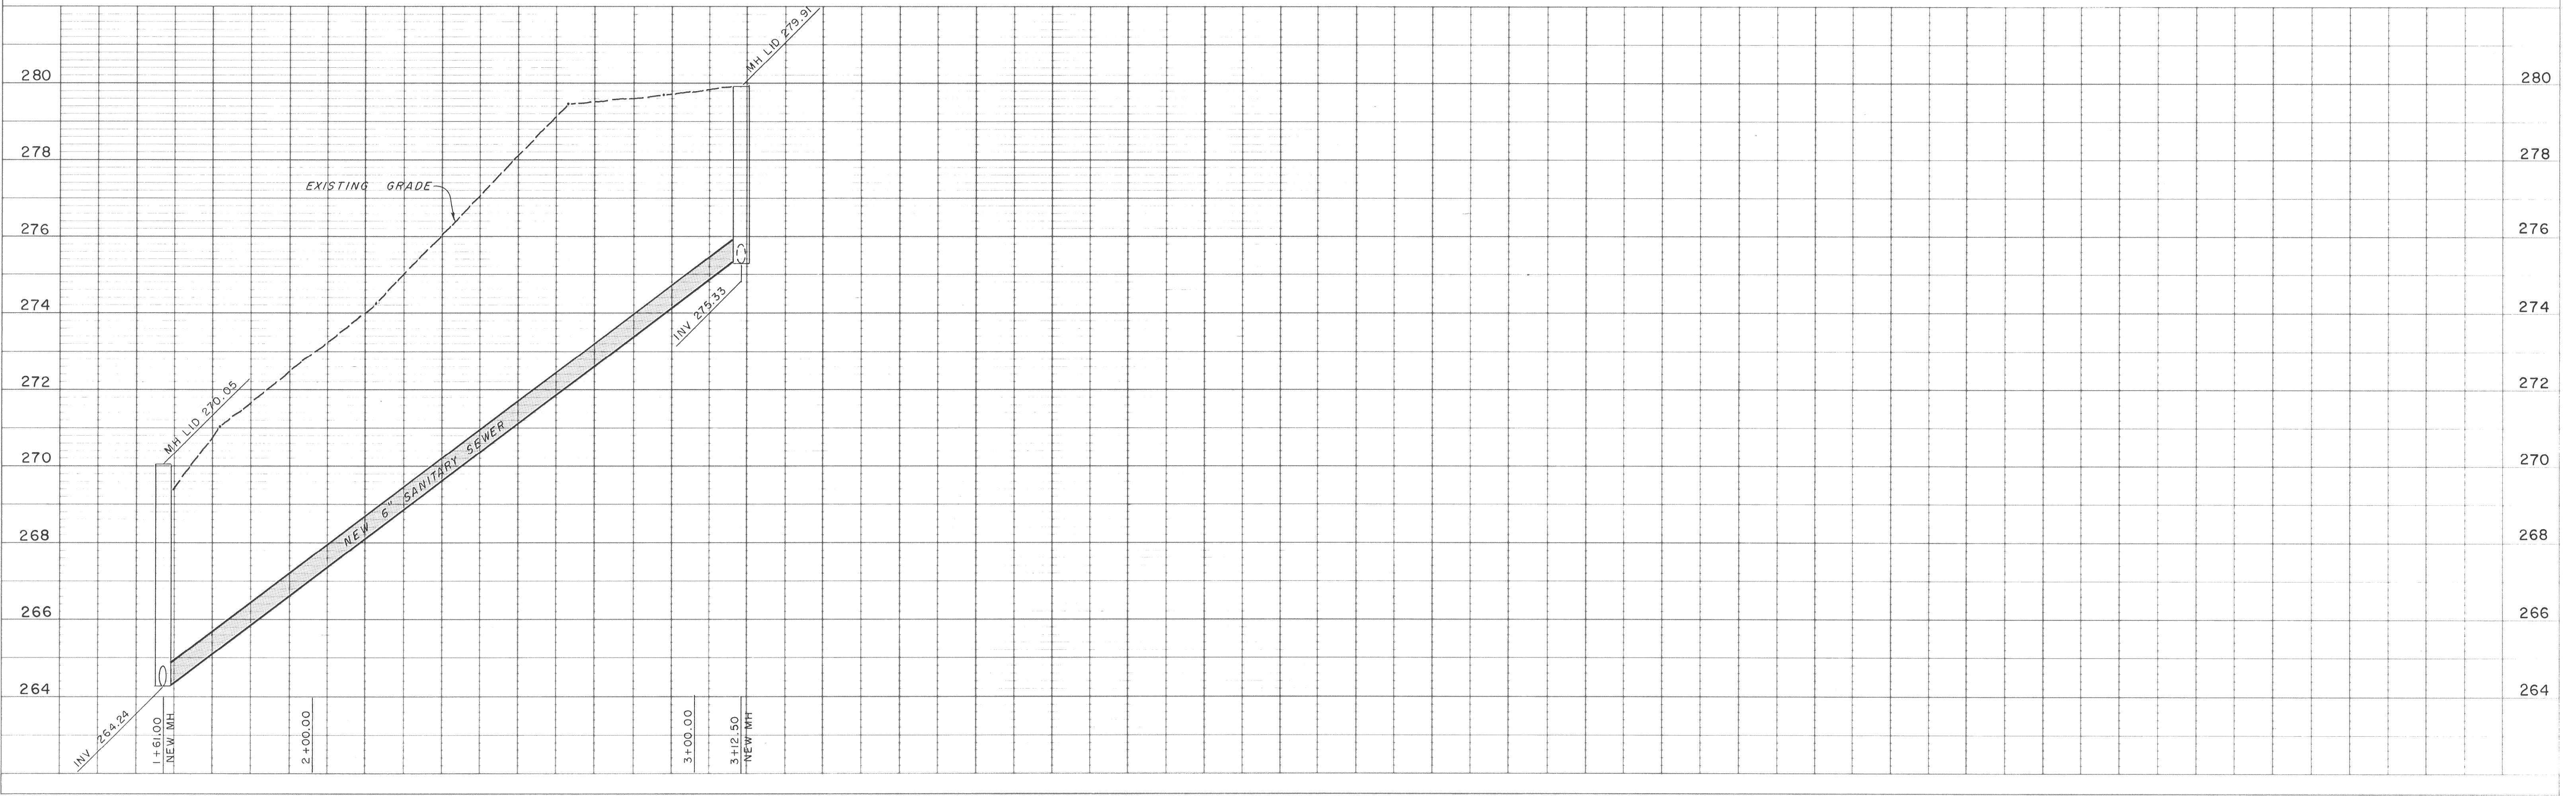

DATE NO.	REVISION	BY	APP'D

FIELD BOOK	DRAWN
ELEVATION DATUM	T.F.
	DESIGNED
	J.J.
	CHECKED
	J.J.
	SCALE

APPROVED	DATE
DIRECTOR PUBLIC WORKS R.C.E. 41977	

CITY OF OROVILLE, CALIFORNIA
 PUBLIC WORKS DEPARTMENT
 1675 MONTGOMERY ST. OROVILLE, CA 95965 (916) 538-2420

" AS BUILT "
IMPROVEMENT PLANS
 SANITARY SEWER EXTENSION
 STA 1+61.00 TO STA 3+12.50