




PLAN
 SURVEYED...
 NOTE BOOK...
 No.

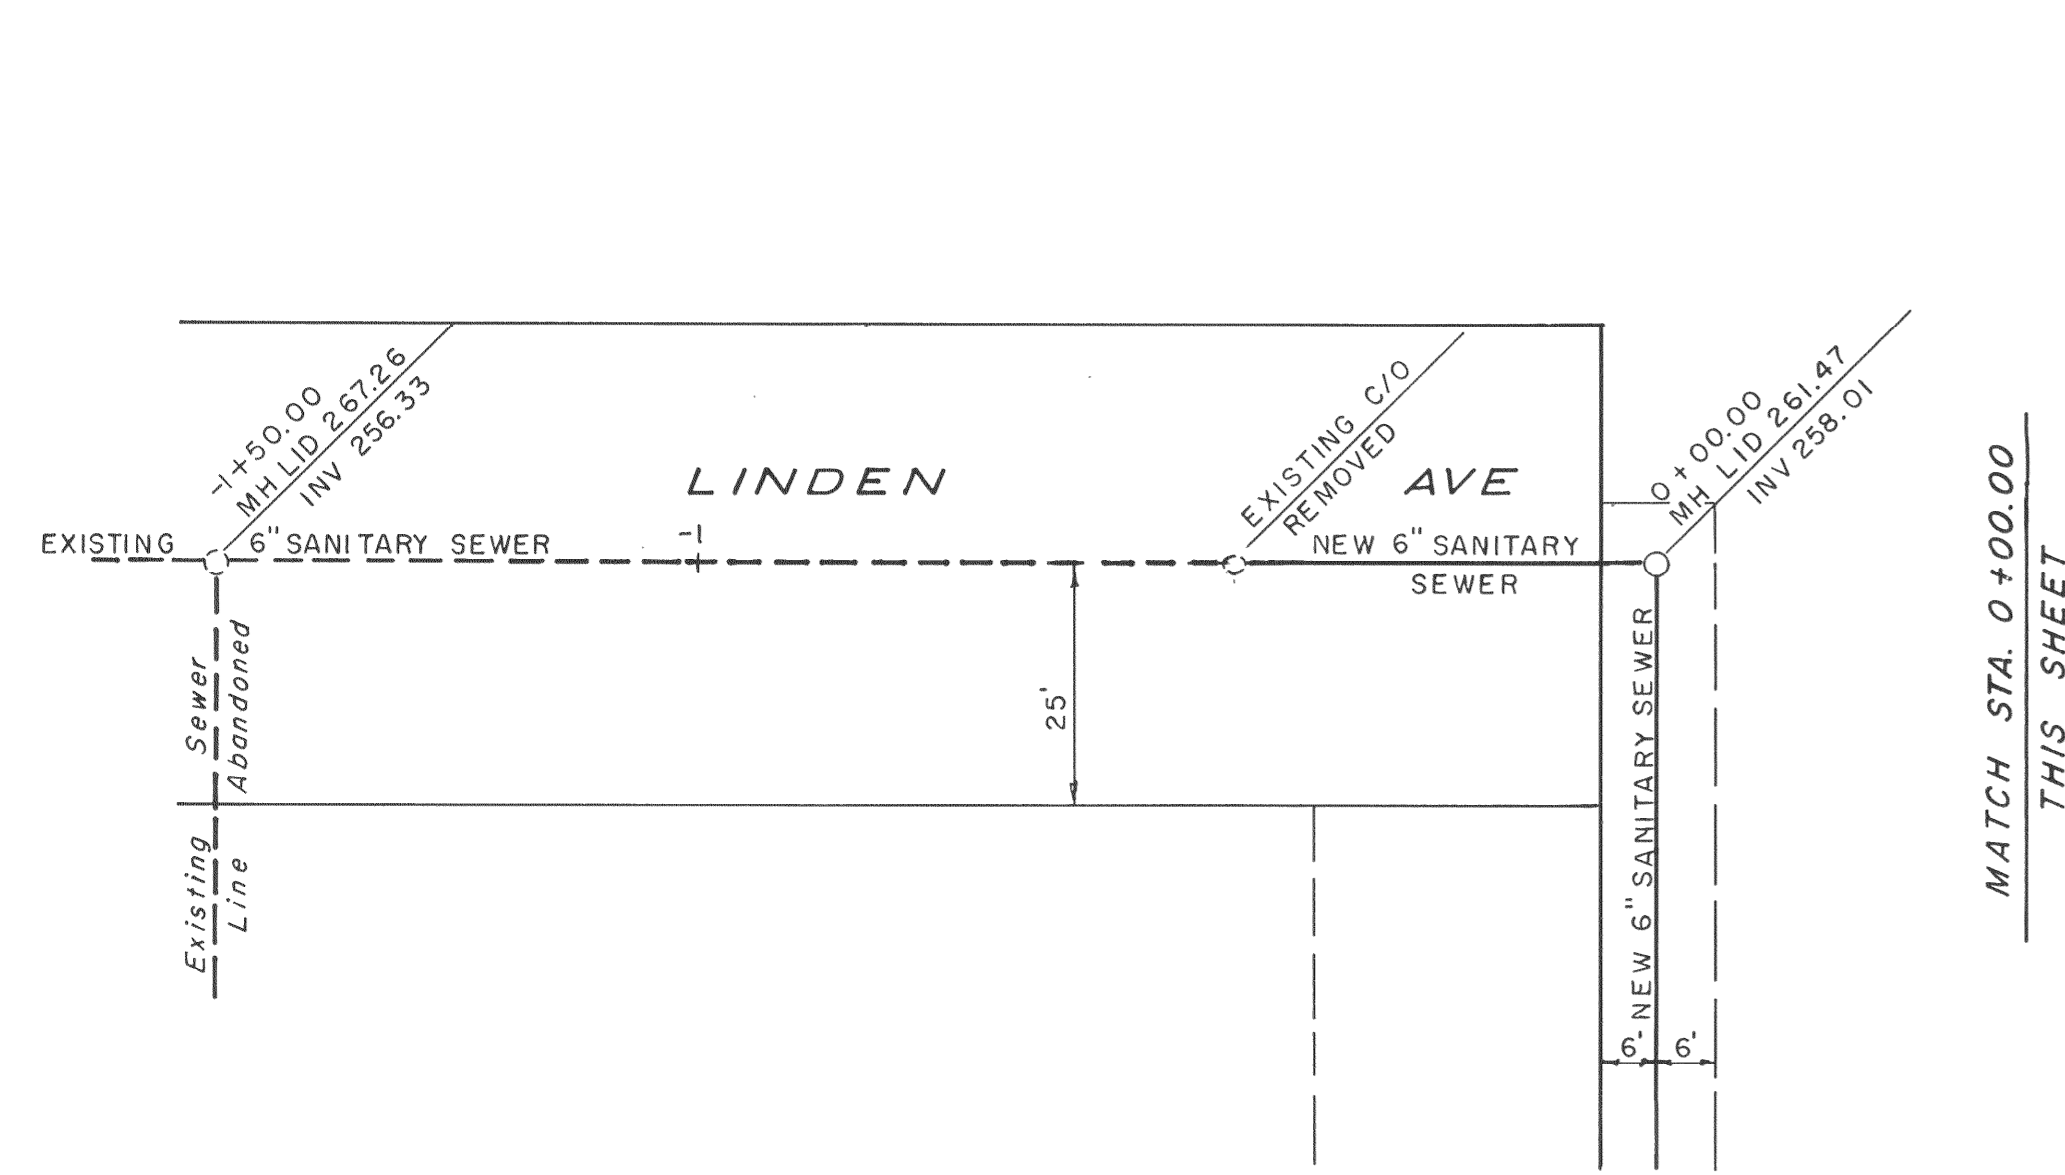

MATCH STA. 0+00.00
 THIS SHEET

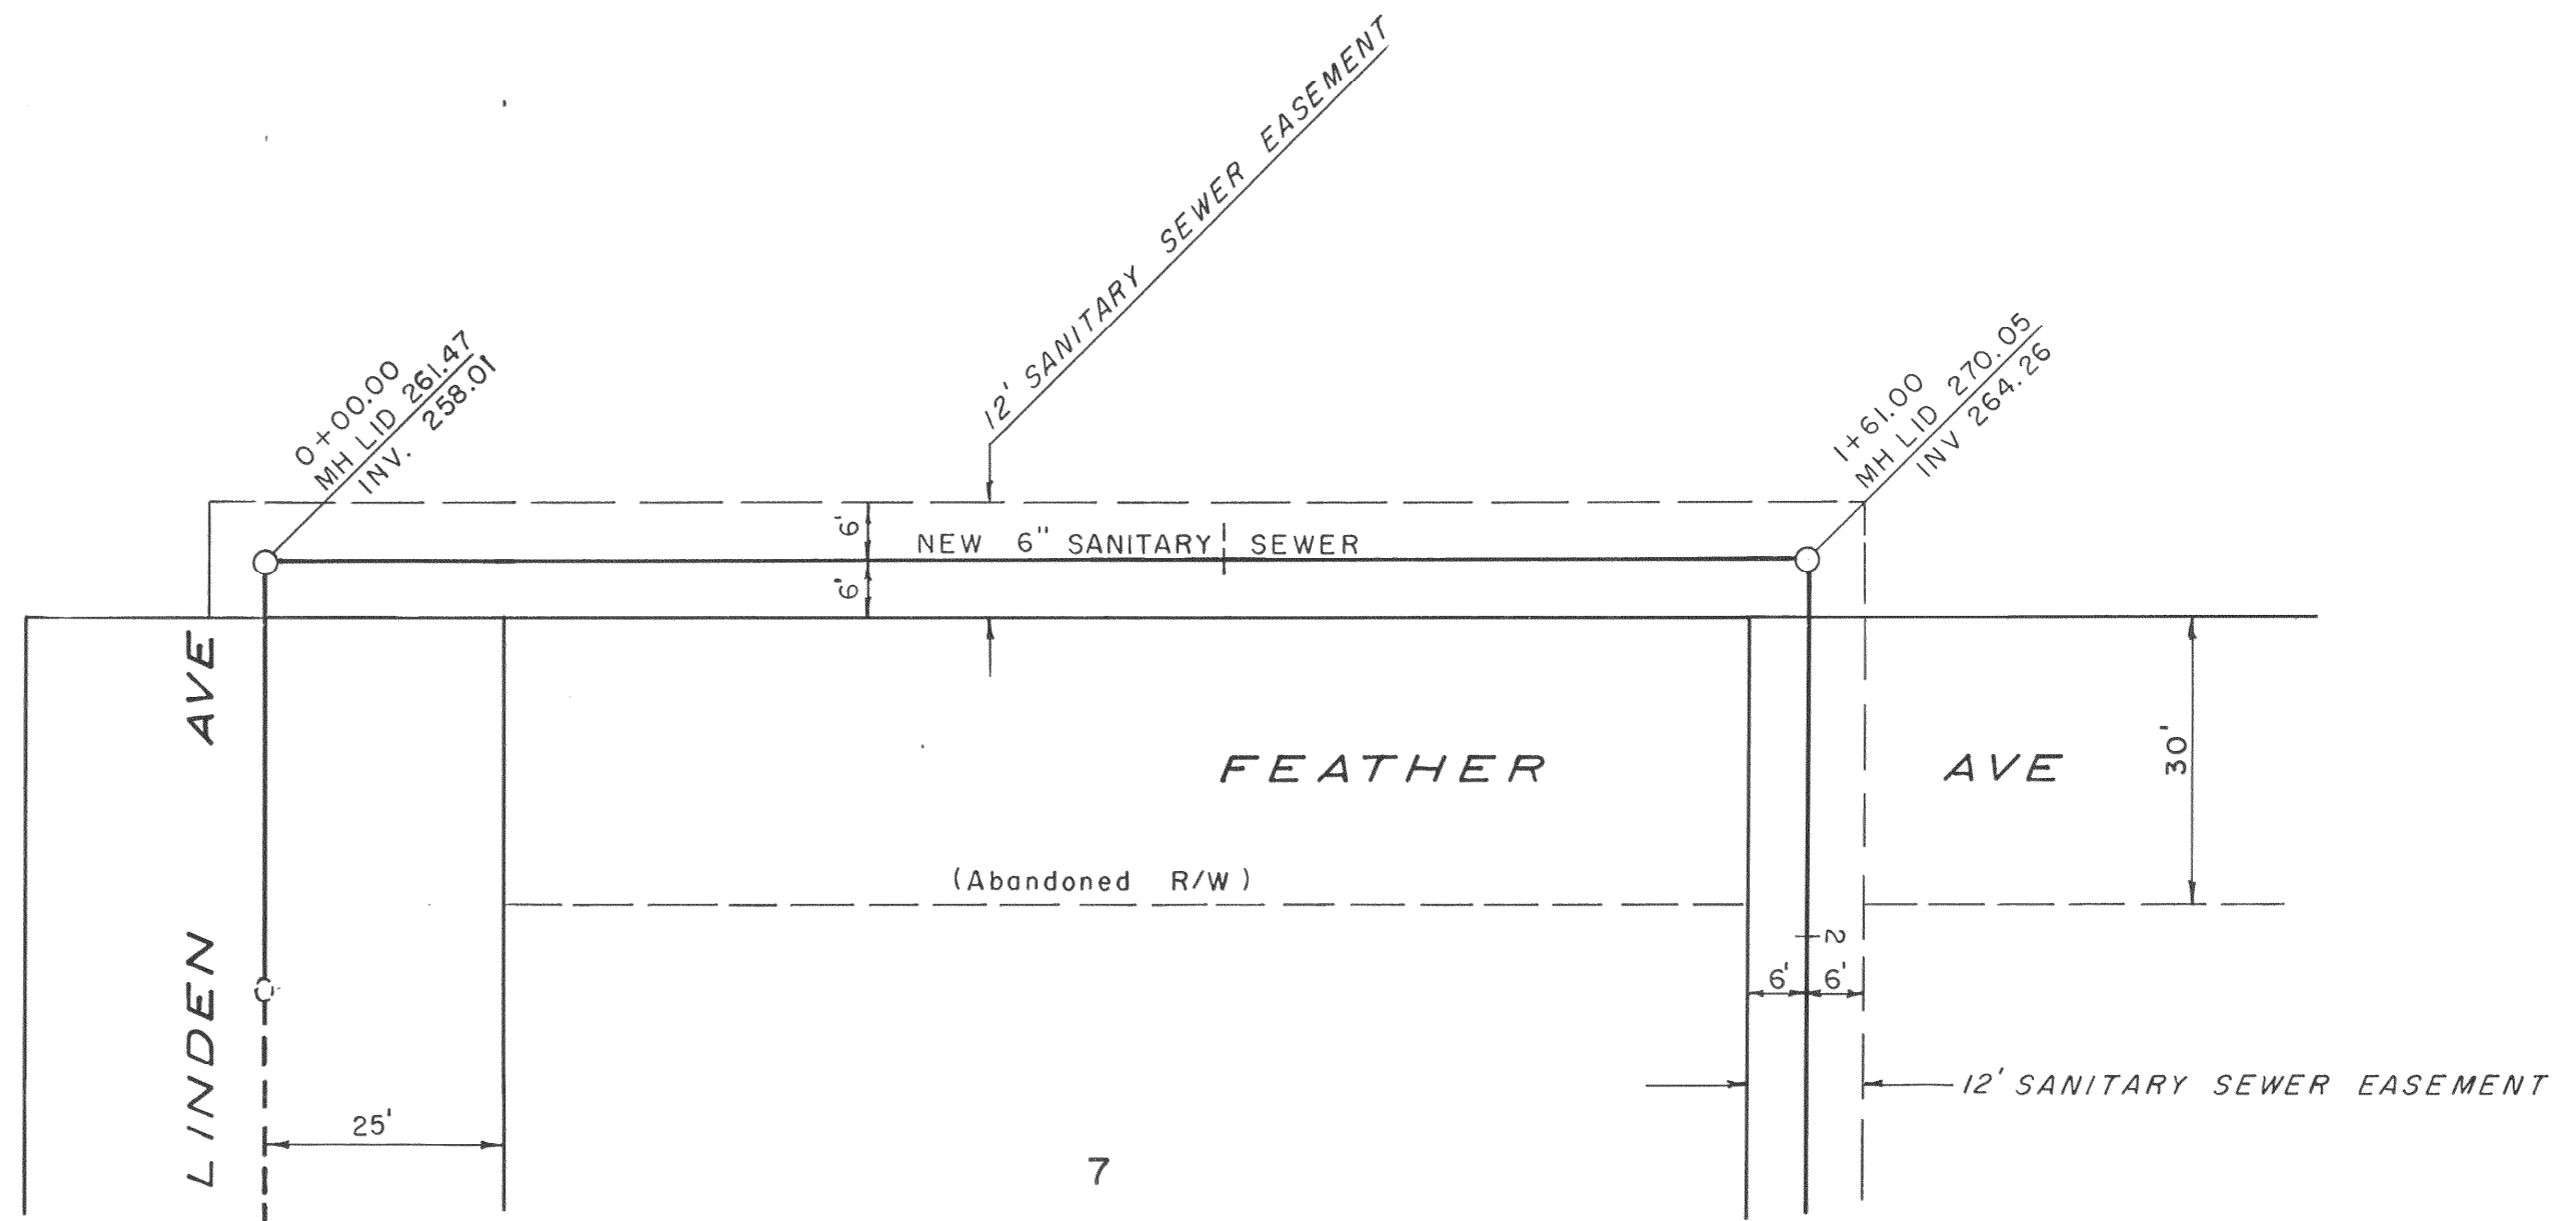


MATCH STA. 1+61.00
 SHEET 2 of 2

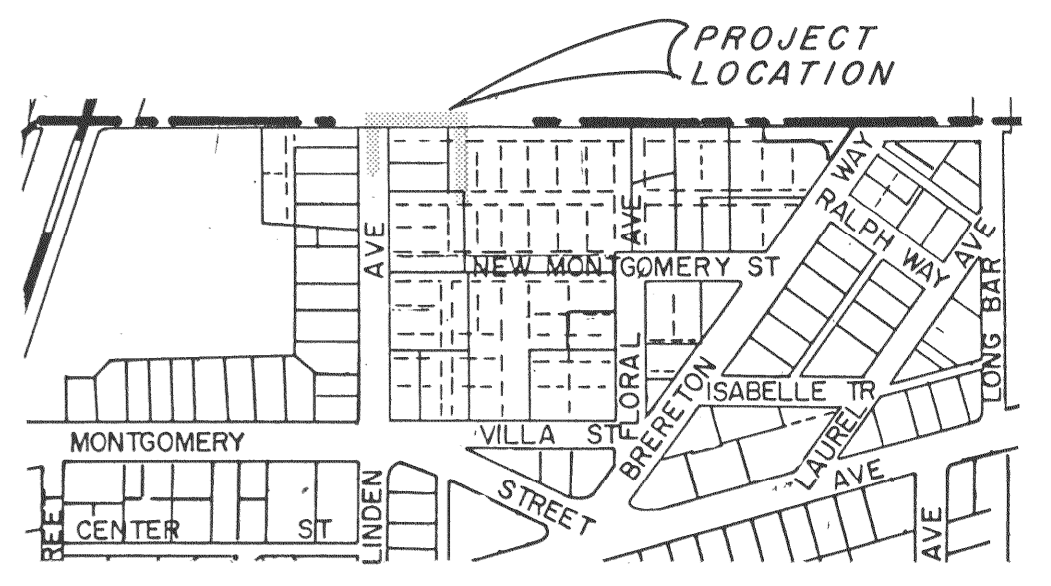

BENCHMARK
 R.R. SPIKE IN JP IN THE
 SW CORNER OF MONTGOMERY
 STREET & LINDEN AVE
 ELEV. 262.53

SCALE
 HORZ - 1"=20'
 VERT - 1"=2'

PROFILE
 SURVEYED...
 NOTE BOOK...
 No.

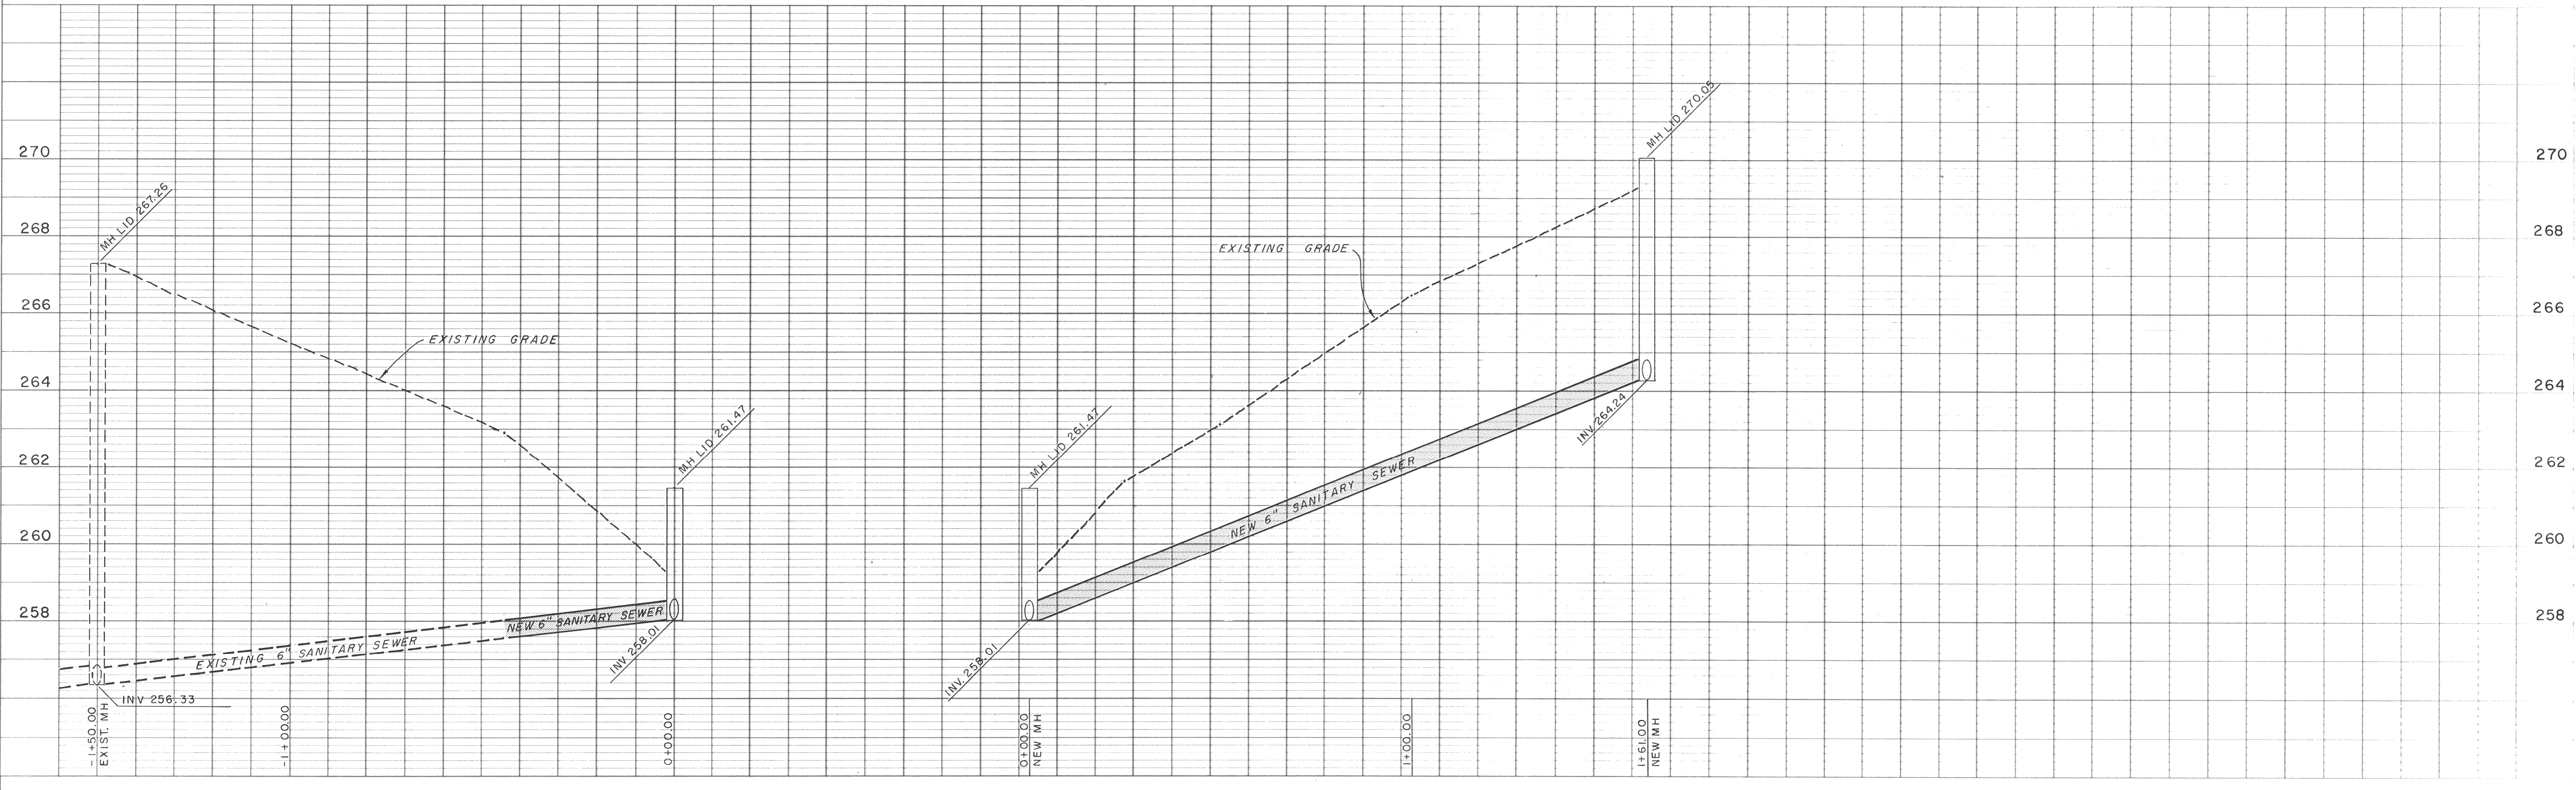

DATE NO.	REVISION	BY	APP'D

FIELD BOOK
 ELEVATION DATUM

DRAWN
 T.F.
 DESIGNED
 J.J.
 CHECKED
 J.J.
 SCALE

APPROVED

DIRECTOR PUBLIC WORKS R.C.E. 41977 DATE

CITY OF OROVILLE
 PUBLIC WORKS DEPARTMENT
 1675 MONTGOMERY ST.
 OROVILLE, CA 95965 (916) 538-2420

"AS BUILT"
IMPROVEMENT PLANS
 SANITARY SEWER EXTENSION
 STA-0+44.00 TO STA 1+61.00

SHEET
 1 OF 2
 SS-333