


PLAN
 SUBMITTED BY DATE
 NOTED BY DATE
 NOTE BOOK, PLOTTED
 NO. ALIGNMENT CHECKED
 NO. FT. OF WAY CHECKED

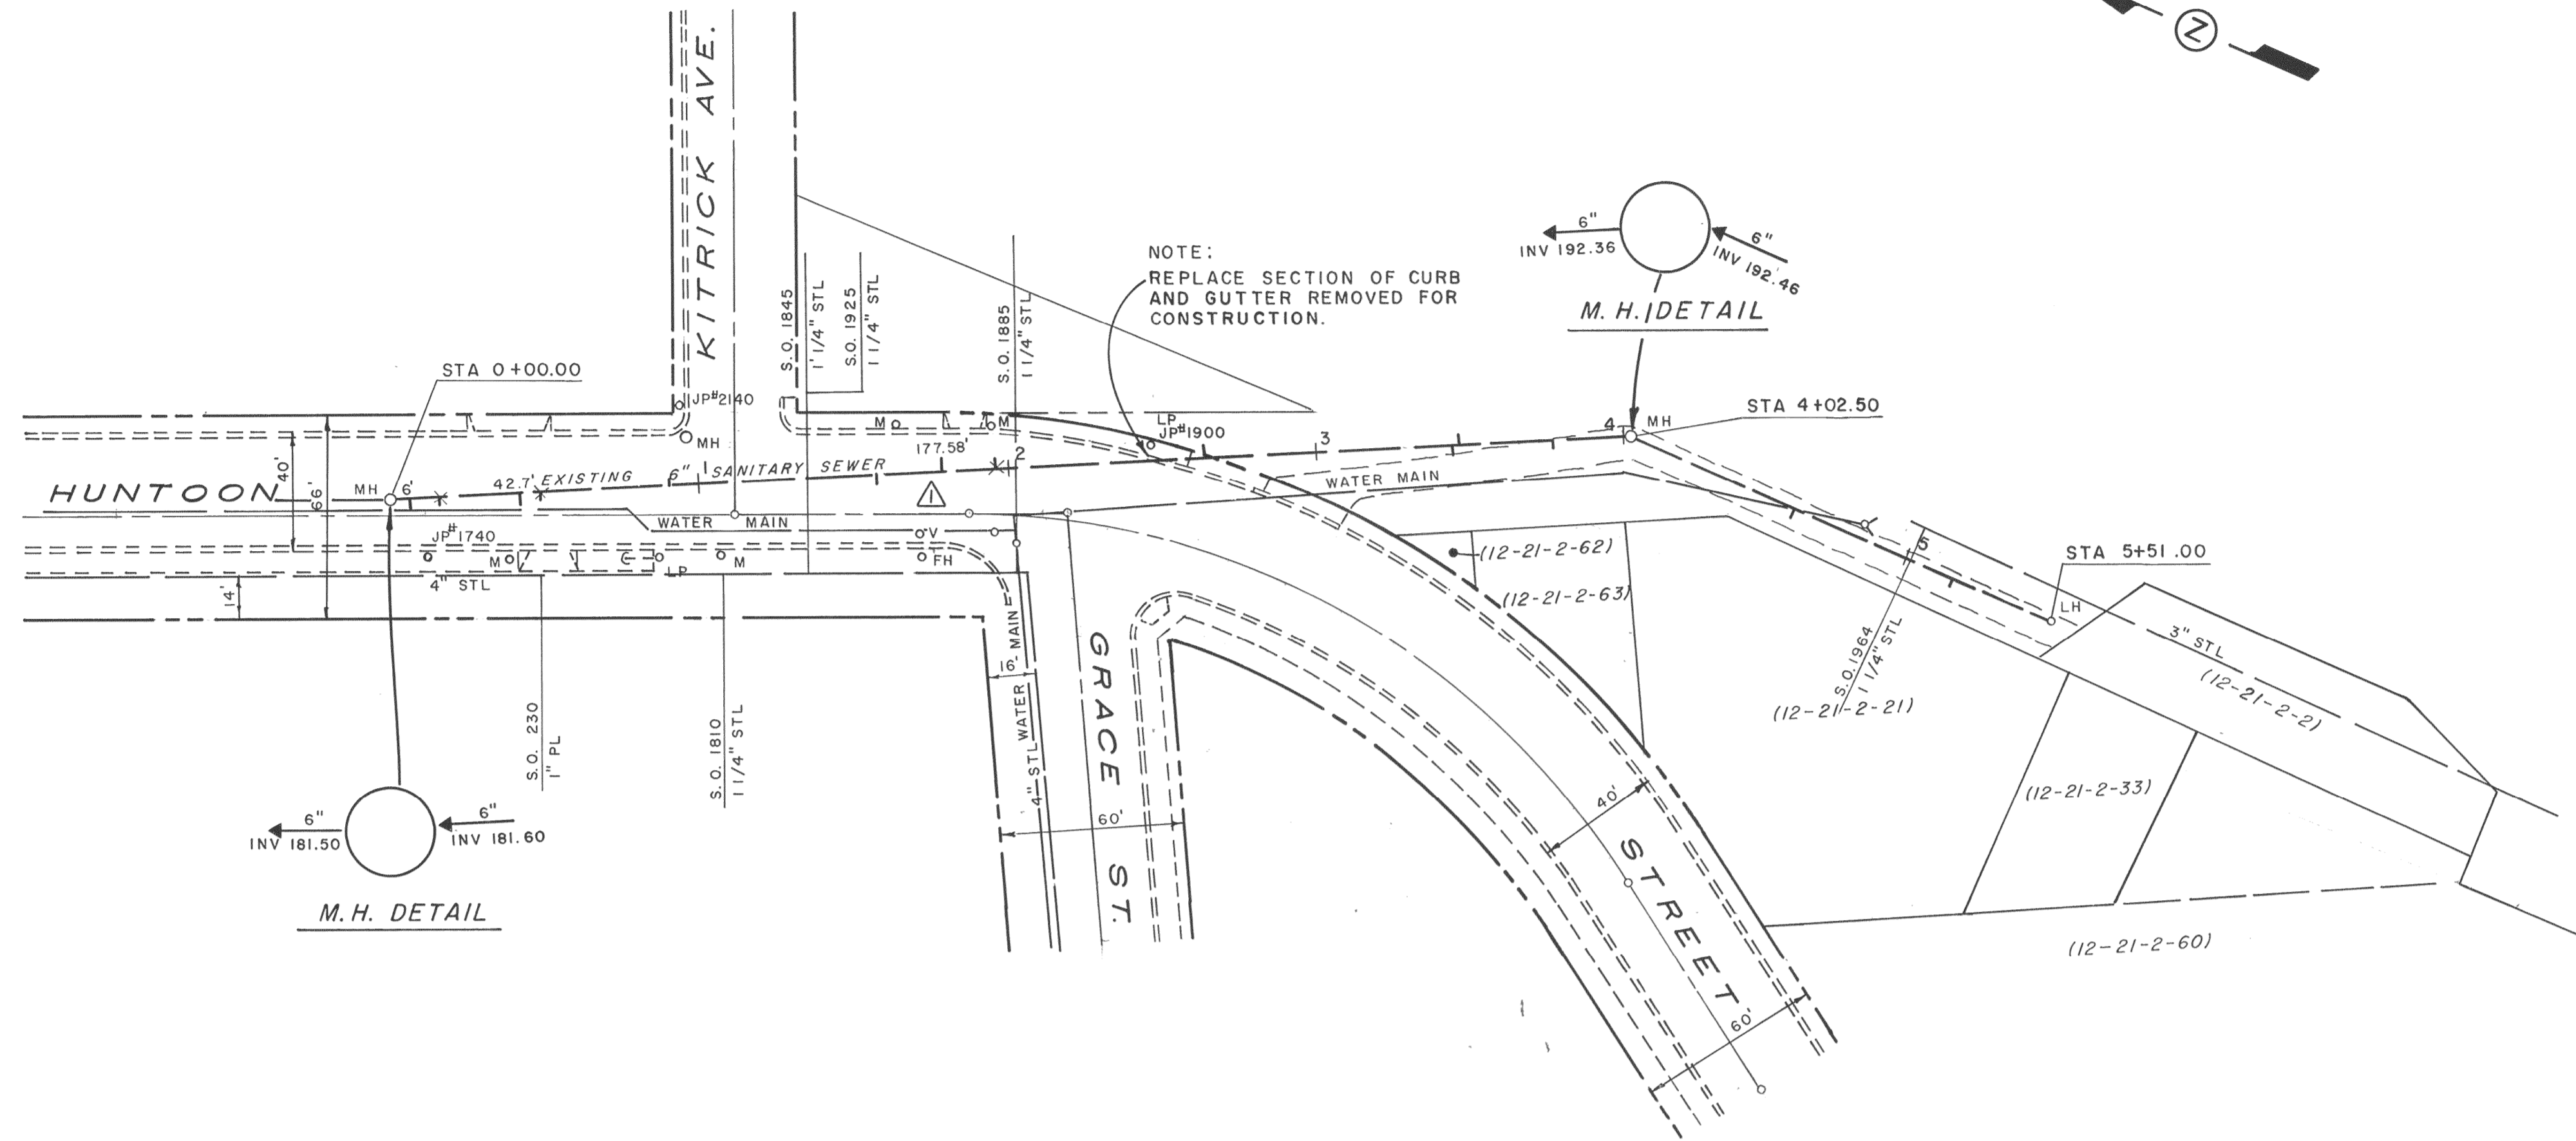


BENCHMARK

BRASS CAP SET IN S.E. CURB RETURN
 AT INTERSECTION OF HUNTOON ST.
 AND KITRICK AVE.
 ELEV. 191.52

SCALE
 HORZ. 1" = 40'
 VERT. 1" = 4'

PROFILE
 SUBMITTED BY DATE
 NOTED BY DATE
 NOTE BOOK, GRADES CHECKED
 NO. B.M.'S NOTED
 NO. STRUCTURE INDICATIONS CHECKED

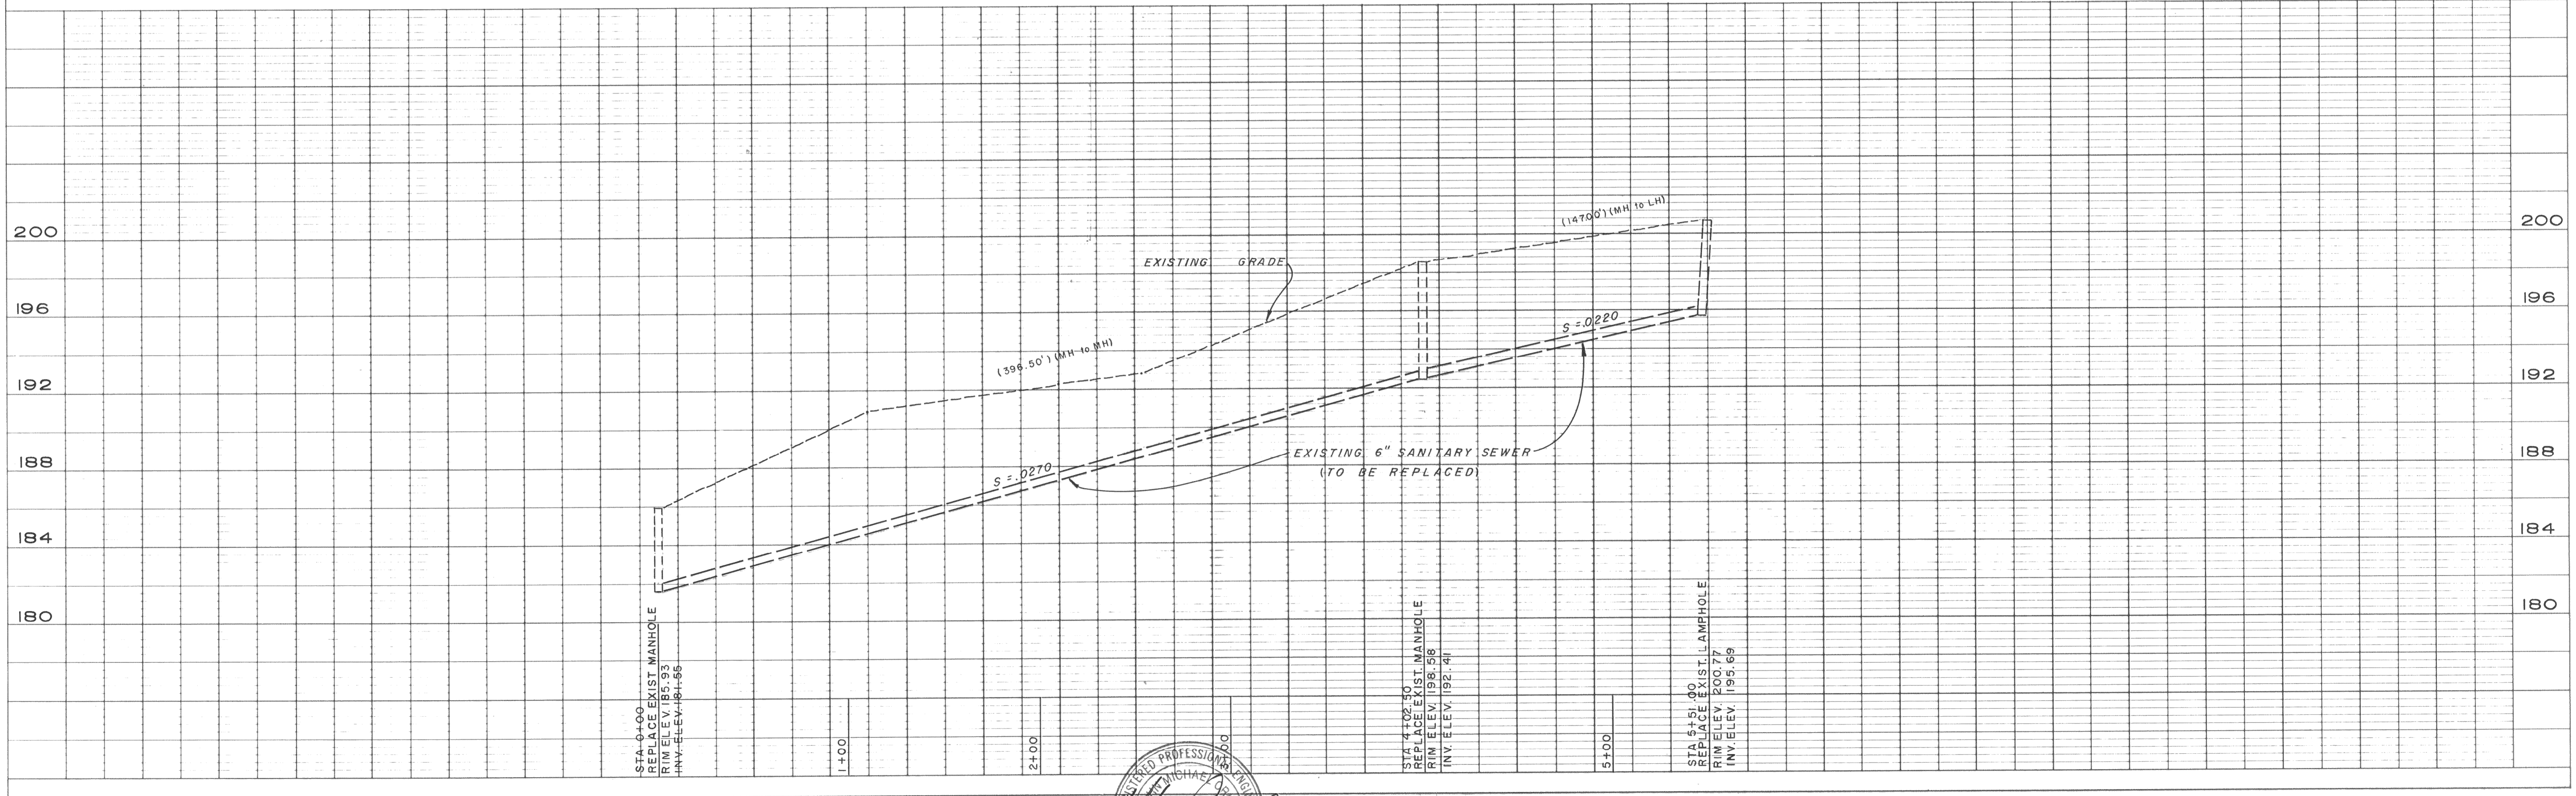

DATE NO.	REVISION	BY	APP'D
1-7-94	SS. LATERALS, WATER MAIN & GAS	T.F.	

FIELD BOOK	DRAWN
ELEVATION DATUM	T.F.
	DESIGNED
	J.J.
	CHECKED
	J.J.
	SCALE

APPROVED
 No. C 041977
 EXP 3/31/92
 CIVIL
 STATE OF CALIFORNIA
 DIRECTOR PUBLIC WORKS R.C.E. 41977 DATE 5/1/92

CITY OF OROVILLE
 PUBLIC WORKS DEPARTMENT
 1675 MONTGOMERY ST.
 OROVILLE, CA 95965 (916) 538-2420

SANITARY SEWER REPLACEMENT
 PROJECT
 HUNTOON STREET

SHEET
 4 OF 4
 SHEETS
 JOB NO.