



PLAN
 SURVEYED BY DATE
 PLOTTED BY
 NOTE BOOK GRADE CHECKED
 ALIGNMENT CHECKED
 FT. OF WAY CHECKED
 No.

PROFILE
 SURVEYED BY DATE
 PLOTTED BY
 NOTE BOOK GRADE CHECKED
 HORIZONTAL ALIGNMENT CHECKED
 VERTICAL CURVATURE CHECKED
 No.

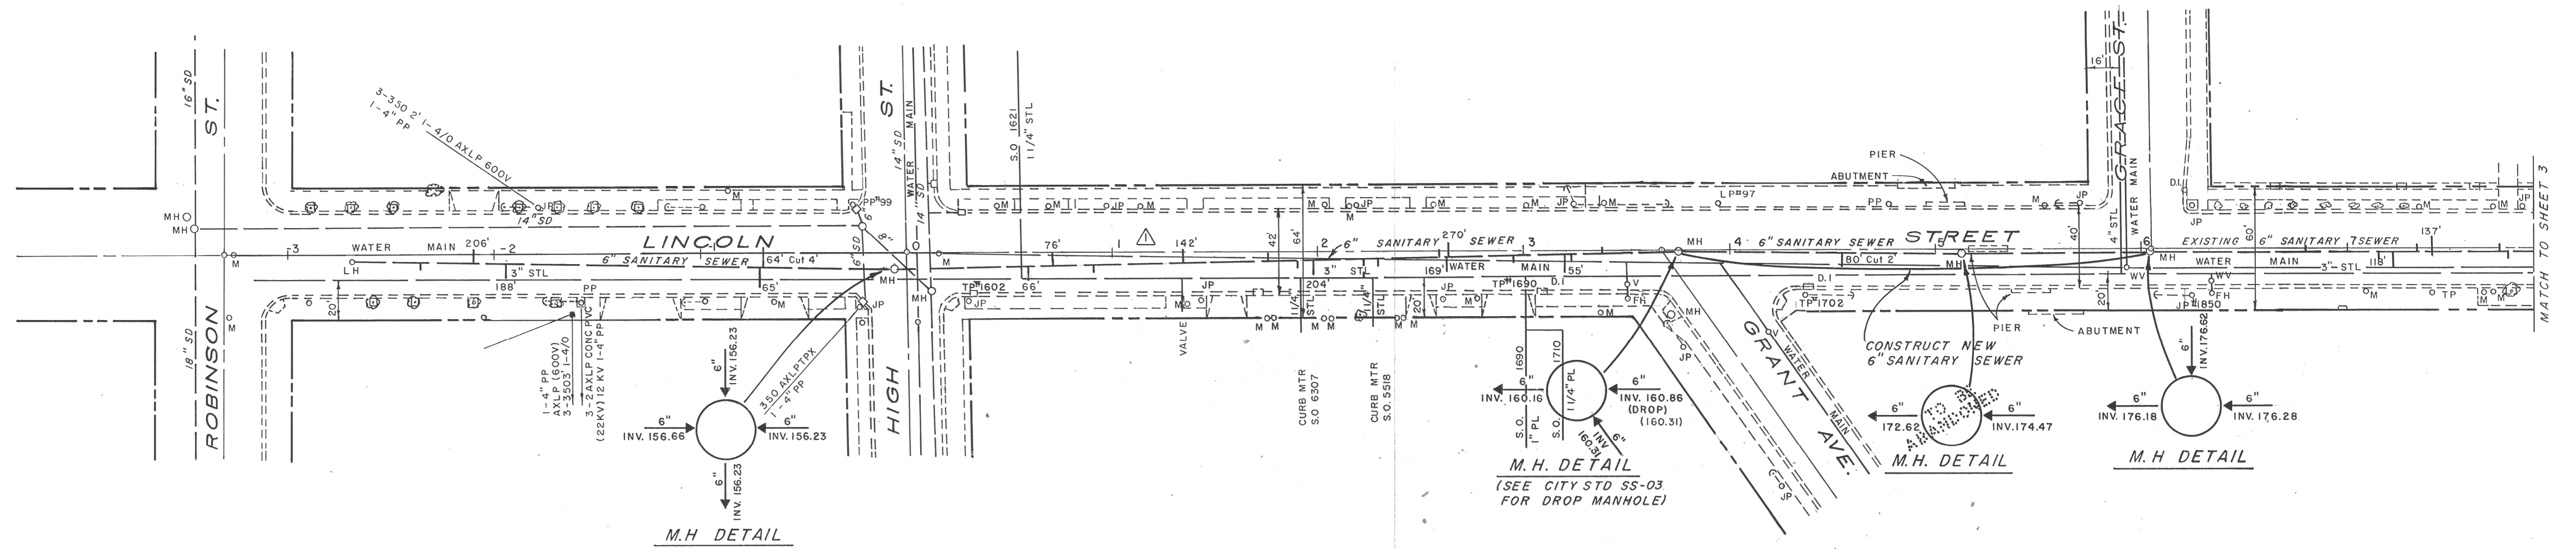

TBM
 TOP OF FIRE HYDRANT WEST OF
 LINCOLN STREET
 STA 6+32.50 RT
 ELEV. 189.24

SCALE
 HORZ. 1" = 40'
 VERT. 1" = 4'

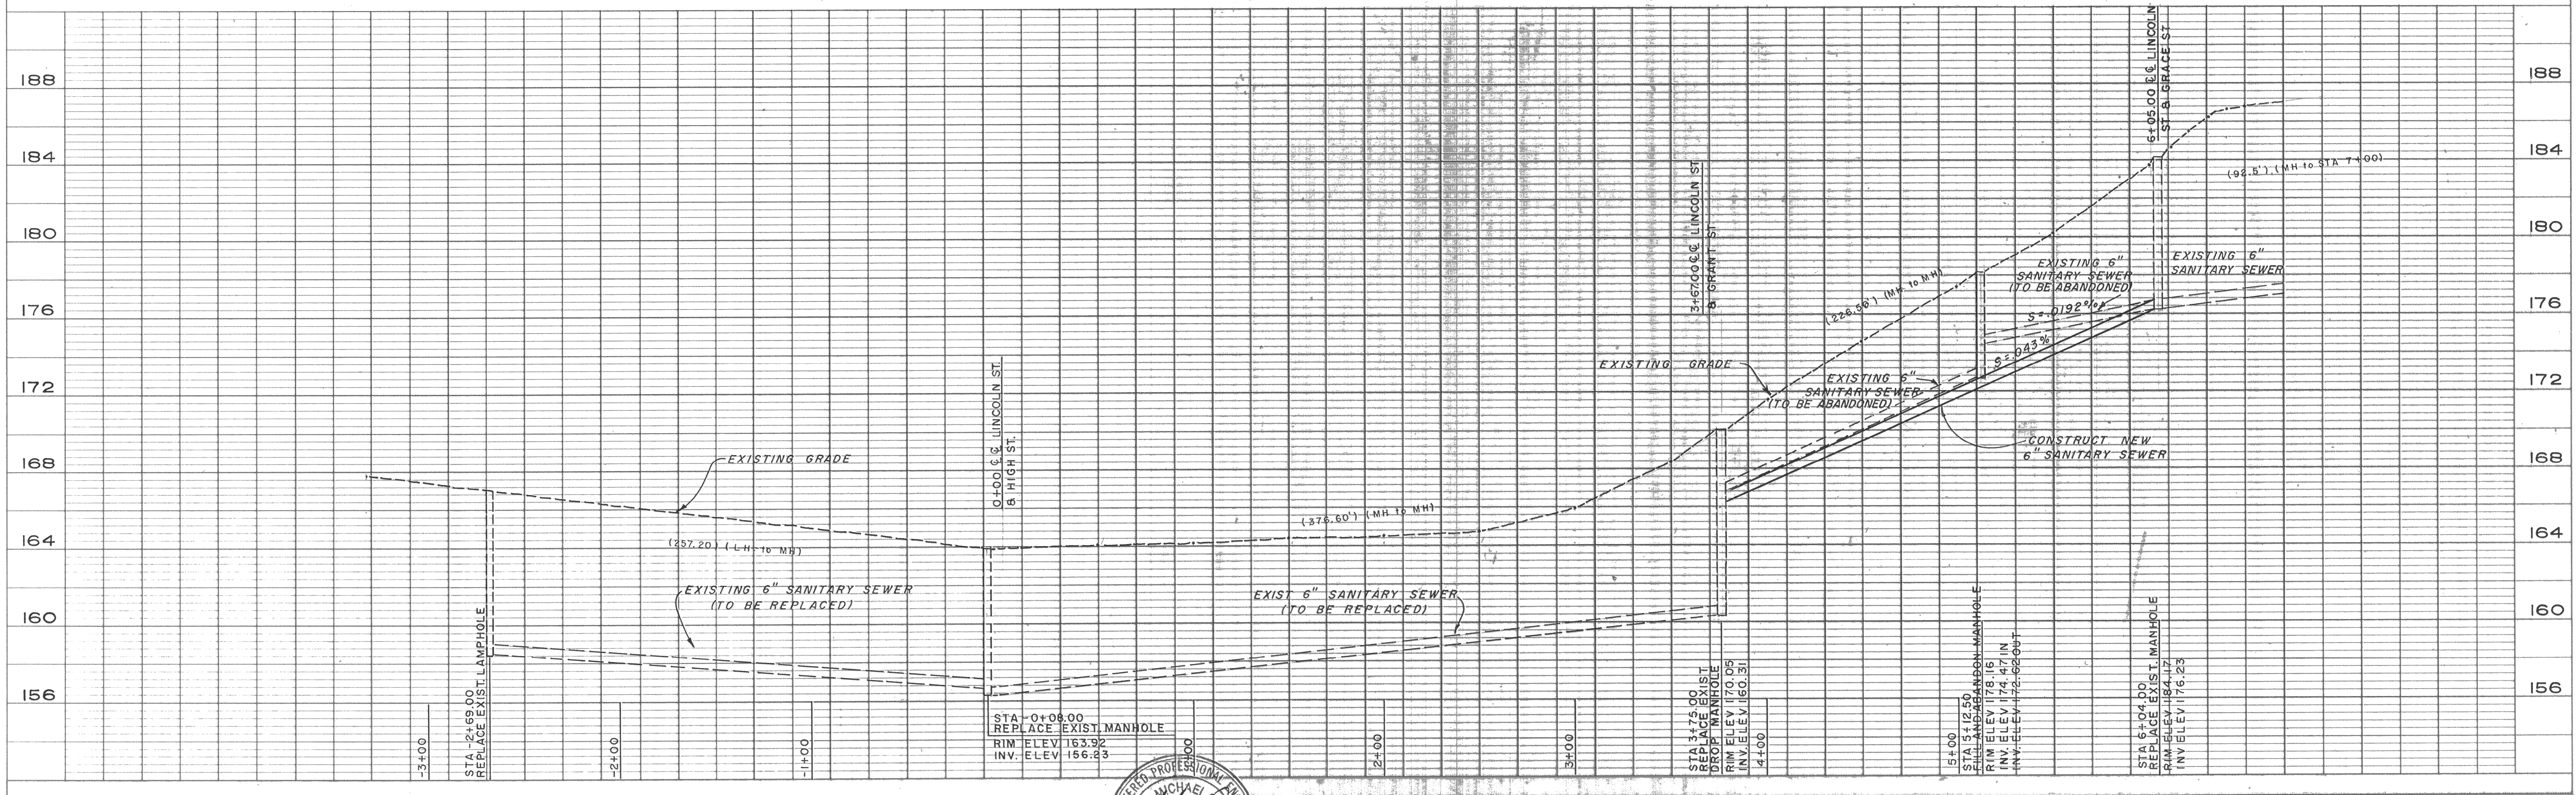

1-7-94	▲ S.S. LATERALS, WATER MAIN & GAS	T.F.
DATE NO.	REVISION	BY APP'D

FIELD BOOK	DRAWN
ELEVATION DATUM	T.F.
	DESIGNED
	J.J.
	CHECKED
	J.J.
	SCALE

APPROVED
 No. C 041977
 EXP 5/31/92
 CIVIL
 STATE OF CALIFORNIA
 DIRECTOR PUBLIC WORKS R.C.E. 41977 DATE 5/5/92

CITY OF OROVILLE
 PUBLIC WORKS DEPARTMENT
 1675 MONTGOMERY ST.
 OROVILLE, CA 95965 (916) 538-2420

SANITARY SEWER REPLACEMENT
 PROJECT
 LINCOLN STREET

SHEET
 2 OF 4
 SHEETS
 JOB NO.