
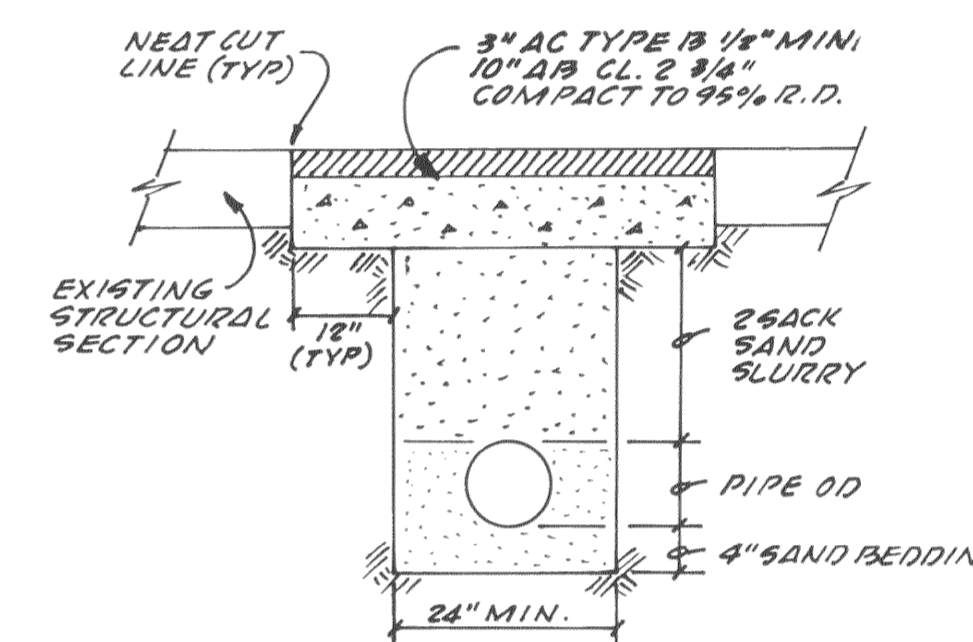




GENERAL NOTES

- All materials and construction shall be in strict conformance with requirements of the City of Oroville and the O.W.I.D. and as set forth in specification and as shown on these plans.
- Approval of City Public Works Department representative is required on completed work within the public right of way prior to:
 - (A) Placing of any concrete
 - (B) Placing of aggregate base
 - (C) Placing of asphalt concrete, prime coat and fog seal
 - (D) Backfilling trenches

Work done without such approval shall be done at the Contractor's risk. Such approval, when given shall not relieve the Contractor from the responsibility of performing the work in an acceptable manner.
- The types, locations, sizes and/or depths of existing underground utilities as shown on these improvement plans were obtained from sources of varying reliability. The Contractor is cautioned that only actual excavation will reveal the number, types, extent, sizes, location and depth of such underground utilities. A reasonable effort has been made to locate and delineate all known underground utilities. However, Barnhart-Brown & Associates, can assume no responsibility for the completeness or accuracy of its delineation of such underground utilities nor for the existence of other buried objects or utilities which may be encountered, but which are not shown on these drawings.
- The Contractor is hereby notified that prior to commencing construction, he is responsible for contacting the utility companies involved and verifying at the construction site the locations of all utilities as shown on these improvements plans or discovered in the field. Contractor shall notify Underground Service Alert (PH. 800-642-2444) 48 hours in advance of any work.
- The Contractor shall remove all obstructions, both above ground and underground, except as indicated on the plans as necessary for the construction of the proposed improvements.
- The Contractor shall be solely and completely responsible for the condition of premises on which the work is performed and for the safety of all persons and property on the site, both during and outside of normal working hours, until such work is accepted by the owner.
- Sufficient equipment shall be available to provide dust control at all times during construction operations. Areas surrounding the work shall be kept clean and returned to original conditions upon completion of this contract.
- Where Barnhart-Brown & Associates are to provide construction stakes, the contractor shall:
 - (A) Request staking at least 24 hours in advance
 - (B) Request concrete form checks
 - (C) Preserve all stakes and monuments
- The Contractor shall, at all times, coordinate his work with that of others on the site.

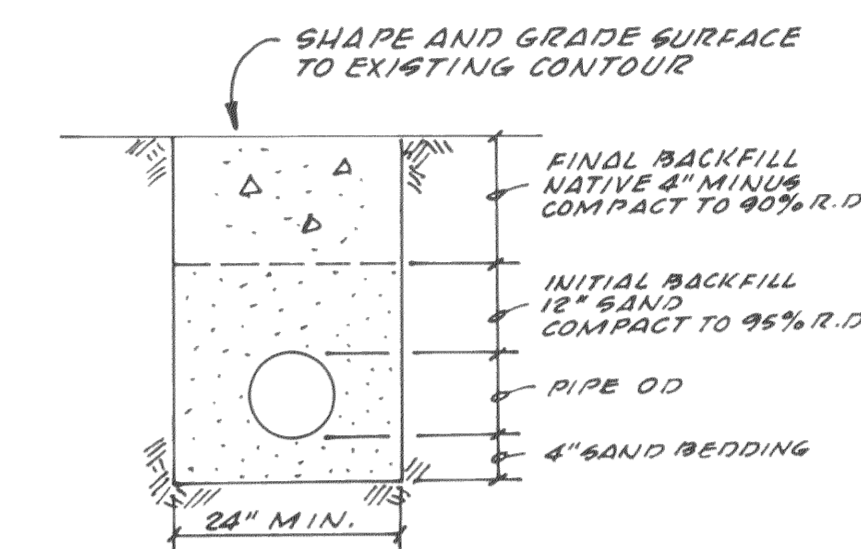

TYPICAL TRENCH SECTION
FOOTHILL BOULEVARD

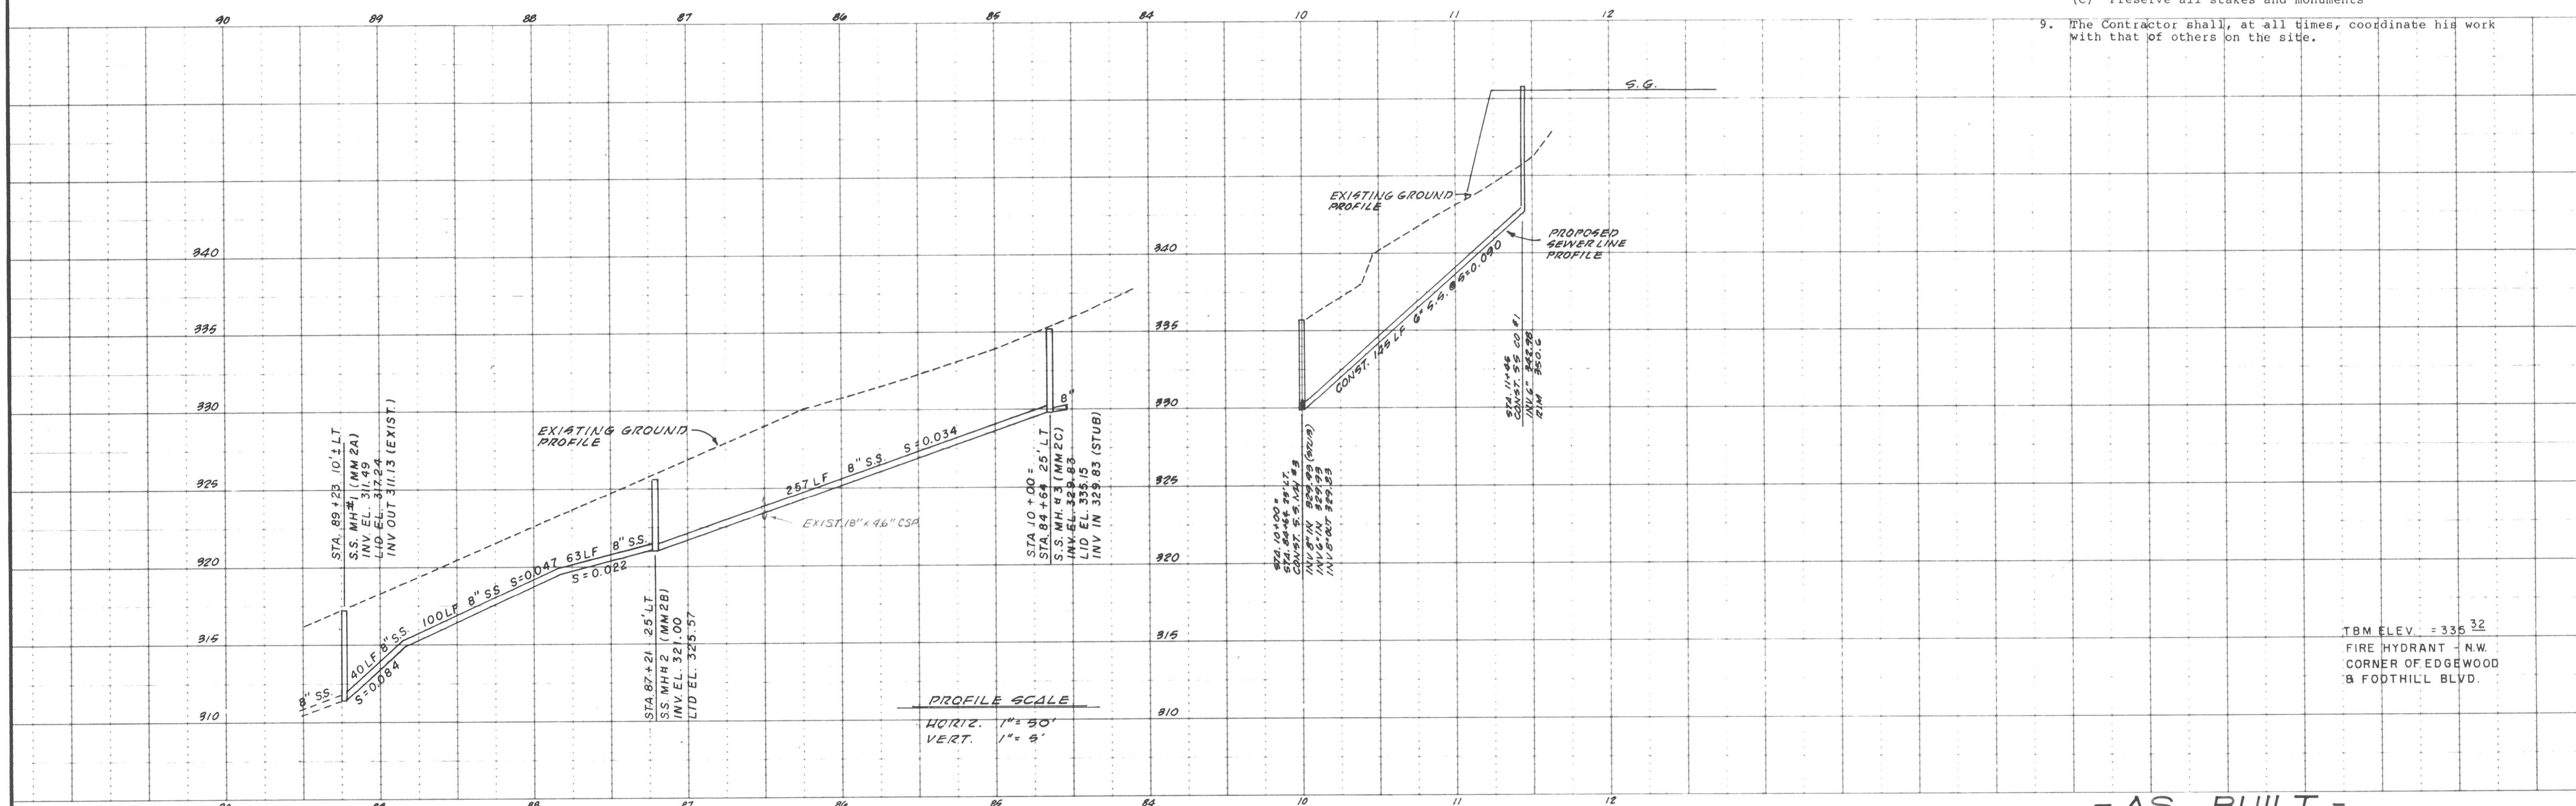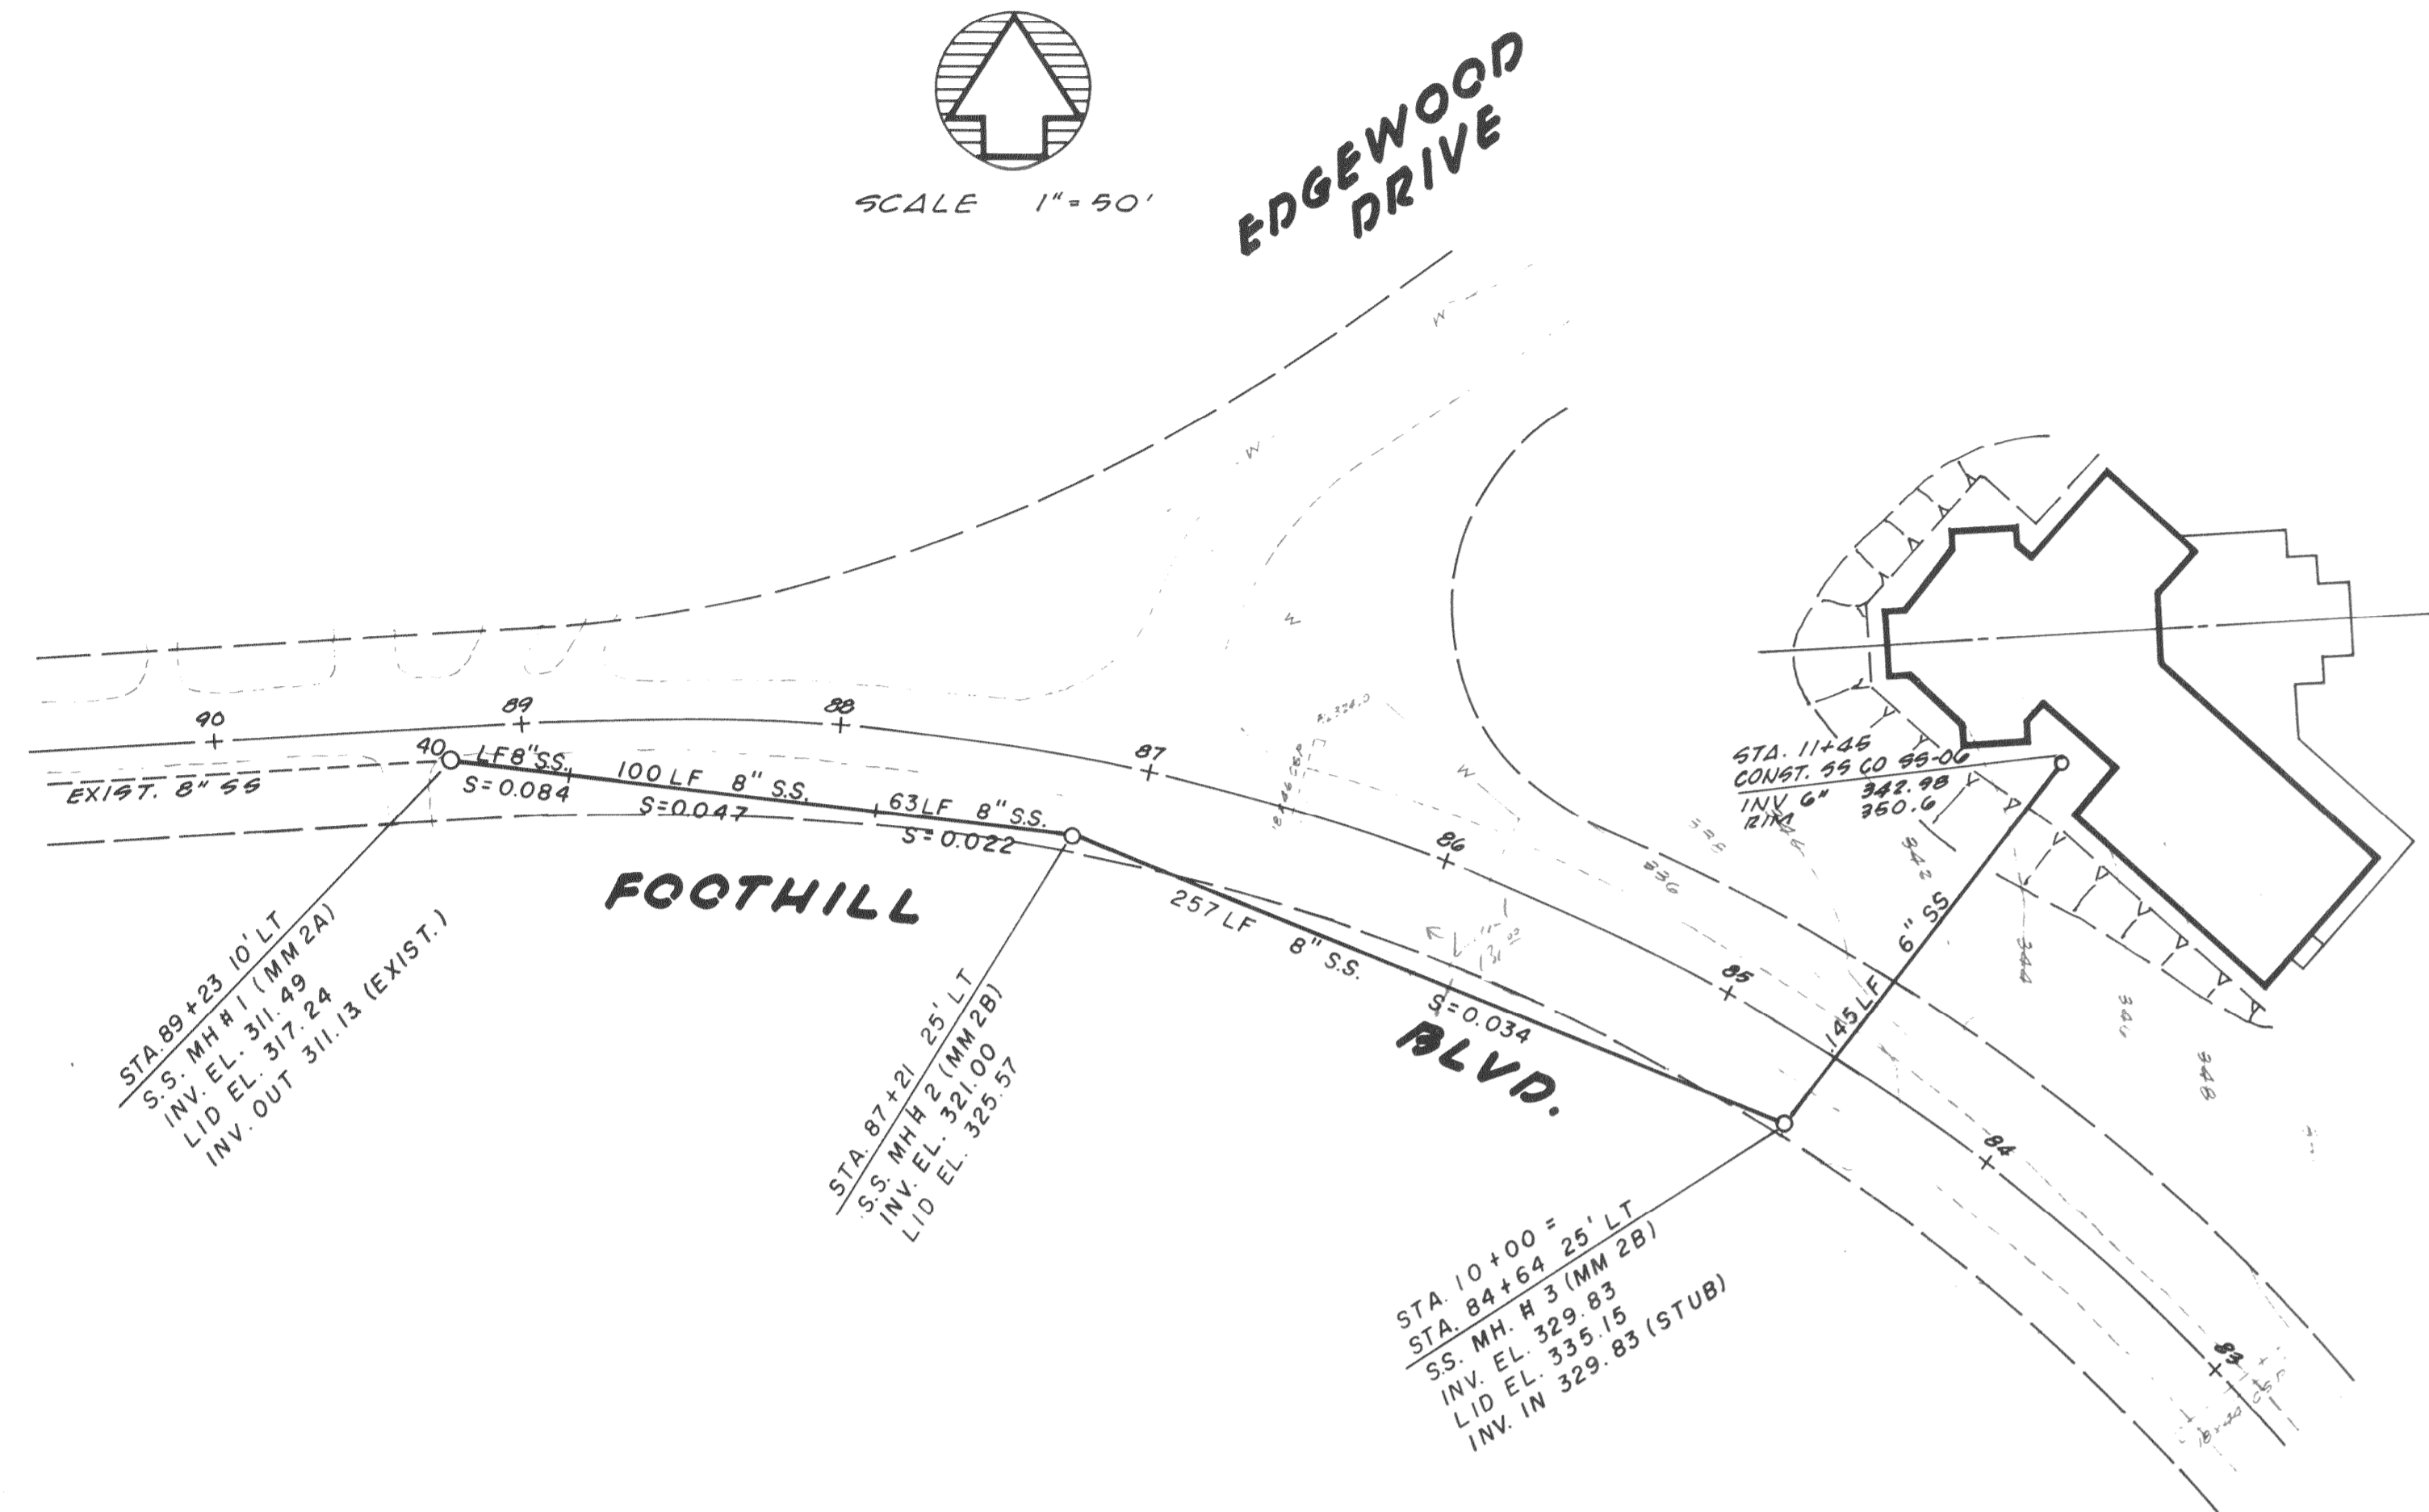

TBM ELEV. = 335.32
FIRE HYDRANT - N.W. CORNER OF EDGEWOOD & FOOTHILL BLVD.

- AS BUILT -

DATE	NO.	REVISION	BY	APPD.	SCALE	AS SHOWN	APPROVED
FIELD BOOK				DRAWN			
ELEVATION DATUM				LANE			
				DESIGNED			
				CHECKED			
				A. G. B.			
				SCALE			
				AS SHOWN			
				DATE			
				APPROVED			
				DATE			

Barnhart-Brown & Associates
A CALIFORNIA CORPORATION

P.O. Box 1576 Oroville, CA 95965 916/534-1911

CIVIL ENGINEERS LAND SURVEYORS

SEWER EXTENSION
CALVARY EVANGELICAL LUTHERN CHURCH

FOOTHILL BLVD. OROVILLE, CA.

SHEET
2 OF 2
SHEETS

JOB NO. 86171