

FOR USE WITH STANDARD SPECIFICATIONS AND STANDARD PLANS  
DATED JULY, 1992 OF THE CALIFORNIA DEPT. OF TRANSPORTATION.

THE CONTRACTOR SHALL POSSESS A CLASS "A" LICENSE, OR A  
COMBINATION OF CLASSES REQUIRED BY THE CATEGORIES AND  
TYPE OF WORK INCLUDED IN THIS CONTRACT AT THE TIME THIS  
CONTRACT IS AWARDED.

# CITY OF OROVILLE


## DEPARTMENT OF PUBLIC WORKS

PROJECT PLANS FOR CONSTRUCTION  
WITHIN THE CITY OF OROVILLE


### SANITARY SEWER MAIN RELINE PROJECT

#### INDEX TO SHEETS



TITLE SHEET	SHEET 1
ORO TERRACE AREA	SHEETS 2, 3, 4
GRANDVIEW AREA	SHEET 5
SOUTHSIDE AREA	SHEET 6

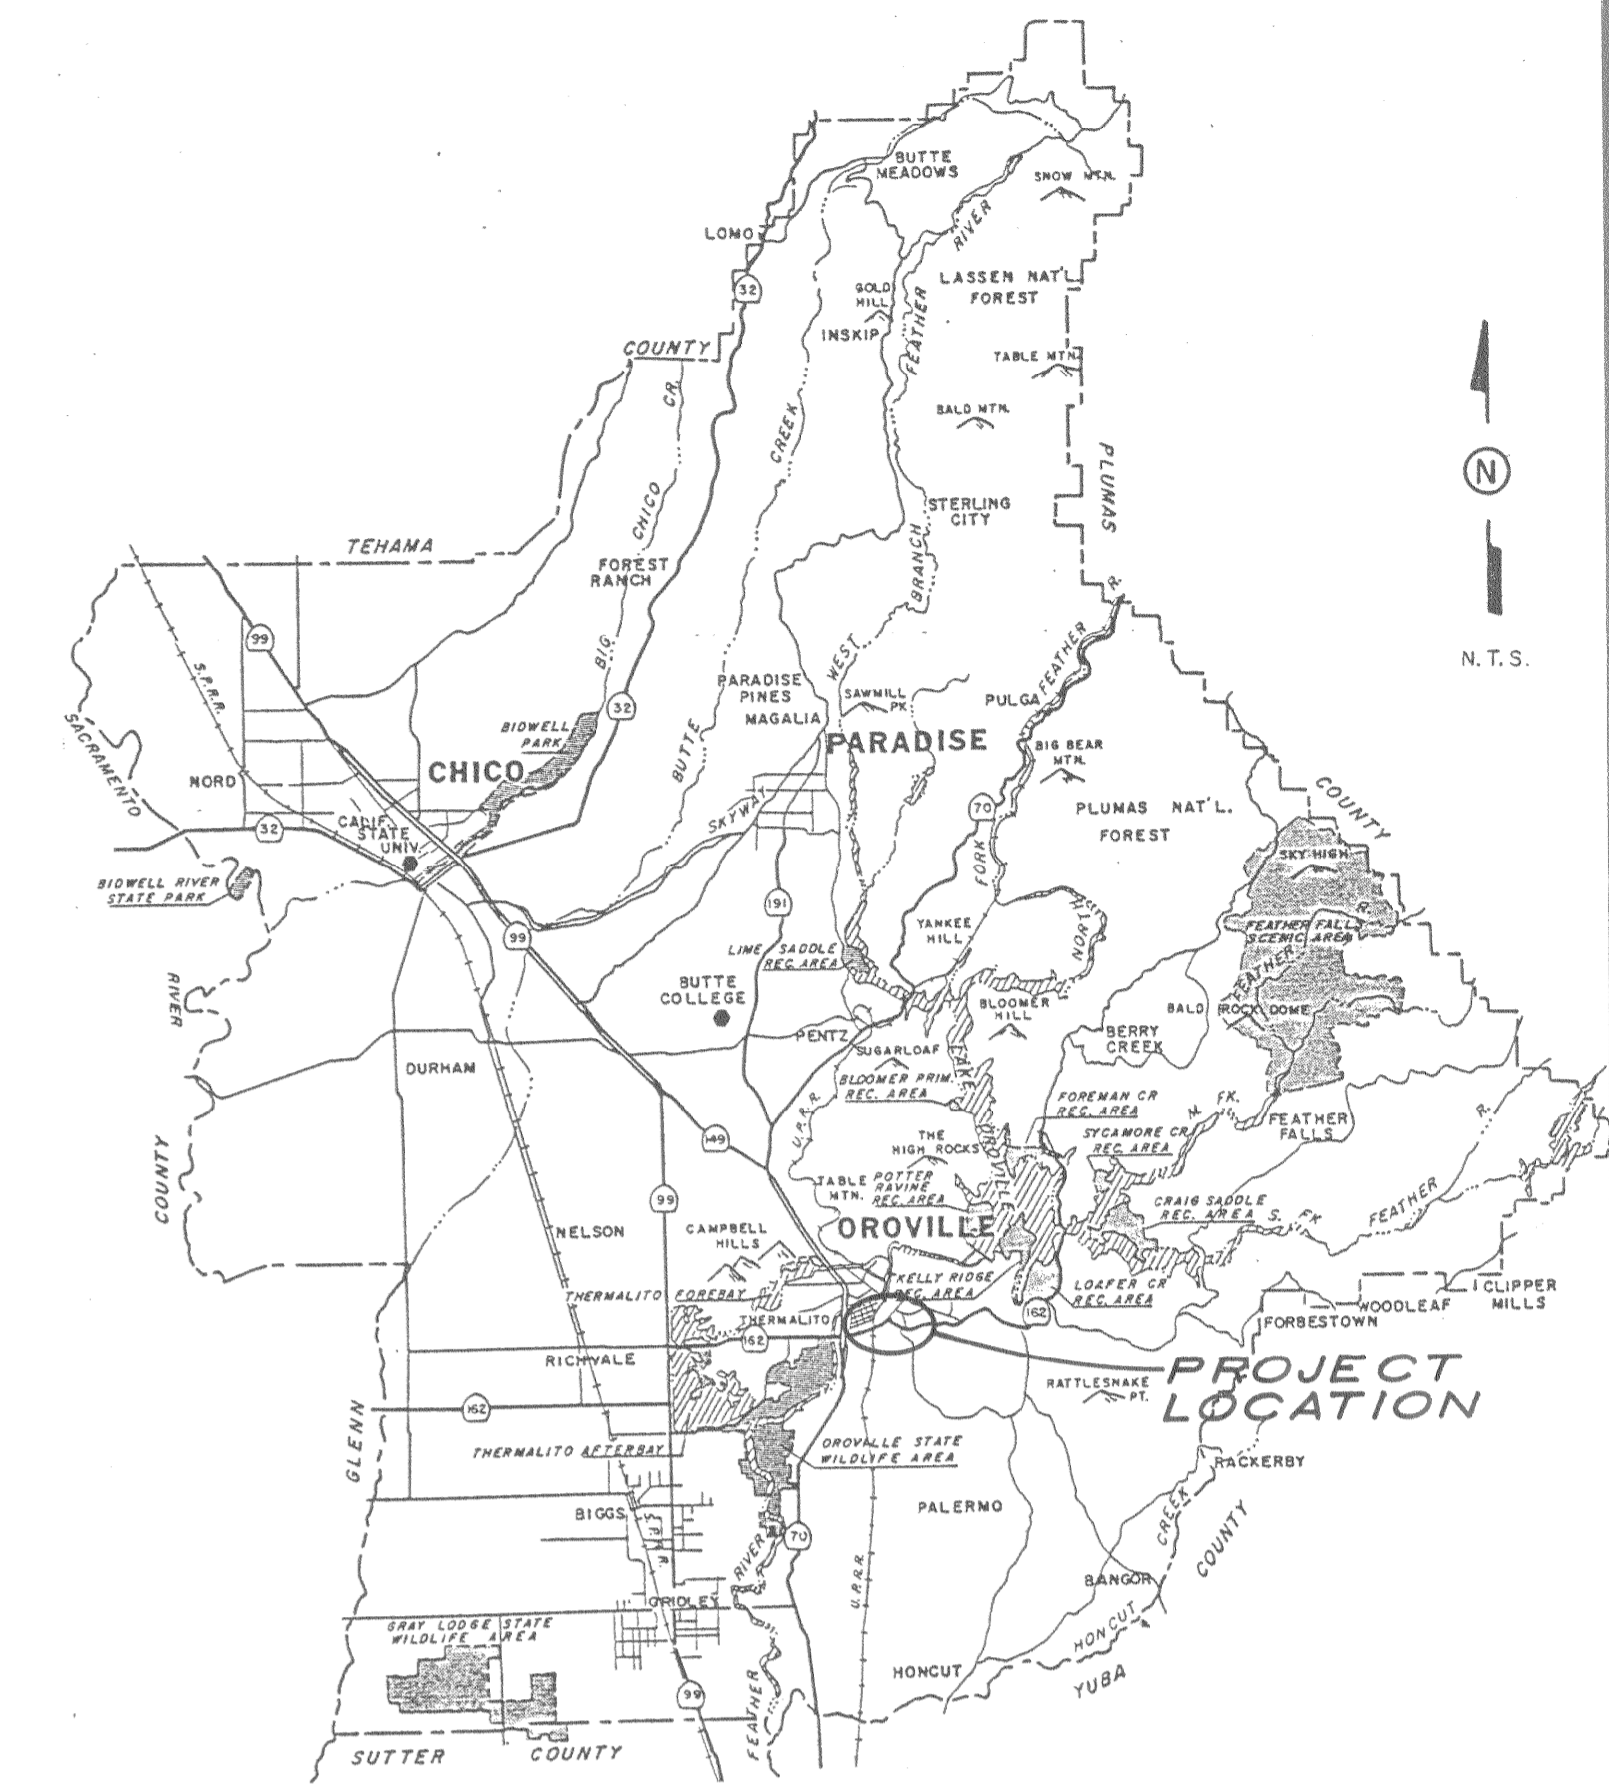

LOCATION MAP  
N.T.S.

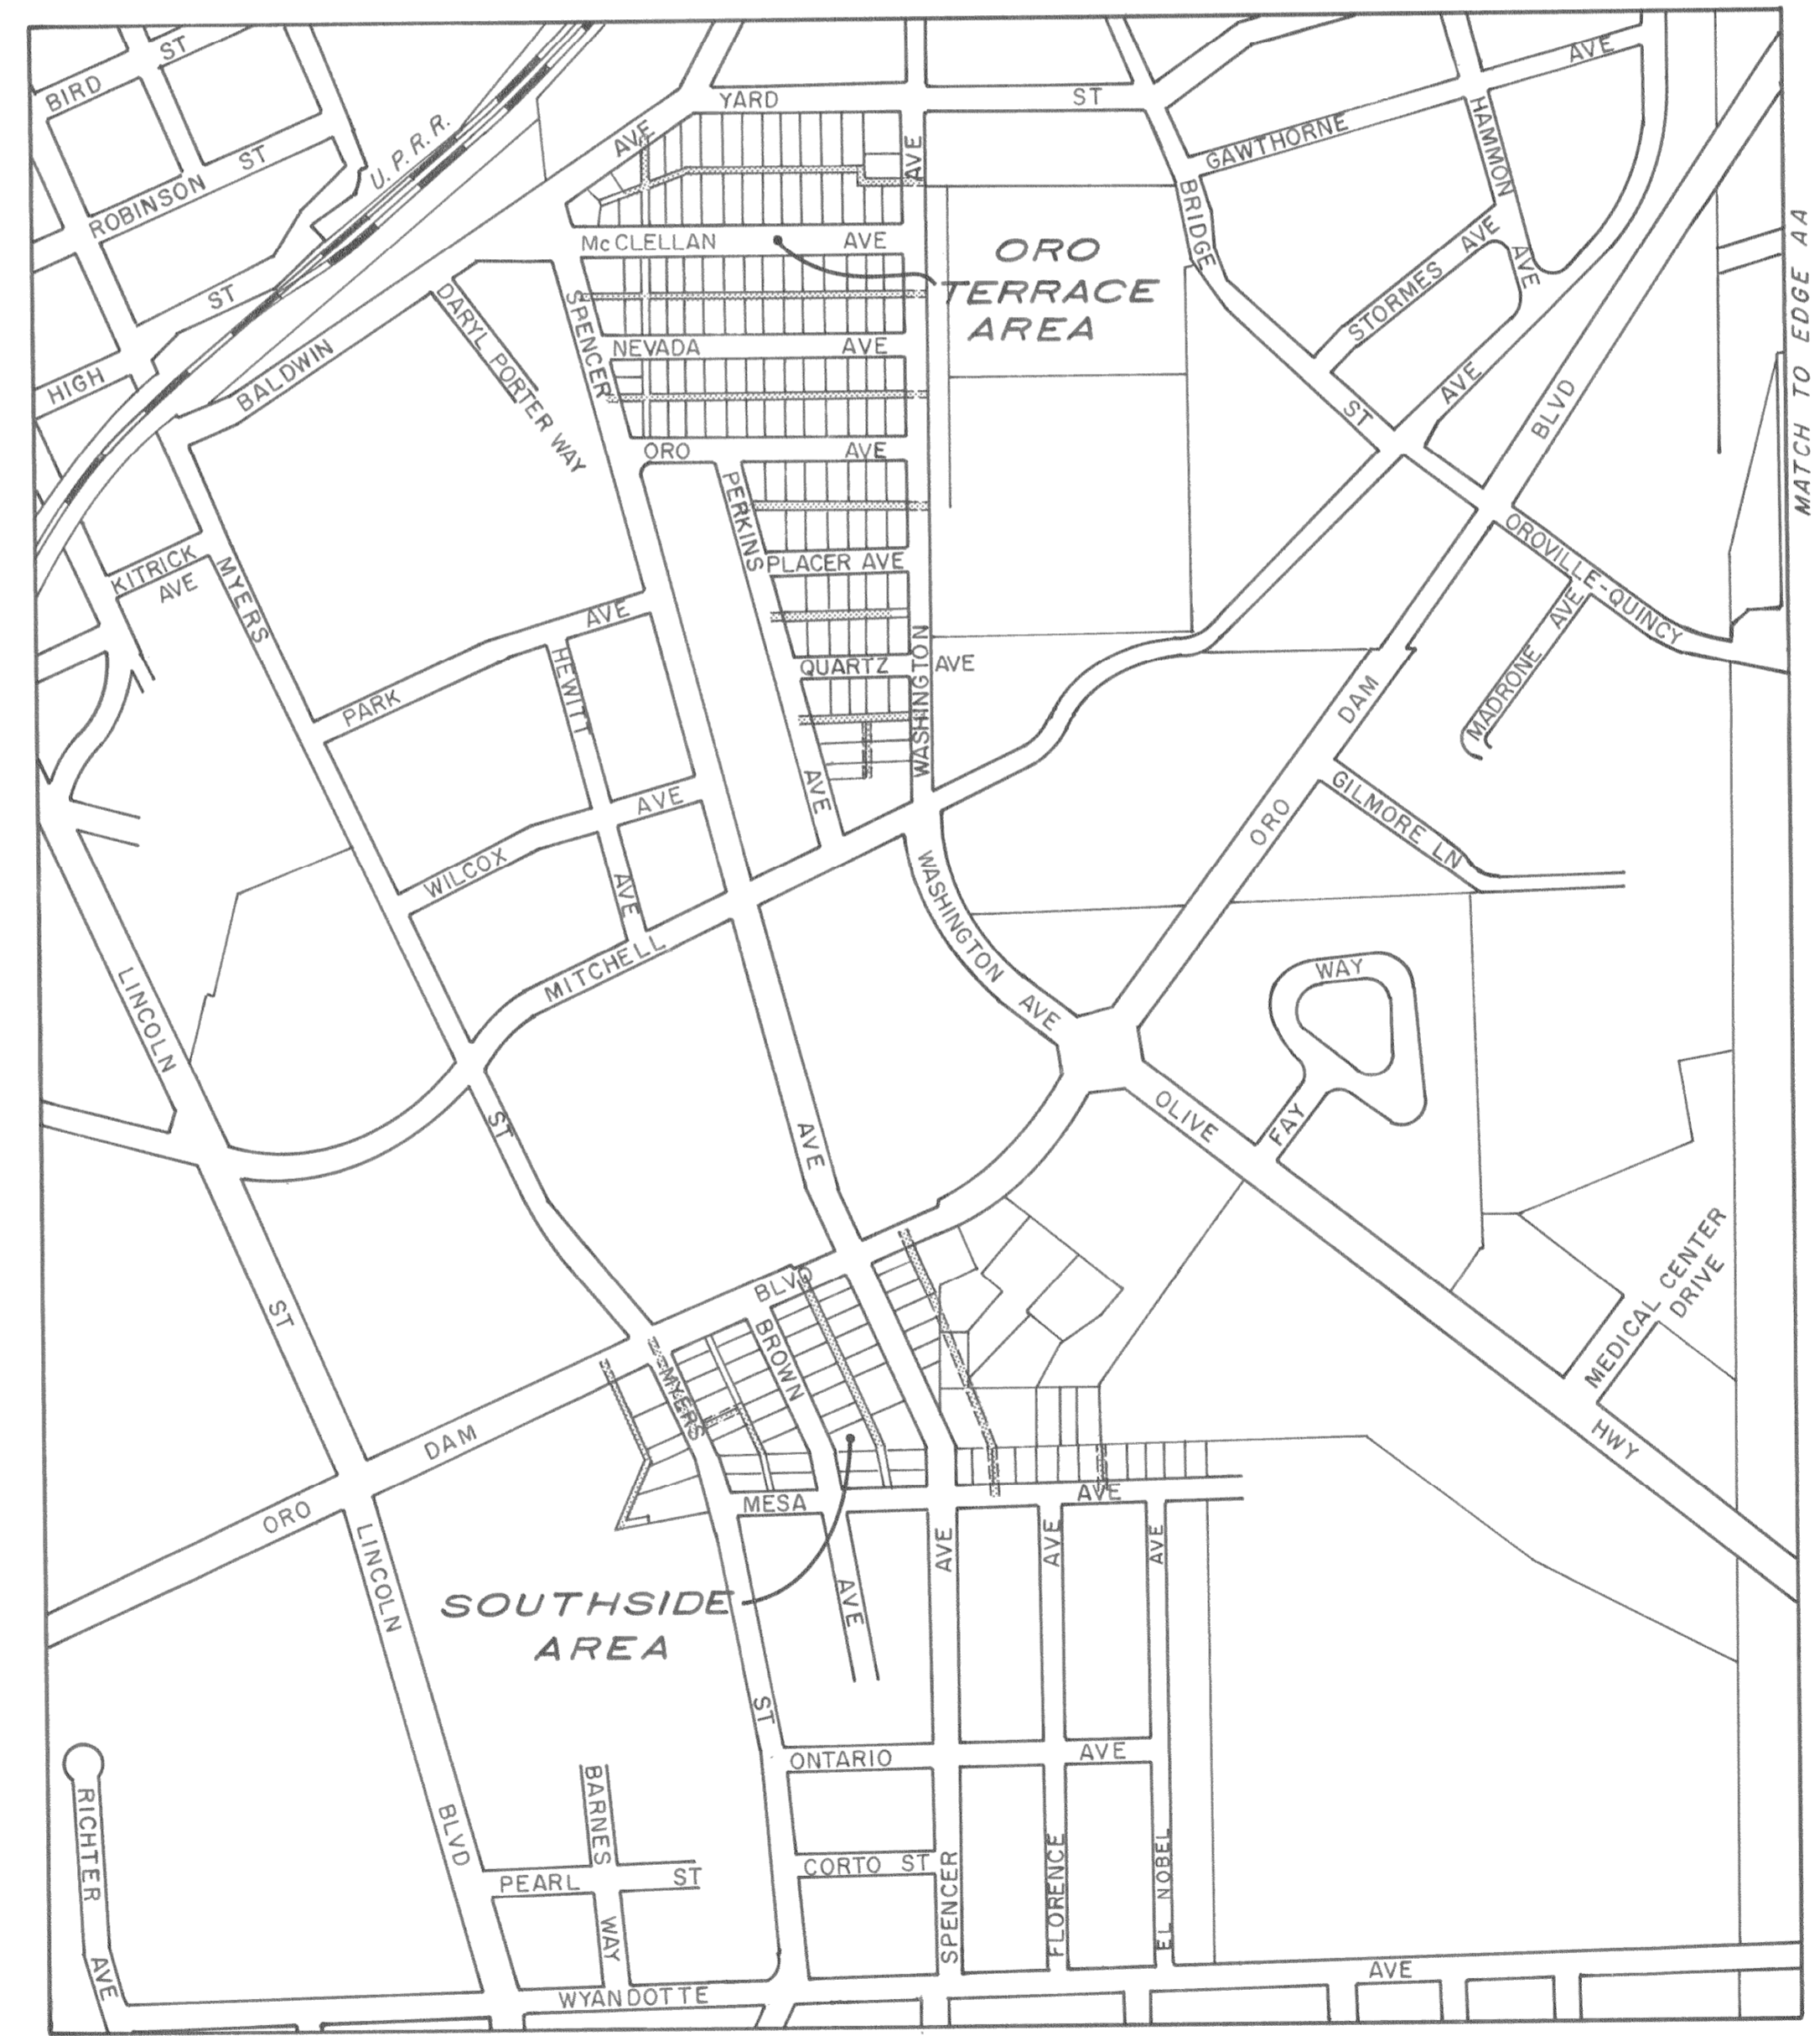

CITY OF OROVILLE  
VICINITY MAP

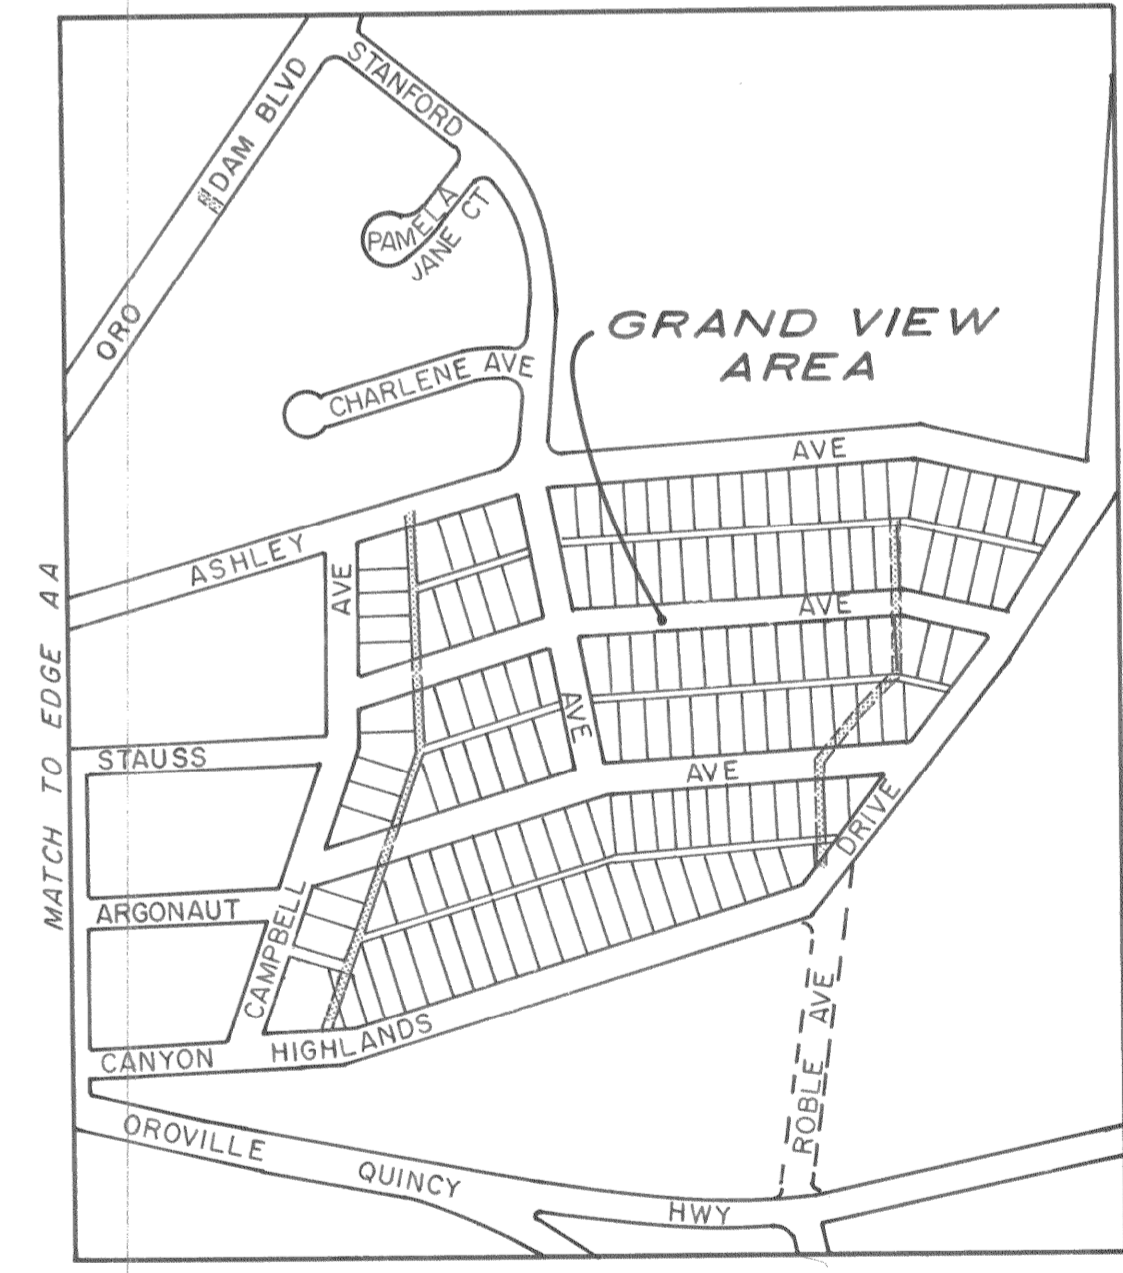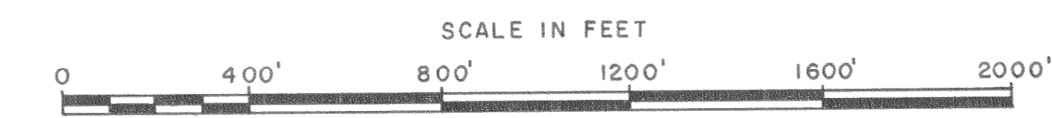

AS BUILT  
LIMITS OF PROJECT



CITY OF OROVILLE	
SANITARY SEWER MAIN RELINE PROJECT	
APPROVED BY <i>Allen Campbell</i> PUBLIC WORKS DIRECTOR	DESIGNED BY T.F. CHECKED BY DATE 5/15/96
DRAWING NO. 1	SHEET 6