

FOR USE WITH STANDARD SPECIFICATIONS AND STANDARD PLANS
DATED JULY, 1992 OF THE CALIFORNIA DEPT. OF TRANSPORTATION.

THE CONTRACTOR SHALL POSSESS A CLASS "A" LICENSE, OR A
COMBINATION OF CLASSES REQUIRED BY THE CATEGORIES AND
TYPE OF WORK INCLUDED IN THIS CONTRACT AT THE TIME THIS
CONTRACT IS AWARDED.

CITY OF OROVILLE


DEPARTMENT OF PUBLIC WORKS

PROJECT PLANS FOR REPAIR WORK
WITHIN THE CITY OF OROVILLE



SANITARY SEWER MAIN GROUT PROJECT

INDEX TO SHEETS

TITLE SHEET	SHEET 1
SEWER MAIN LOCATION SHEET	SHEET 2



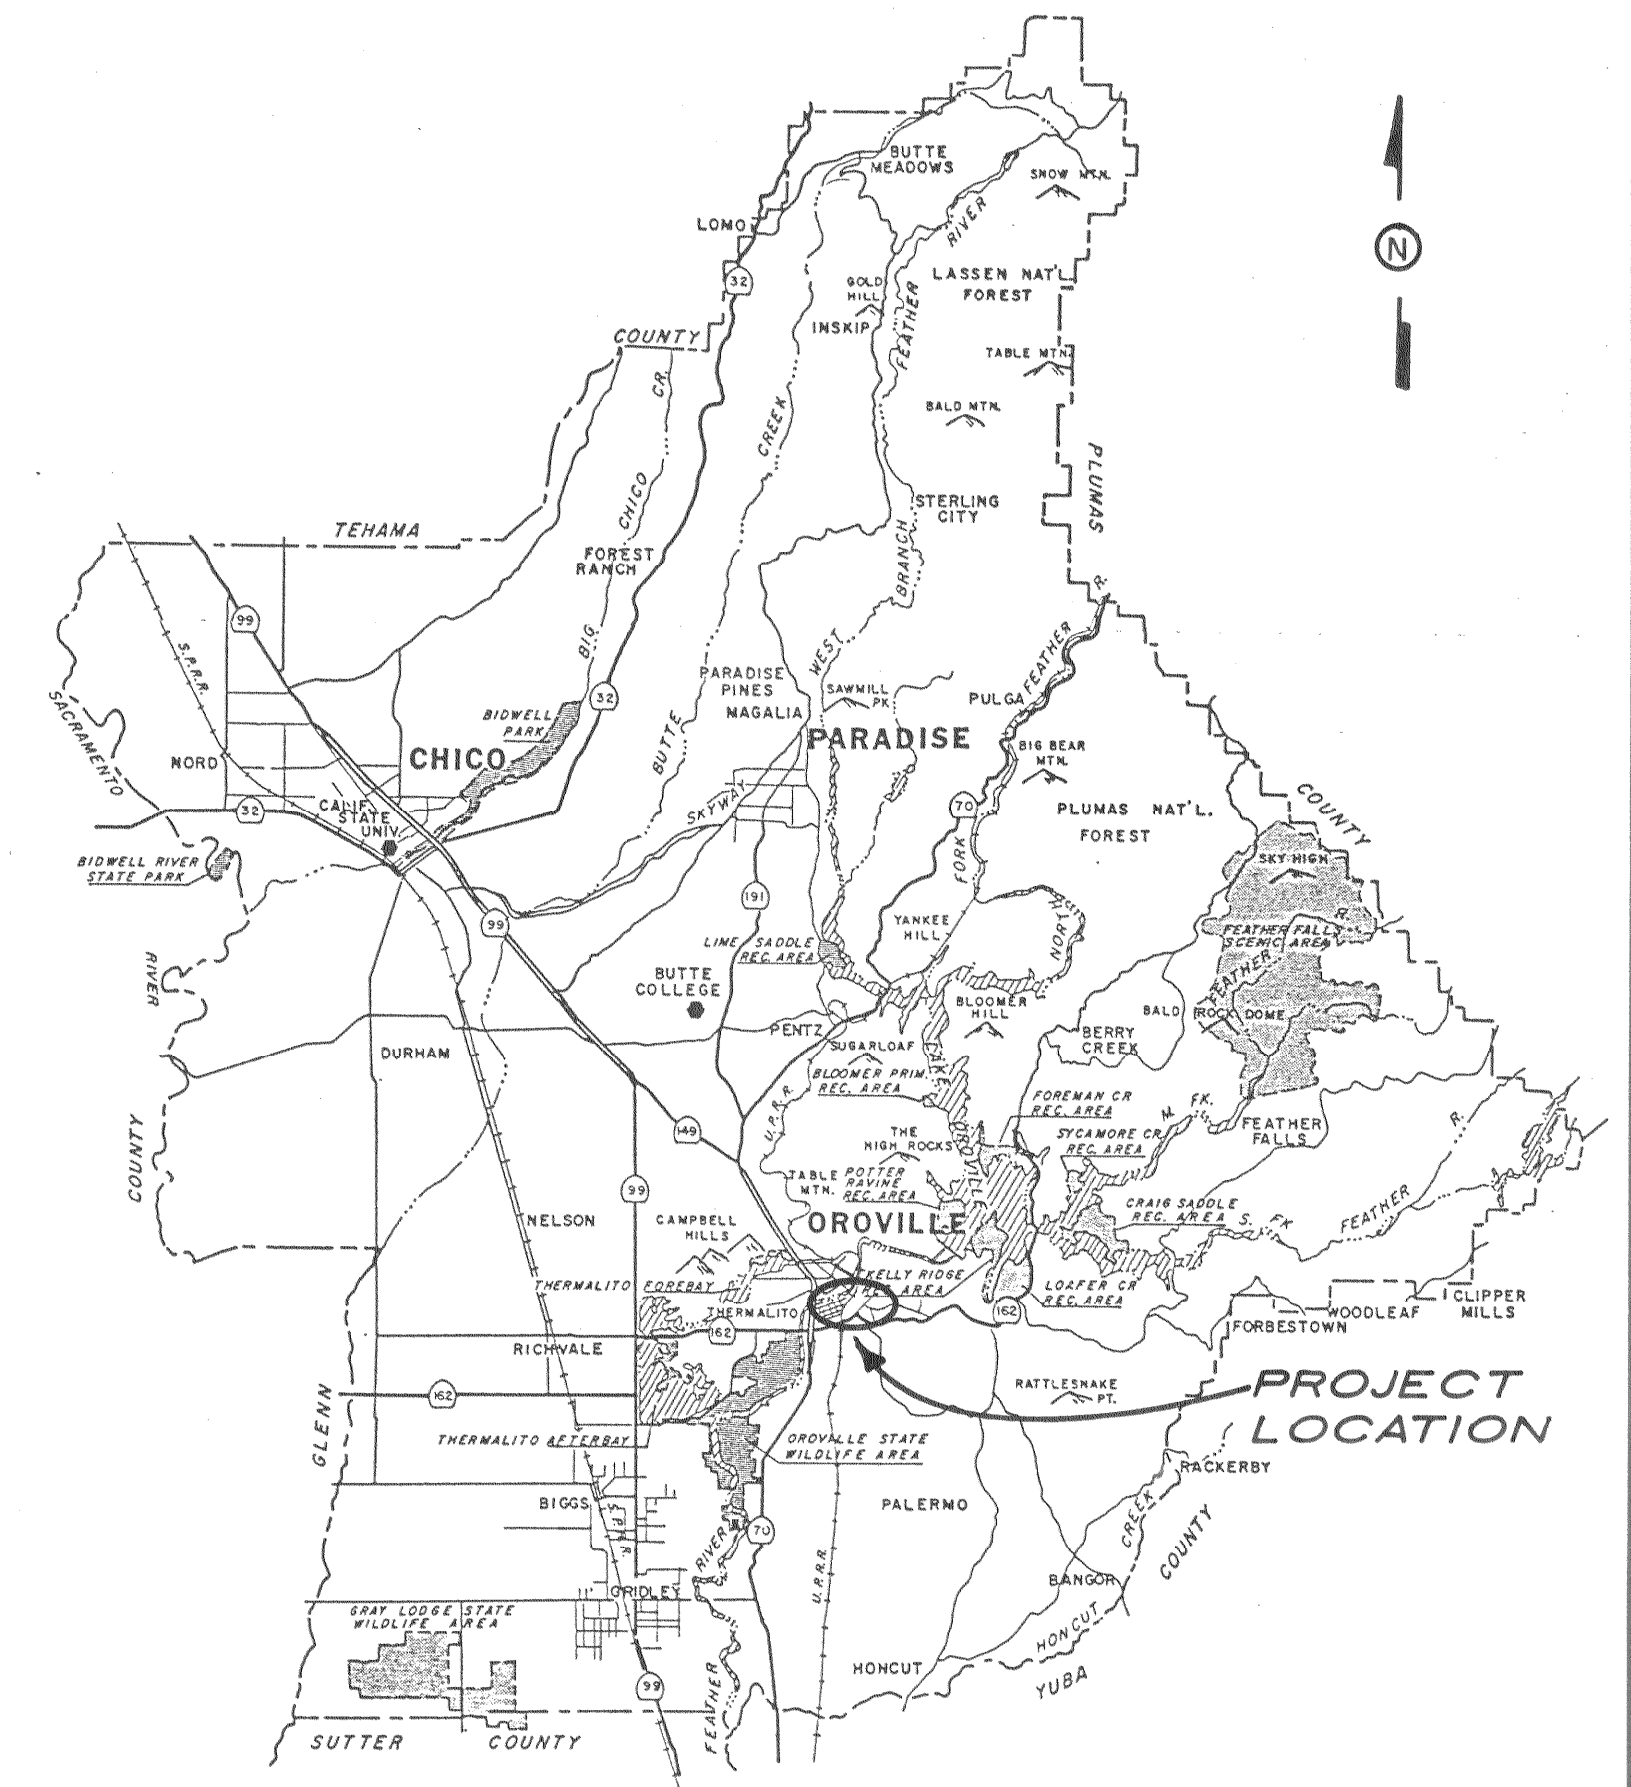


LOCATION MAP
N.T.S.

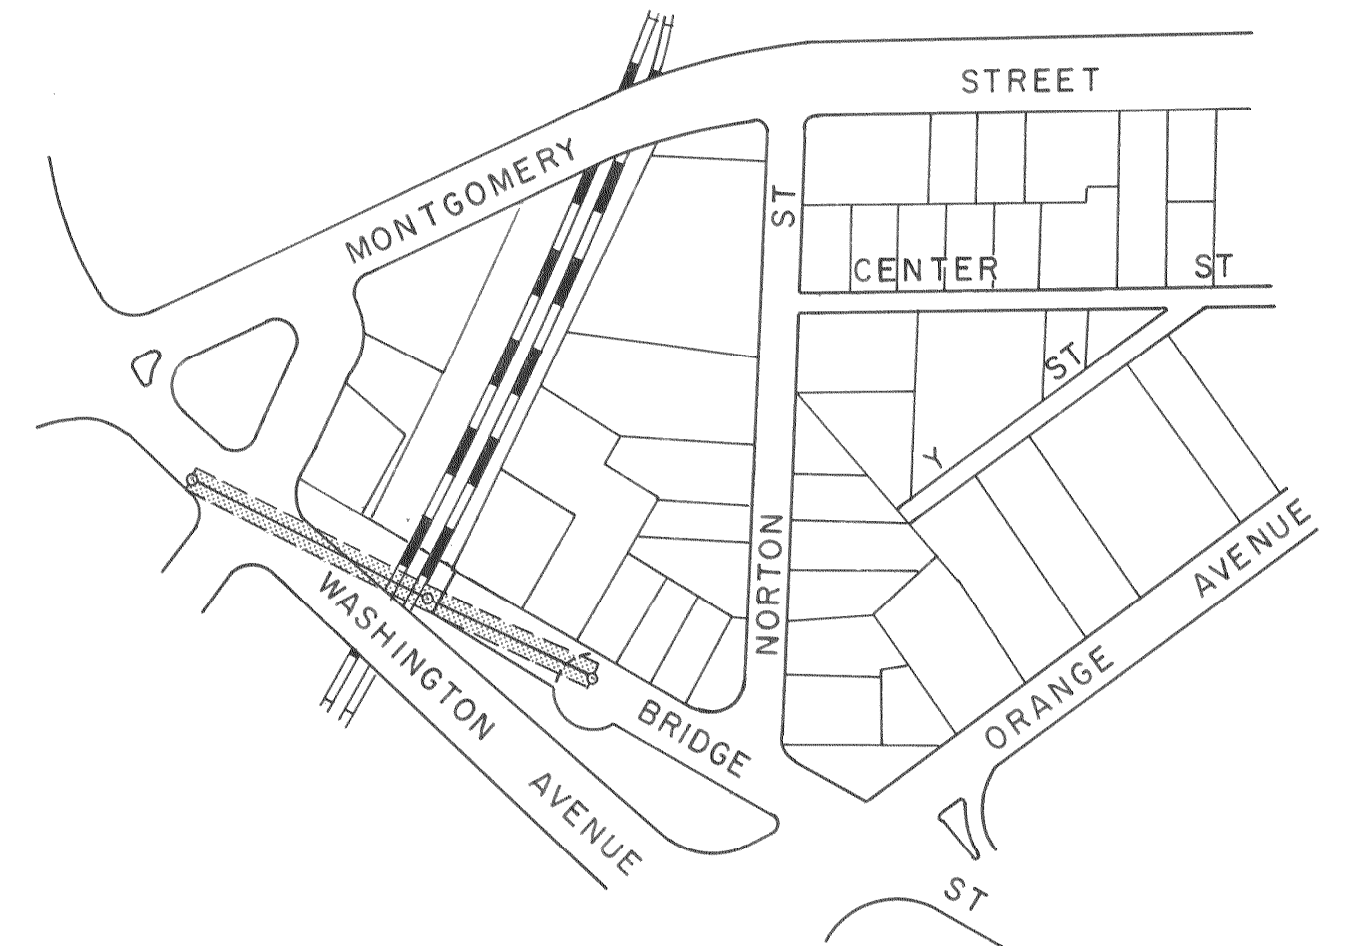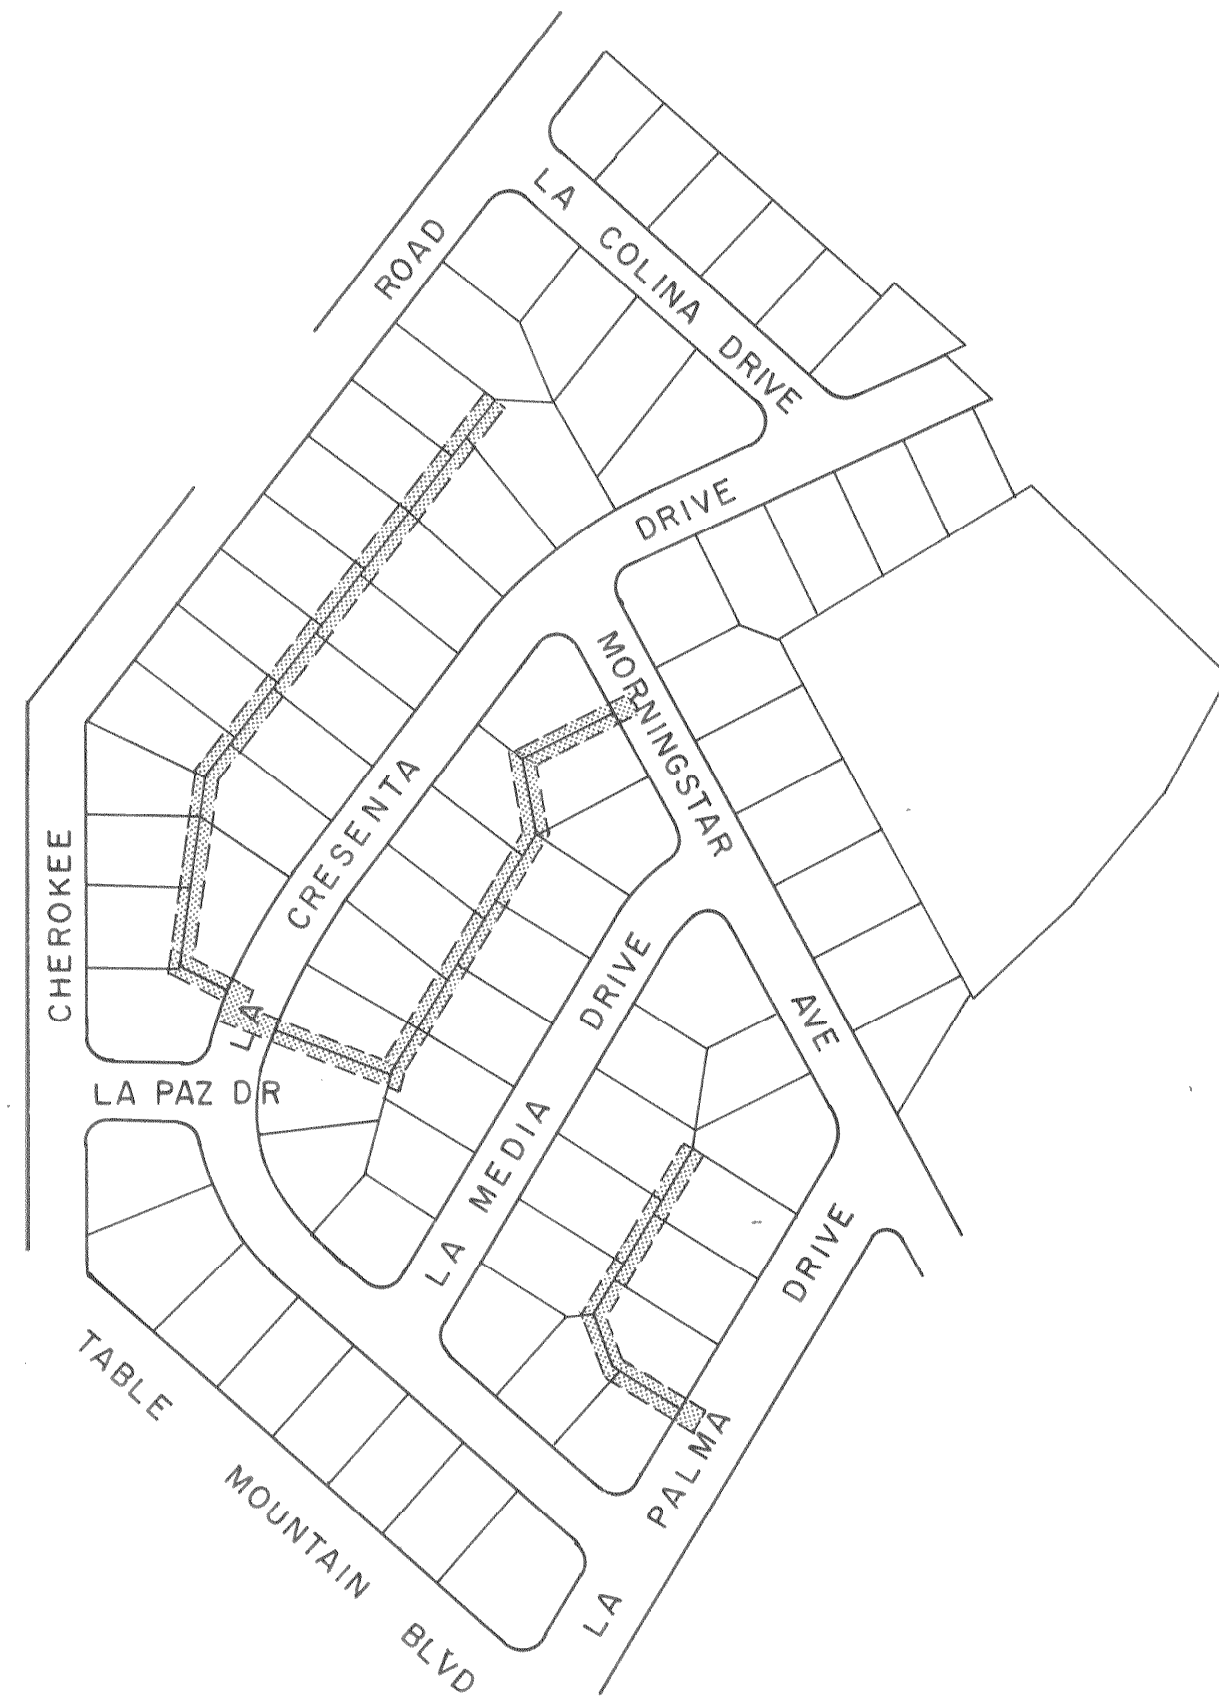

AS BUILT
LIMITS OF PROJECT

CITY OF OROVILLE
VICINITY MAP

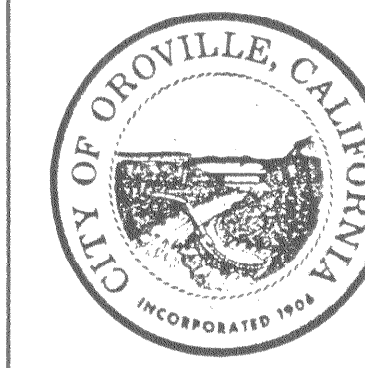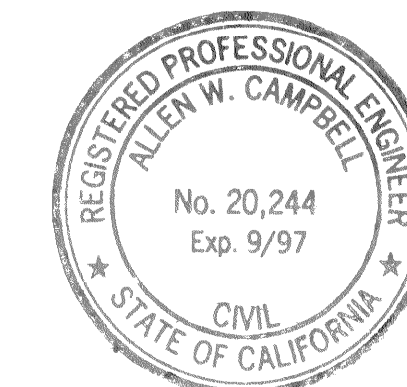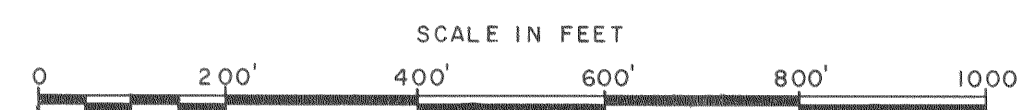

CITY OF OROVILLE
SANITARY SEWER MAIN
GROUT PROJECT

APPROVED BY <i>Allen W. Campbell</i> PUBLIC WORKS DIRECTOR	DESIGNED BY T.F.	DRAWING NO. 1
DATE 9-3-97	CHECKED BY T.F.	SHEET OF 2