

FOR USE WITH STANDARD SPECIFICATIONS AND STANDARD PLANS
DATED JULY, 1992 OF THE CALIFORNIA DEPT. OF TRANSPORTATION.

THE CONTRACTOR SHALL POSSESS A CLASS "A" LICENSE, OR A
COMBINATION OF CLASSES REQUIRED BY THE CATEGORIES AND
TYPE OF WORK INCLUDED IN THIS CONTRACT AT THE TIME THIS
CONTRACT IS AWARDED.

CITY OF OROVILLE


DEPARTMENT OF PUBLIC WORKS

PROJECT PLANS FOR REPAIR WORK
WITHIN THE CITY OF OROVILLE



SANITARY SEWER MAIN GROUT PROJECT

INDEX TO SHEETS

TITLE SHEET	SHEET 1
SEWER MAIN LOCATION SHEET	SHEET 2



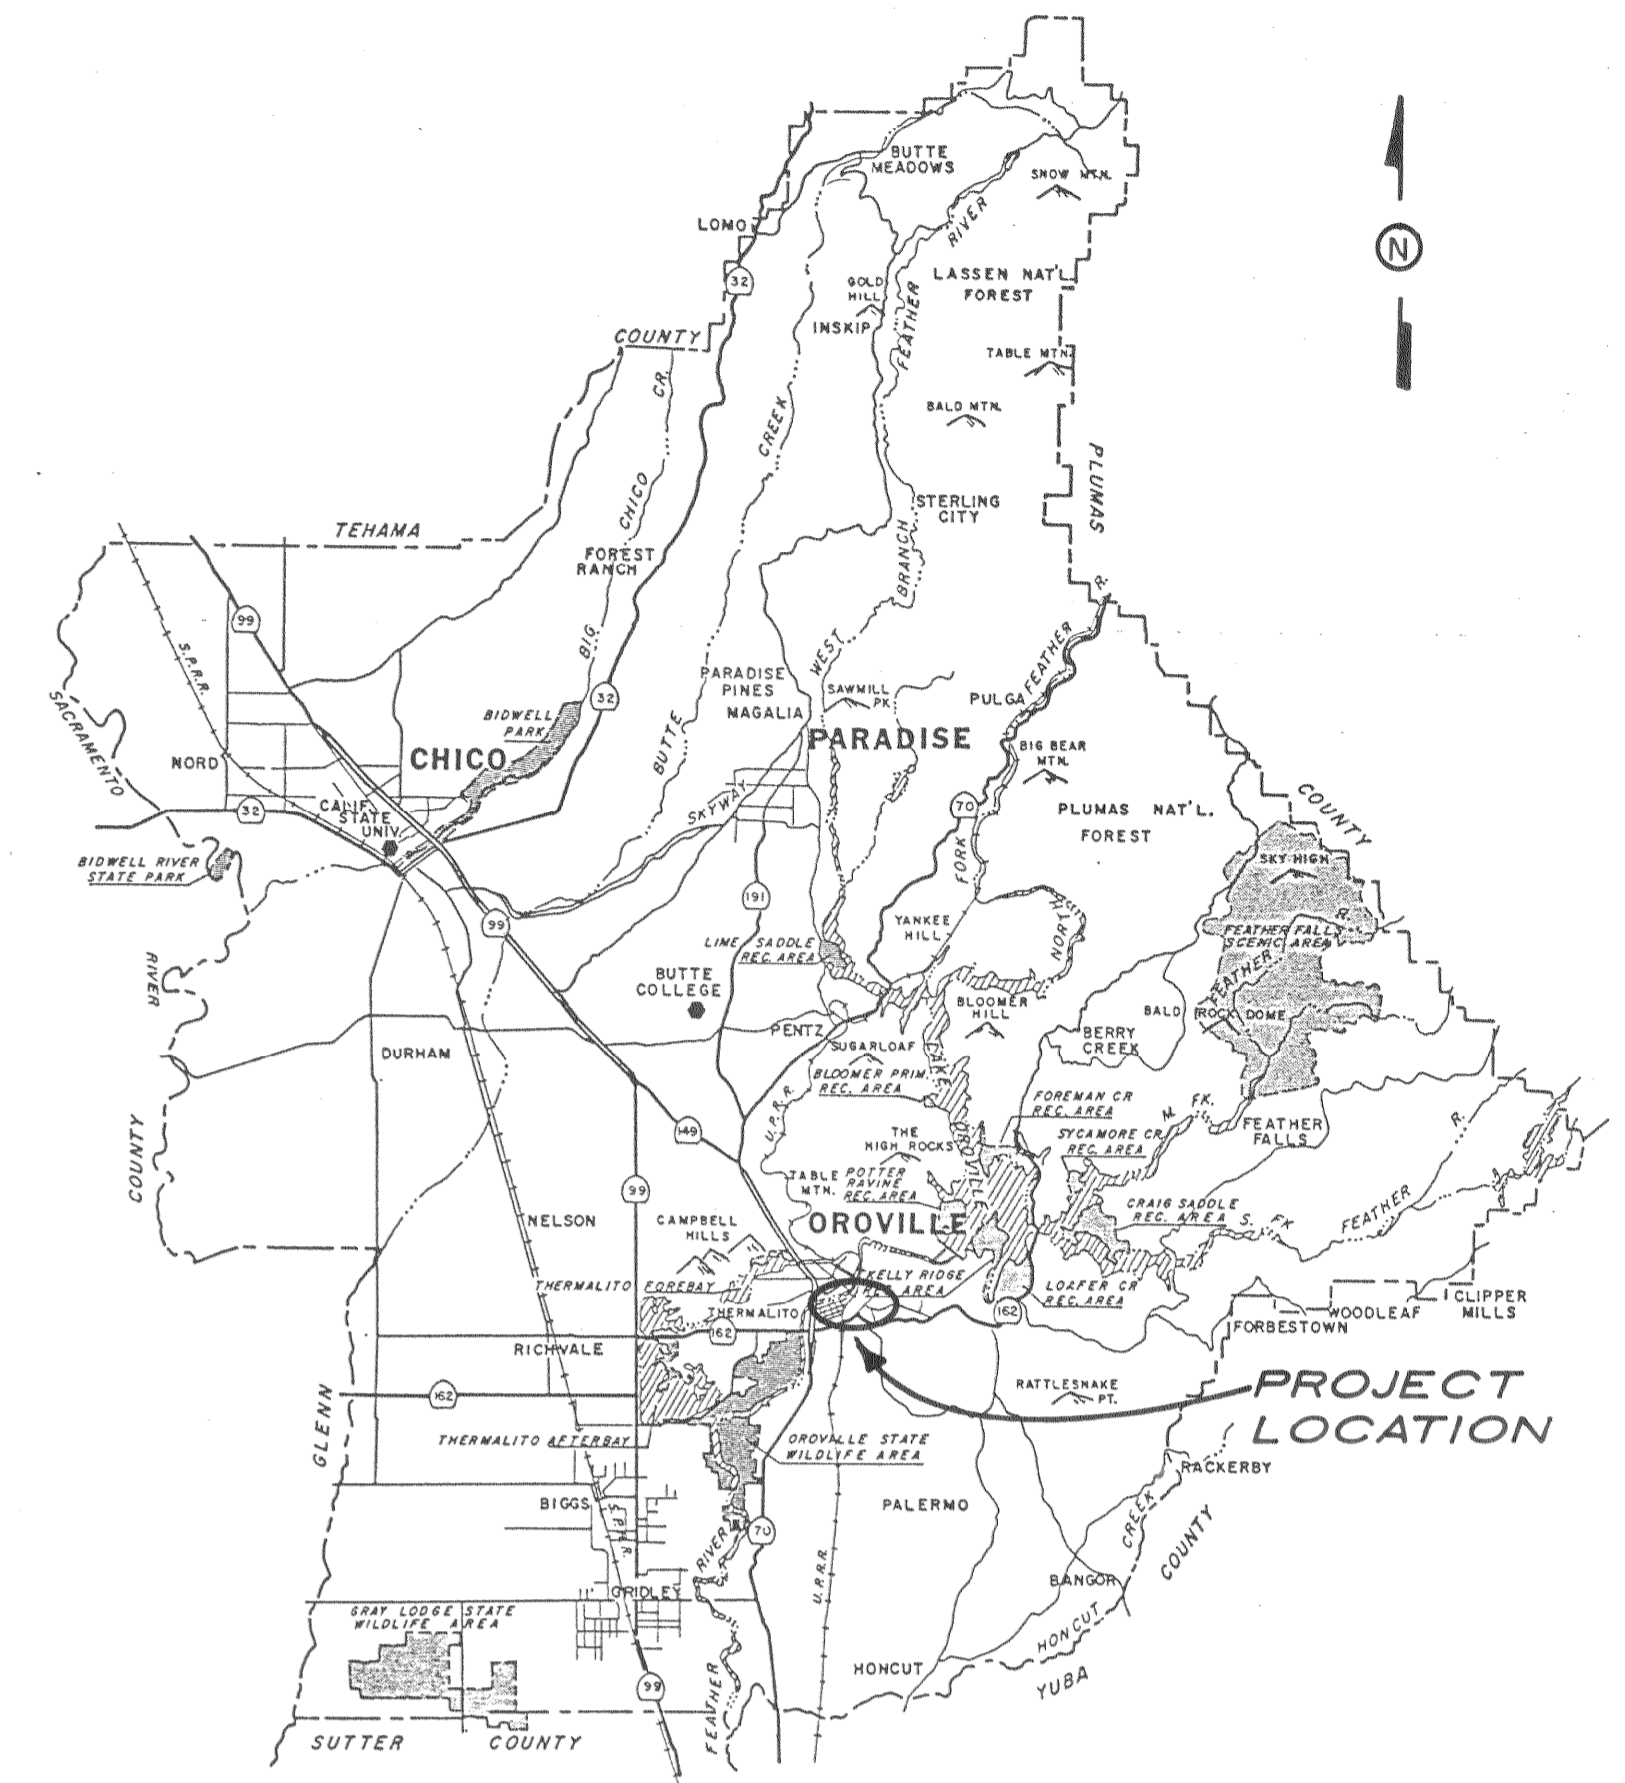


LOCATION MAP
N.T.S.

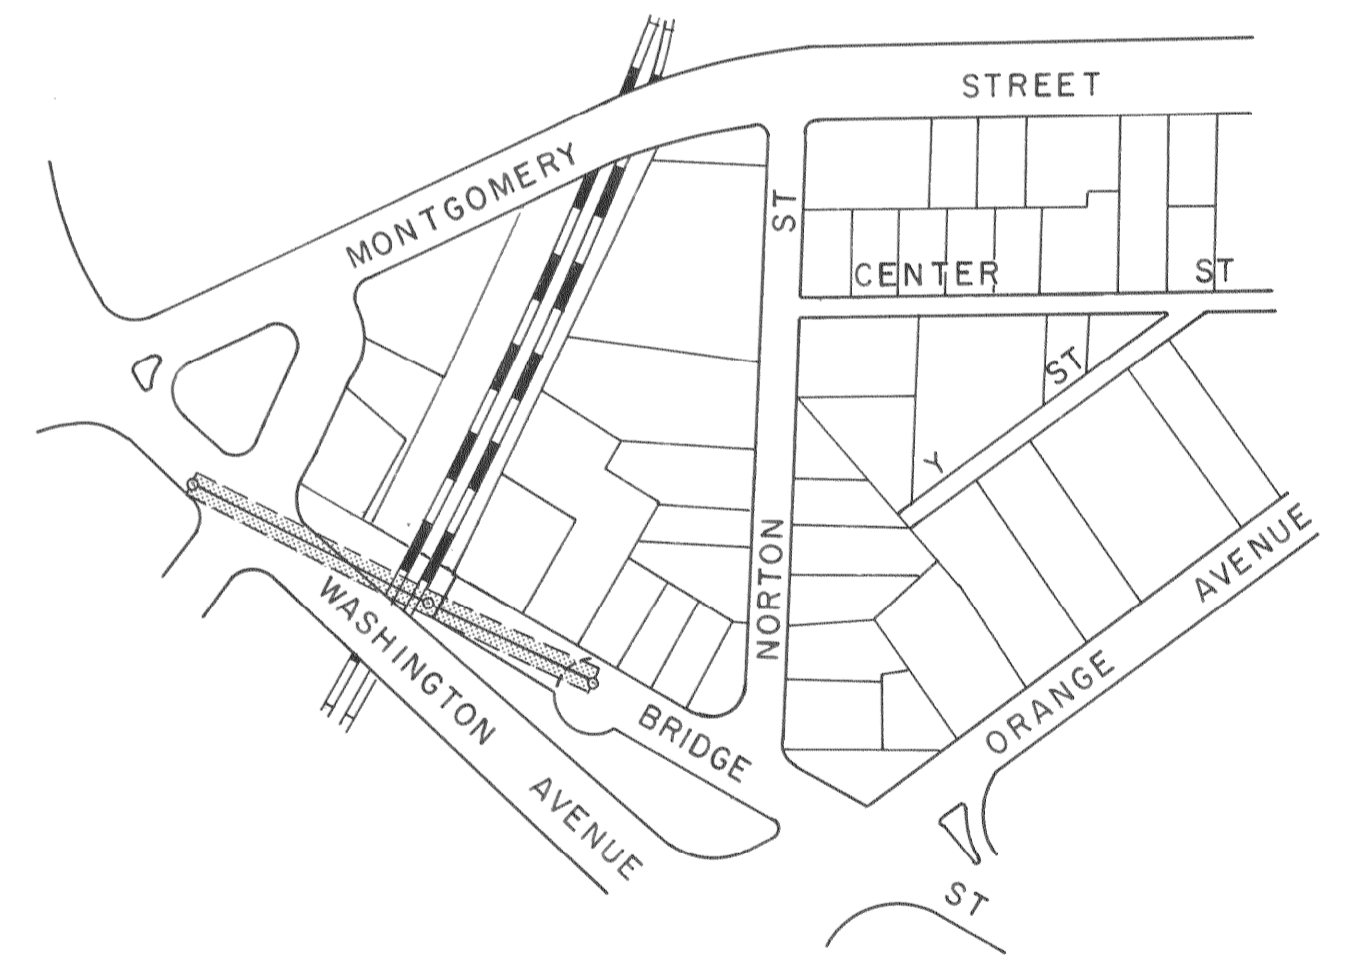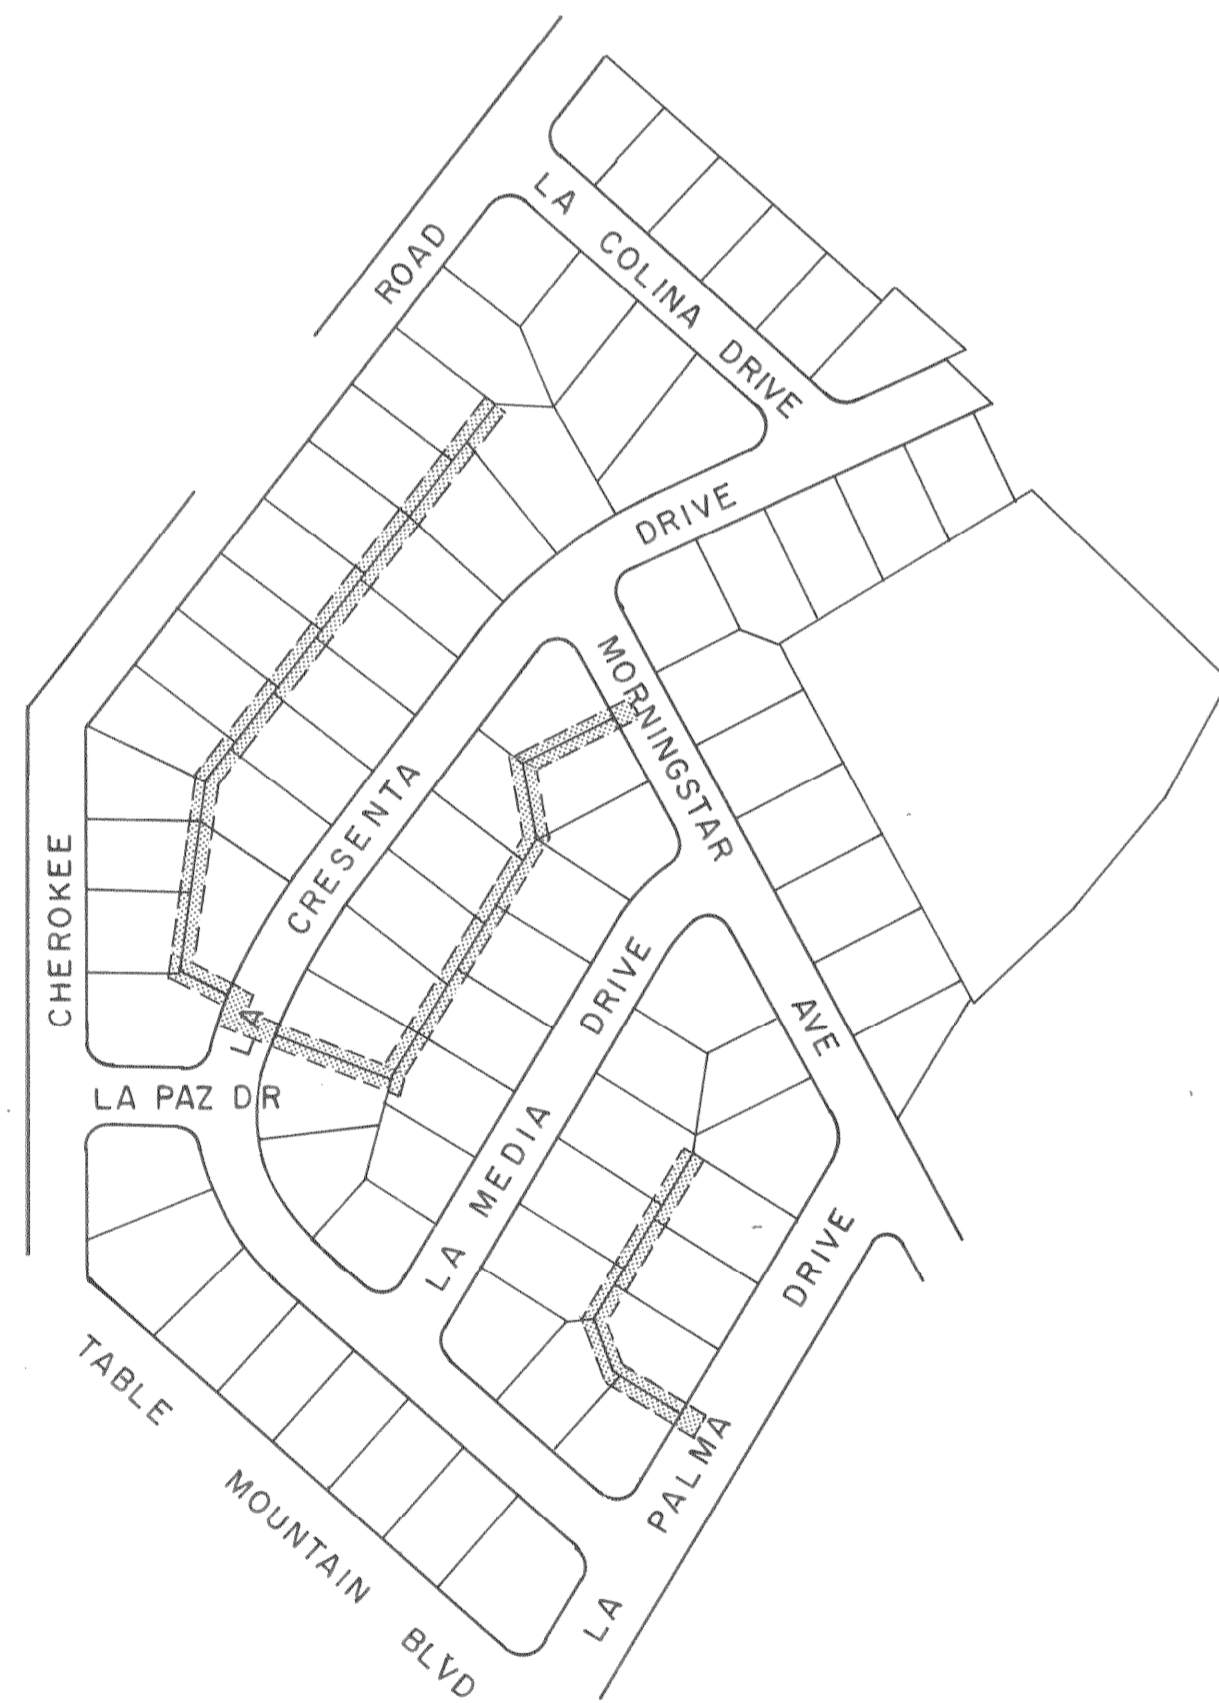

AS BUILT
LIMITS OF PROJECT

CITY OF OROVILLE
VICINITY MAP

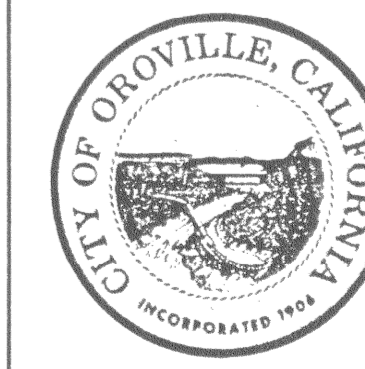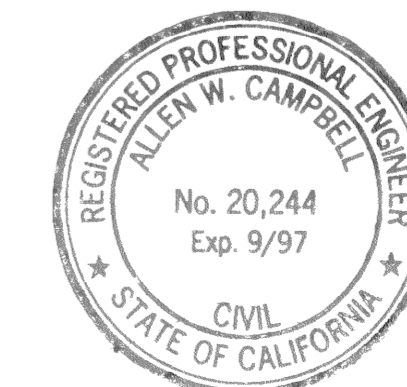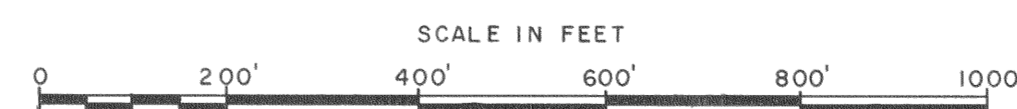

CITY OF OROVILLE SANITARY SEWER MAIN GROUT PROJECT

APPROVED BY <i>Allen W. Campbell</i> PUBLIC WORKS DIRECTOR	DESIGNED BY T.F.	DRAWING NO. 1
CHECKED BY 9-3-97 DATE	CHECKED BY T.F.	SHEET 2



SCALE 1" = 100'

LEGEND

- EXISTING 6" CLAY PIPE UNLESS OTHERWISE SO NOTED
- ▭ LIMITS OF SANITARY SEWER MAIN GROUT PROJECT
- JJ32 MANHOLE NUMBER
- CLEANOUT
- 20 STREET ADDRESS
- ▭ LIMITS OF SANITARY SEWER RELINE PROJECT (NOT A PART OF THIS CONTRACT) COMPLETED WITH SS-347

NOTES

1. ALL SANITARY SEWER MANHOLE AND CLEANOUT LOCATIONS ARE TO BE VERIFIED IN THE FIELD.
2. EXISTING SANITARY SEWER 6" CLAY PIPE LENGTHS MAY VARY FROM 3 FEET TO 5 FEET.

AS BUILT

	FIELD BOOK	DRAWN T.F.	APPROVED		CITY OF OROVILLE PUBLIC WORKS DEPARTMENT 1735 MONTGOMERY ST. OROVILLE, CA 95965 (916) 538-2420	FEATHER PORTAL UNIT NO.1/PLEASANT VALLEY TRACT AREA SANITARY SEWER MAIN GROUT PROJECT	SHEET 2 OF 2 SHEETS JOB NO.
	ELEVATION DATUM	DESIGNED A.C.	 DIRECTOR PUBLIC WORKS R.C.E. 20244 DATE 9-2-96				
		CHECKED					
DATE NO.	REVISION	BY APP'D		SCALE AS SHOWN			