


CITY OF OROVILLE

SANITARY SEWER REPLACEMENT PROJECT

Lincoln Street and Huntoon Street

GENERAL NOTES

1. All materials and construction shall be in strict conformance with requirements of the City of Oroville, and as set forth in specifications and as shown on these plans.
2. Approval of the City of Oroville representative is required on completed work prior to backfilling trenches. Work done without such approval shall be done at the Contractor's risk. Such approval, when given shall not relieve the Contractor from the responsibility of performing the work in an acceptable manner.
3. The types, locations, sizes and/or depths of existing underground utilities as shown on these improvement plans were obtained from sources of varying reliability. The Contractor is cautioned that only actual excavation will reveal the number, types, extent, sizes, location and depth of such underground utilities. However, the City of Oroville can assume no responsibility for the completeness or accuracy of its delineation of such underground utilities nor for the existence of other buried objects or utilities which may be encountered, but which are not shown on these drawings.
4. The Contractor is hereby notified that prior to commencing construction, he is responsible for contacting the utility companies involved and verifying at the Construction Site the locations of all utilities as shown on these improvement plans, or discovered in the field. Contractor shall notify Underground Service Alert (PH. 800-642-2444) 48 hours in advance of any work.
5. The Contractor shall remove all obstructions, both above the ground and underground, except as indicated on the plans, as necessary for the construction of the proposed improvements.
6. The Contractor shall be solely and completely responsible for condition of premises on which the work is performed and for safety of all persons and property on the site, both during and outside of normal working hours, until such work is accepted by the owner.
7. Sufficient equipment shall be available to provide dust control at all times during construction operations. Areas surrounding the work shall be kept clean and returned to original conditions upon completion of this contract.
8. The Contractor shall, at all times, coordinate his work with that of others on the site.
9. The Contractor shall provide construction area traffic control devices as per section 12 of the State Standard Specifications.
10. All salvaged material shall become the property of the Contractor unless otherwise noted.
11. The Contractor shall be responsible for the protection of all existing monuments and other survey markers during construction. All such monuments and markers destroyed during construction shall be replaced at Contractor's expense.
12. The Contractor shall obtain an Encroachment Permit from the City of Oroville prior to beginning any work within the right-of-way.
13. No person shall enter a trench or excavation 5 feet deep or more unless protected with a system of shoring, sloping or benching, or equivalent alternate. The Contractor shall be responsible for complying with all requirements of the Division of Occupational Safety and Health, to include obtaining any necessary permits.
14. At the completion of work each day, the Contractor shall secure the job site by backfilling or steel plating any open trenches, method subject to approval by the Engineer, and ensuring that the proper barricades and/or warning devices are placed where needed.

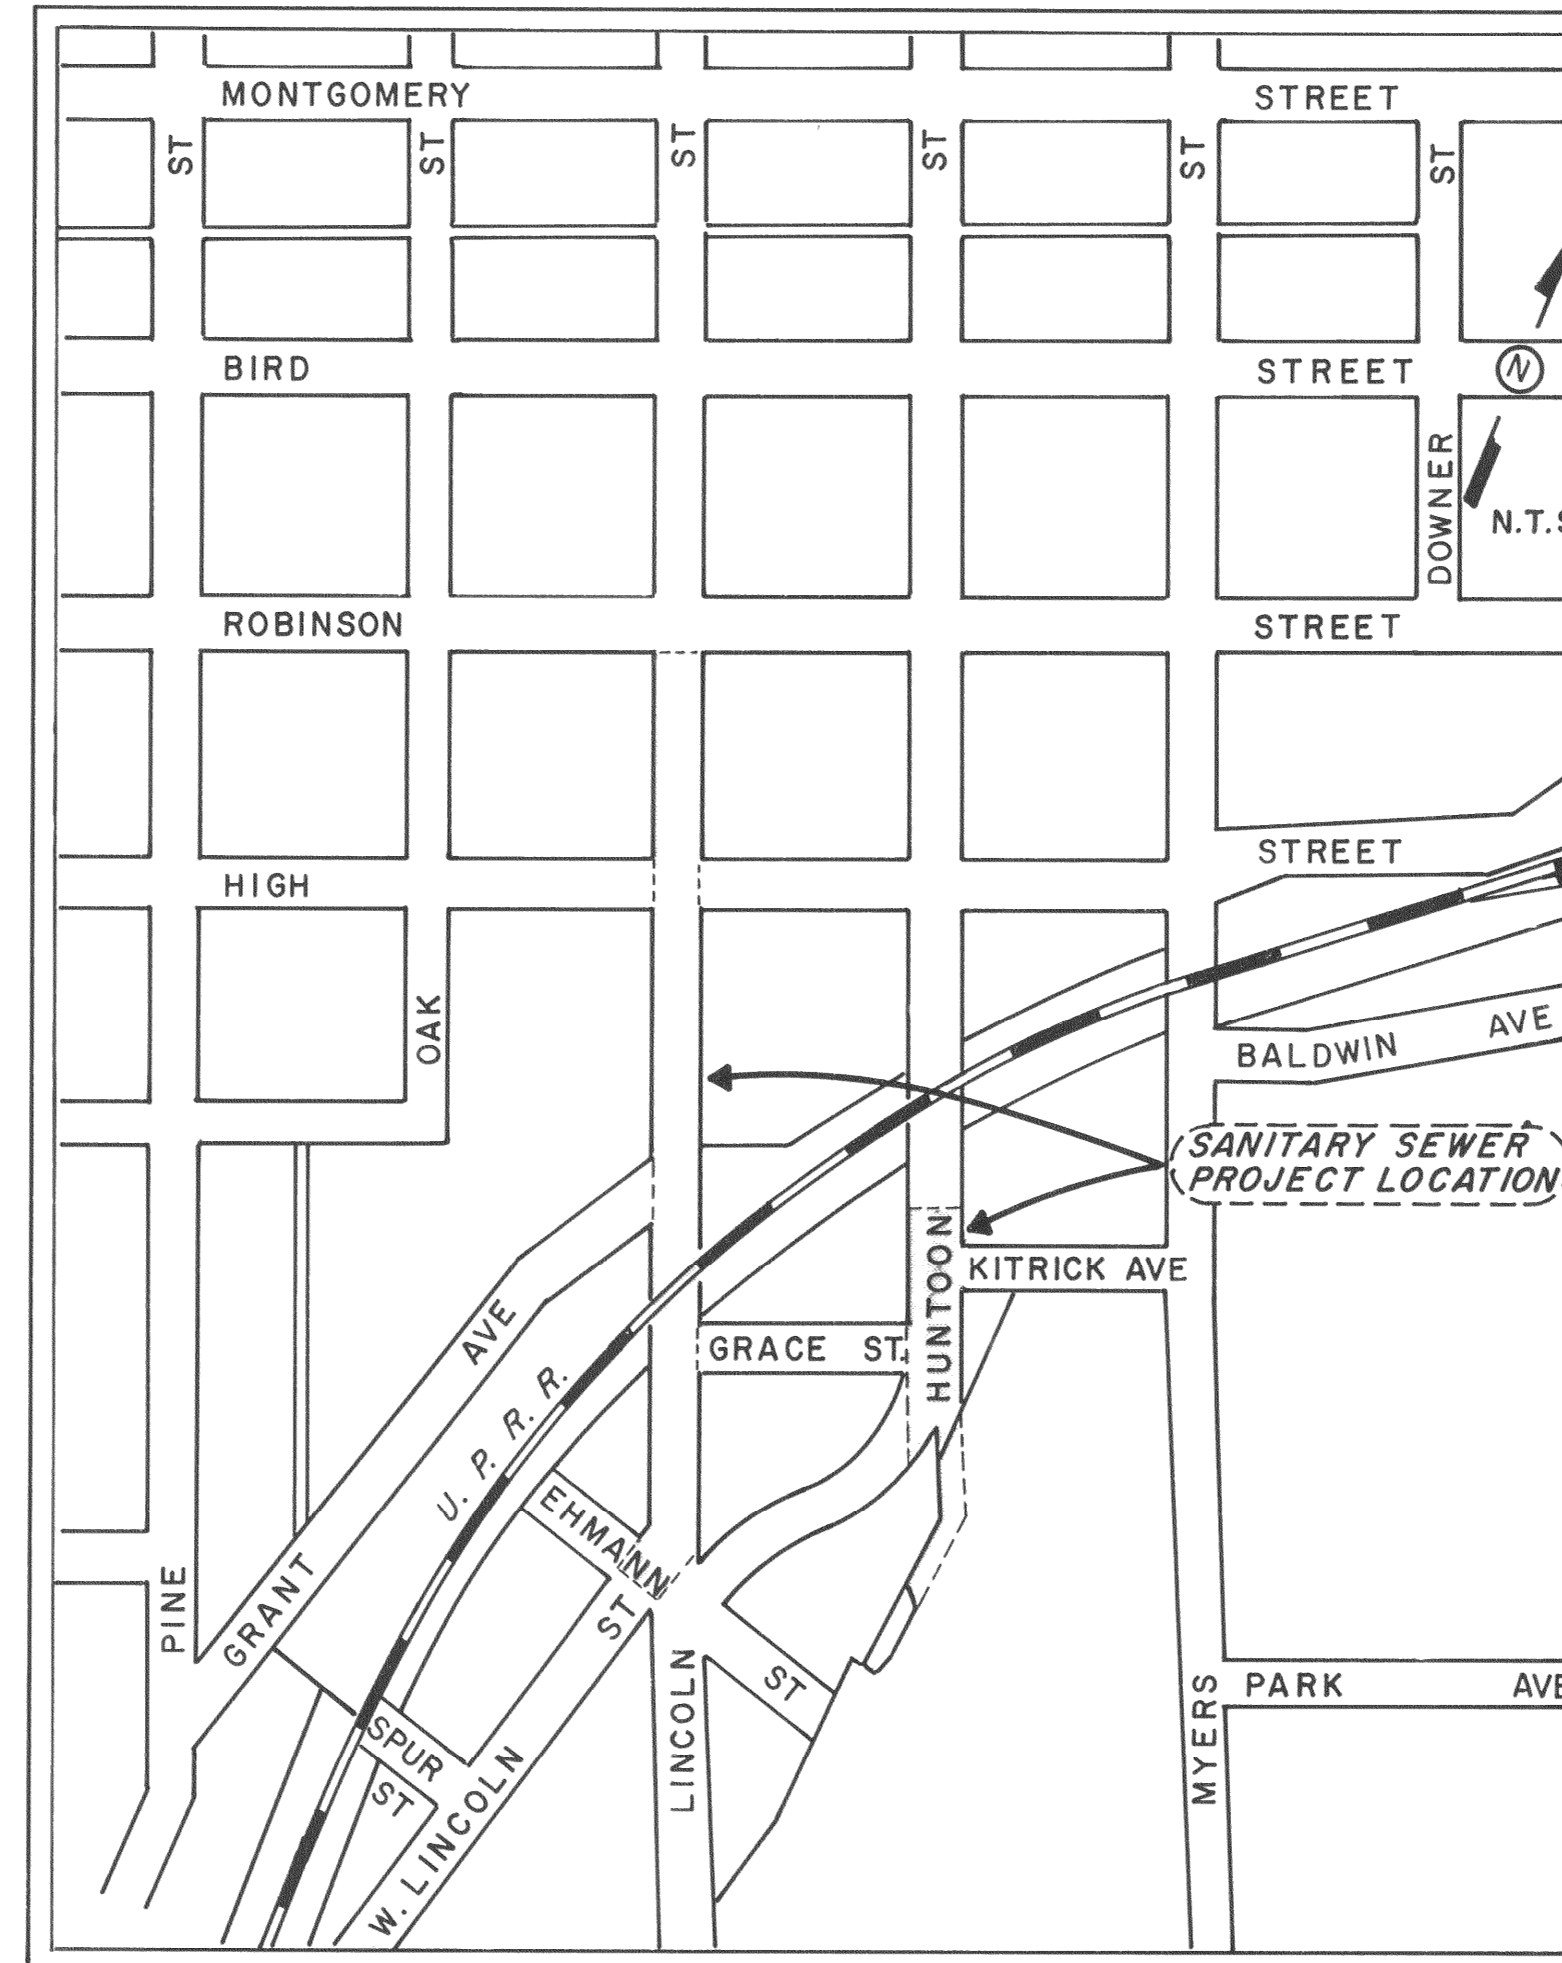

LOCATION MAP

APPLICABLE CITY STANDARDS AND DETAILS


(SEE SPECIFICATION BOOK)

1. ST-34 STANDARD PAVEMENT REPLACEMENT DETAILS
2. SS-01 HOUSE SERVICE CONNECTION TO SANITARY SEWER
3. SS-02 SANITARY SEWER MANHOLE
4. SS-03 STANDARD DROP MANHOLE FOR SANITARY SEWER
5. SS-06 SANITARY SEWERS - FLUSHING BRANCH

		FIELD BOOK	DRAWN T.F.	APPROVED <i>Michael</i>	CITY OF OROVILLE PUBLIC WORKS DEPARTMENT	TITLE SHEET	SHEET 1 OF 4
		ELEVATION DATUM	DESIGNED J.J.	No. C 041977 EXP 3/31/92 CIVIL	1675 MONTGOMERY ST. OROVILLE, CA 95965 (916) 538-2420	SANITARY SEWER REPLACEMENT PROJECT	SHEETS
DATE NO.	REVISION	BY APP'D	CHECKED J.J.	DIRECTOR PUBLIC WORKS R.C.E. 4/977 DATE 5/5/89		LINCOLN STREET AND HUNTOON STREET	JOB NO.
			SCALE				SS - 330


PLAN SURVEYED BY DATE
 NOTED CHECKED
 NOTE BOOK, ALIGNMENT CHECKED, # FT. OF WAY CHECKED
 No. 1

PROFILE SURVEYED BY DATE
 NOTED CHECKED
 NOTE BOOK, GRADE CHECKED, # OF HORIZONTAL CURVES CHECKED
 No. 1

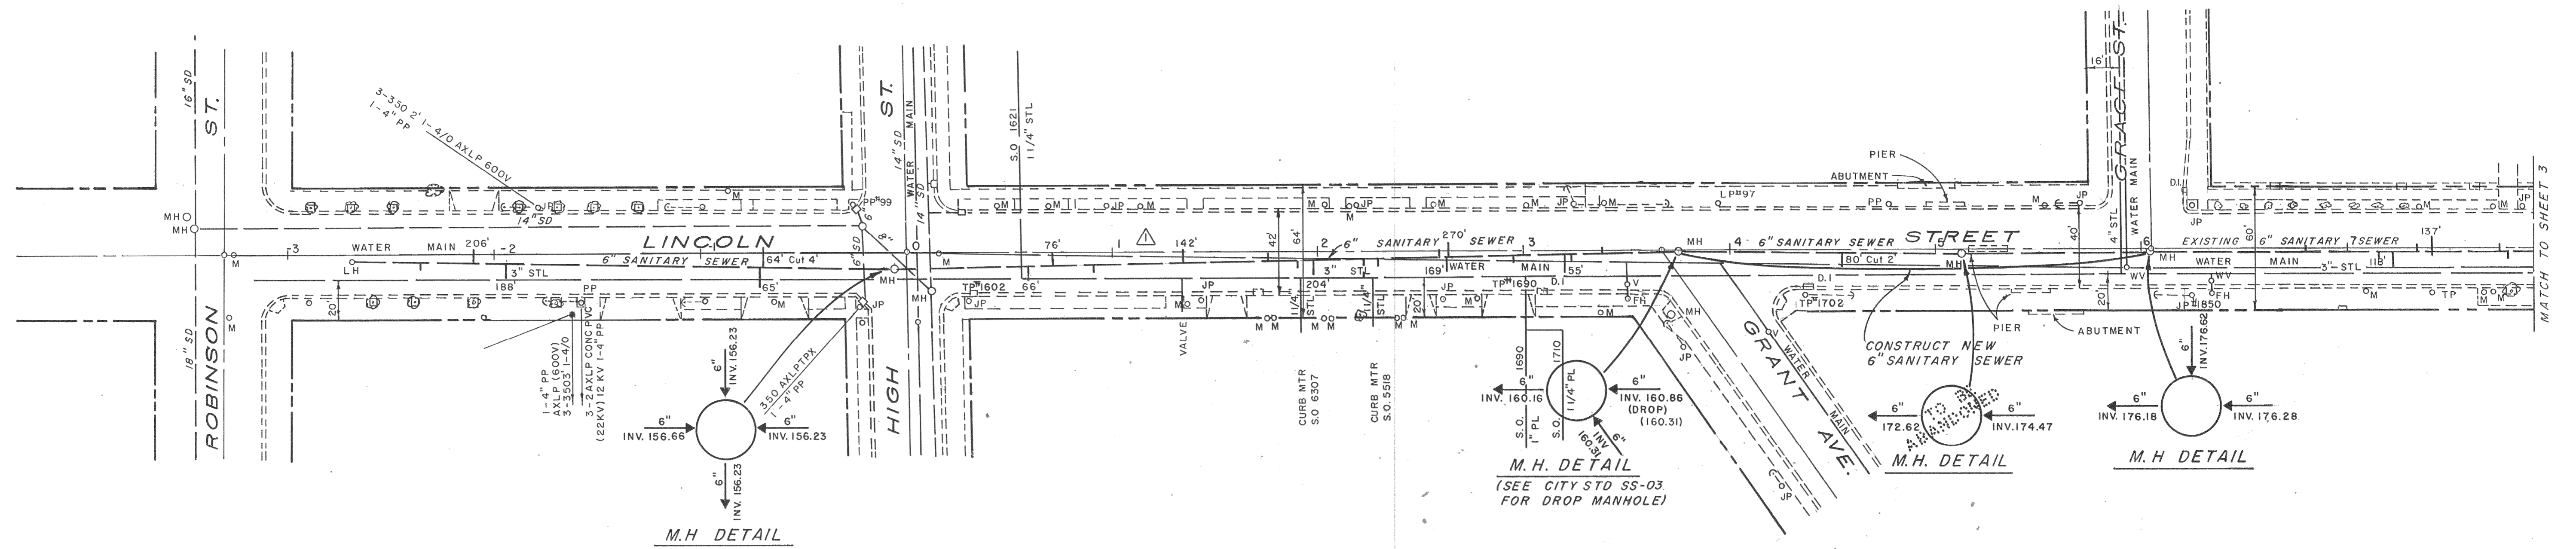

TBM
 TOP OF FIRE HYDRANT WEST OF
 LINCOLN STREET
 STA 6+32.50 RT
 ELEV. 189.24

SCALE
 HORZ. 1" = 40'
 VERT. 1" = 4'

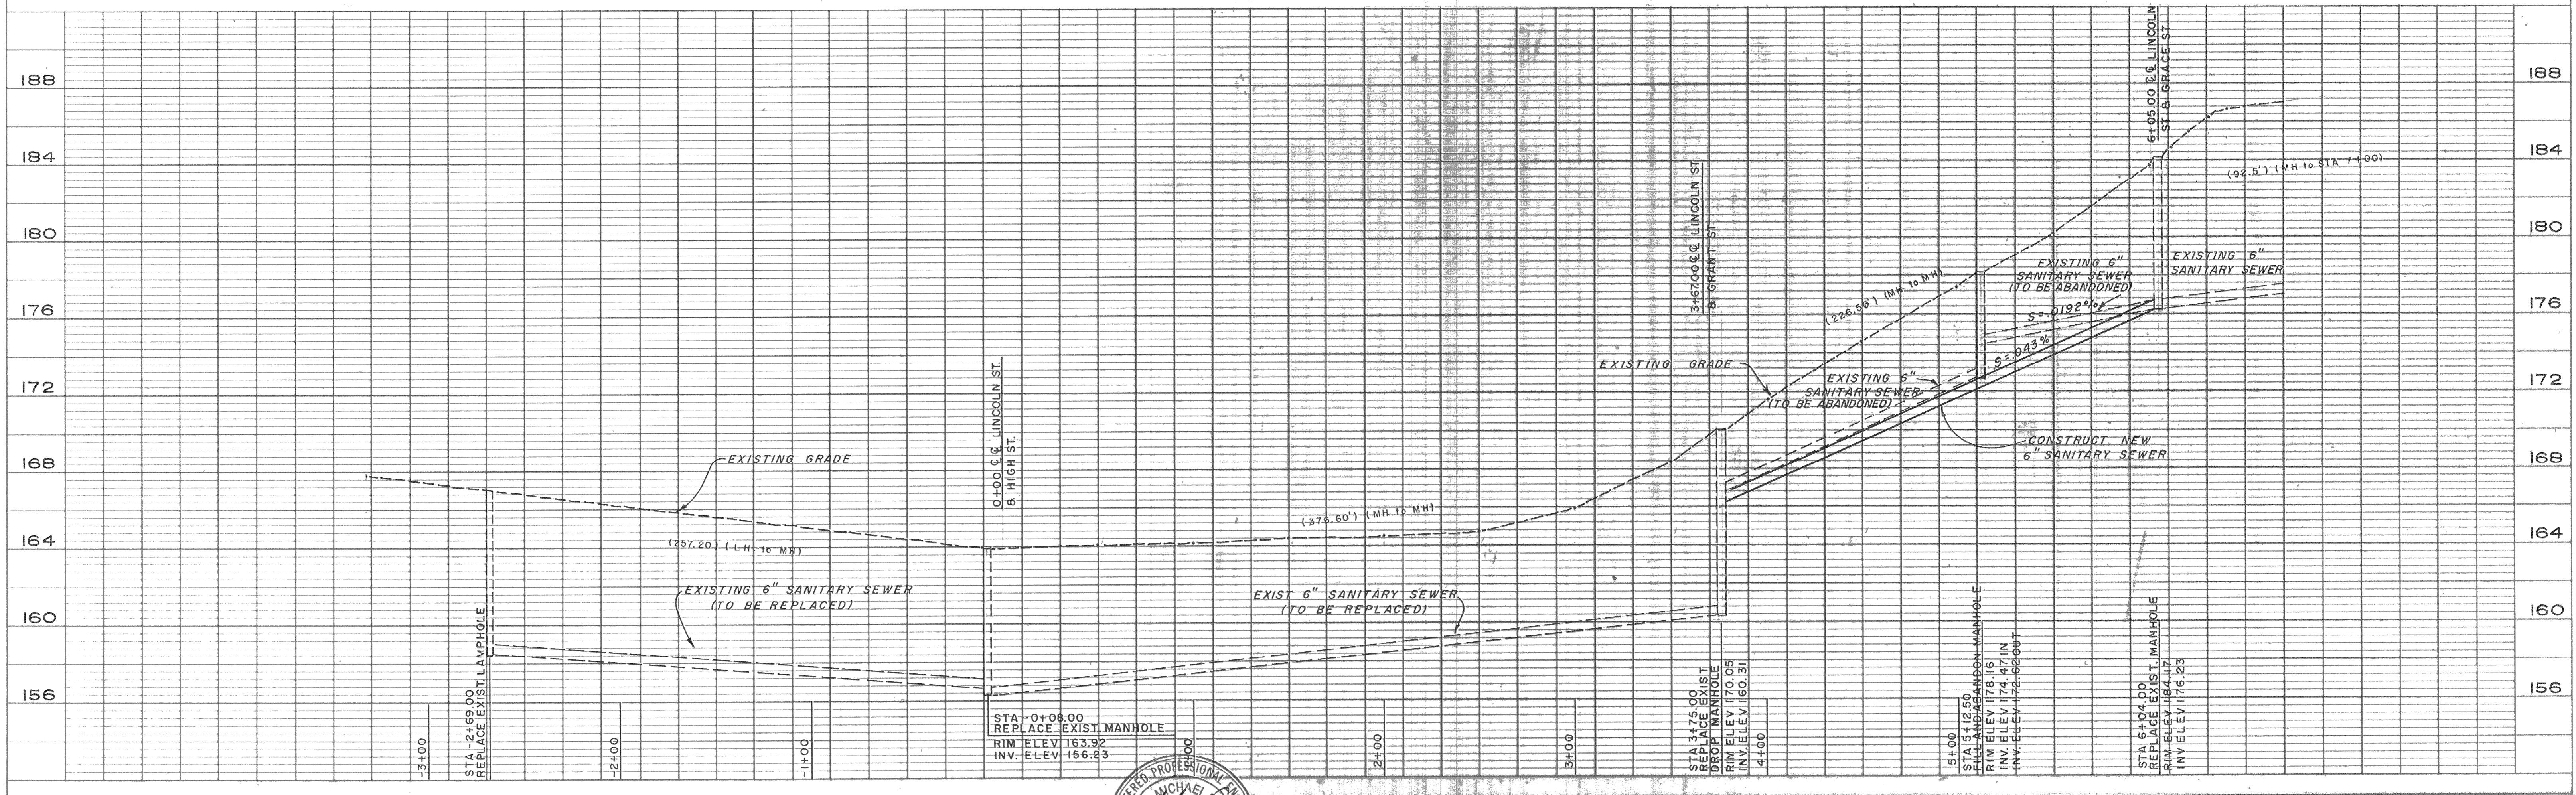

1-7-94	▲ S.S. LATERALS, WATER MAIN & GAS	T.F.
DATE NO.	REVISION	BY APP'D

FIELD BOOK	DRAWN
ELEVATION DATUM	T.F.
	DESIGNED
	J.J.
	CHECKED
	J.J.
	SCALE

APPROVED
 No. C 041977
 EXP 5/31/92
 CIVIL
 STATE OF CALIFORNIA
 DIRECTOR PUBLIC WORKS R.C.E. 41977 DATE 5/5/89



CITY OF OROVILLE
 PUBLIC WORKS DEPARTMENT
 1675 MONTGOMERY ST.
 OROVILLE, CA 95965 (916) 538-2420

SANITARY SEWER REPLACEMENT
 PROJECT
 LINCOLN STREET


SHEET
 2 OF 4
 SHEETS
 JOB NO.

DATE
BY
PLAN SURVEYED
PLOTTED
NOTE BOOK
ALIGNMENT CHECKED
AT 07/04/08

DATE
BY
PROFILE SURVEYED
GRADES CHECKED
NOTE BOOK
B.M.'S NOTED
STRUCTURE NOTATIONS CHECKED

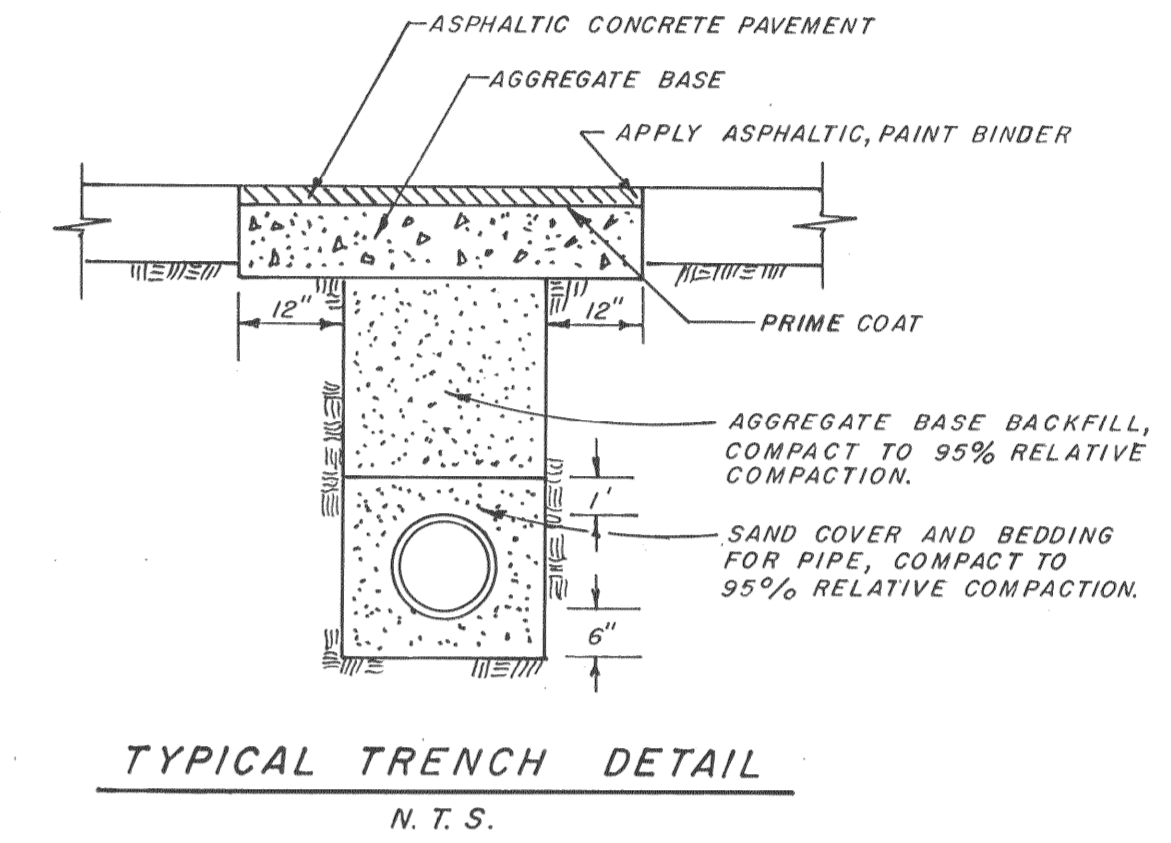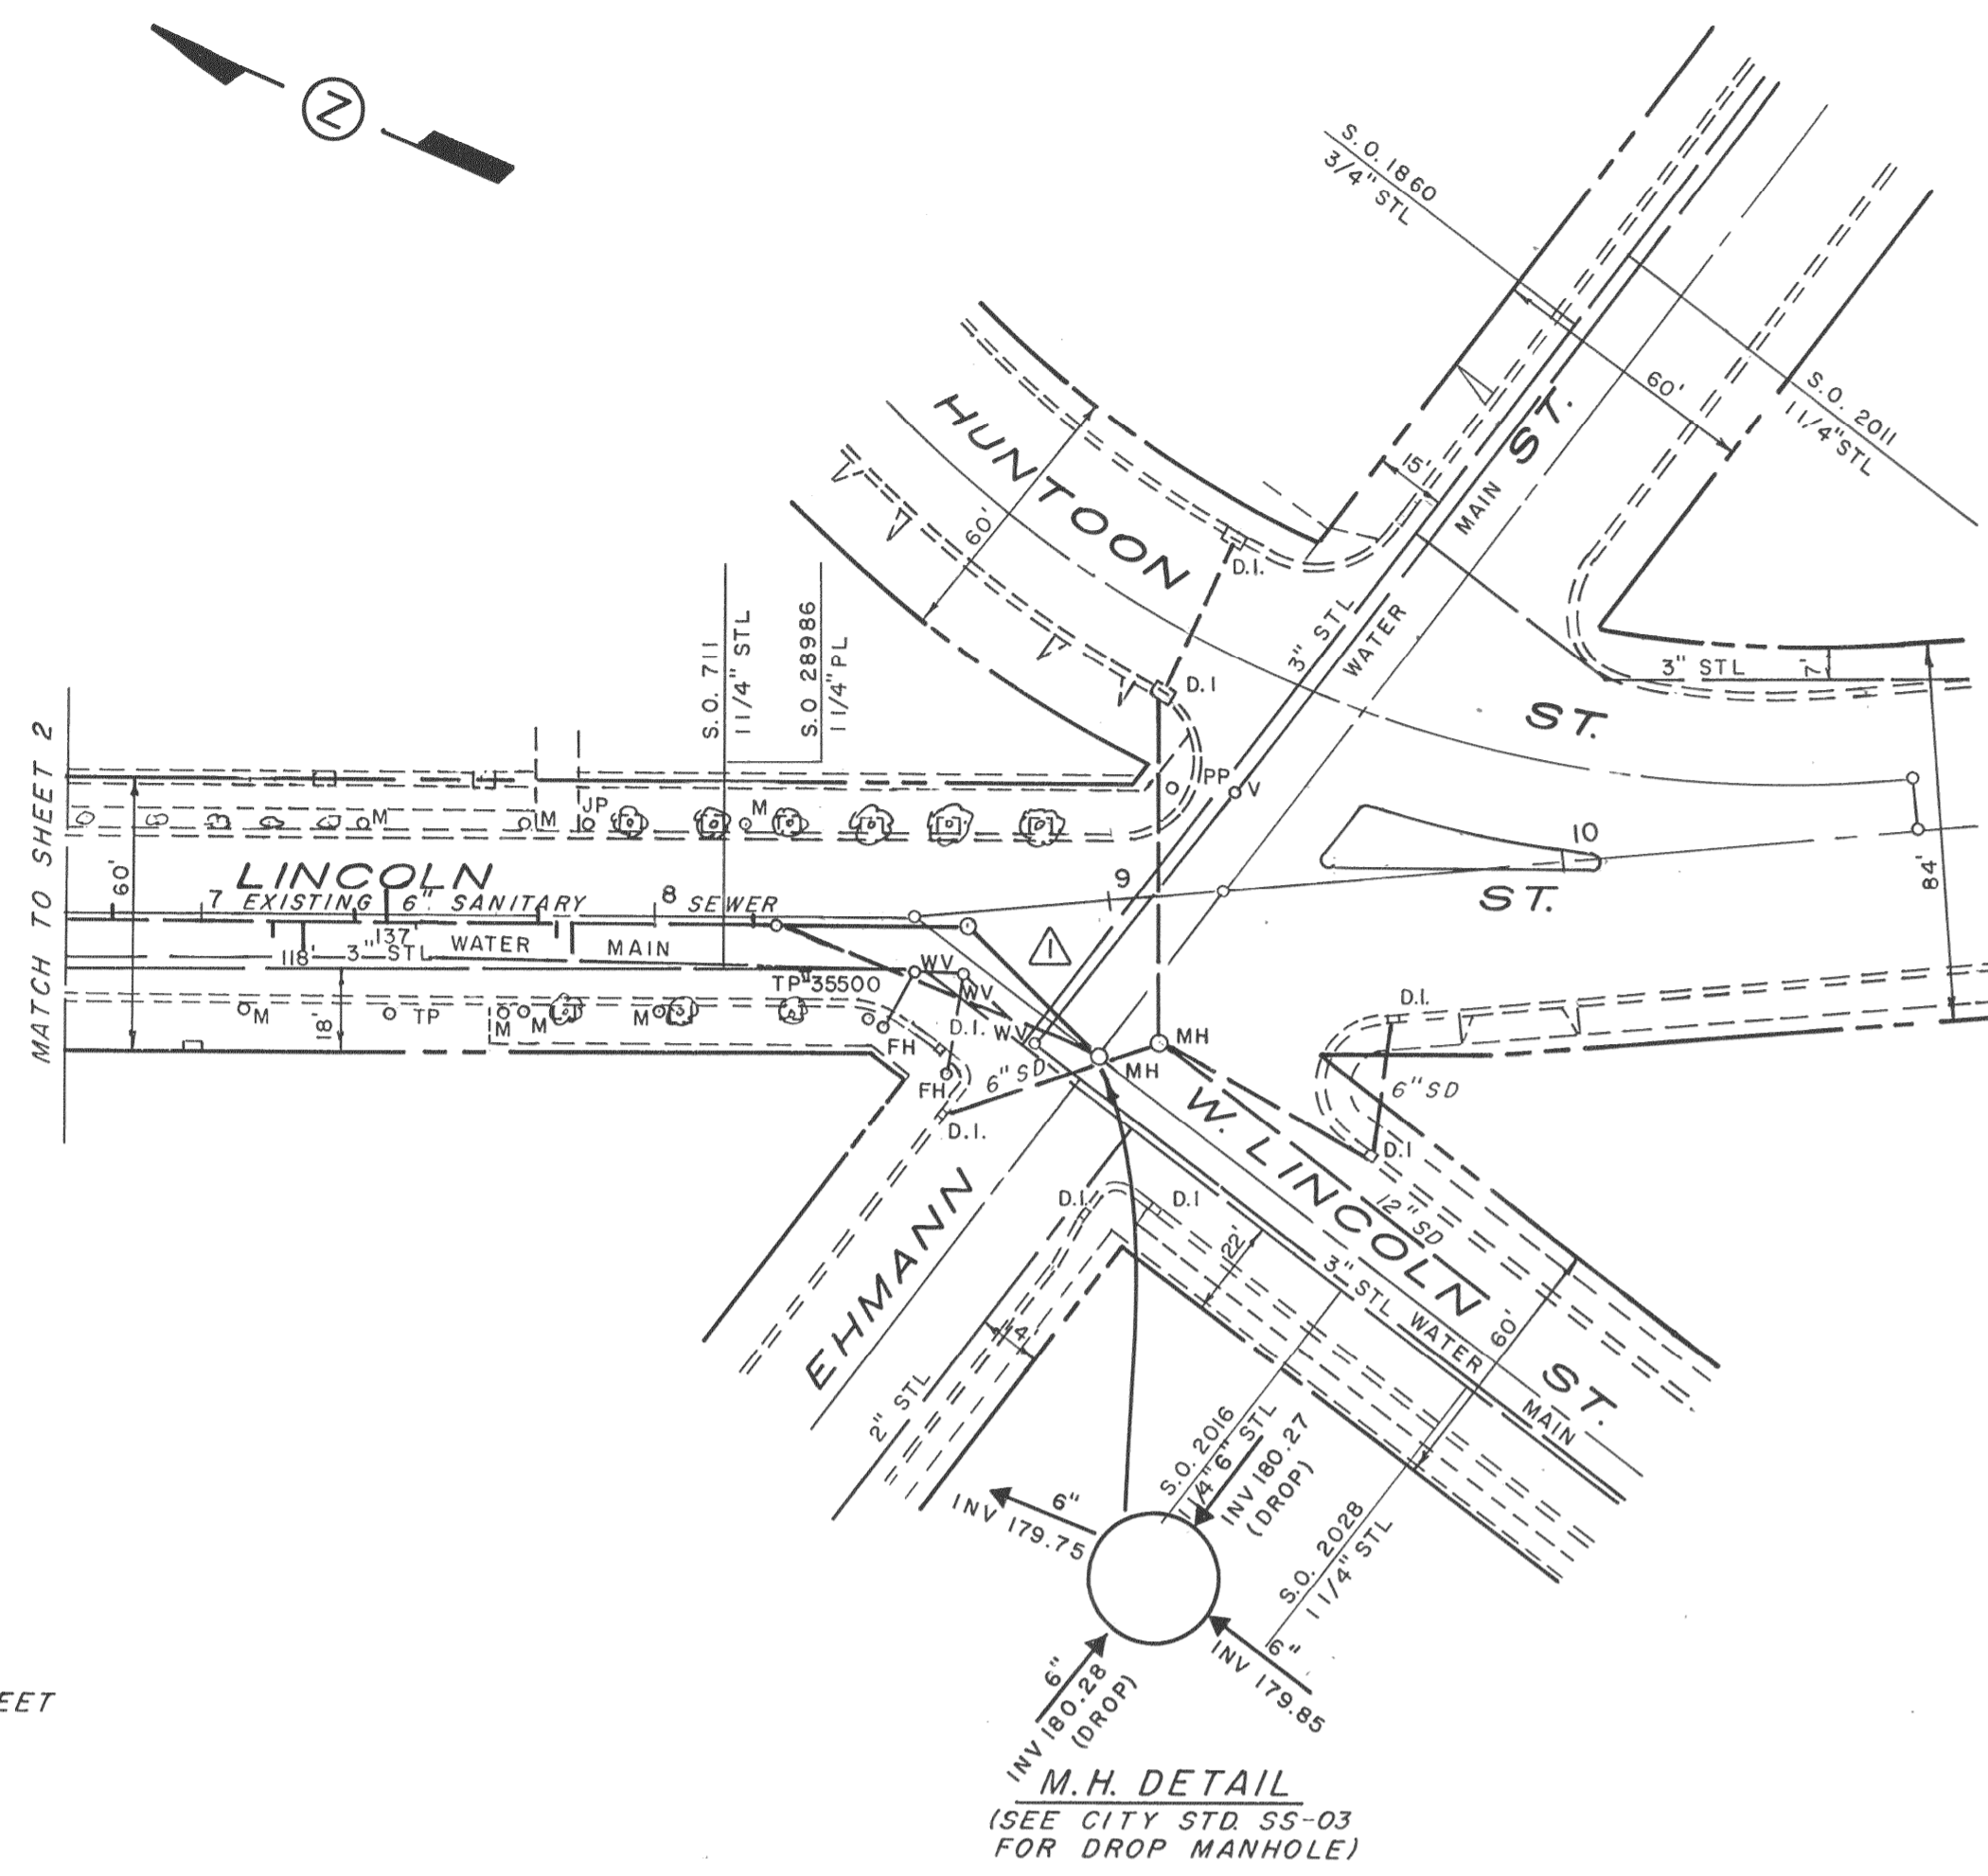

SCALE
HORZ. 1" = 40'
VERT. 1" = 4'

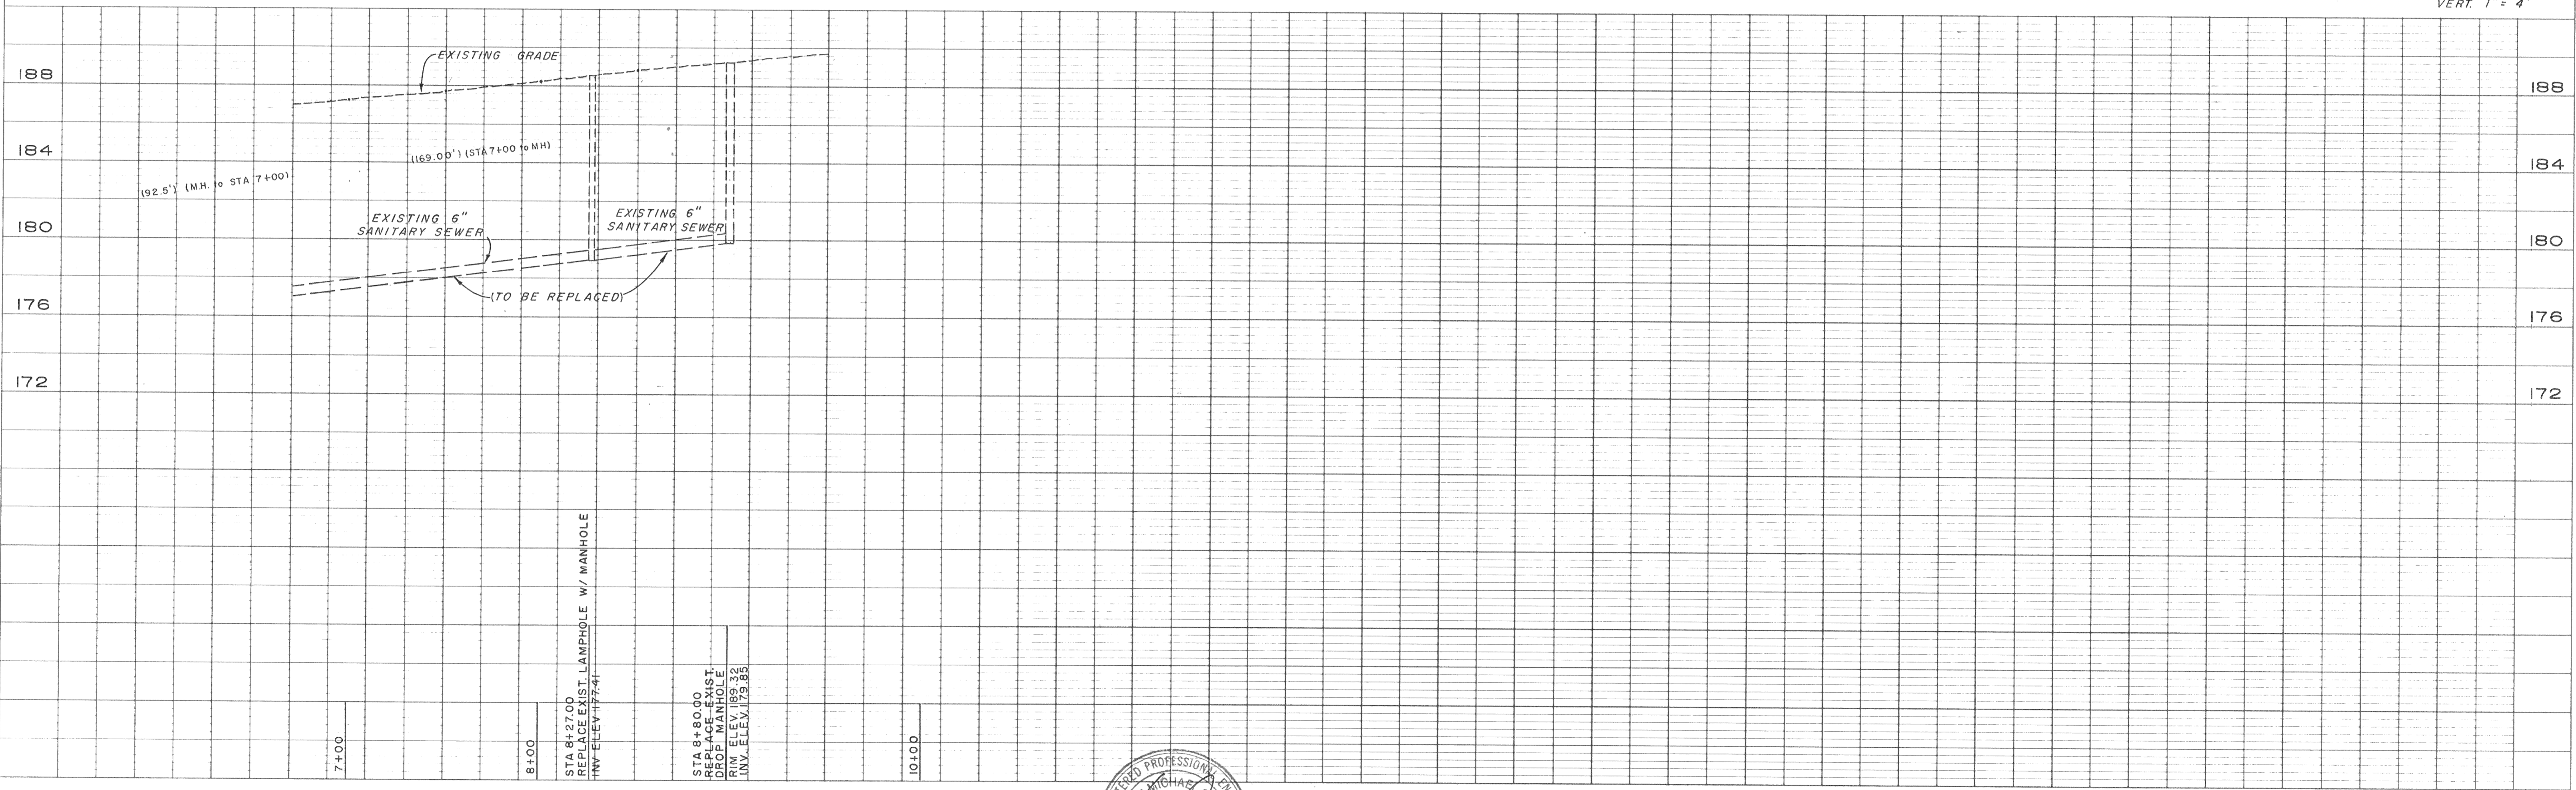

1-7-94	SS. LATERALS, WATER MAIN & GAS	T.F.
DATE NO.	REVISION	BY APP'D

FIELD BOOK	DRAWN
ELEVATION DATUM	T.F.
	DESIGNED
	J.J.
	CHECKED
	J.J.
	SCALE

APPROVED
No. C 041977
EXP 3/31/92
CIVIL
STATE OF CALIFORNIA
5/17/08
DIRECTOR PUBLIC WORKS R.C.E. 41977 DATE




CITY OF OROVILLE
PUBLIC WORKS DEPARTMENT
1675 MONTGOMERY ST.
OROVILLE, CA 95965 (916) 538-2420

SANITARY SEWER REPLACEMENT
PROJECT
LINCOLN STREET AND EHMANN STREET

SHEET
3 OF 4
SHEETS
JOB NO.


PLAN
 SUBMITTED BY DATE
 CHECKED BY DATE
 NOTE BOOK, PLOTTED
 NO. ALIGNMENT CHECKED
 NO. FT. OF WAY CHECKED

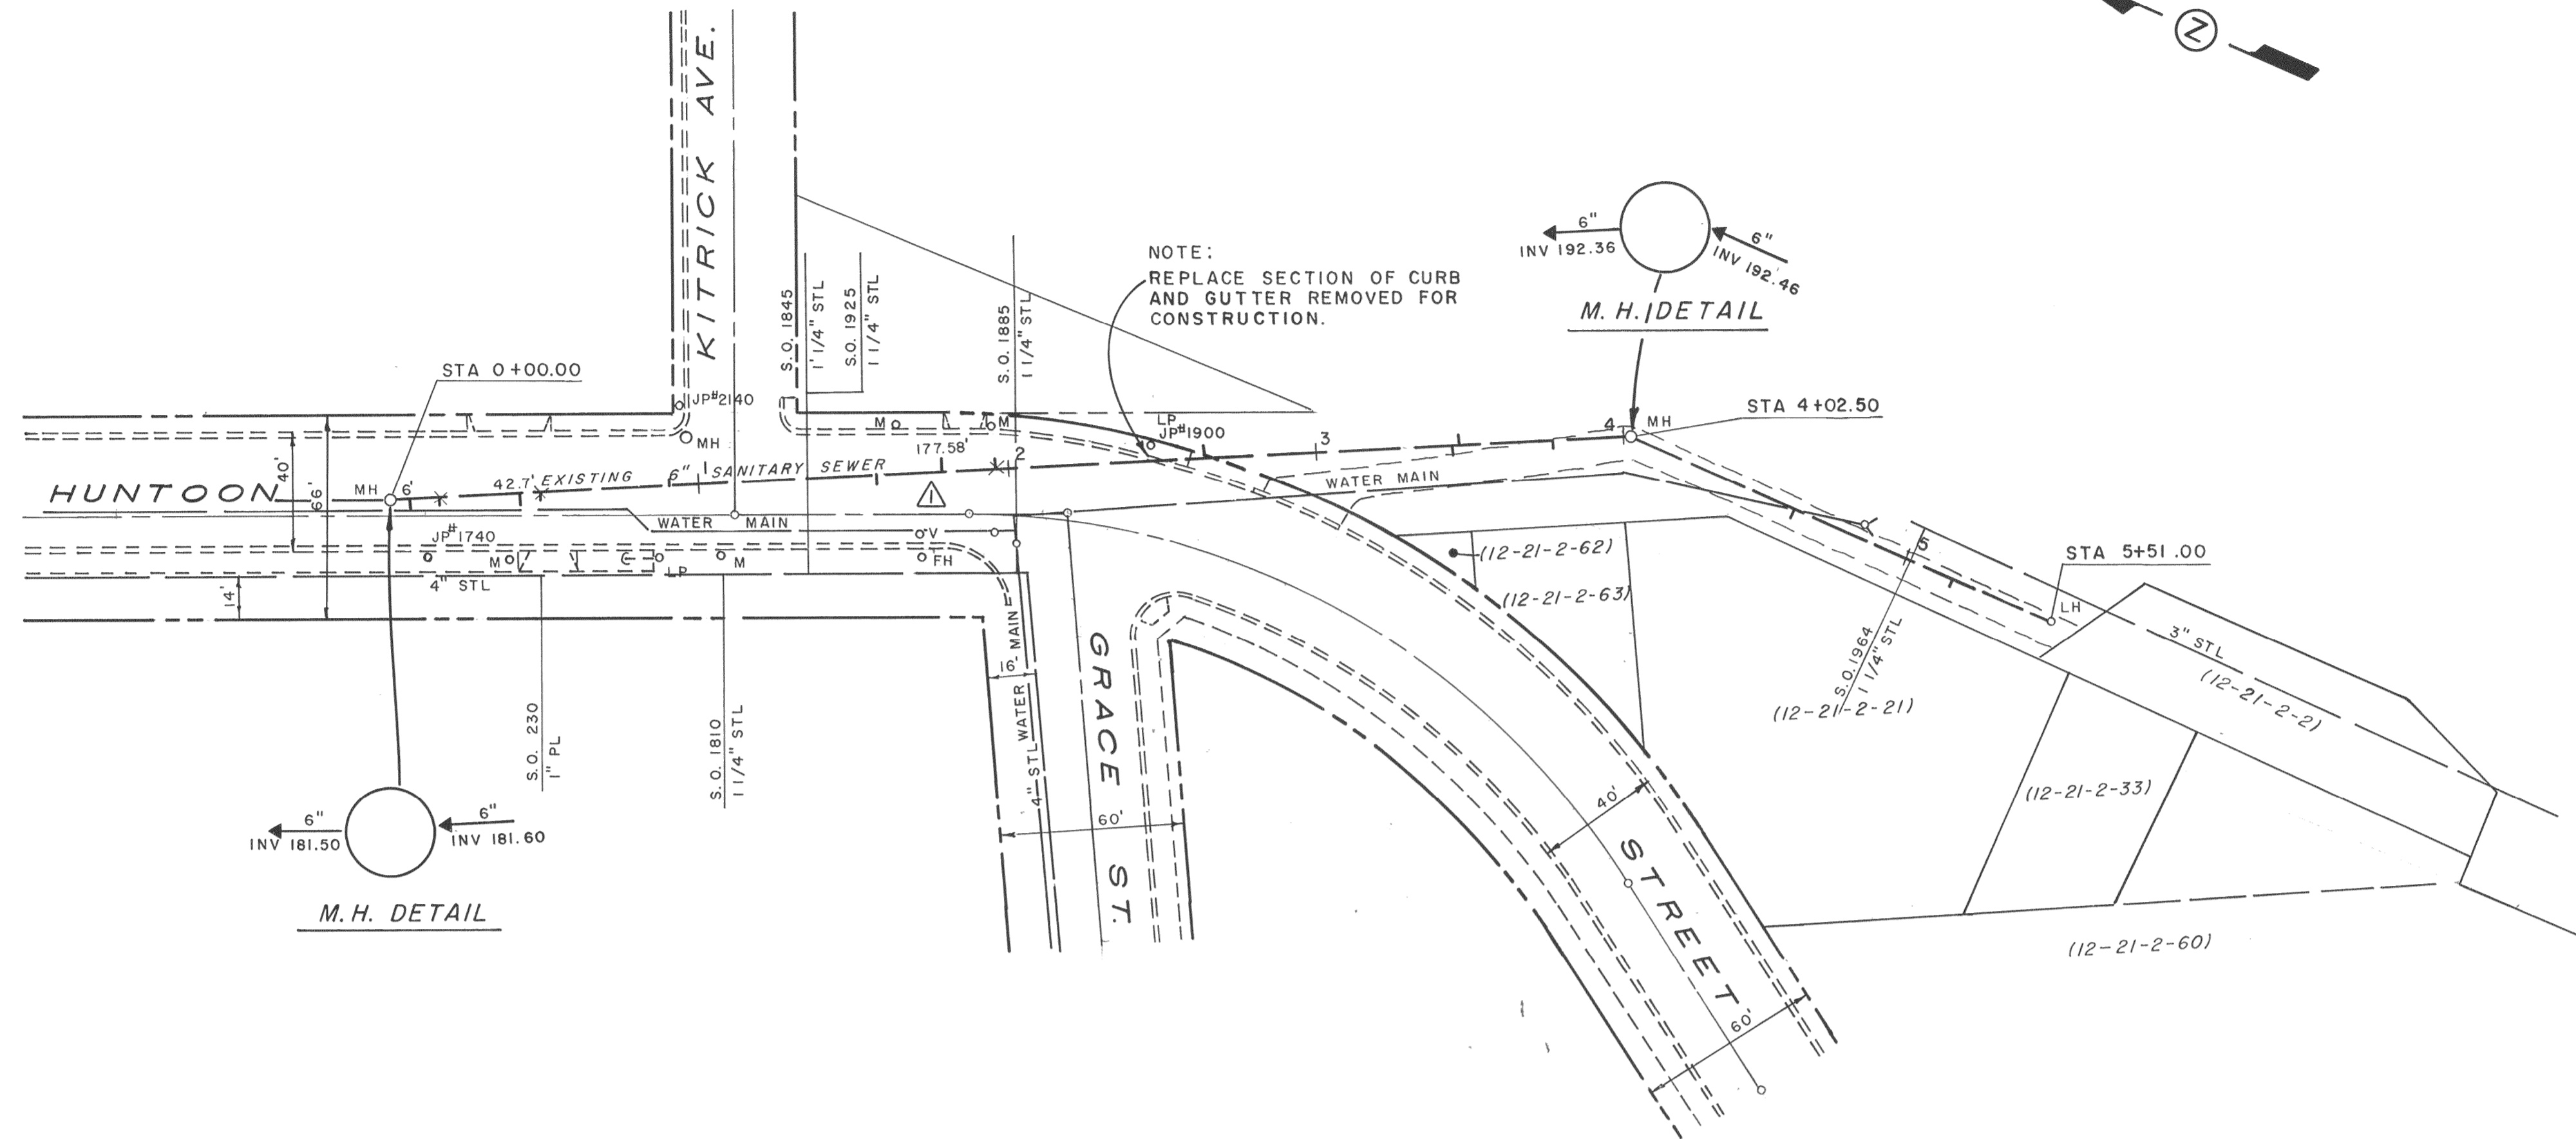

BENCHMARK
 BRASS CAP SET IN S.E. CURB RETURN
 AT INTERSECTION OF HUNTOON ST.
 AND KITRICK AVE.
 ELEV. 191.52

SCALE
 HORIZ. 1" = 40'
 VERT. 1" = 4'

PROFILE
 SUBMITTED BY DATE
 CHECKED BY DATE
 NOTE BOOK, GRADES CHECKED
 NO. B.M.'S NOTED
 NO. STRUCTURE INDICATIONS CHECKED

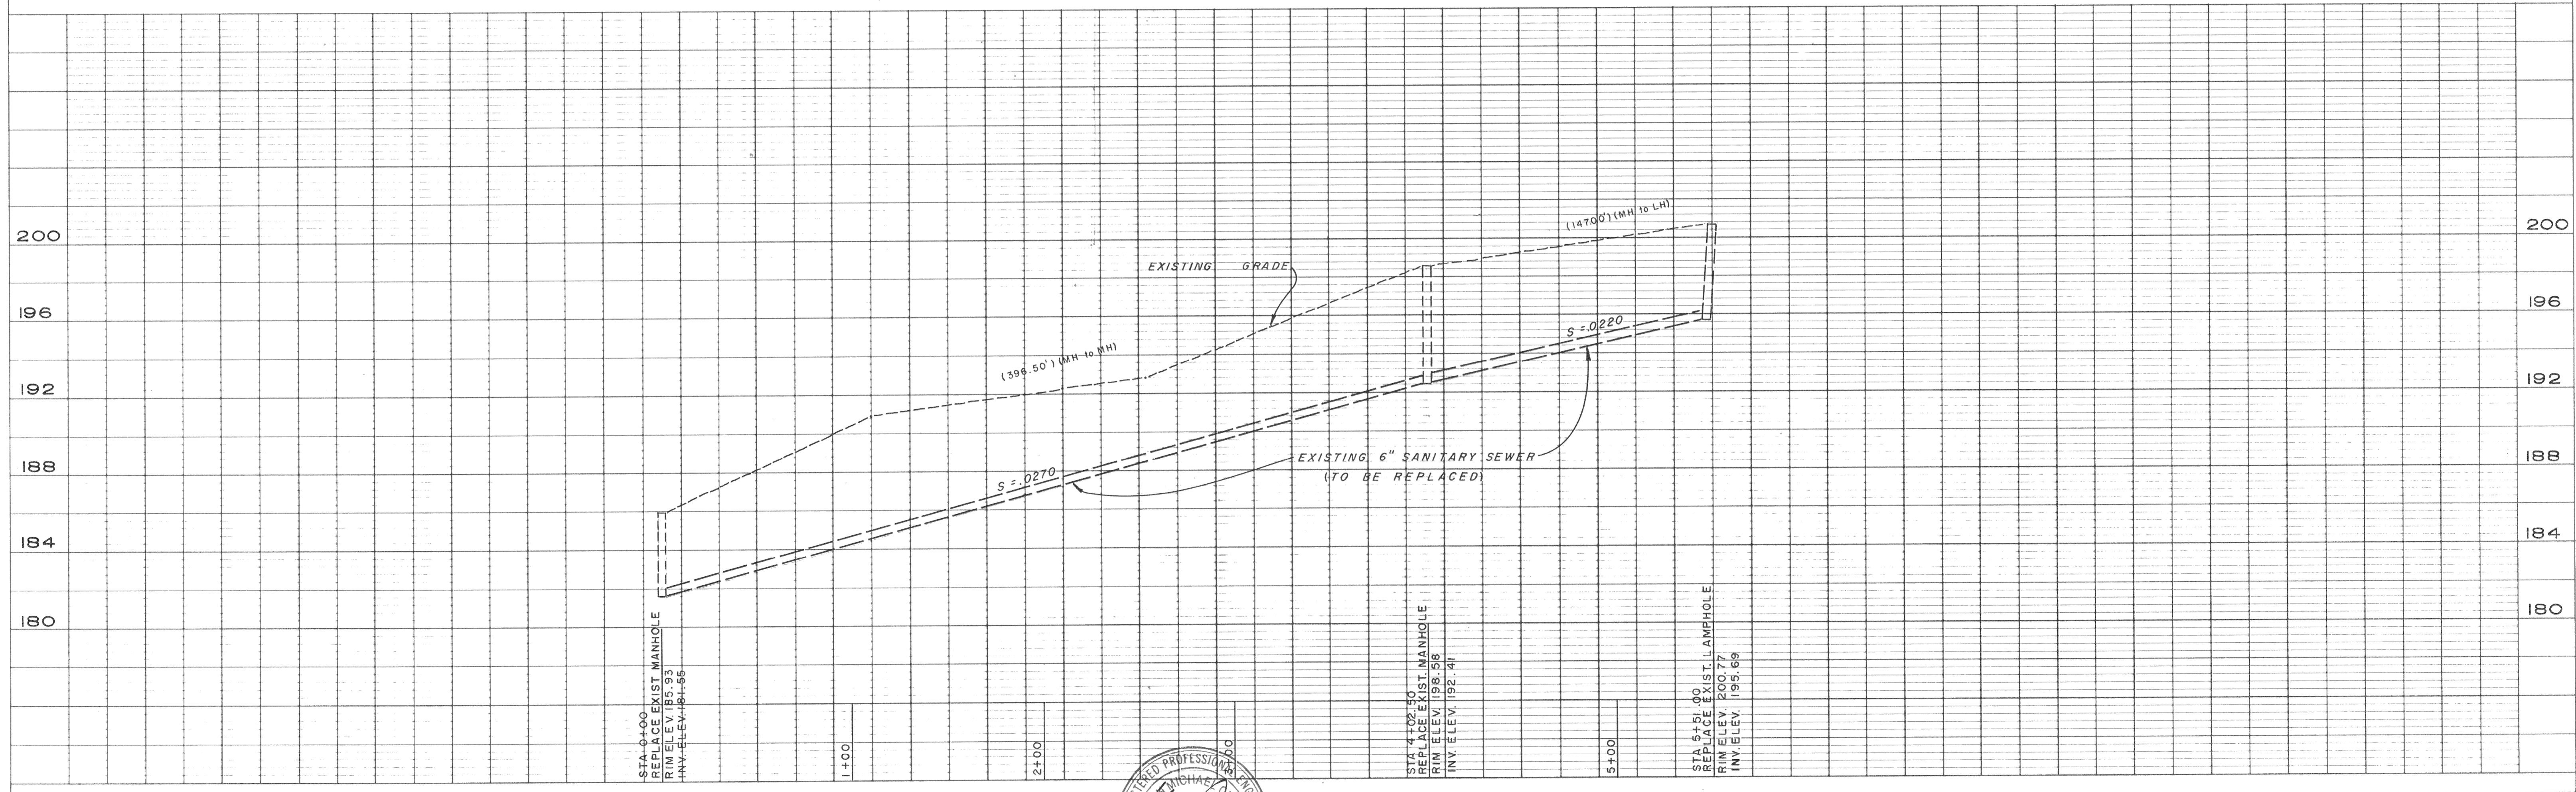

DATE NO.	REVISION	BY	APP'D
1-7-94	SS. LATERALS, WATER MAIN & GAS	T.F.	

FIELD BOOK	DRAWN
ELEVATION DATUM	T.F.
	DESIGNED
	J.J.
	CHECKED
	J.J.
	SCALE

APPROVED
 No. C 041977
 EXP 3/31/92
 CIVIL
 STATE OF CALIFORNIA
 DIRECTOR PUBLIC WORKS R.C.E. 41977 DATE 5/1/92

CITY OF OROVILLE
 PUBLIC WORKS DEPARTMENT
 1675 MONTGOMERY ST.
 OROVILLE, CA 95965 (916) 538-2420

SANITARY SEWER REPLACEMENT PROJECT
 HUNTOON STREET

SHEET 4 OF 4 SHEETS
 JOB NO.