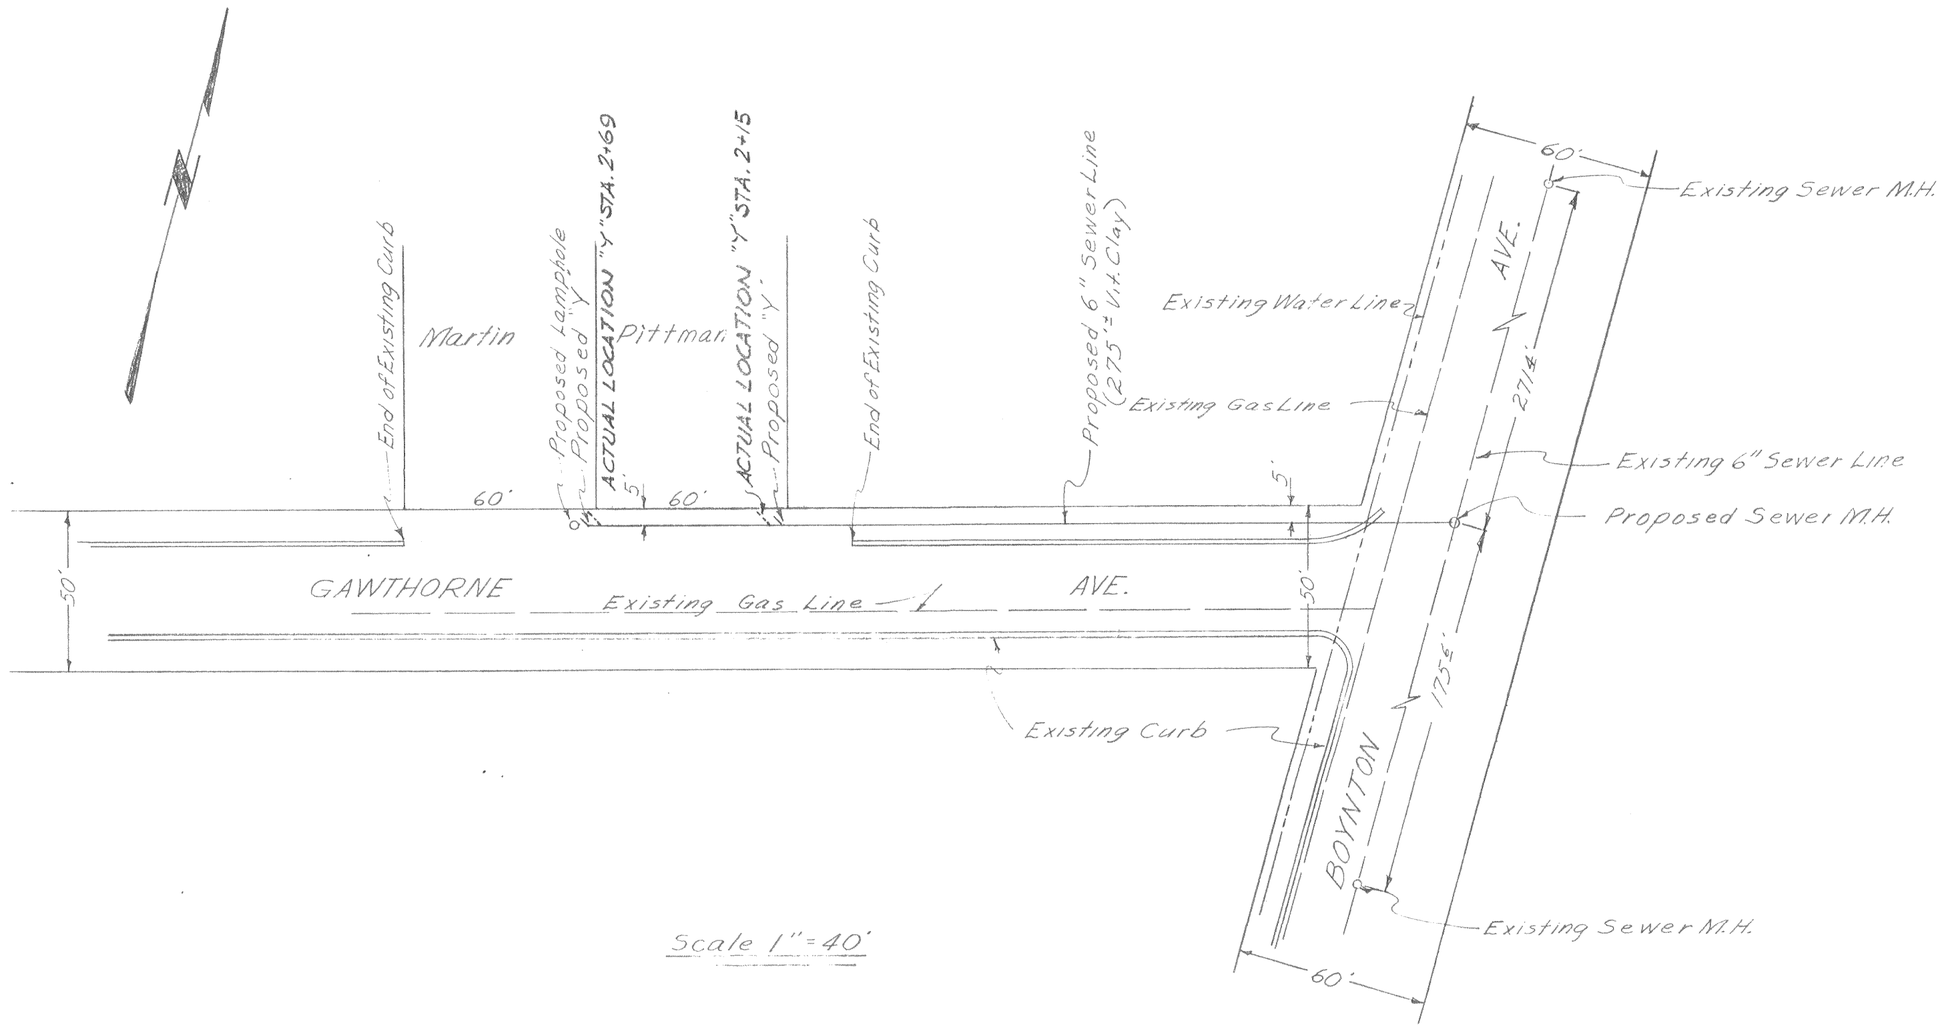

Scale 1" = 40'

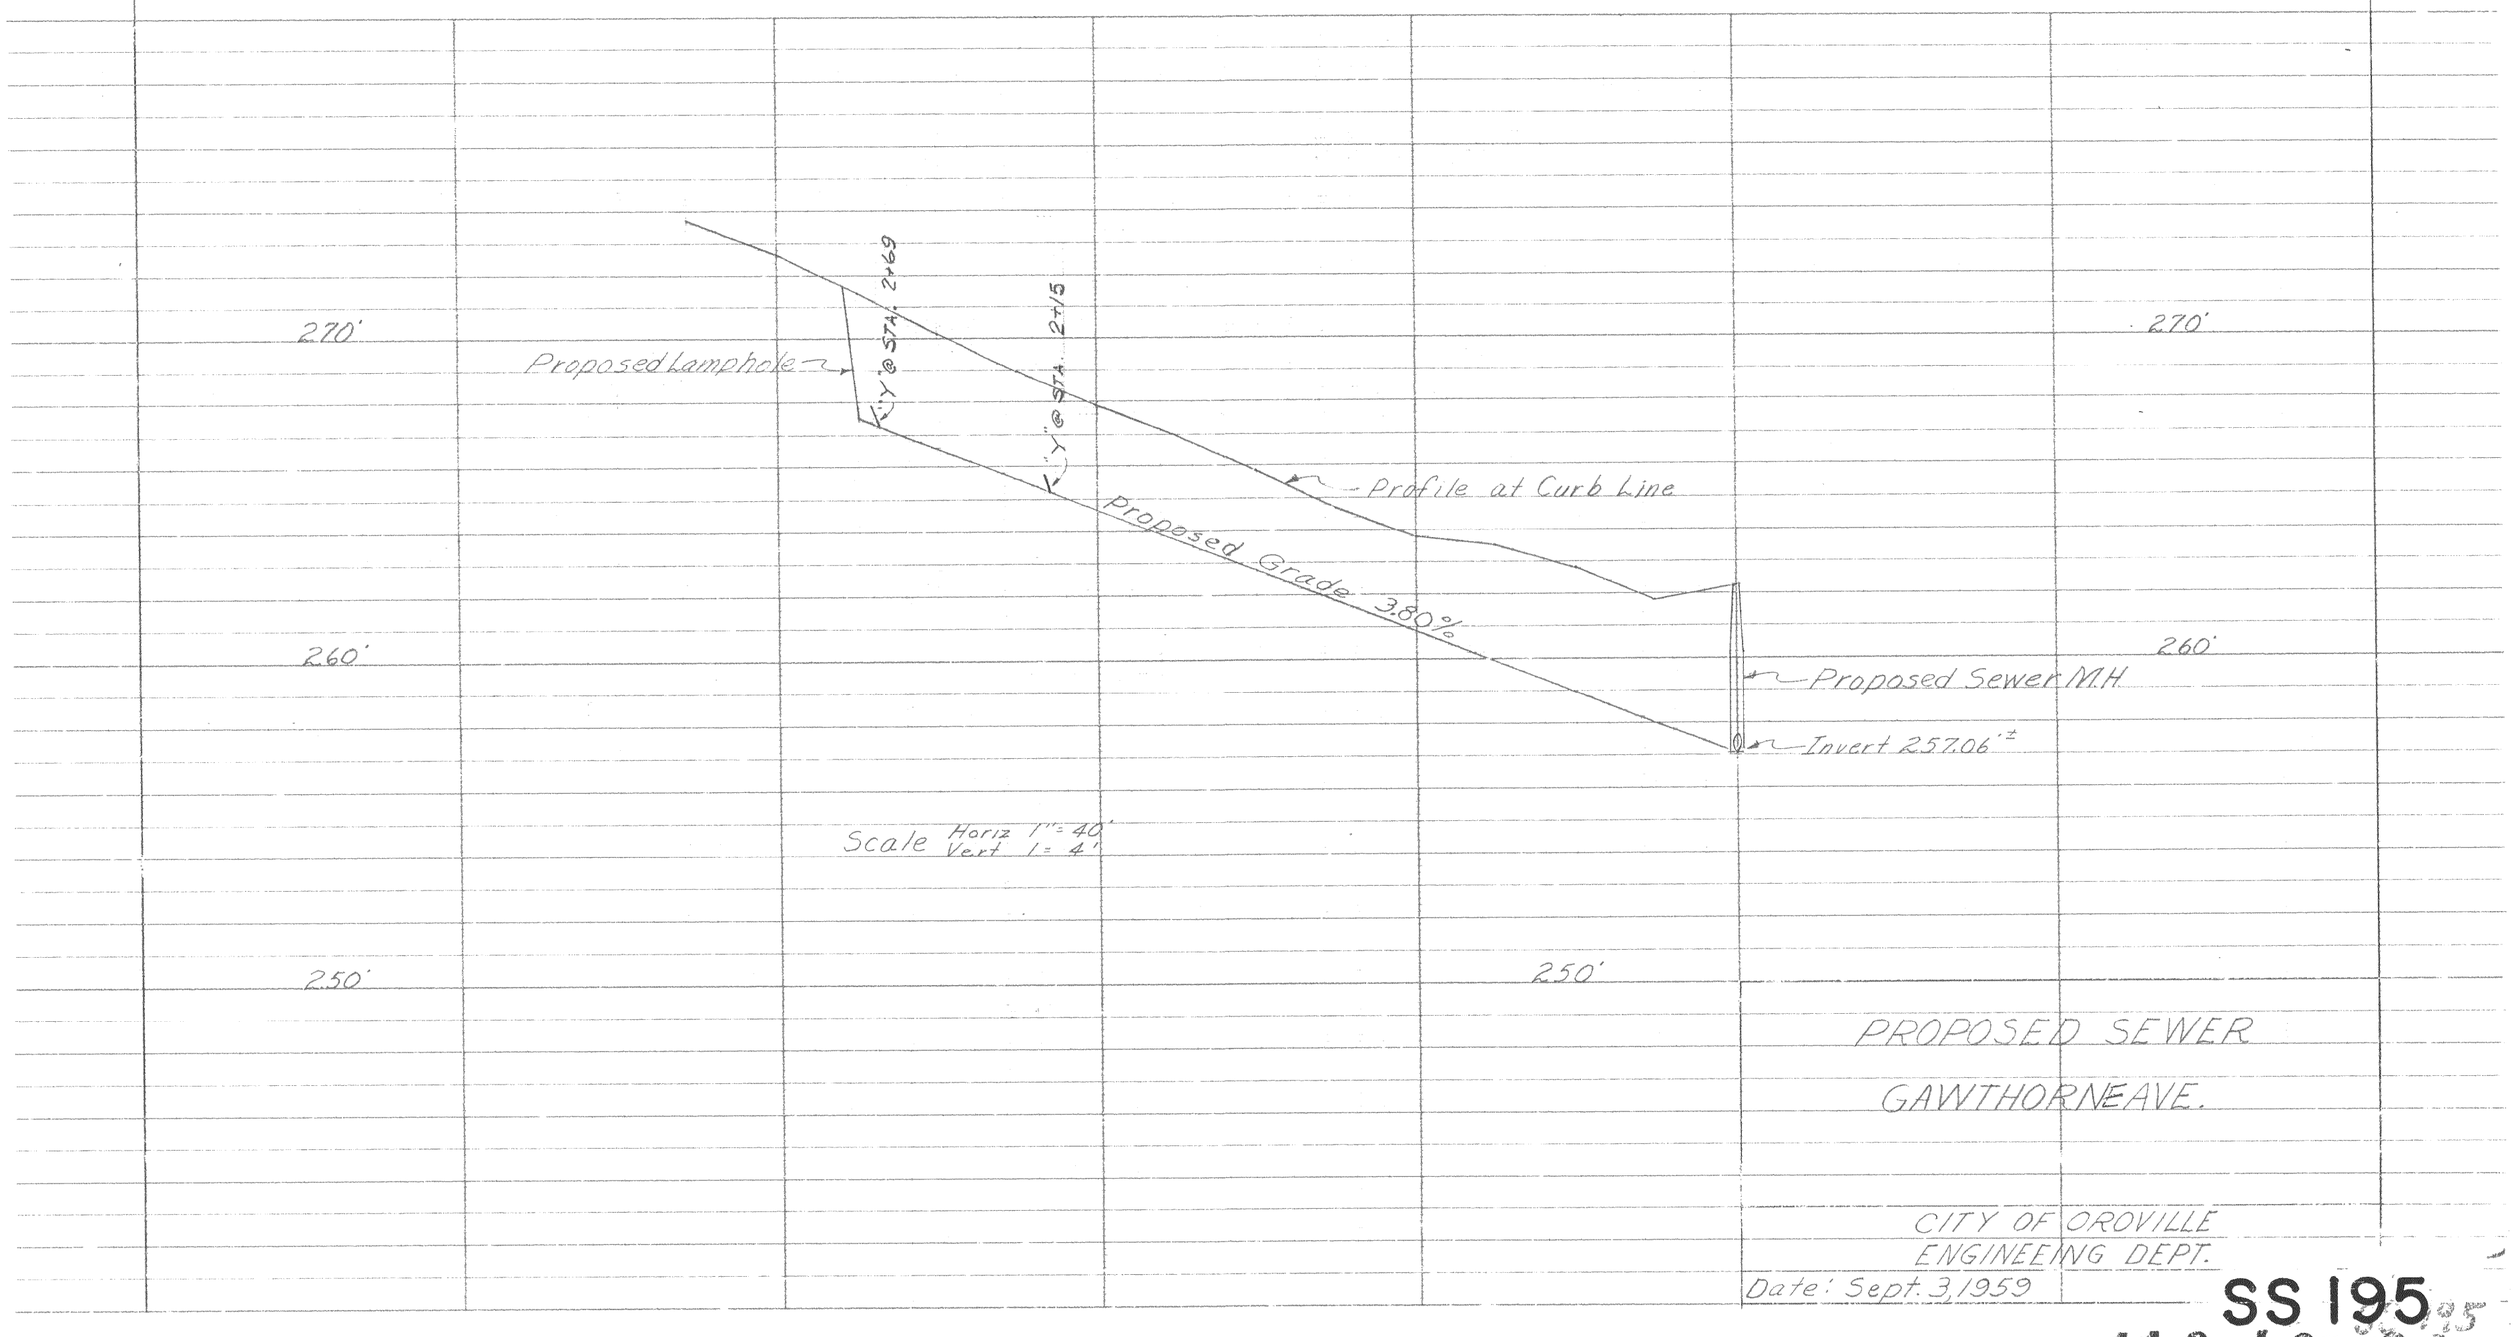

SS 195

~~11.0 (9-C)~~

11.0 (9-C)