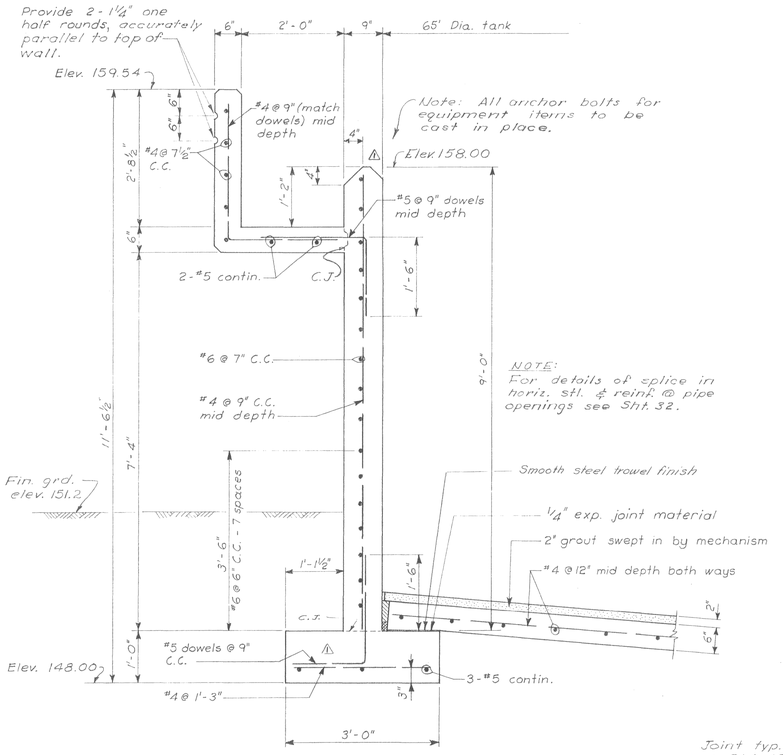

TYPICAL WALL SECTION

Scale : 3/4" = 1'-0"

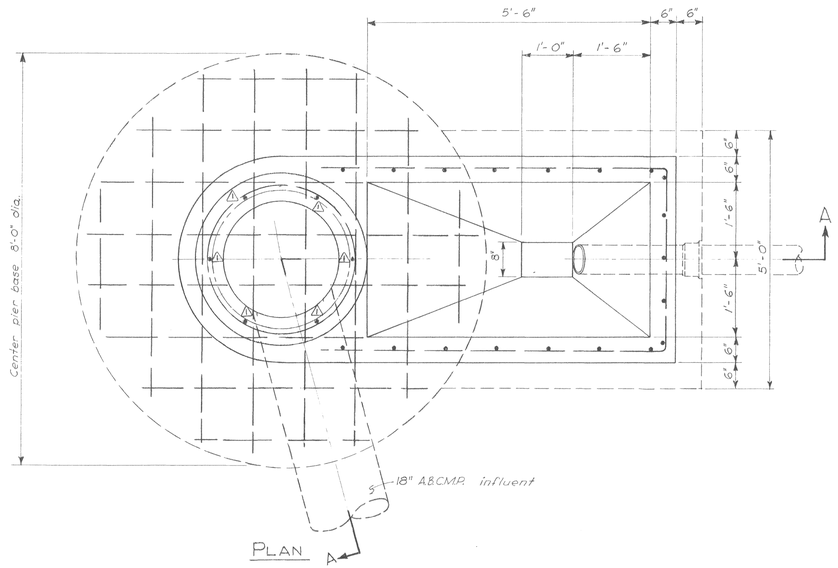

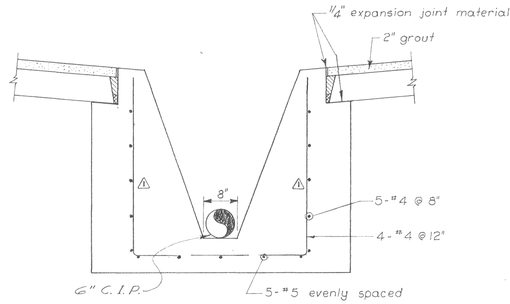

SECTION "B-B"

Scale : 3/4" = 1'-0"

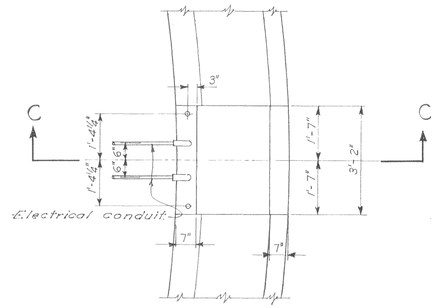

PLAN OF WALKWAY

Scale : 1/2" = 1'-0"

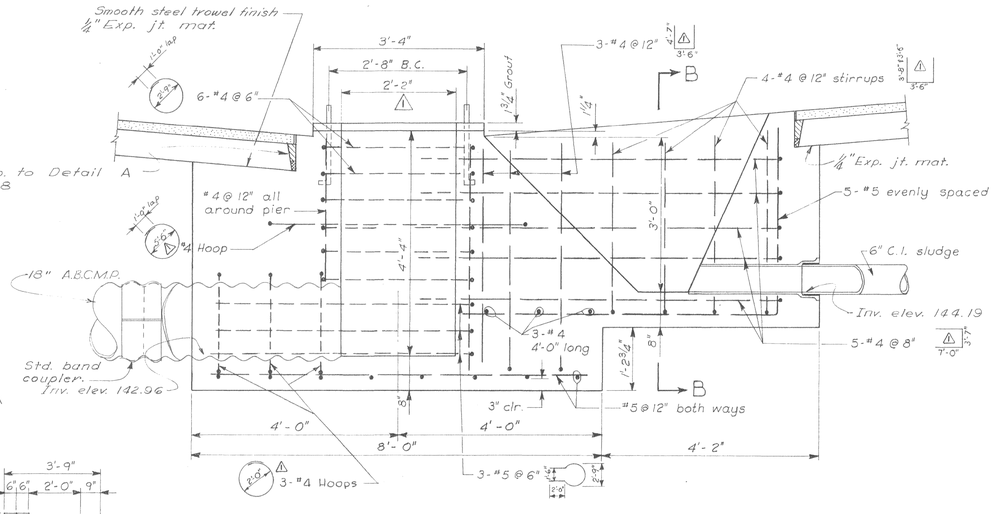

SECTION "A-A"

CENTER PIER DETAILS

Scale : 3/4" = 1'-0"

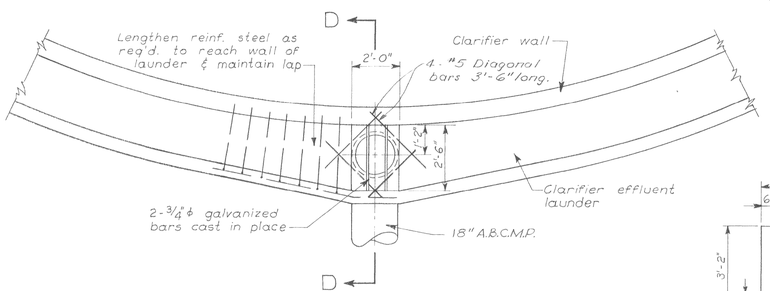

EFFLUENT BOX DETAIL

Scale : 3/8" = 1'-0"

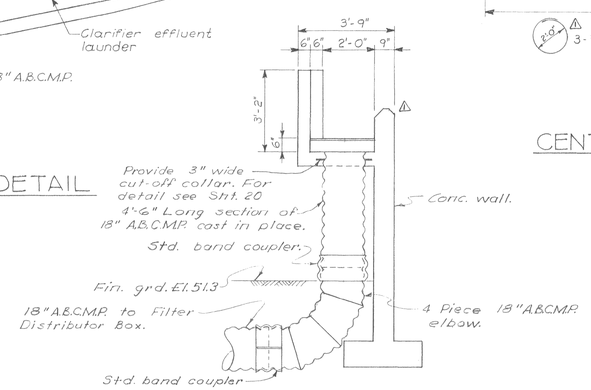

SECTION "D-D"

Scale : 3/8" = 1'-0"

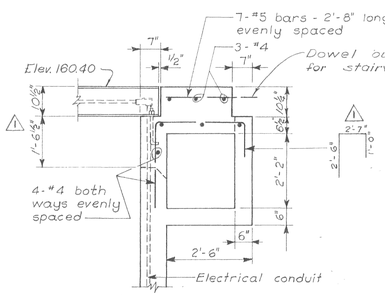

SECTION "C-C"

Scale : 1/2" = 1'-0"

AS BUILT

REVISION	DATE	DESCRIPTION	BY	APP
⚠ A.B.	5-1-61	Relocated steel, anchor bolts. Changed steel dimensions.	RAB	

CITY OF OROVILLE
BUTTE COUNTY , CALIFORNIA

SEWAGE TREATMENT PLANT

PRIMARY CLARIFIERS STRUCTURAL DETAILS

DEWANTE AND STOWELL
SANITARY AND CIVIL ENGINEERS — SACRAMENTO, CALIFORNIA

DRAWN: H.N.H.
CHECKED: R.H.D.
DATE: Mar. 1959

SUBMITTED:
APPROVED:

SHEET NO. 19 OF 36

SS 157